

DURABLE 4 INCH WHITE LINE, SEE OPTION ITEMS  
 STA. A 2+25 - STA. A 7+50 (SOLID LT & RT)

TEMPORARY 4 INCH WHITE LINE, PAINT  
 STA. A 2+25 - STA. A 7+50 (SOLID LT & RT)

DURABLE 4 INCH YELLOW LINE, POLYUREA  
 STA. A 2+25 - STA. A 7+50 (CENTERLINE)



TEMPORARY 4 INCH YELLOW LINE, PAINT  
 STA. A 2+25 - STA. A 7+50 (CENTERLINE)

REMOVAL AND DISPOSAL OF GUARDRAIL  
 STA. A 2+25 - STA. A 5+35 RT

6 INCH UNDERDRAIN PIPE  
 STA. A 2+25 - STA. A 3+50 LT  
 STA. A 4+25 - STA. A 7+50 LT  
 4+20

SPECIAL PROVISION (BOX BEAM GUARDRAIL W/7 FEET POSTS)  
 STA. A 2+25 - STA. A 6+09 RT  
 6+13

MILLED RUMBLE STRIPS  
 STA. A 2+25 - STA. A 7+50 (CENTERLINE)

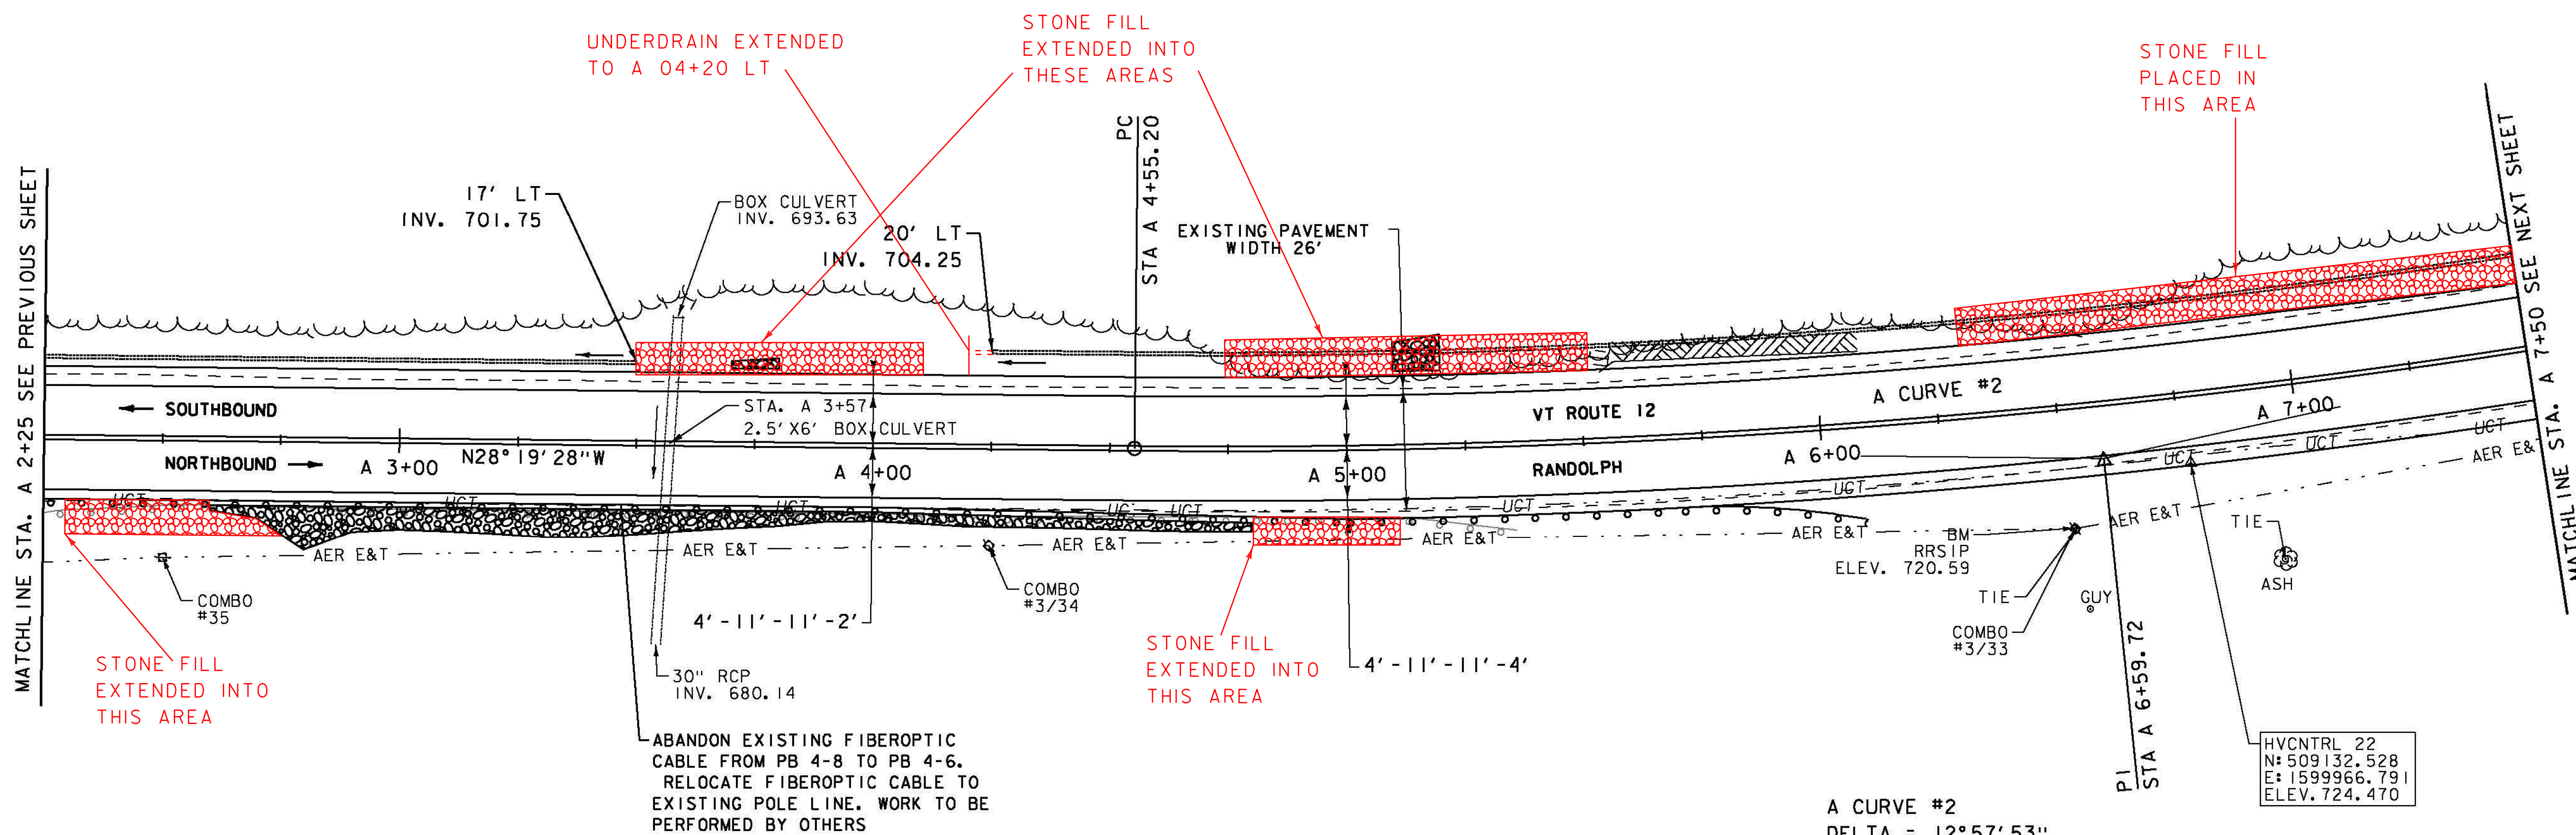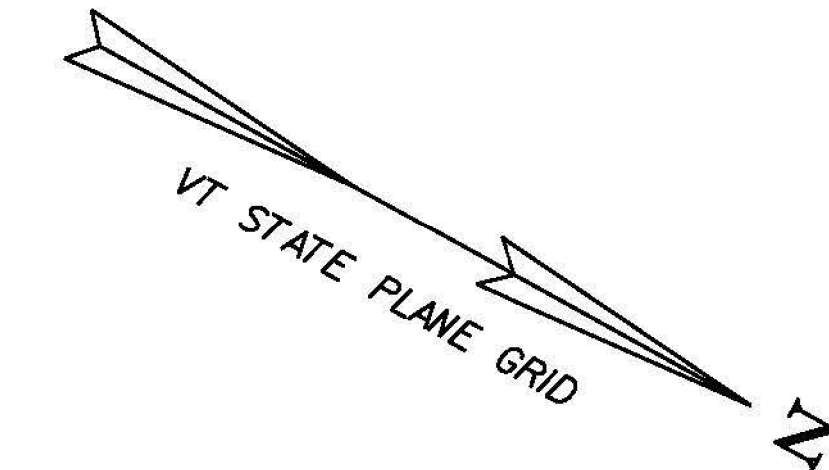

SOLID ROCK EXCAVATION  
 STA. A 5+00 - STA. A 6+50 LT

STONE FILL, TYPE I  
 STA. A 2+60 - STA. A 4+80 RT  
 STA. A 3+70 - STA. A 3+80 LT  
 STA. A 5+10 - STA. A 5+20 LT

STONE FILL, TYPE I  
 STA. A 2+30 - STA. A 5+10 RT  
 STA. A 3+50 - STA. A 4+10 LT  
 STA. A 4+75 - STA. A 5+50 LT  
 STA. A 6+30 - STA. A 7+50 LT


GEOTEXTILE FOR SILT FENCE  
 STA. A 2+60 - STA. A 4+80 RT  
 STA. A 3+70 - STA. A 3+80 LT  
 STA. A 5+10 - STA. A 5+20 LT

GRUBBING MATERIAL (6")  
 STA. A 2+60 - STA. A 4+80 RT  
 STA. A 3+70 - STA. A 3+80 LT  
 STA. A 5+10 - STA. A 5+20 LT

A CURVE #2  
 DELTA = 12°57'53"  
 D = 3°10'59"  
 R = 1800.00'  
 T = 204.52'  
 L = 407.30'  
 E = 11.58'  
 BANKING 0.054 FT/FT  
 DESIGN SPEED 50 MPH  
 SEE SUPERELEVATION DIAGRAMS  
 FOR MORE INFORMATION

**SIGN LEGEND**

- R = REMOVE
- R&S = REMOVE AND SALVAGE
- RET = RETAIN
- S = SALVAGED
- N = NEW
- B-B = BACK TO BACK
- - = EXISTING
- = NEW

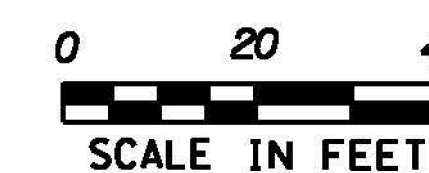

PROJECT NAME:	BETHEL-RANDOLPH	PLOT DATE:	4/23/2015
PROJECT NUMBER:	STP 292(I)	DRAWN BY:	S. LAMPHERE
FILE NAME:	z10c244bdr.dgn	DESIGNED BY:	S. LAMPHERE
		CHECKED BY:	C. LATHROP
			SHEET 72 OF 211