

DURABLE 4 INCH WHITE LINE, SEE OPTION ITEMS
 STA. A 13+25 - STA. A 18+75 (SOLID LT & RT)

DURABLE 4 INCH YELLOW LINE, POLYUREA
 STA. A 13+25 - STA. A 18+75 (CENTERLINE)

MILLED RUMBLE STRIPS
 STA. A 13+25 - STA. A 18+75 (CENTERLINE)

REMOVAL AND DISPOSAL OF GUARDRAIL
 STA. A 15+00 - STA. A 16+92 RT

SPECIAL PROVISION (BOX BEAM GUARDRAIL W/7 FEET POSTS)
 STA. A 14+70 - STA. A 17+28 RT



TEMPORARY 4 INCH WHITE LINE, PAINT
 STA. A 13+25 - STA. A 18+75 (SOLID LT & RT)

TEMPORARY 4 INCH YELLOW LINE, PAINT
 STA. A 13+25 - STA. A 18+75 (CENTERLINE)

6 INCH UNDERDRAIN PIPE
 STA. A 13+25 - STA. A 13+96 LT

SPECIAL PROVISION (CORING CONCRETE)
 STA. A 13+96 LT

A CURVE #3
 DELTA = 36°35'17"
 D = 1°57'20" (1) D = 10°03'07" (2)
 R = 2930.00' (1) R = 570.00' (2)
 T = 377.64' (1) T = 202.79' (2)
 L = 249.49' (1) L = 315.46' (2)
 E = 24.24'
 BANKING 0.038 FT/FT, 0.080 FT/FT
 DESIGN SPEED 50 MPH
 SEE SUPERELEVATION DIAGRAMS
 FOR MORE INFORMATION

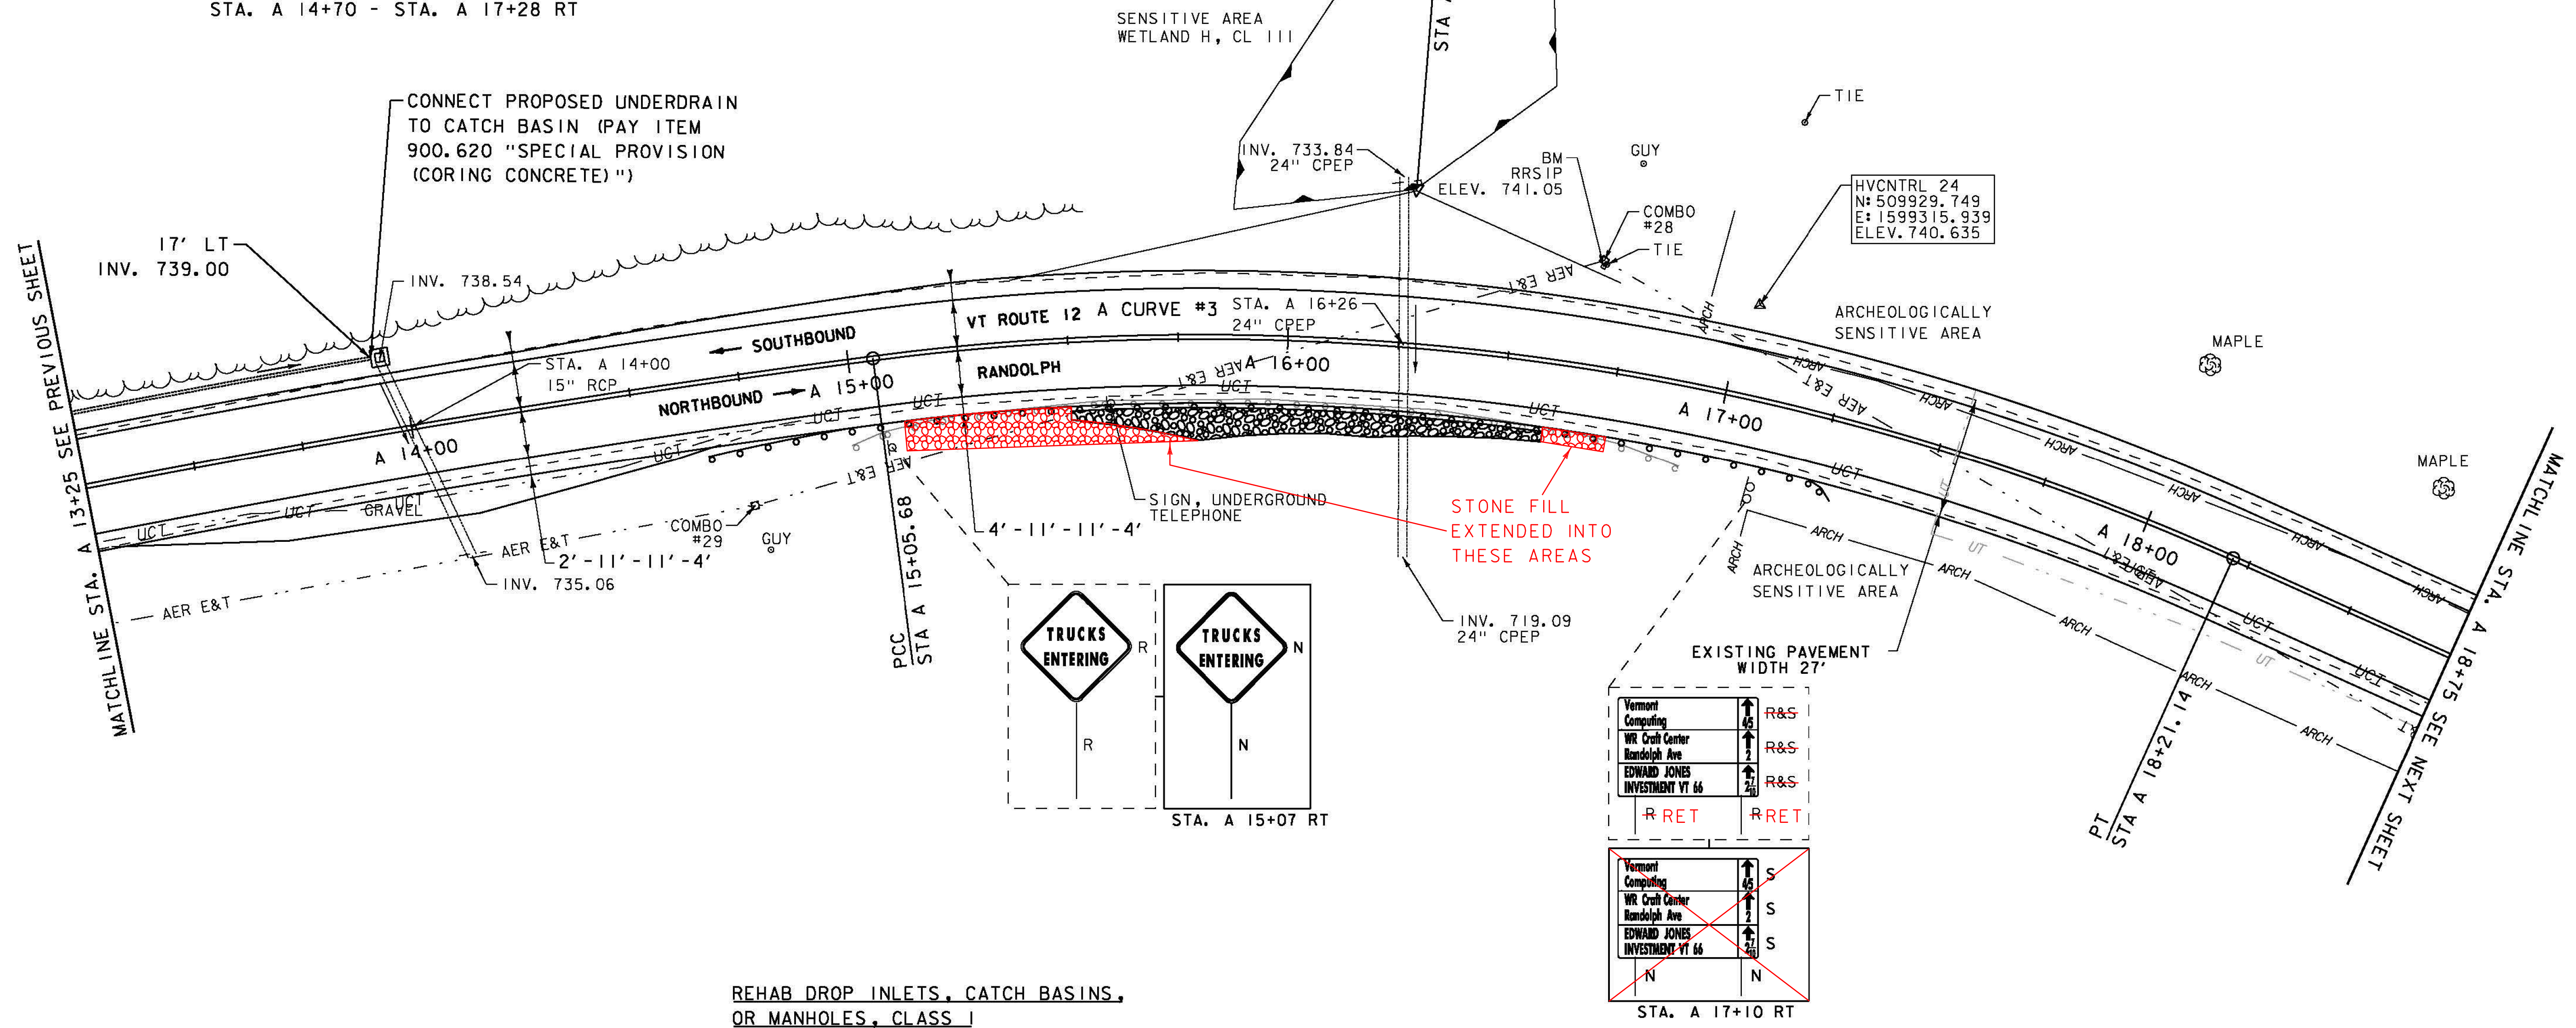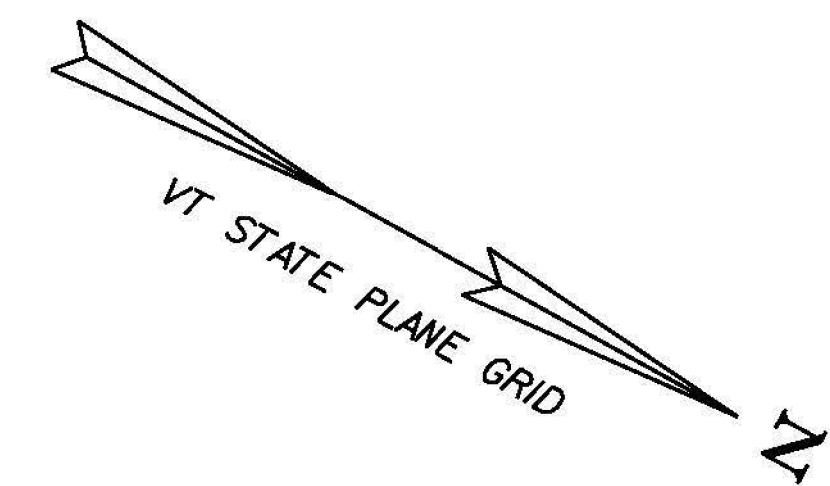

REHAB DROP INLETS, CATCH BASINS,
 OR MANHOLES, CLASS I
 STA. A 13+96 LT

STONE FILL, TYPE I
 STA. A 15+50 - STA. A 16+60 RT
 15+10 16+75

GEOTEXTILE FOR SILT FENCE
 STA. A 15+50 - STA. A 16+60 RT

GRUBBING MATERIAL (6")
 STA. A 15+50 - STA. A 16+60 RT


SIGN LEGEND
 R = REMOVE
 R&S = REMOVE AND SALVAGE
 RET = RETAIN
 S = SALVAGED
 N = NEW
 B-B = BACK TO BACK
 - - = EXISTING
 — = NEW

REMOVING SIGNS
 AS SHOWN - 4

ERECTING SALVAGED SIGNS
 AS SHOWN - 3

ENVIRONMENTALLY SENSITIVE LOCATIONS:

NO.	LIMITS	POS.	TYPE
11.	STA. A 15+87 - STA. A 16+53	LT	-

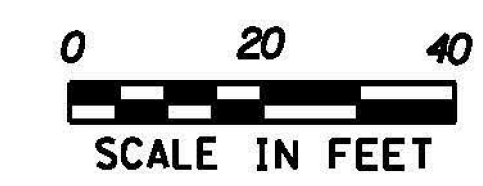

PROJECT NAME: BETHEL-RANDOLPH	PLOT DATE: 4/23/2015
PROJECT NUMBER: STP 292(1)	DRAWN BY: S. LAMPHERE
FILE NAME: z10c244bdr.dgn	CHECKED BY: C. LATHROP
DESIGNED BY: S. LAMPHERE	SHEET 74 OF 211
PLAN SHEET 48	