

A CURVE #5
 DELTA = 2°56'39"
 D = 0°57'18"
 R = 6000.00'
 T = 154.18'
 L = 308.30'
 E = 1.98'
 BANKING 0.020 FT/FT
 DESIGN SPEED 50 MPH
 SEE SUPERELEVATION DIAGRAMS
 FOR MORE INFORMATION

A CURVE #6
 DELTA = 2°01'14"
 D = 1°25'57"
 R = 4000.00'
 T = 70.54'
 L = 141.06'
 E = 0.62'
 BANKING 0.029 FT/FT
 DESIGN SPEED 50 MPH
 SEE SUPERELEVATION DIAGRAMS
 FOR MORE INFORMATION

MATCHLINE STA. A 24+25 SEE PREVIOUS SHEET

MATCHLINE STA. A 29+75 SEE NEXT SHEET

DURABLE 4 INCH WHITE LINE, SEE OPTION ITEMS
 STA. A 24+25 - STA. A 29+75 (SOLID LT & RT)
 (WITH EDGE LINE BREAKS AT TH#79)
 STA. A 27+50 LT. (EDGE LINE AT TH#79)

DURABLE 4 INCH YELLOW LINE, POLYUREA
 STA. A 24+25 - STA. A 29+75 (CENTERLINE)
 (WITH CENTERLINE BREAKS AT TH#79)
 STA. A 27+50 LT. (CENTERLINE AT TH#79)

DURABLE 24" STOP BAR (SEE OPTION ITEMS)
 STA. A 27+27 - STA. A 27+49 LT

DURABLE LETTER OR SYMBOL (SEE OPTION ITEMS)
 STA. A 27+37 LT "STOP"

SIGN LEGEND

- R = REMOVE
- R&S = REMOVE AND SALVAGE
- RET = RETAIN
- S = SALVAGED
- N = NEW
- B-B = BACK TO BACK
- - = EXISTING
- = NEW

TEMPORARY 4 INCH WHITE LINE, PAINT
 STA. A 24+25 - STA. A 29+75 (SOLID LT & RT)
 (WITH EDGE LINE BREAKS AT TH#79)
 STA. A 27+50 LT. (EDGE LINE AT TH#79)

TEMPORARY 4 INCH YELLOW LINE, PAINT
 STA. A 24+25 - STA. A 29+75 (CENTERLINE)
 (WITH CENTERLINE BREAKS AT TH#79)
 STA. A 27+50 LT. (CENTERLINE AT TH#79)

TEMPORARY 24" STOP BAR, PAINT
 STA. A 27+27 - STA. A 27+49 LT

TEMPORARY LETTER OR SYMBOL, PAINT
 STA. A 27+37 LT "STOP"

REMOVAL AND DISPOSAL OF GUARDRAIL
 STA. A 25+53 - STA. A 25+82 RT
 STA. A 25+70.5 - STA. A 25+95.5 LT
 STA. A 26+25 - STA. A 26+45.5 LT
 STA. A 26+49.5 - STA. A 26+78.5 RT

STEEL BEAM GUARDRAIL, GALVANIZED
 STA. A 24+57 - STA. A 24+69.5 RT^{25+07.5}
~~STA. A 25+70.5 - STA. A 25+83 LT~~
~~STA. A 26+25 - STA. A 26+45.5 LT~~
 STA. A 26+99.5 - STA. A 27+12 RT
 STA. A 26+45.5 - STA. A 26+50 LT

STONE FILL, TYPE I
 STA. A 25+90 - STA. A 26+30 RT

GEOTEXTILE FOR SILT FENCE
 STA. A 25+90 - STA. A 26+30 RT

GRUBBING MATERIAL (6")
 STA. A 25+90 - STA. A 26+30 RT

STEEL BEAM GUARDRAIL, GALVANIZED W/ 8 FEET POSTS
 STA. A 24+69.5 - STA. A 25+57 RT²⁵⁺⁴⁵
~~STA. A 25+83 - STA. A 25+95.5 LT~~
 STA. A 26+74.5 - STA. A 26+99.5 RT


~~HD STEEL BEAM GUARDRAIL, W/8 FEET POSTS~~
~~STA. A 25+57 - STA. A 25+82 RT~~
~~STA. A 26+49.5 - STA. A 26+74.5 RT~~

ANCHOR FOR STEEL BEAM RAIL
 (SEE STANDARD G-1d)

6 INCH UNDERDRAIN PIPE
 STA. A 28+50 - STA. A 29+75 LT

REMOVING SIGNS
 AS SHOWN - 10

HD STEEL BEAM GUARDRAIL, W/8 FEET POSTS
 STA. A 25+45 - STA. A 25+82 RT
 STA. A 26+49.5 - STA. A 26+74.5 RT
 STA. A 25+70.5 - STA. A 25+95.5 LT
 STA. A 26+25 - STA. A 26+45.5 LT

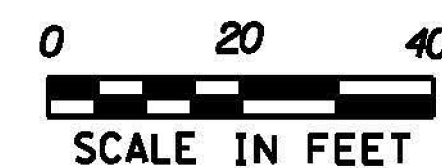

PROJECT NAME:	BETHEL-RANDOLPH	PLOT DATE:	4/23/2015
PROJECT NUMBER:	STP 292(I)	DRAWN BY:	S. LAMPHERE
FILE NAME:	z10c244bdr.dgn	DESIGNED BY:	S. LAMPHERE
PROJECT LEADER:	C. LATHROP	CHECKED BY:	C. LATHROP
PLAN SHEET 50		SHEET	76 OF 211