

DURABLE 4 INCH WHITE LINE, SEE OPTION ITEMS
 STA. A 41+25 - STA. A 46+50 (SOLID LT & RT)

TEMPORARY 4 INCH WHITE LINE, PAINT
 STA. A 41+25 - STA. A 46+50 (SOLID LT & RT)


DURABLE 4 INCH YELLOW LINE, POLYUREA
 STA. A 41+25 - STA. A 46+50 (CENTERLINE)

TEMPORARY 4 INCH YELLOW LINE, PAINT
 STA. A 41+25 - STA. A 46+50 (CENTERLINE)

MILLED RUMBLE STRIPS
 STA. A 41+25 - STA. A 44+00 (CENTERLINE)

6 INCH UNDERDRAIN PIPE
 STA. A 41+25 - STA. A 45+25 LT

A CURVE #8
 DELTA = 0°17'50"
 D = 0°13'45"
 R = 25000.00'
 T = 64.83'
 L = 129.65'
 E = 0.08'
 BANKING NORMAL CROWN
 DESIGN SPEED 50 MPH
 SEE SUPERELEVATION DIAGRAMS
 FOR MORE INFORMATION

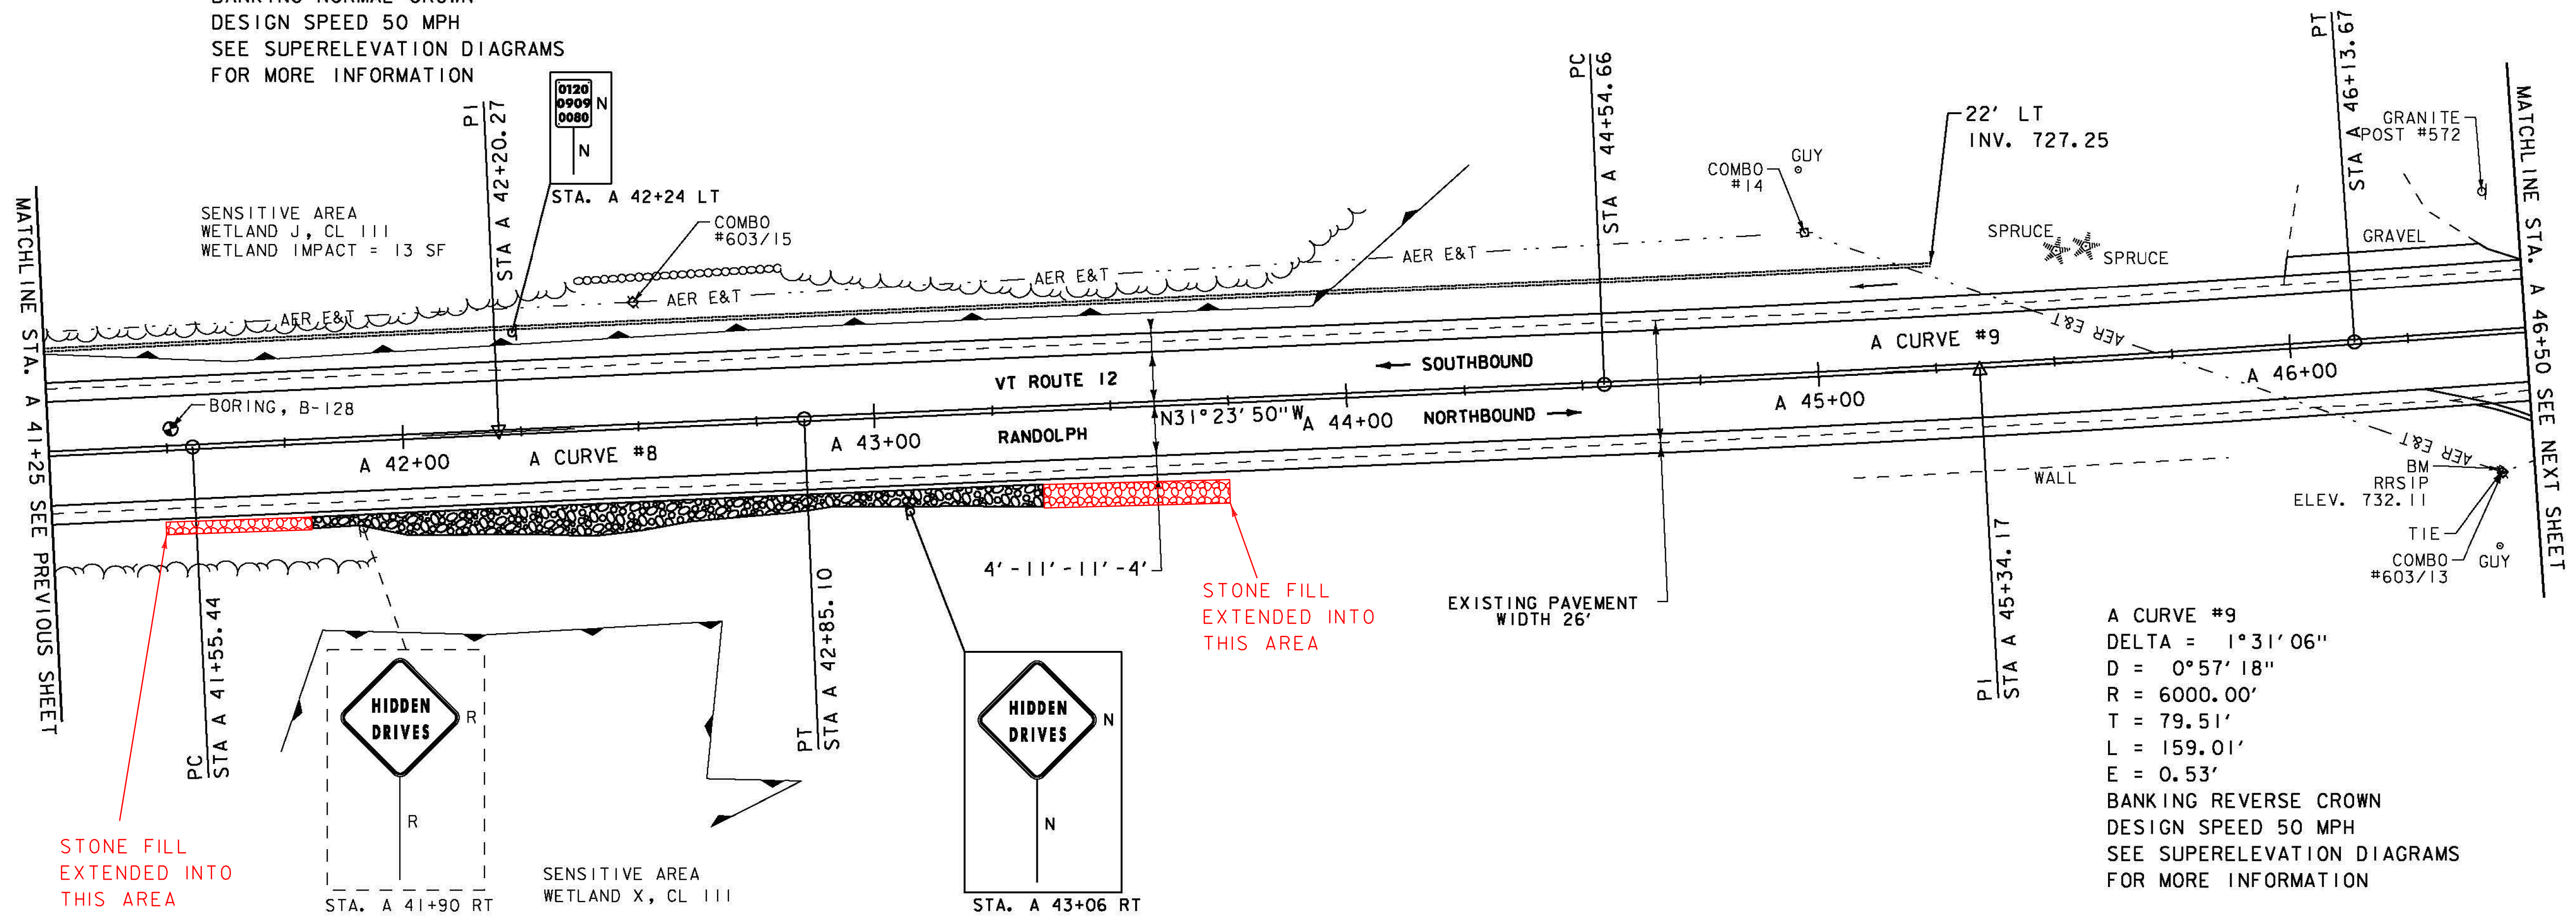

STONE FILL
 EXTENDED INTO
 THIS AREA

STONE FILL
 EXTENDED INTO
 THIS AREA

A CURVE #9
 DELTA = 1°31'06"
 D = 0°57'18"
 R = 6000.00'
 T = 79.51'
 L = 159.01'
 E = 0.53'
 BANKING REVERSE CROWN
 DESIGN SPEED 50 MPH
 SEE SUPERELEVATION DIAGRAMS
 FOR MORE INFORMATION

SIGN LEGEND

- R = REMOVE
- R&S = REMOVE AND SALVAGE
- RET = RETAIN
- S = SALVAGED
- N = NEW
- B-B = BACK TO BACK
- - = EXISTING
- = NEW

STONE FILL, TYPE I
 STA. A 41+80 - STA. A 43+35 RT
 41+50 43+75


GEOTEXTILE FOR SILT FENCE
 STA. A 41+80 - STA. A 43+35 RT

GRUBBING MATERIAL (6")
 STA. A 41+80 - STA. A 43+35 RT

REMOVING SIGNS
 AS SHOWN - I

ENVIRONMENTALLY SENSITIVE LOCATIONS:

NO.	LIMITS	POS.	TYPE
12.	STA. A 41+25 - STA. A 44+18	LT	-
13.	STA. A 41+71 - STA. A 42+81	RT	-

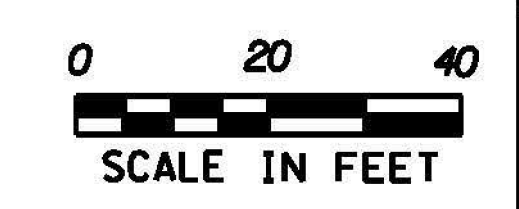

PROJECT NAME:	BETHEL-RANDOLPH	FILE NAME:	z10c244bdr.dgn	PLOT DATE:	4/23/2015
PROJECT NUMBER:	STP 292(I)	PROJECT LEADER:	C. LATHROP	DRAWN BY:	S. LAMPHERE
		DESIGNED BY:	S. LAMPHERE	CHECKED BY:	C. LATHROP
		PLAN SHEET 53		SHEET	79 OF 211