
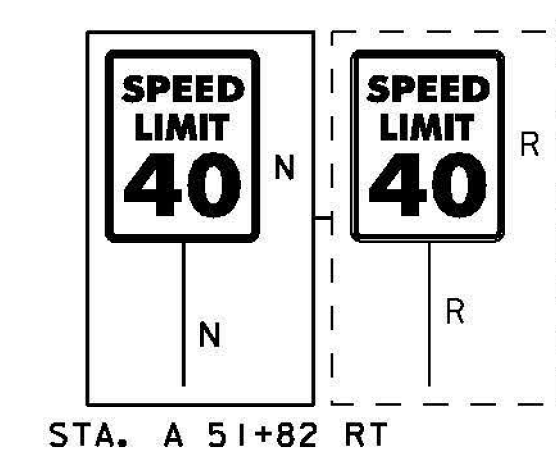
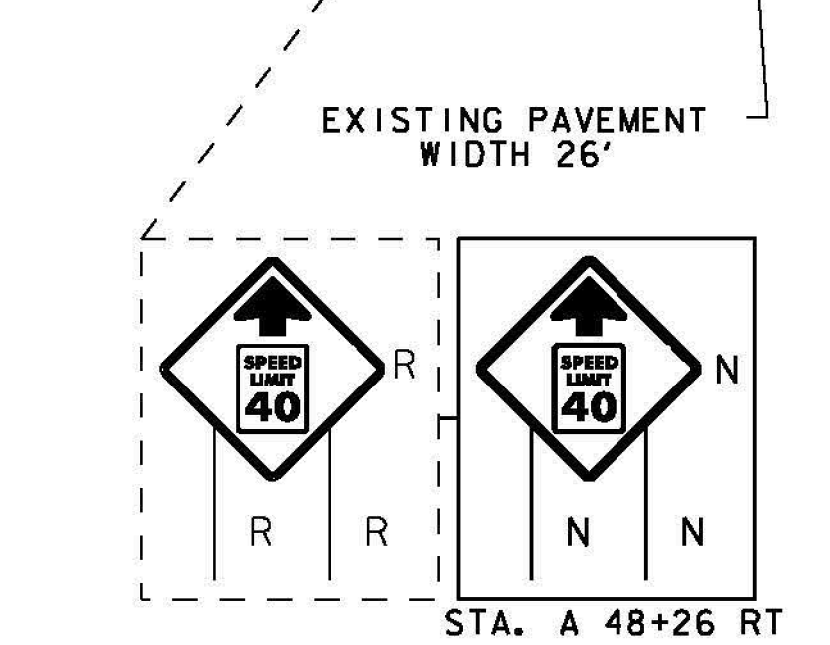


MATCHLINE STA. A 46+50 SEE PREVIOUS SHEET

MATCHLINE STA. A 52+25 SEE NEXT SHEET

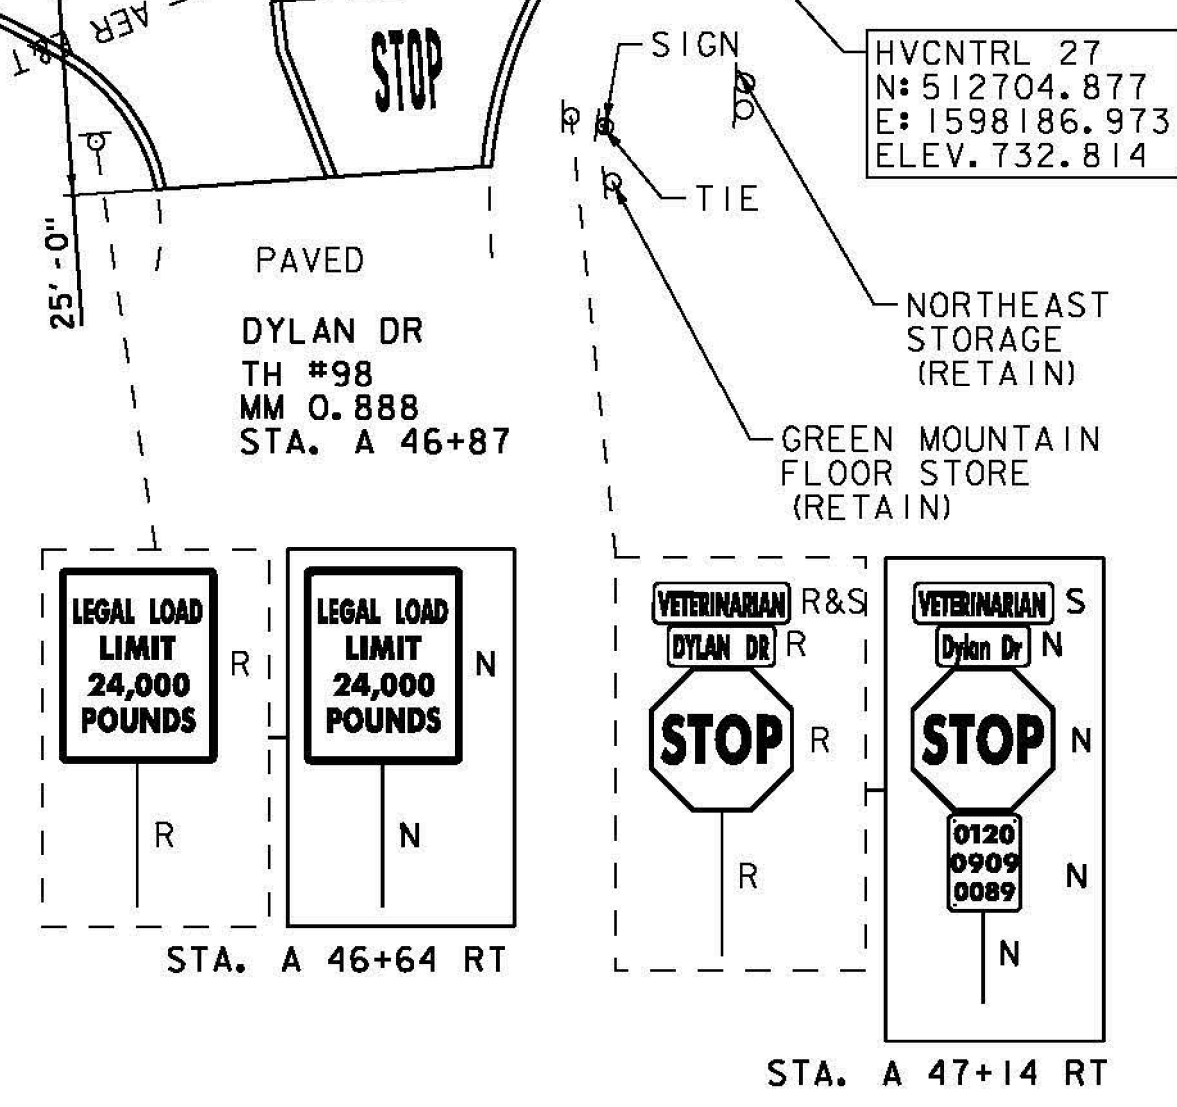

**SIGN LEGEND**  
 R = REMOVE  
 R&S = REMOVE AND SALVAGE  
 RET = RETAIN  
 S = SALVAGED  
 N = NEW  
 B-B = BACK TO BACK  
 - - = EXISTING  
 — = NEW

**STONE FILL, TYPE I**  
 STA. A 49+00 - STA. A 50+40 RT  
 STA. A 49+30 - STA. A 50+30 LT

**GEOTEXTILE FOR SILT FENCE**  
 STA. A 49+00 - STA. A 50+40 RT  
 STA. A 49+30 - STA. A 50+30 LT

**GRUBBING MATERIAL (6")**  
 STA. A 49+00 - STA. A 50+40 RT  
 STA. A 49+30 - STA. A 50+30 LT

**REMOVING SIGNS**  
 AS SHOWN - 6

**ERECTING SALVAGED SIGNS**  
 AS SHOWN - 1

**DURABLE 4 INCH WHITE LINE, SEE OPTION ITEMS**  
 STA. A 46+50 - STA. A 52+25 (SOLID LT & RT)  
 (WITH EDGE LINE BREAKS AT TH#98)  
 STA. A 46+87 RT. (EDGE LINE AT TH#98)

**DURABLE 4 INCH YELLOW LINE, POLYUREA**  
 STA. A 46+50 - STA. A 52+25 (CENTERLINE)  
 (WITH CENTERLINE BREAKS AT TH#98)  
 STA. A 46+87 RT. (CENTERLINE AT TH#98)

**DURABLE 24" STOP BAR (SEE OPTION ITEMS)**  
 STA. A 46+83 - STA. A 47+11 RT

**DURABLE LETTER OR SYMBOL (SEE OPTION ITEMS)**  
 STA. A 46+97 RT "STOP"

**TEMPORARY 4 INCH WHITE LINE, PAINT**  
 STA. A 46+50 - STA. A 52+25 (SOLID LT & RT)  
 (WITH EDGE LINE BREAKS AT TH#98)  
 STA. A 46+87 RT. (EDGE LINE AT TH#98)

**TEMPORARY 4 INCH YELLOW LINE, PAINT**  
 STA. A 46+50 - STA. A 52+25 (CENTERLINE)  
 (WITH CENTERLINE BREAKS AT TH#98)  
 STA. A 46+87 RT. (CENTERLINE AT TH#98)


**TEMPORARY 24" STOP BAR, PAINT**  
 STA. A 46+83 - STA. A 47+11 RT

**TEMPORARY LETTER OR SYMBOL, PAINT**  
 STA. A 46+97 RT "STOP"

**6 INCH UNDERDRAIN PIPE**  
 STA. A 46+50 - STA. A 49+00 LT  
 STA. A 50+50 - STA. A 52+25 LT  
 51+05

ENVIRONMENTALLY SENSITIVE LOCATIONS:

NO.	LIMITS	POS.	TYPE
14.	STA. A 49+22 - STA. A 50+18	LT	-

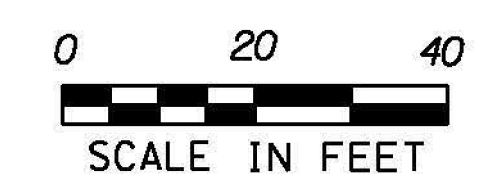

PROJECT NAME:	BETHEL-RANDOLPH	FILE NAME:	z10c244bdr.dgn	PLOT DATE:	4/23/2015
PROJECT NUMBER:	STP 292(I)	PROJECT LEADER:	C. LATHROP	DRAWN BY:	S. LAMPHERE
		DESIGNED BY:	S. LAMPHERE	CHECKED BY:	C. LATHROP
		PLAN SHEET 54		SHEET	80 OF 211