


A CURVE #12
 DELTA = 28°26'37"
 D = 2°58'35" (1) D = 1°53'39" (2)
 R = 1925.00' (1) R = 3025.00' (2)
 T = 502.46' (1) T = 598.47' (2)
 L = 739.21' (1) L = 340.09' (2)
 E = 64.49'
 BANKING 0.038 FT/FT, 0.026 FT/FT
 DESIGN SPEED 40 MPH
 SEE SUPERELEVATION DIAGRAMS
 FOR MORE INFORMATION

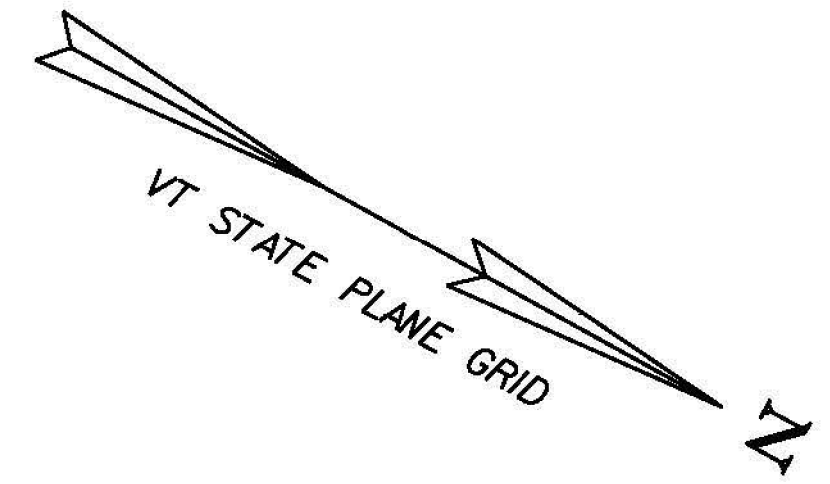

MATCHLINE STA. A 63+50 SEE PREVIOUS SHEET

MATCHLINE STA. A 68+75 SEE NEXT SHEET

DURABLE 24" STOP BAR (SEE OPTION ITEMS)
 STA. A 67+85 - STA. A 68+07 LT

TEMPORARY 24" STOP BAR, PAINT
 STA. A 67+85 - STA. A 68+07 LT

REMOVAL AND DISPOSAL OF GUARDRAIL
 STA. A 63+50 - STA. A 65+38.5 RT
 STA. A 63+50 - STA. A 66+87 LT

DURABLE LETTER OR SYMBOL (SEE OPTION ITEMS)
 STA. A 67+98 LT "STOP"

TEMPORARY LETTER OR SYMBOL, PAINT
 STA. A 67+98 LT "STOP"

SPECIAL PROVISION (BOX BEAM GUARDRAIL W/7 FEET POSTS)
 STA. A 63+50 - STA. A 65+37 RT
 STA. A 63+50 - STA. A 67+55 LT
 67+06

STONE FILL, TYPE 1
 STA. A 67+00 - STA. A 68+00 RT

REMOVING SIGNS
 AS SHOWN - 6

SIGN LEGEND

- R = REMOVE
- R&S = REMOVE AND SALVAGE
- RET = RETAIN
- S = SALVAGED
- N = NEW
- B-B = BACK TO BACK
- = EXISTING
- = NEW

DURABLE 4 INCH WHITE LINE, SEE OPTION ITEMS
 STA. A 63+50 - STA. A 68+75 (SOLID LT & RT)
 (WITH EDGE LINE BREAKS AT TH#74)
 STA. A 68+05 LT. (EDGE LINE AT TH#74)

TEMPORARY 4 INCH WHITE LINE, PAINT
 STA. A 63+50 - STA. A 68+75 (SOLID LT & RT)
 (WITH EDGE LINE BREAKS AT TH#74)
 STA. A 68+05 LT. (EDGE LINE AT TH#74)

DURABLE 4 INCH YELLOW LINE, POLYUREA
 STA. A 63+50 - STA. A 68+75 (CENTERLINE)
 (WITH CENTERLINE BREAKS AT TH#74)
 STA. A 68+05 LT. (CENTERLINE AT TH#74)

TEMPORARY 4 INCH YELLOW LINE, PAINT
 STA. A 63+50 - STA. A 68+75 (CENTERLINE)
 (WITH CENTERLINE BREAKS AT TH#74)
 STA. A 68+05 LT. (CENTERLINE AT TH#74)



PROJECT NAME:	BETHEL-RANDOLPH	PLOT DATE:	4/23/2015
PROJECT NUMBER:	STP 292(1)	DRAWN BY:	S. LAMPHERE
FILE NAME:	z10c244bdr.dgn	CHECKED BY:	C. LATHROP
DESIGNED BY:	S. LAMPHERE	SHEET	83 OF 211
PLAN SHEET	57		