




130+50

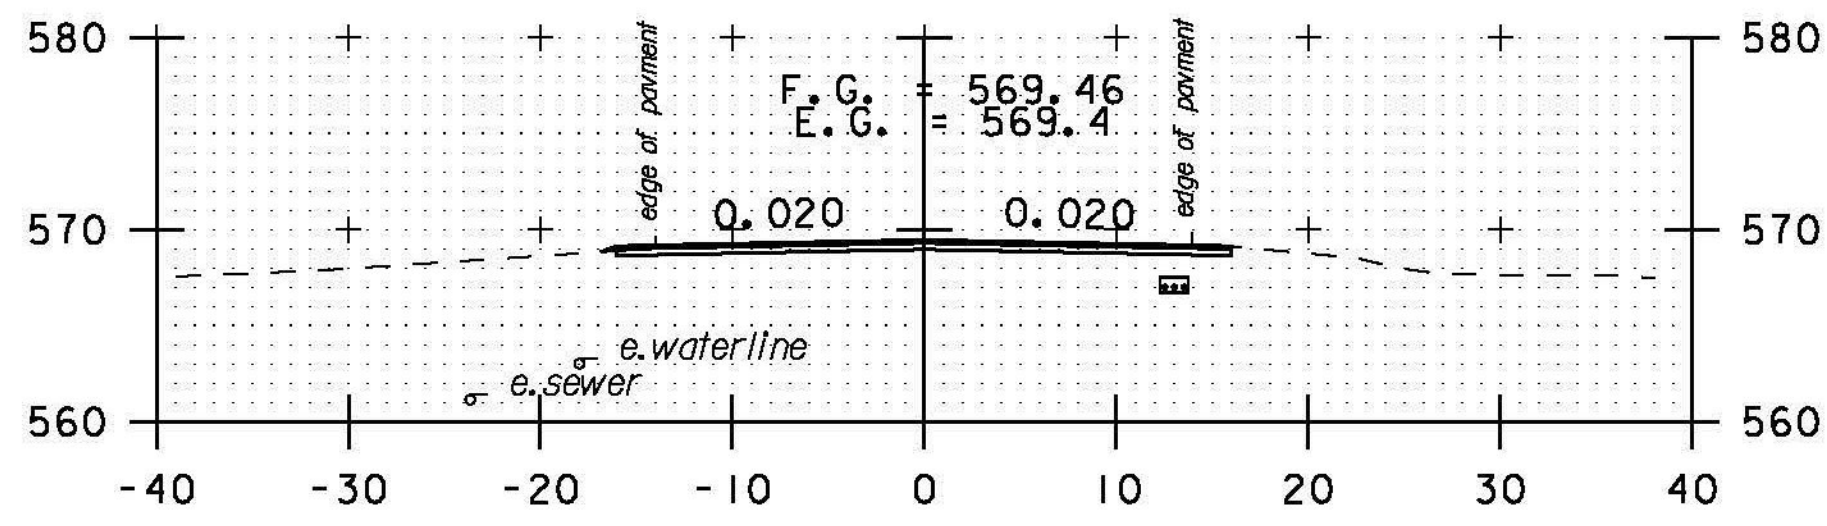


132+50

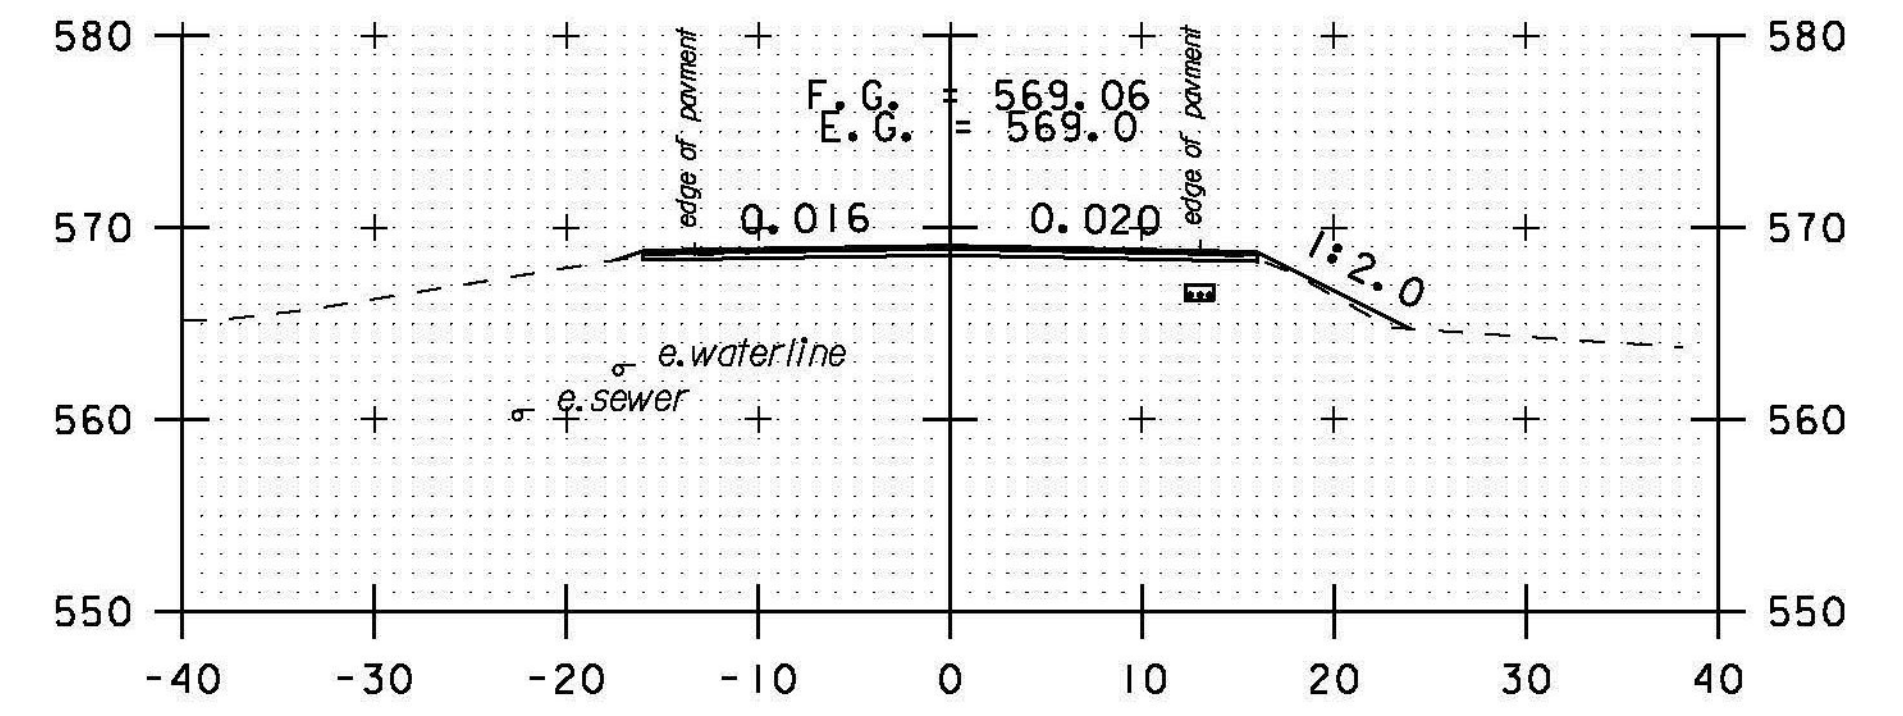


134+50

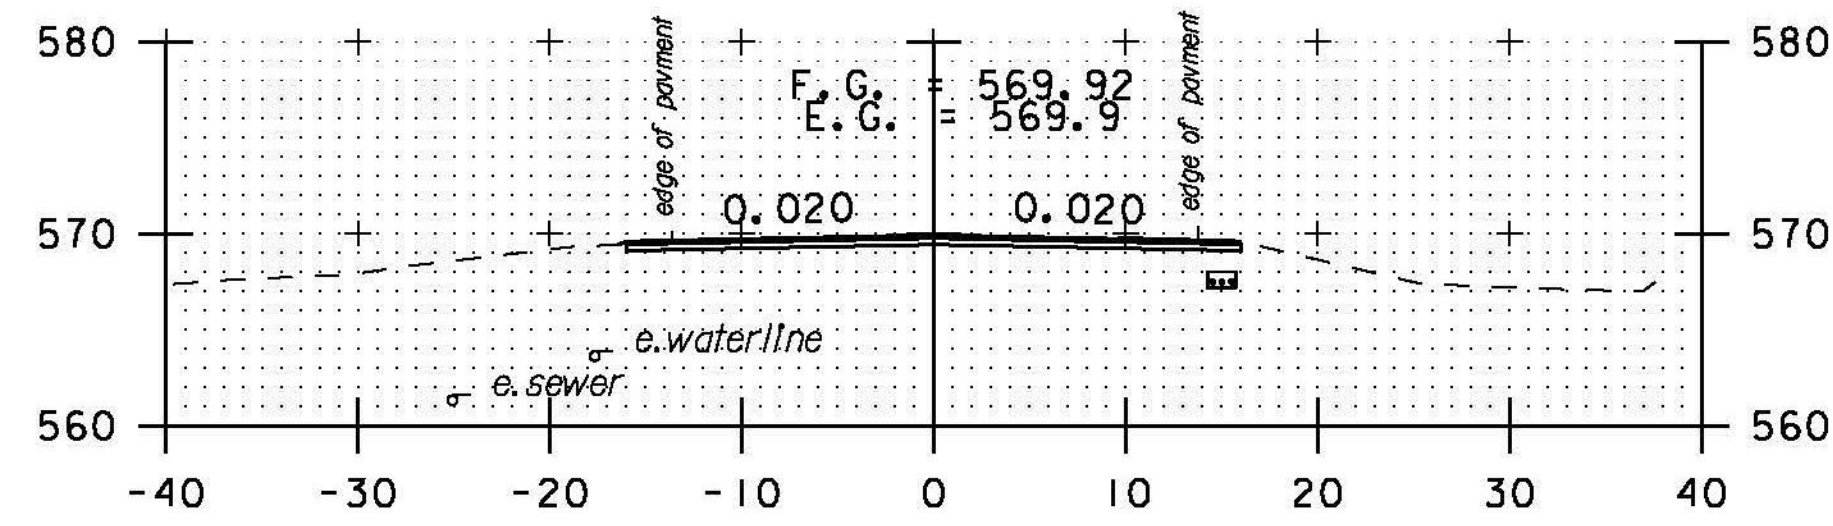


130+00

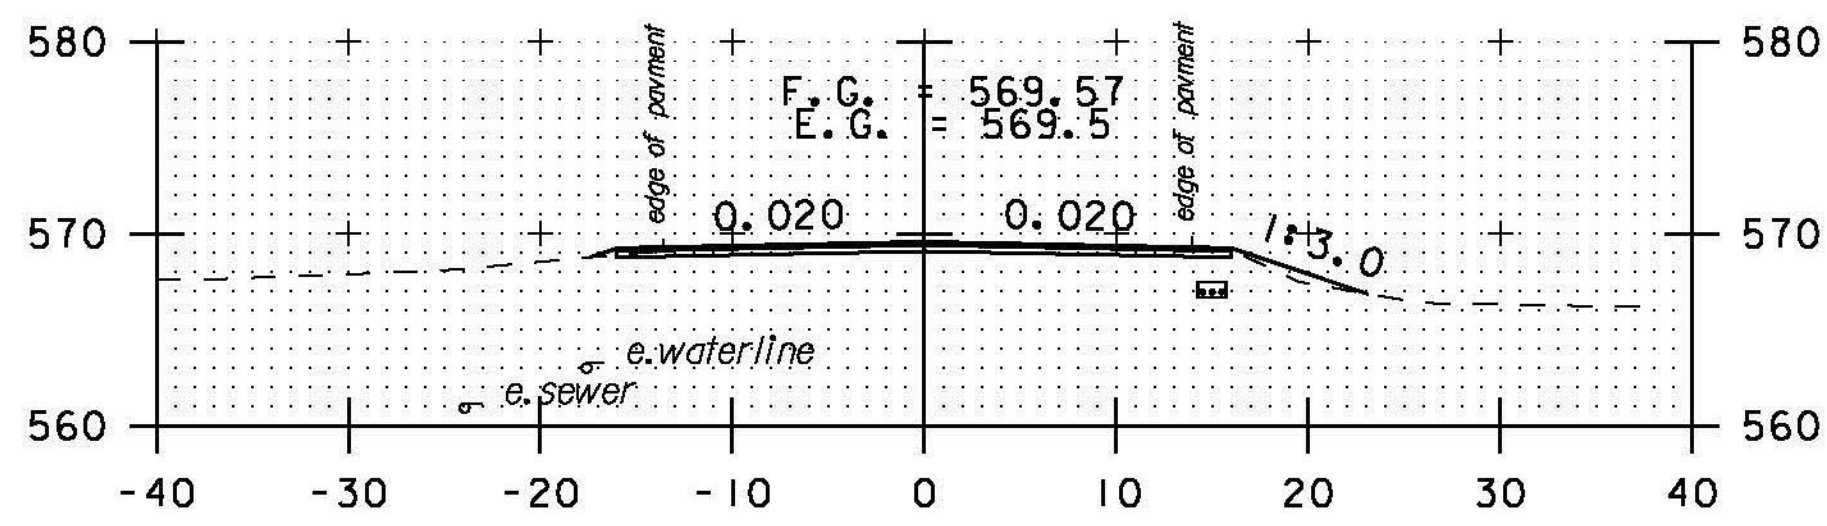


132+00

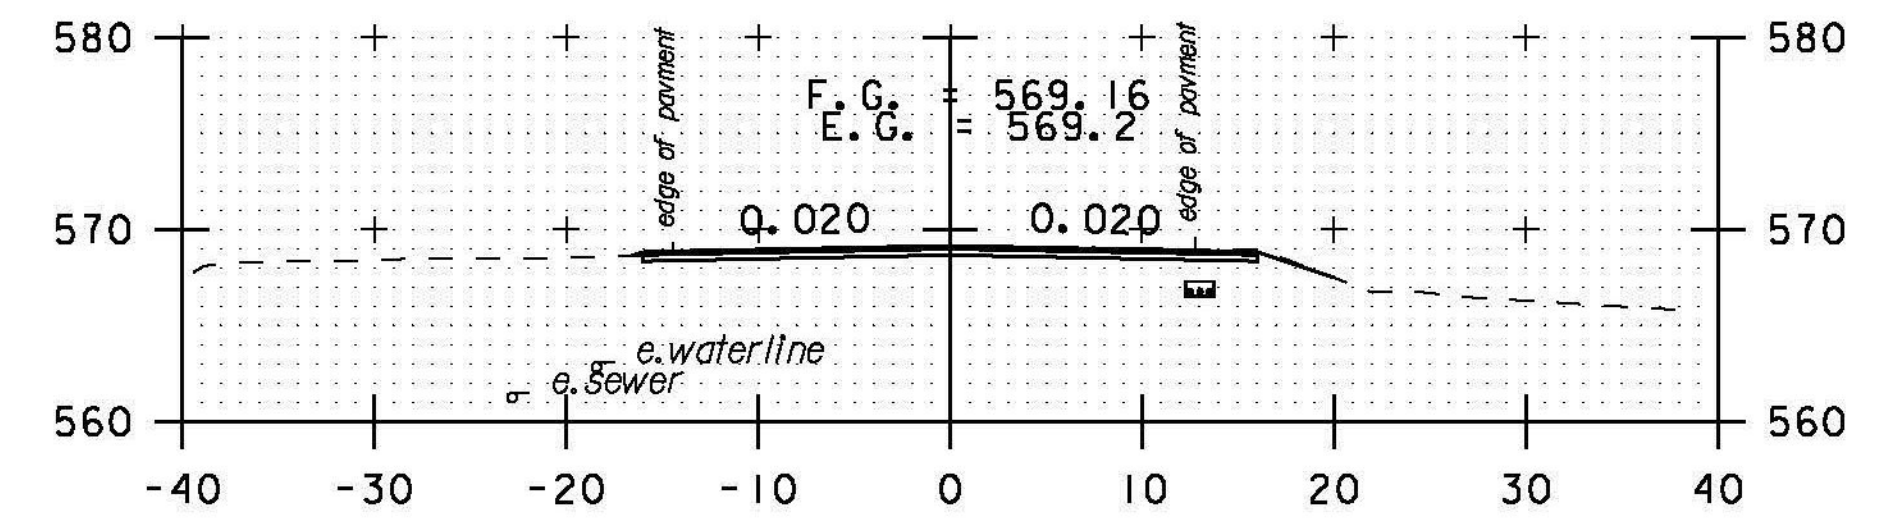


134+00

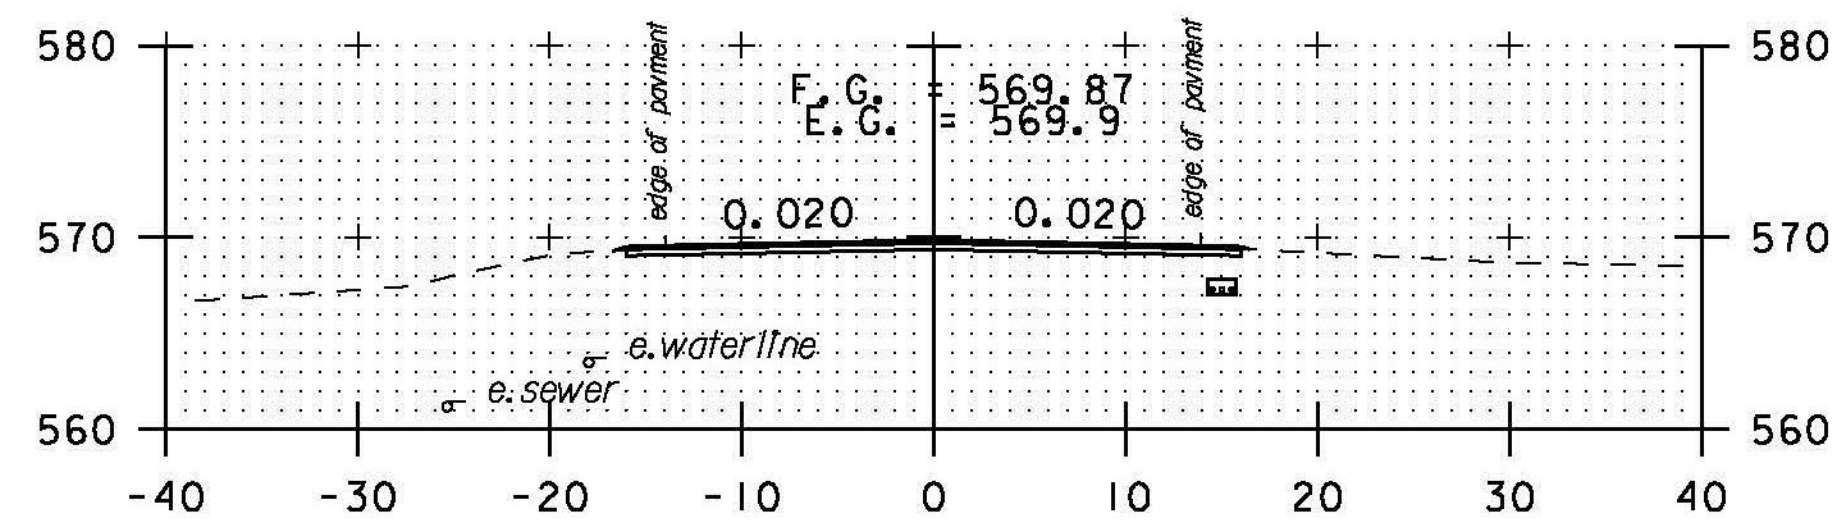


DRIVE RT
129+50

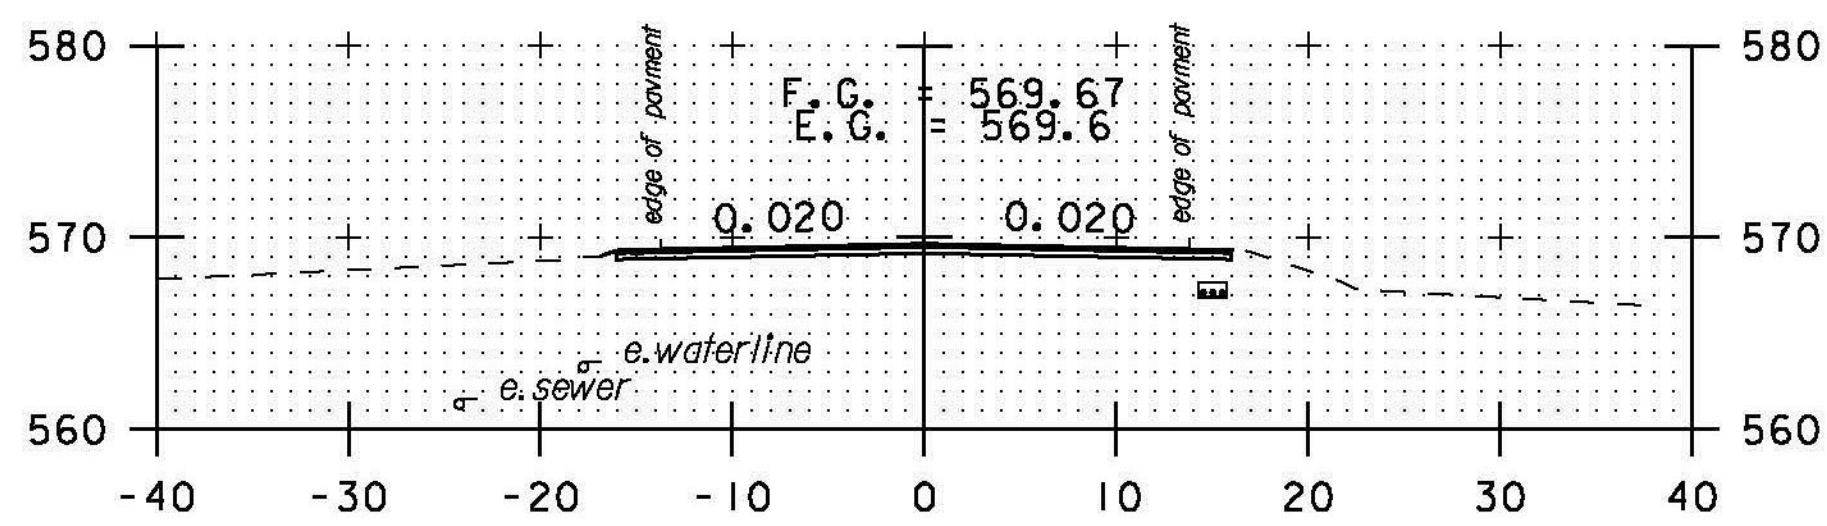


131+50

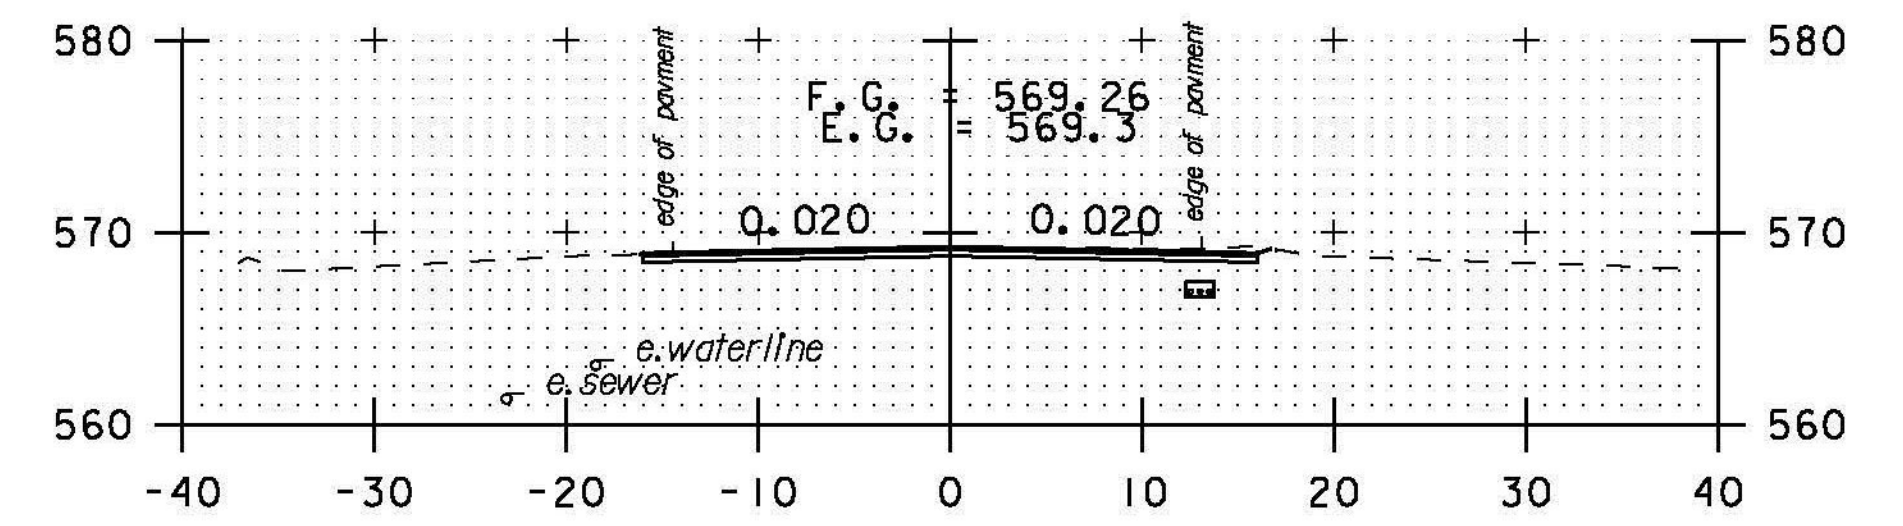


133+50

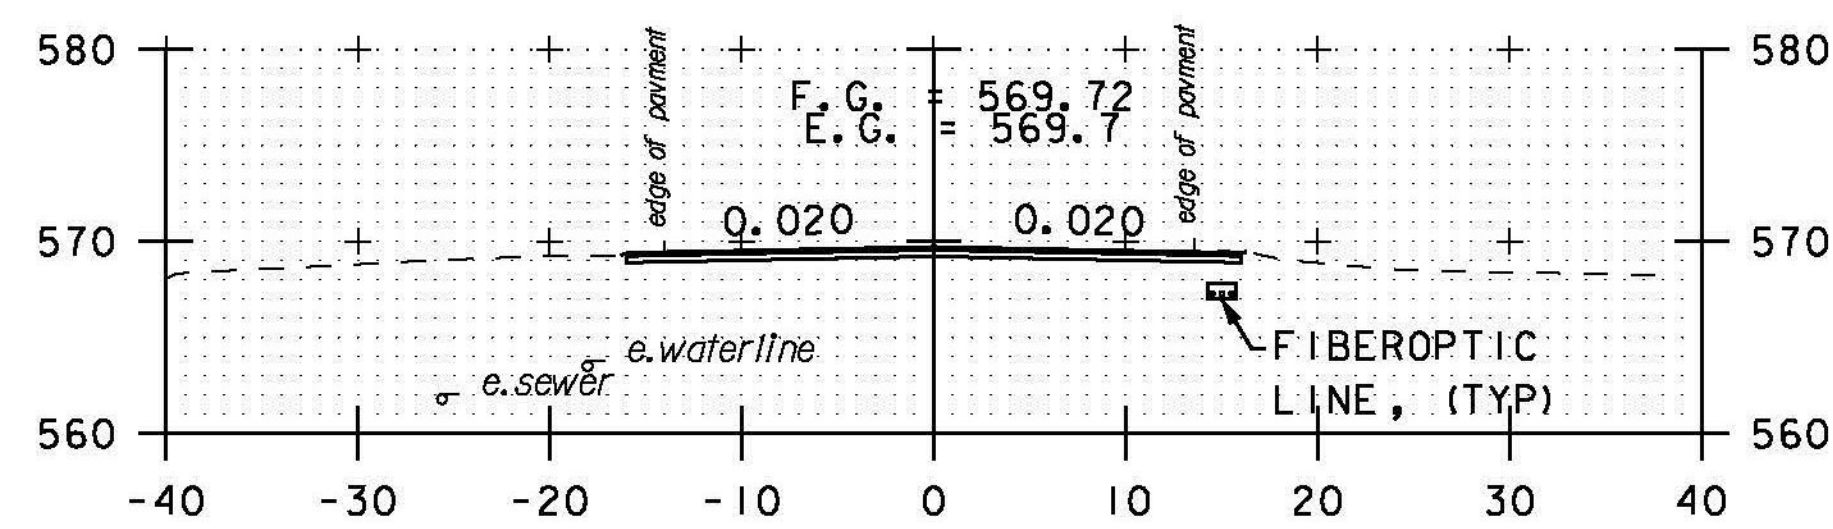

DRIVE LT
129+00

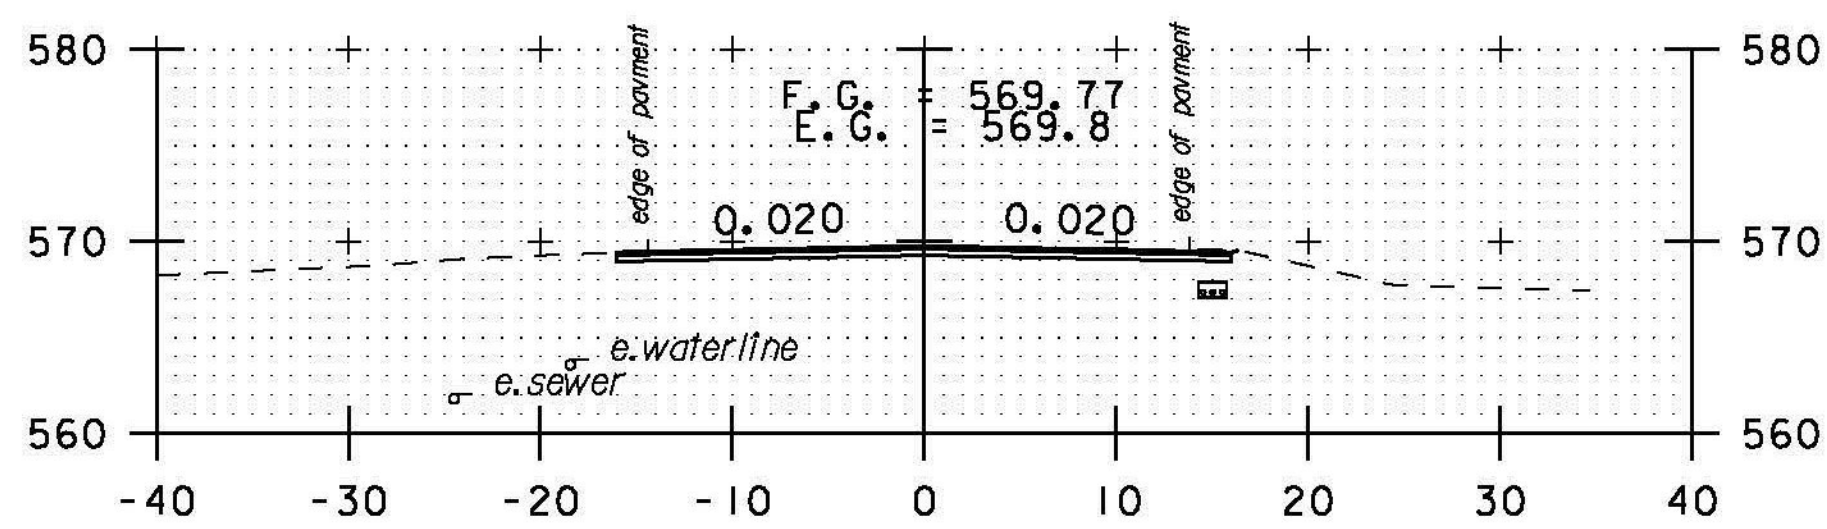


131+00

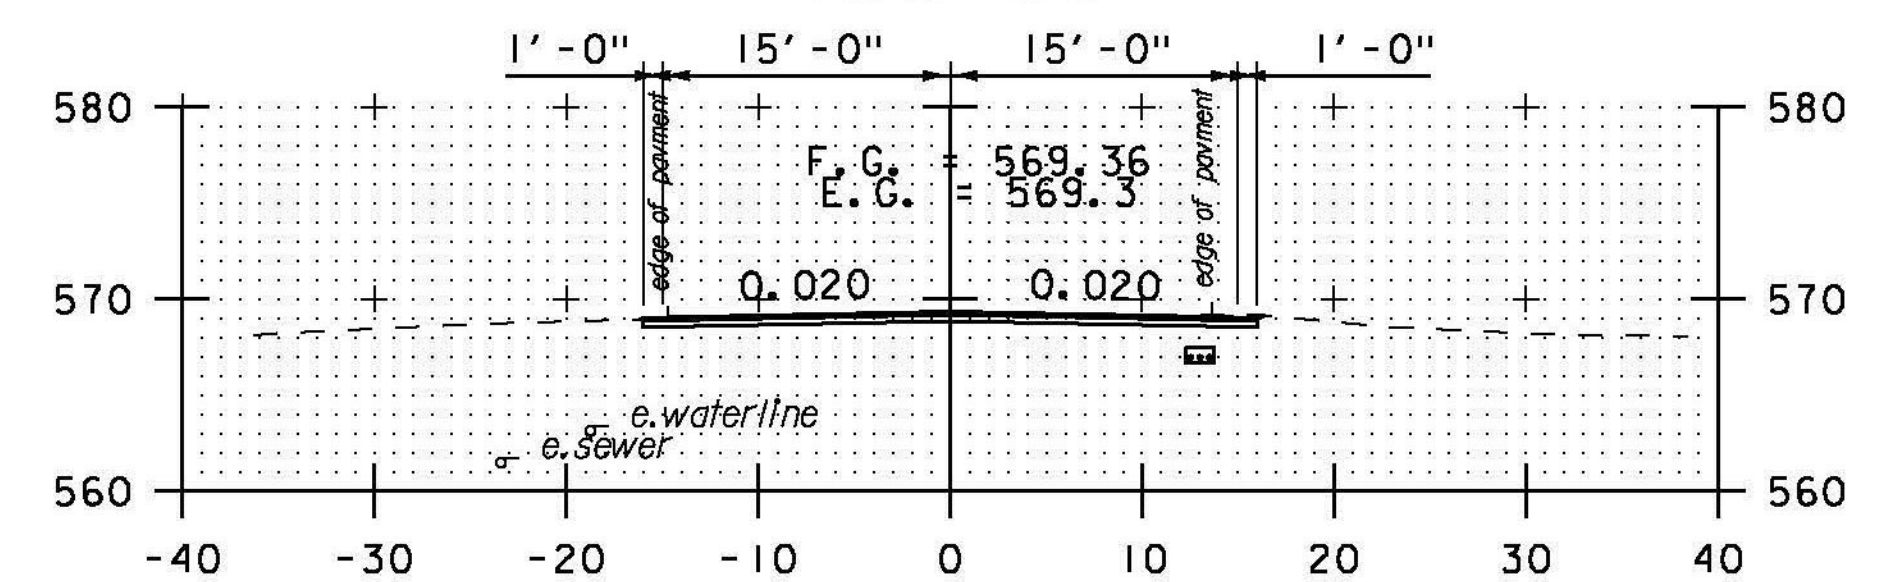

133+00

STA. 129+00 TO STA. 134+50

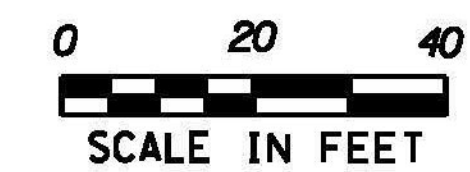

SCALE IN FEET

PROJECT NAME: BETHEL-RANDOLPH
PROJECT NUMBER: STP 292(I)

FILE NAME: piOC244.dgn
PROJECT LEADER: C. LATHROP
DESIGNED BY: S. LAMPHERE
CROSS SECTION SHEET 2

PLOT DATE: 4/23/2015
DRAWN BY: S. LAMPHERE
CHECKED BY: C. LATHROP
SHEET 136 OF 211