




136+50

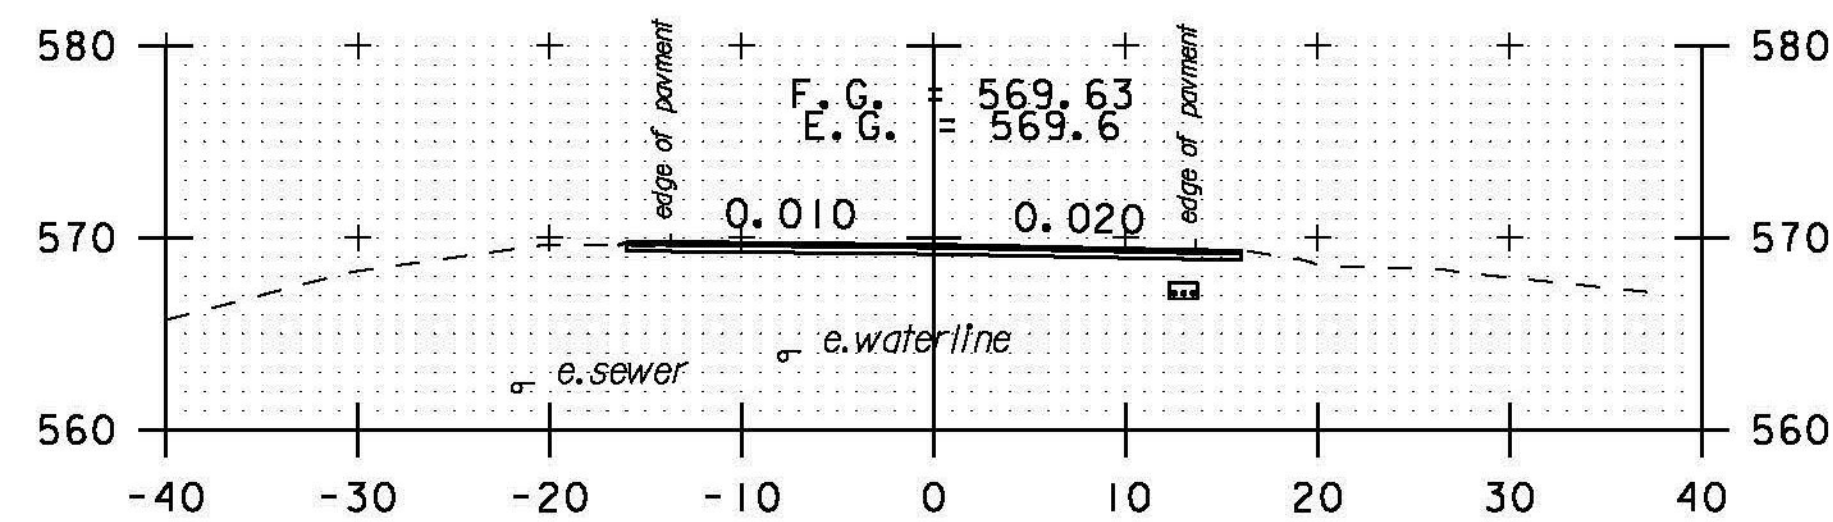


136+00

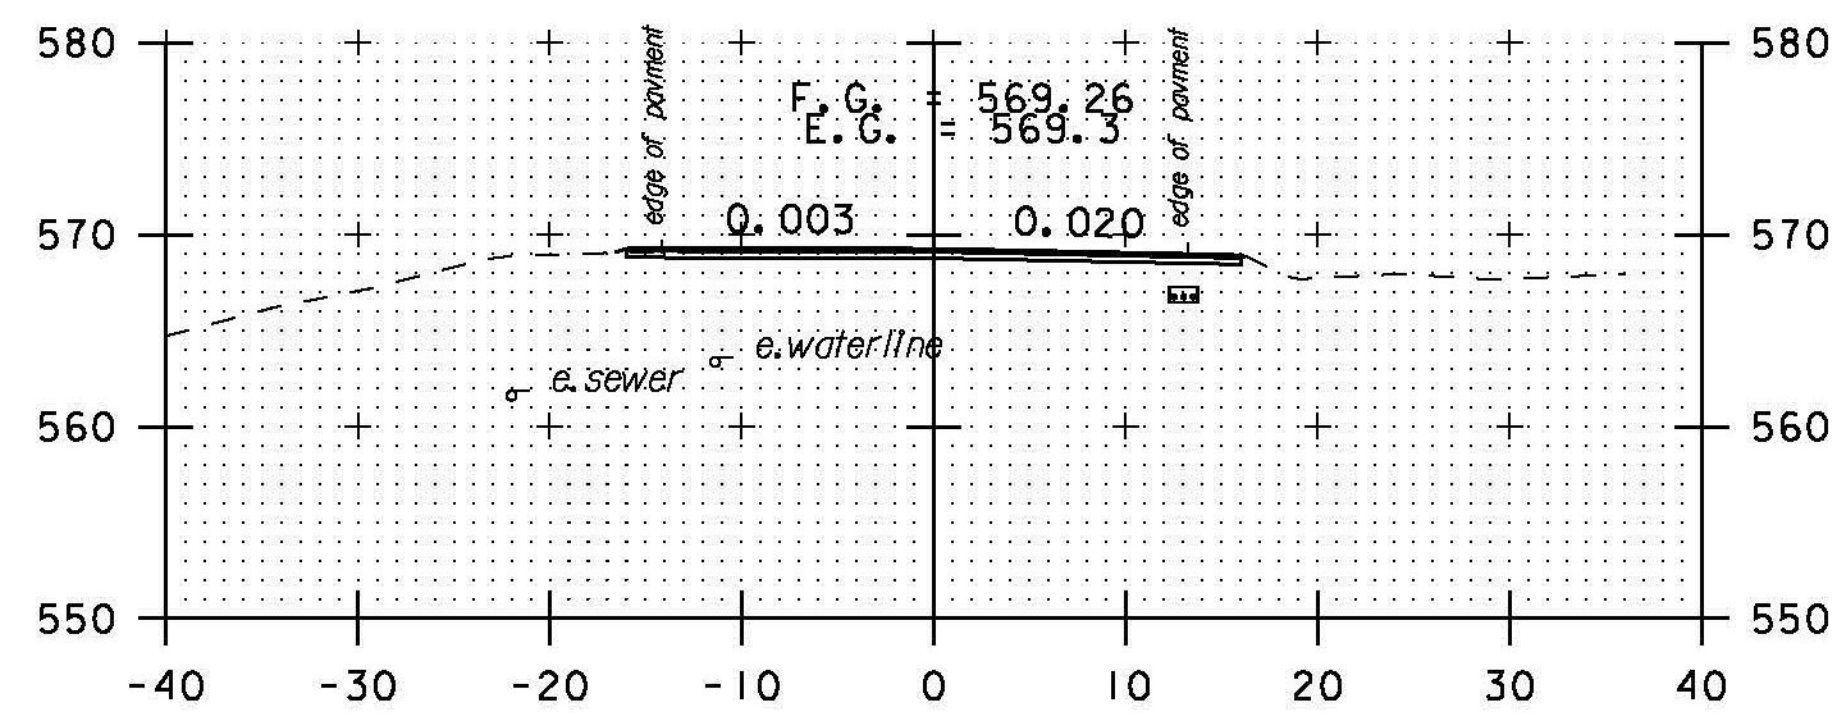


135+50

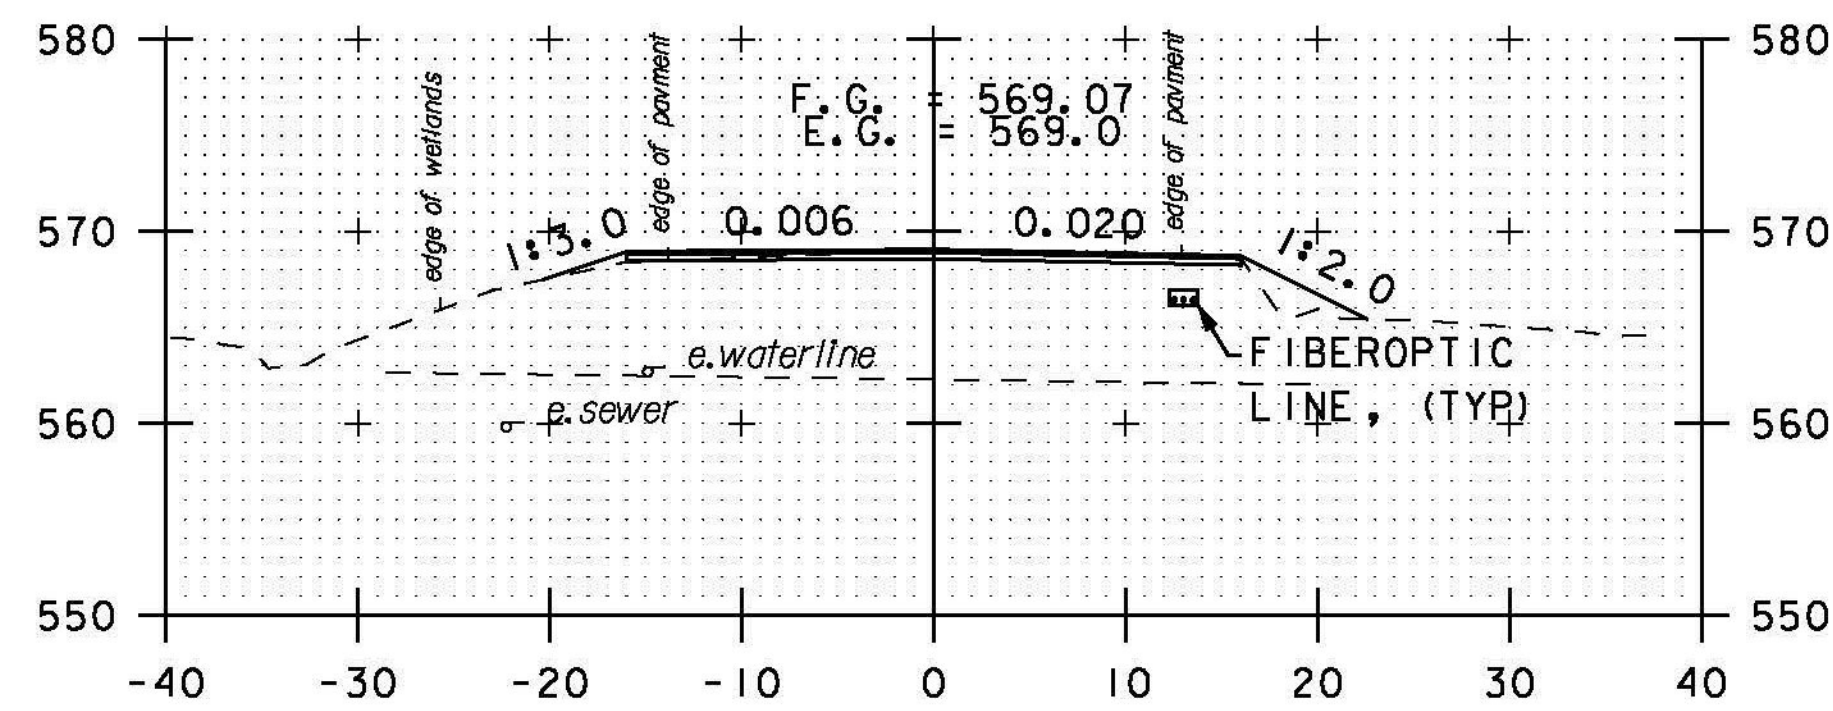

135+00

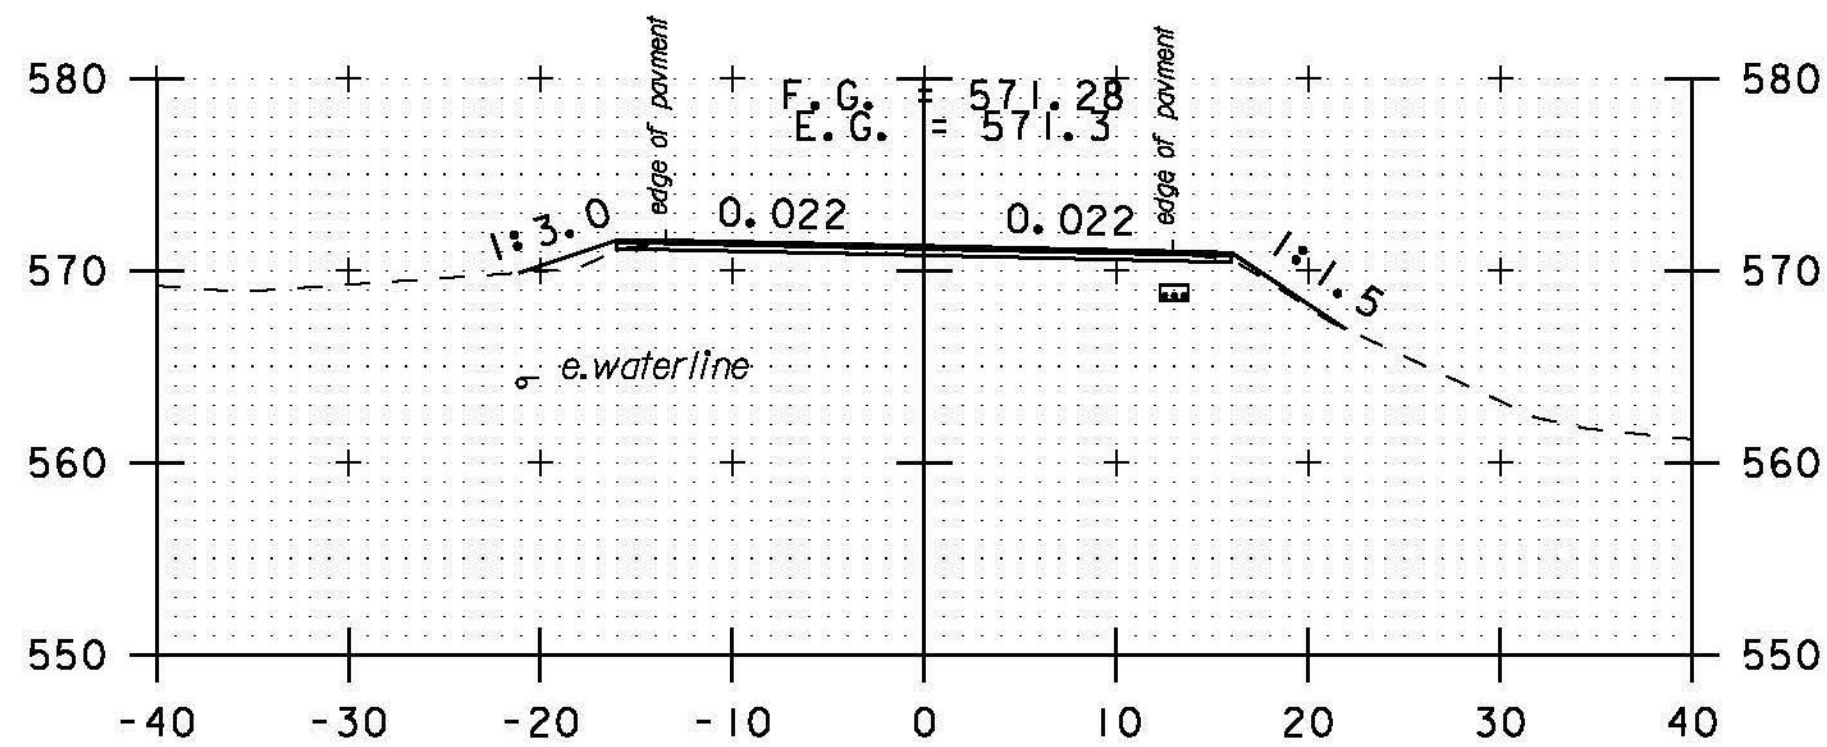


138+00

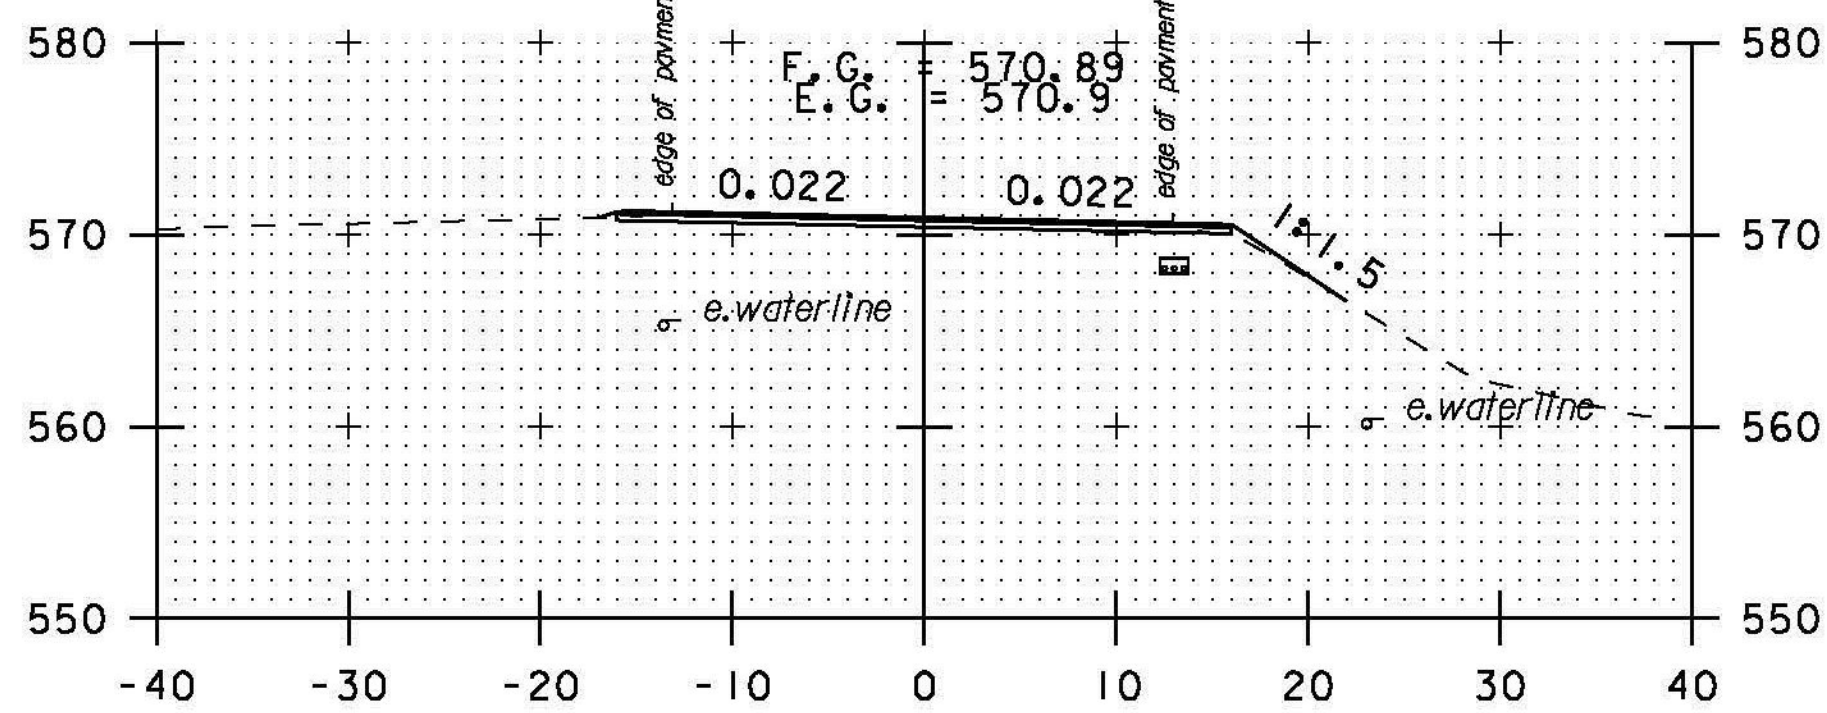


DRIVE LT


137+50

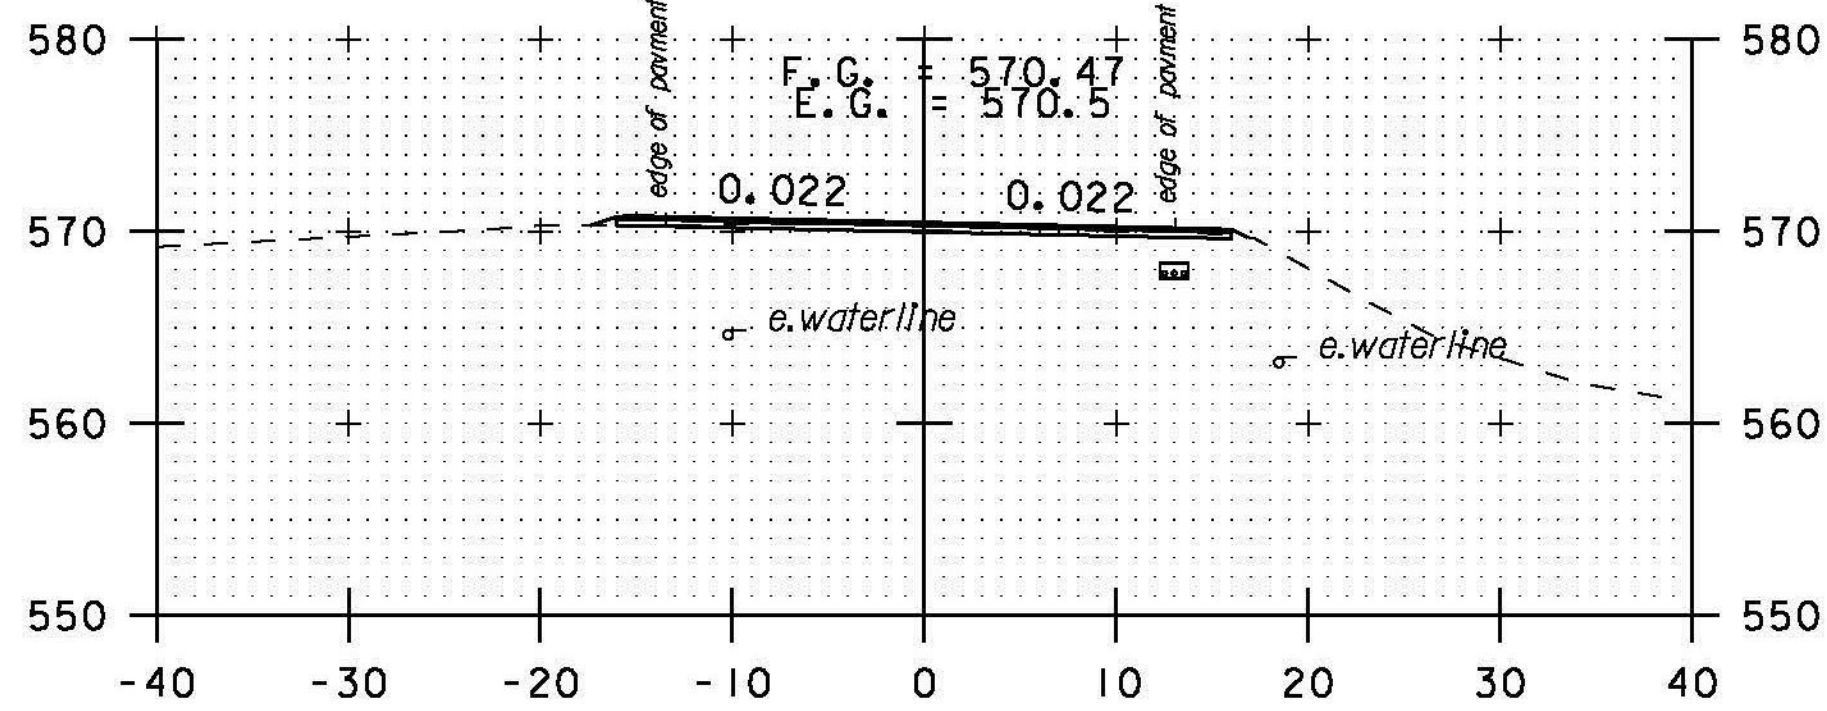


137+00

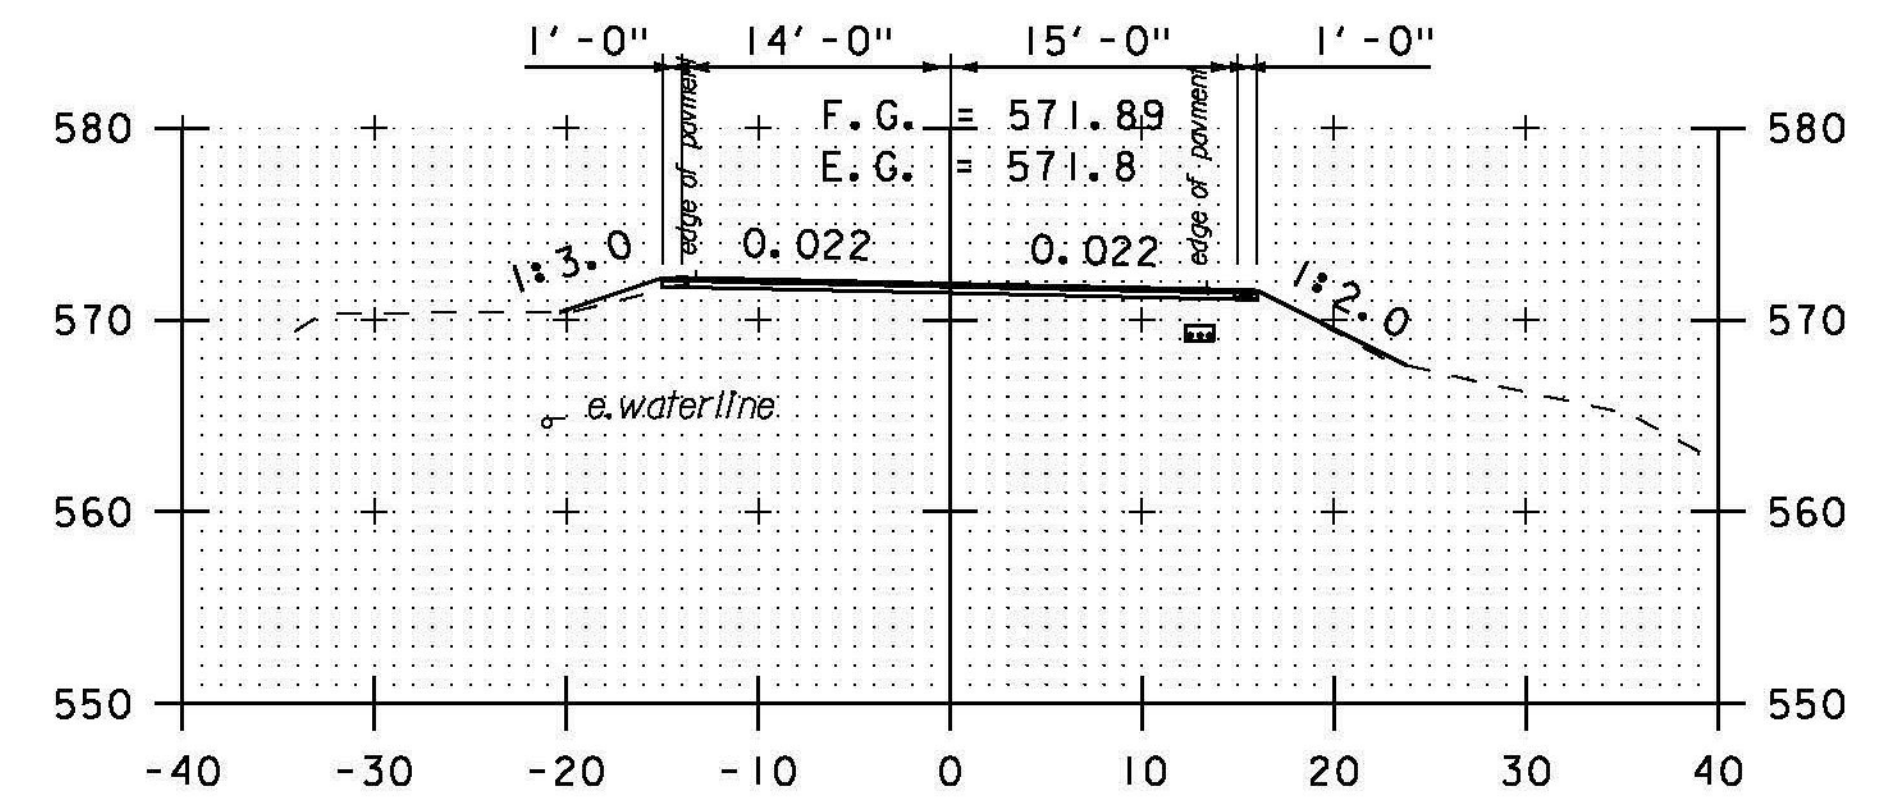


139+50

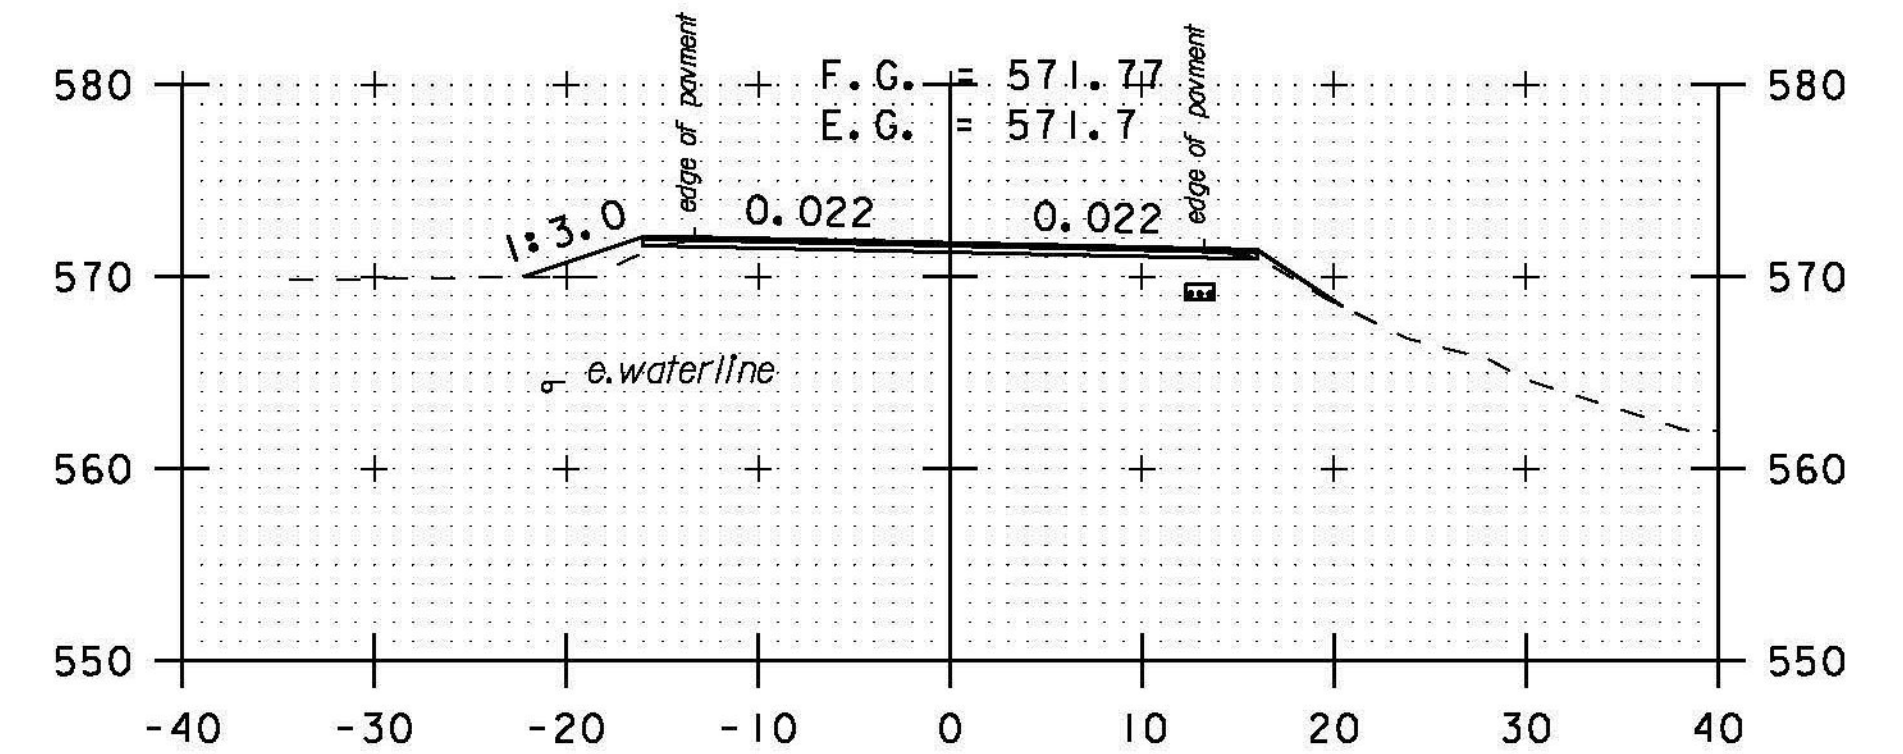

139+00

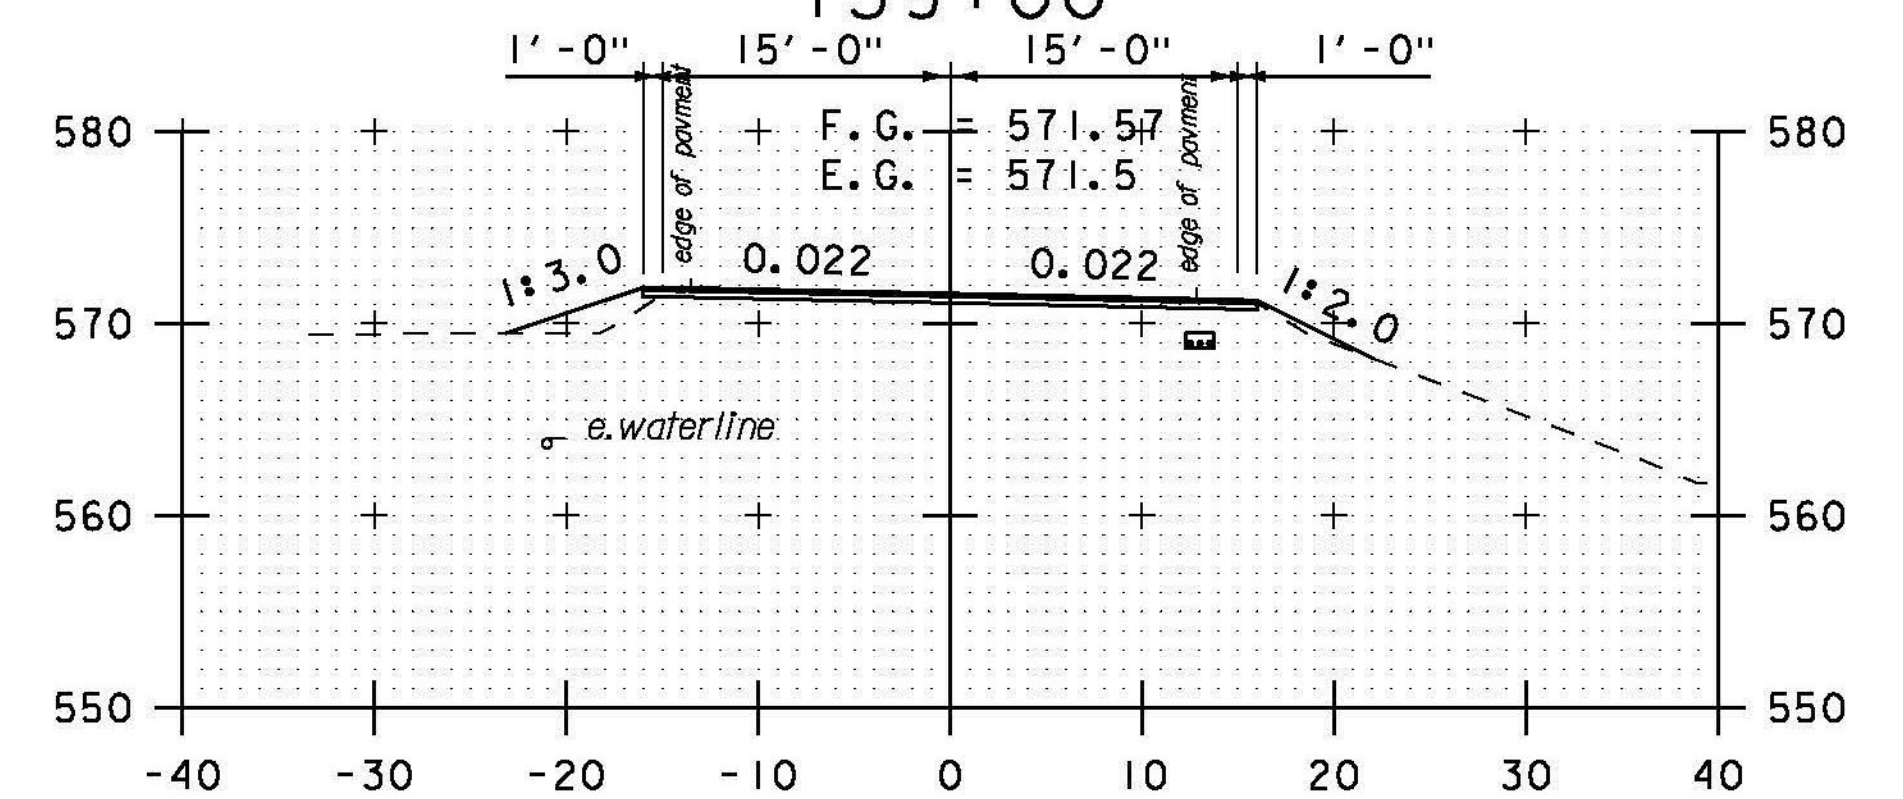

138+50

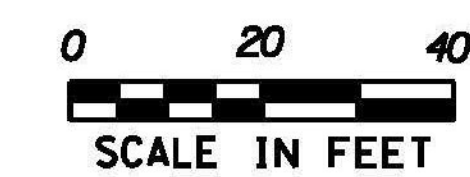

SCALE IN FEET

STA. 135+00 TO STA. 139+50

PROJECT NAME: BETHEL-RANDOLPH
PROJECT NUMBER: STP 292(I)

FILE NAME: piOC244.dgn
PROJECT LEADER: C. LATHROP
DESIGNED BY: S. LAMPHERE
CROSS SECTION SHEET 3

PLOT DATE: 4/23/2015
DRAWN BY: S. LAMPHERE
CHECKED BY: C. LATHROP
SHEET 137 OF 211