




146+50

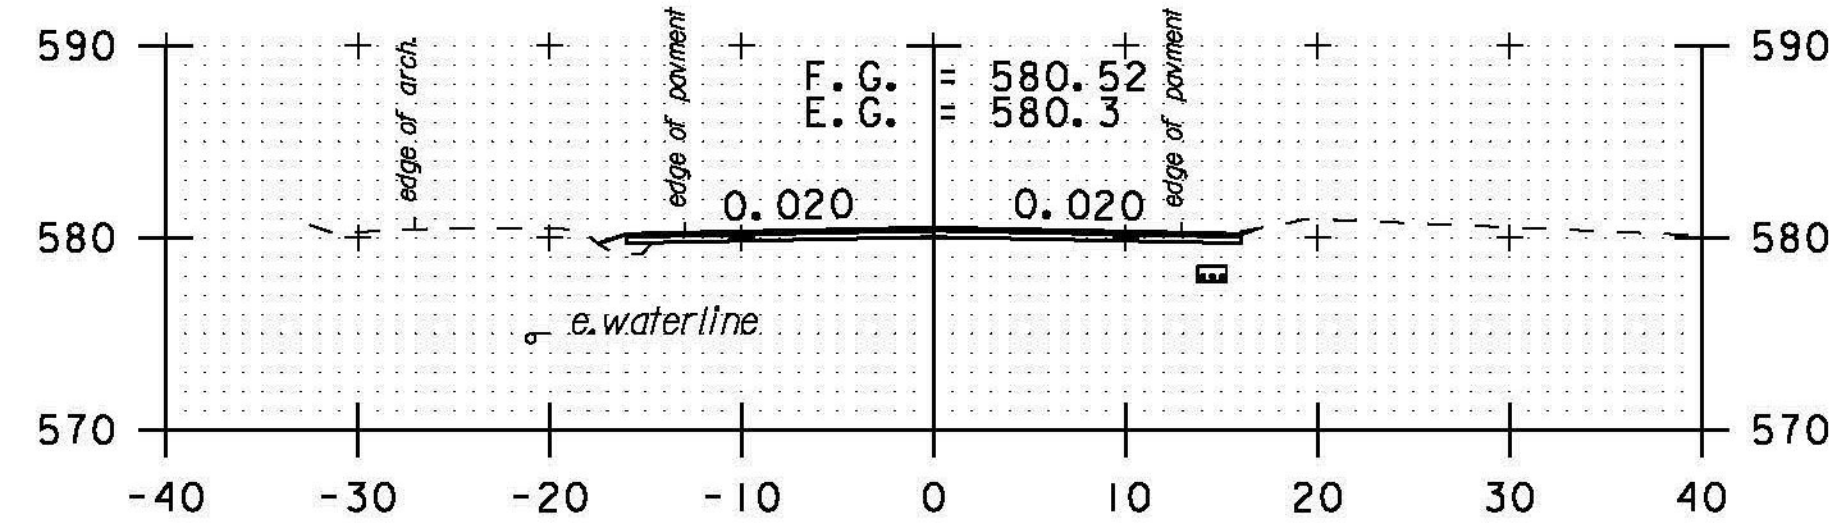


146+00

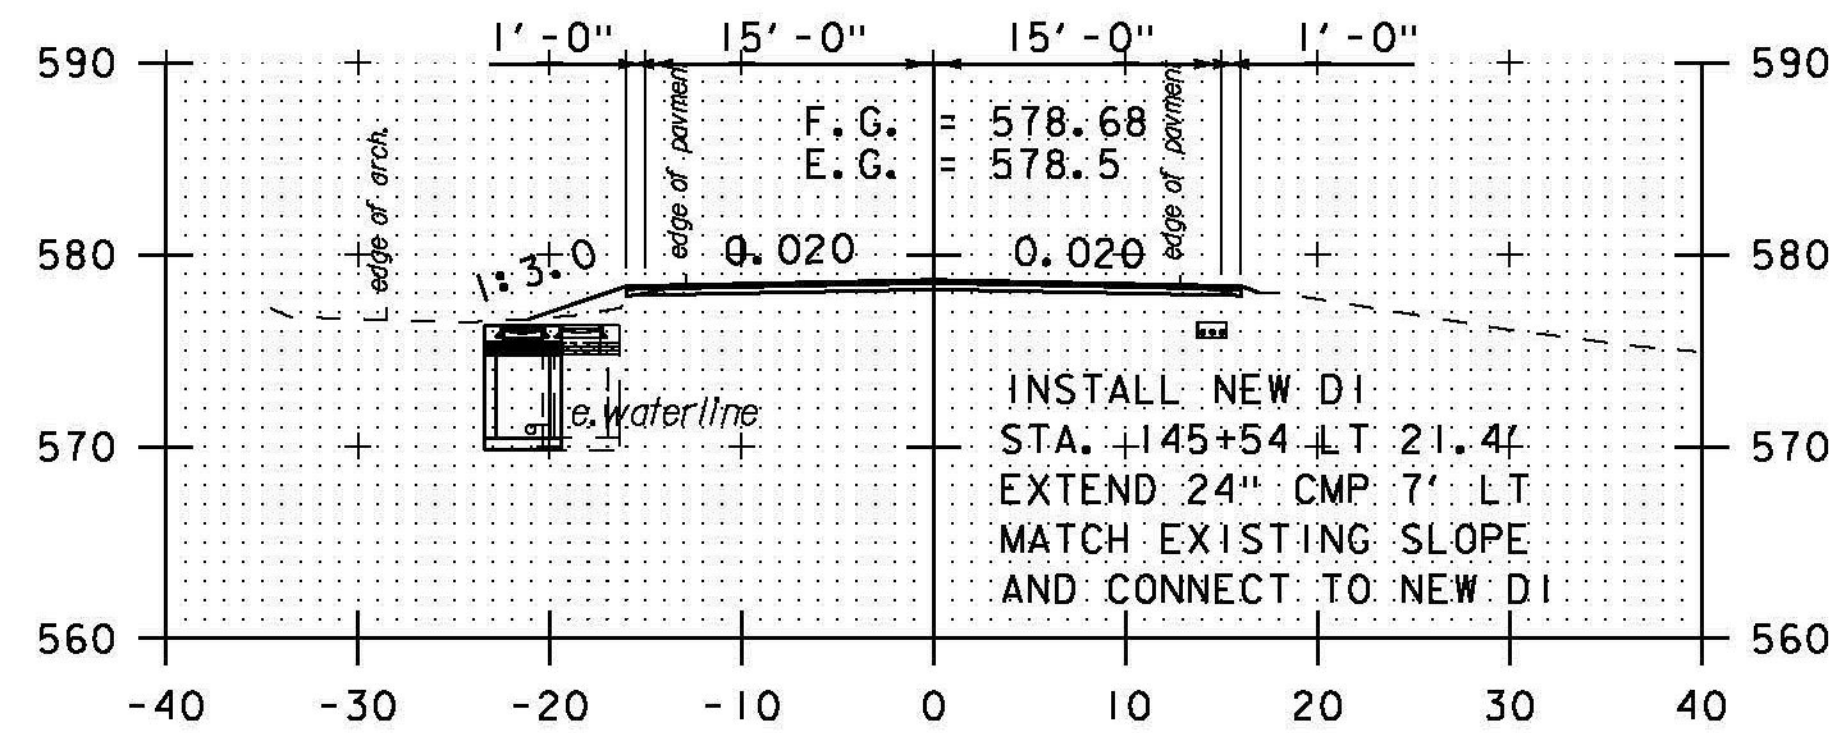


145+50

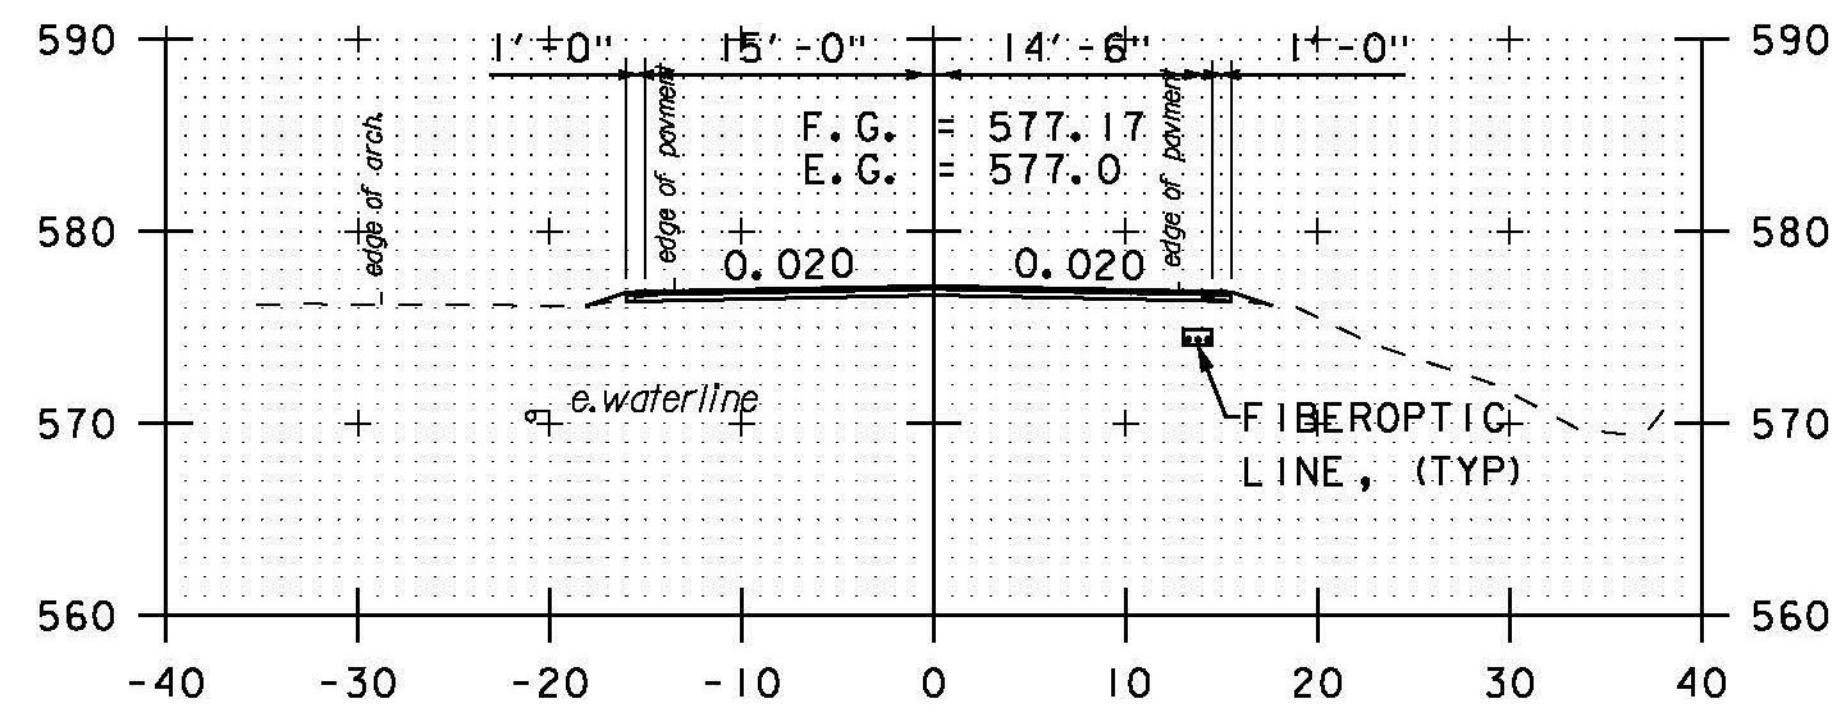


145+00

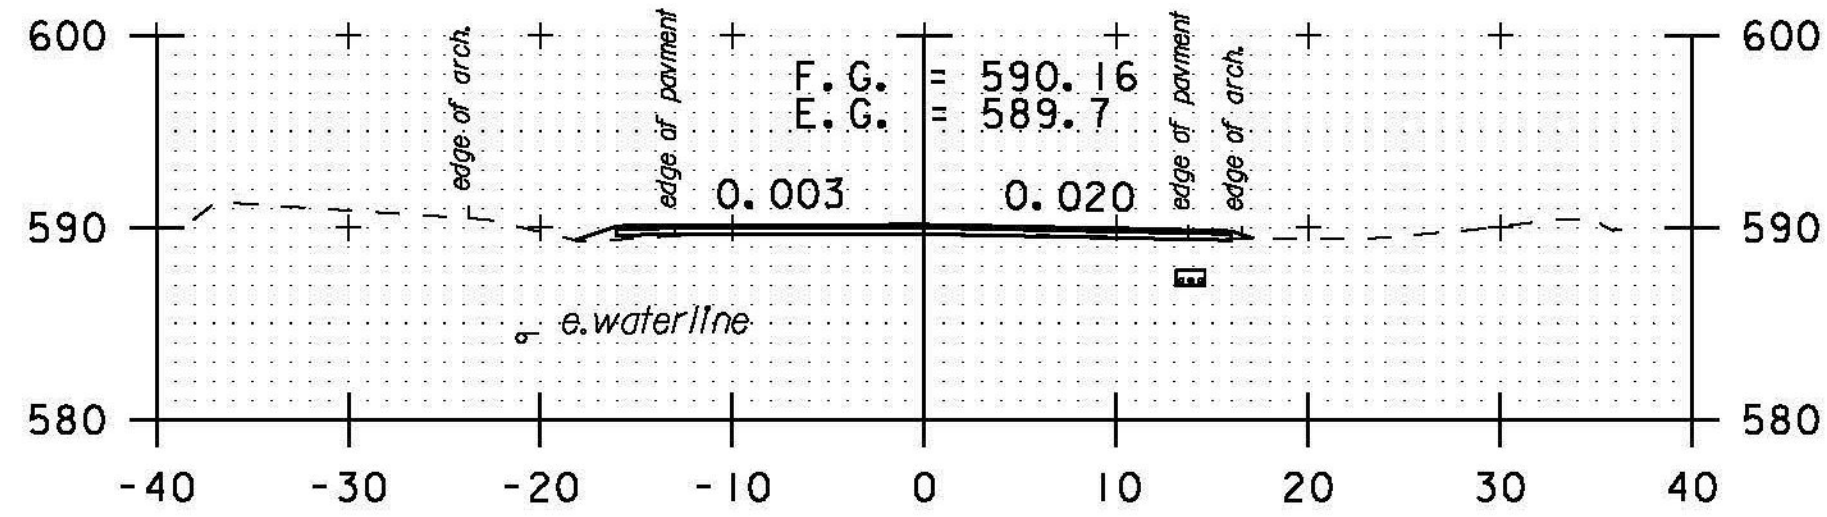


DRIVE RT
148+50

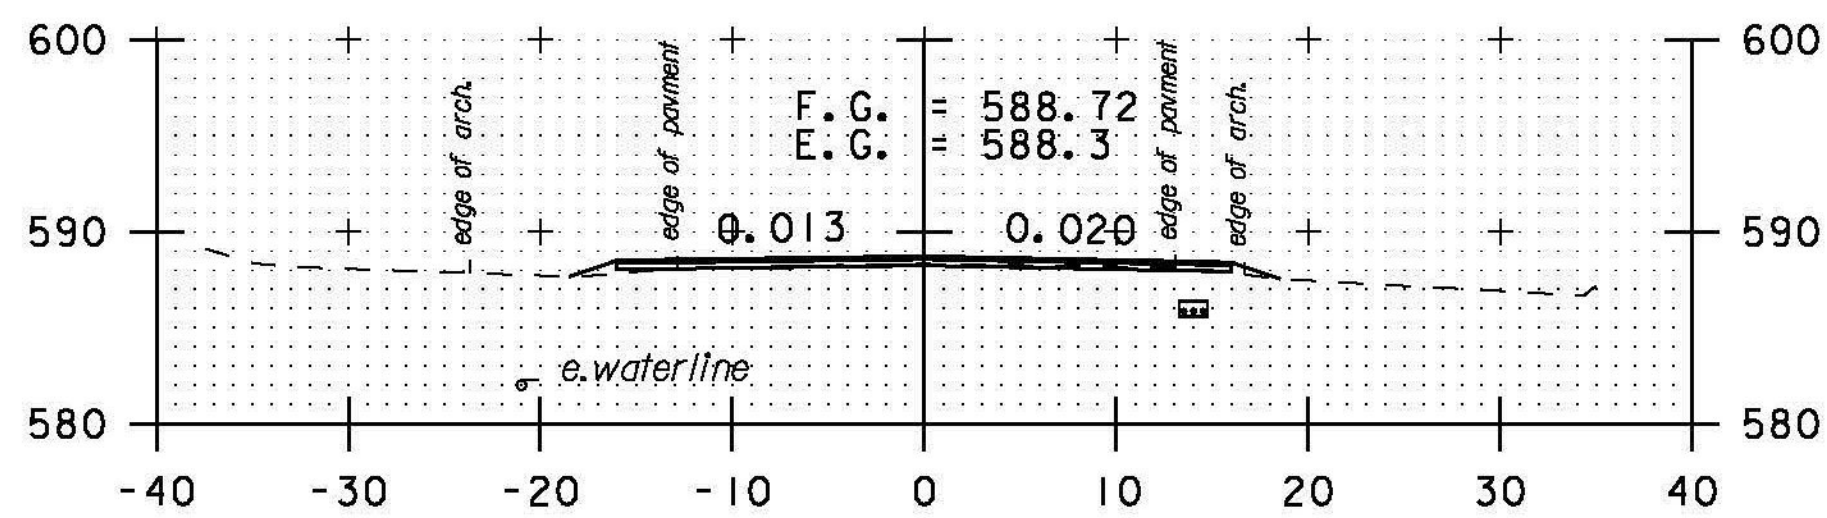


148+00

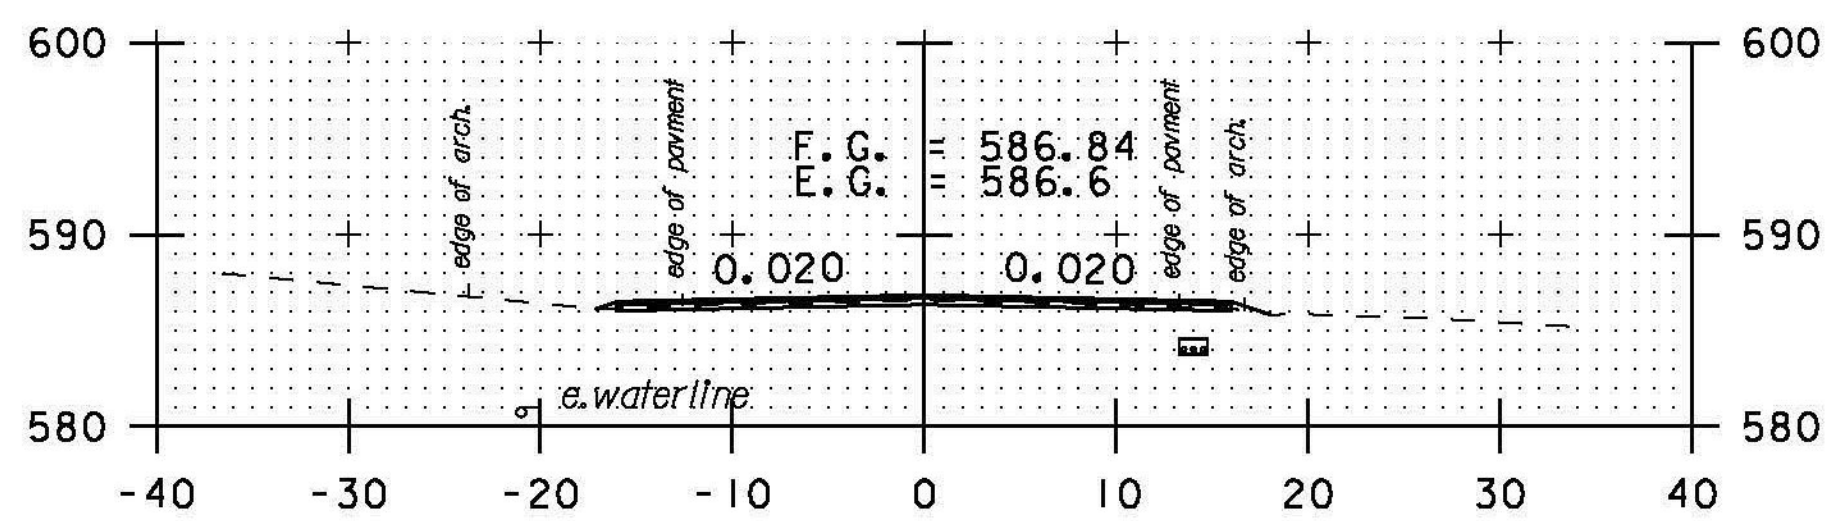


147+50

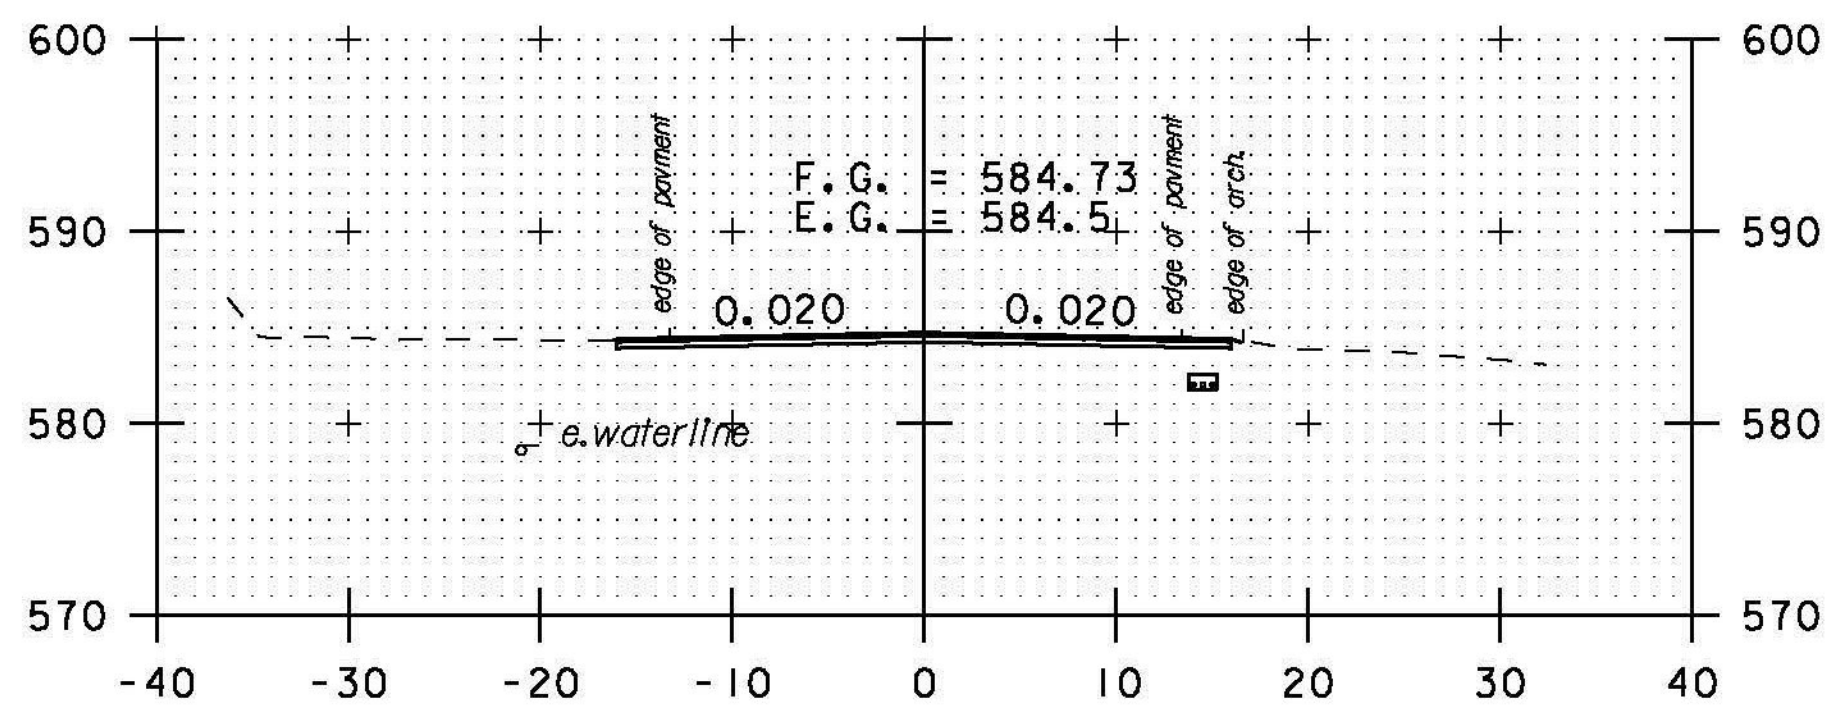


DRIVE LT
147+00

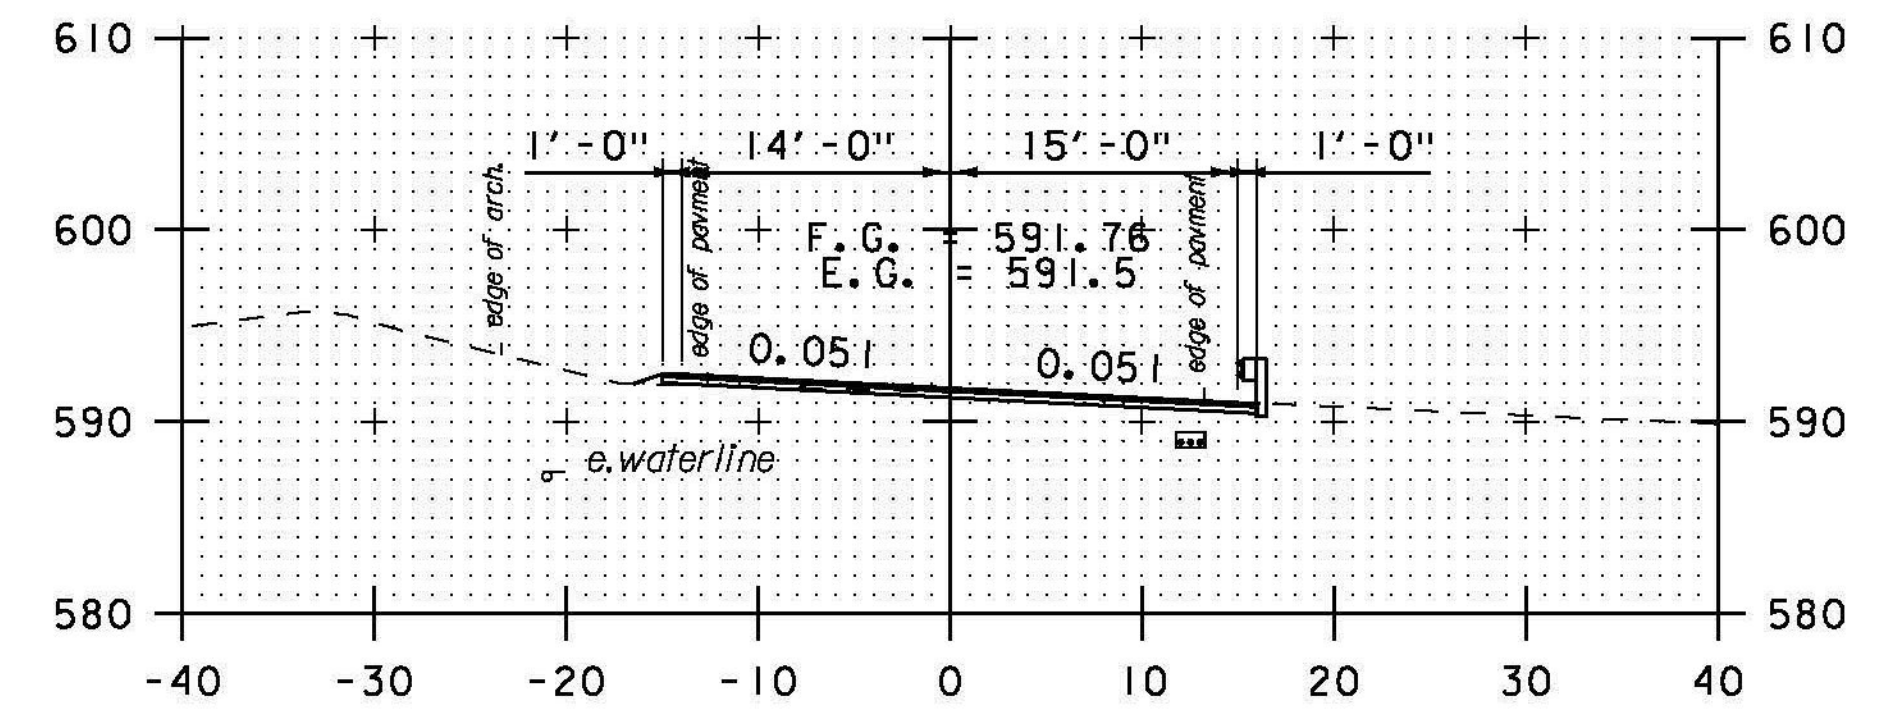


150+00

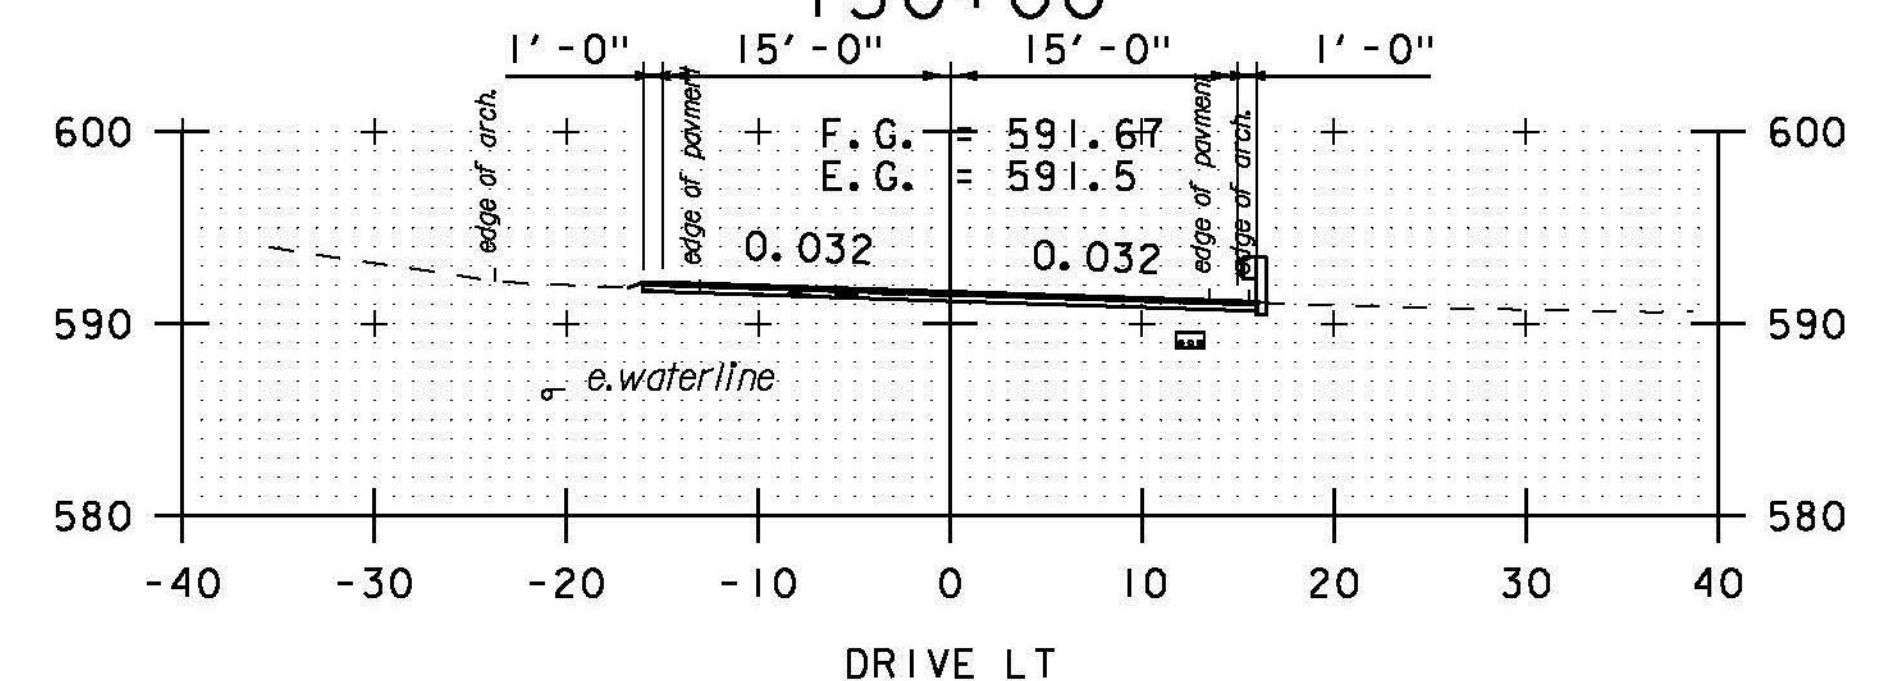

DRIVE LT
149+50

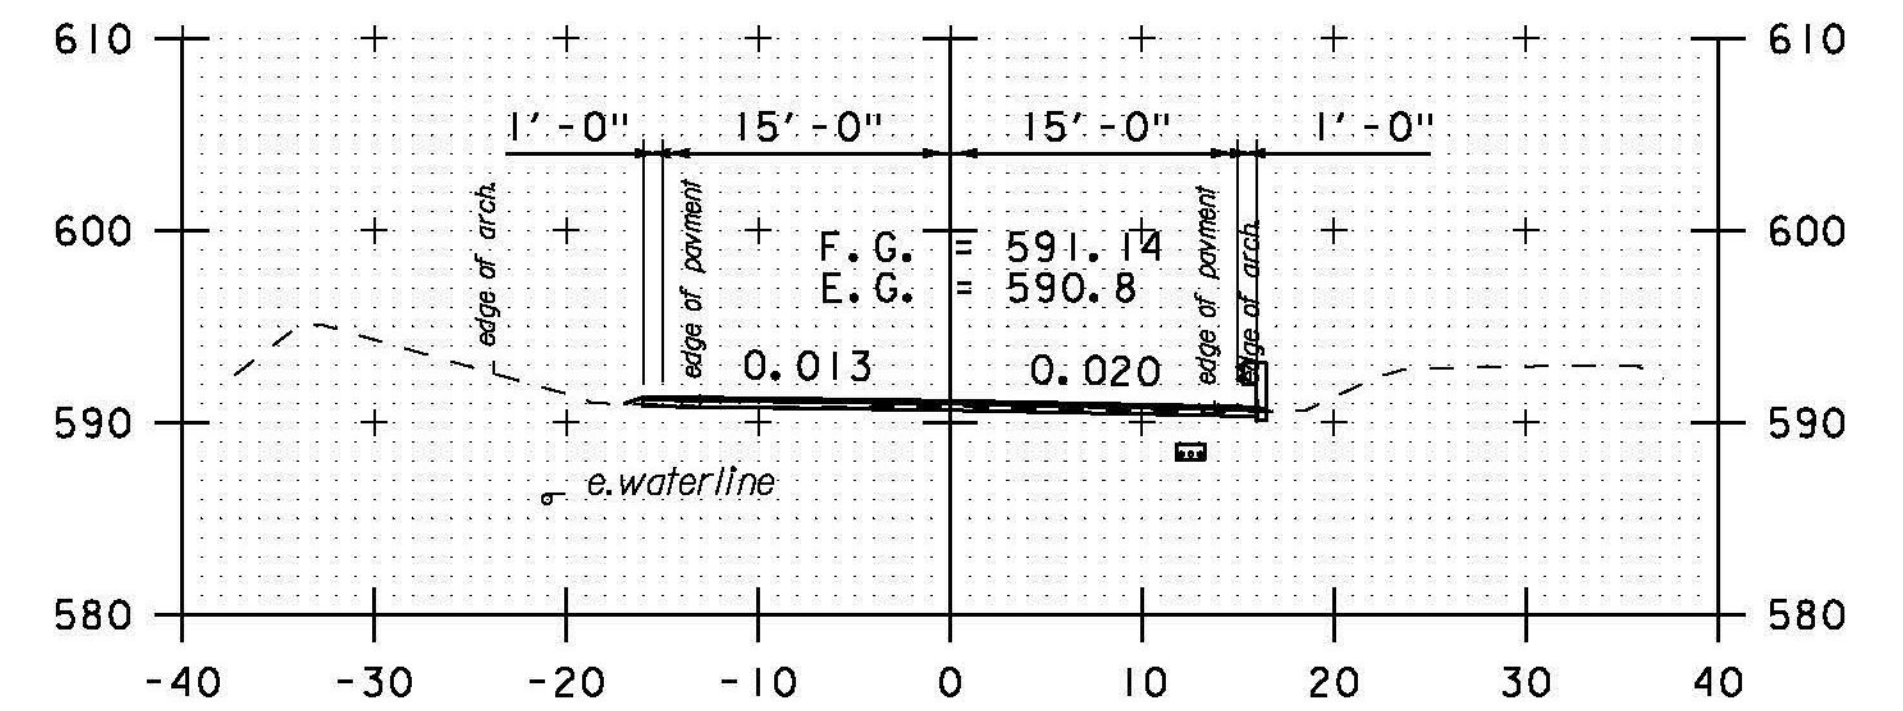

149+00

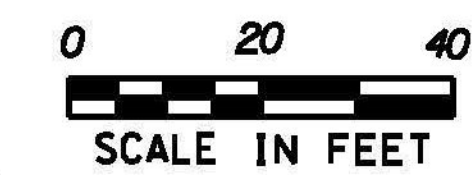

SCALE IN FEET

STA. 145+00 TO STA. 150+00

PROJECT NAME: BETHEL-RANDOLPH
PROJECT NUMBER: STP 292(I)

FILE NAME: piOC244.dgn
PROJECT LEADER: C. LATHROP
DESIGNED BY: S. LAMPHERE
CROSS SECTION SHEET 5

PLOT DATE: 4/23/2015
DRAWN BY: S. LAMPHERE
CHECKED BY: C. LATHROP
SHEET 139 OF 211