



PULL OFF RT


156+00

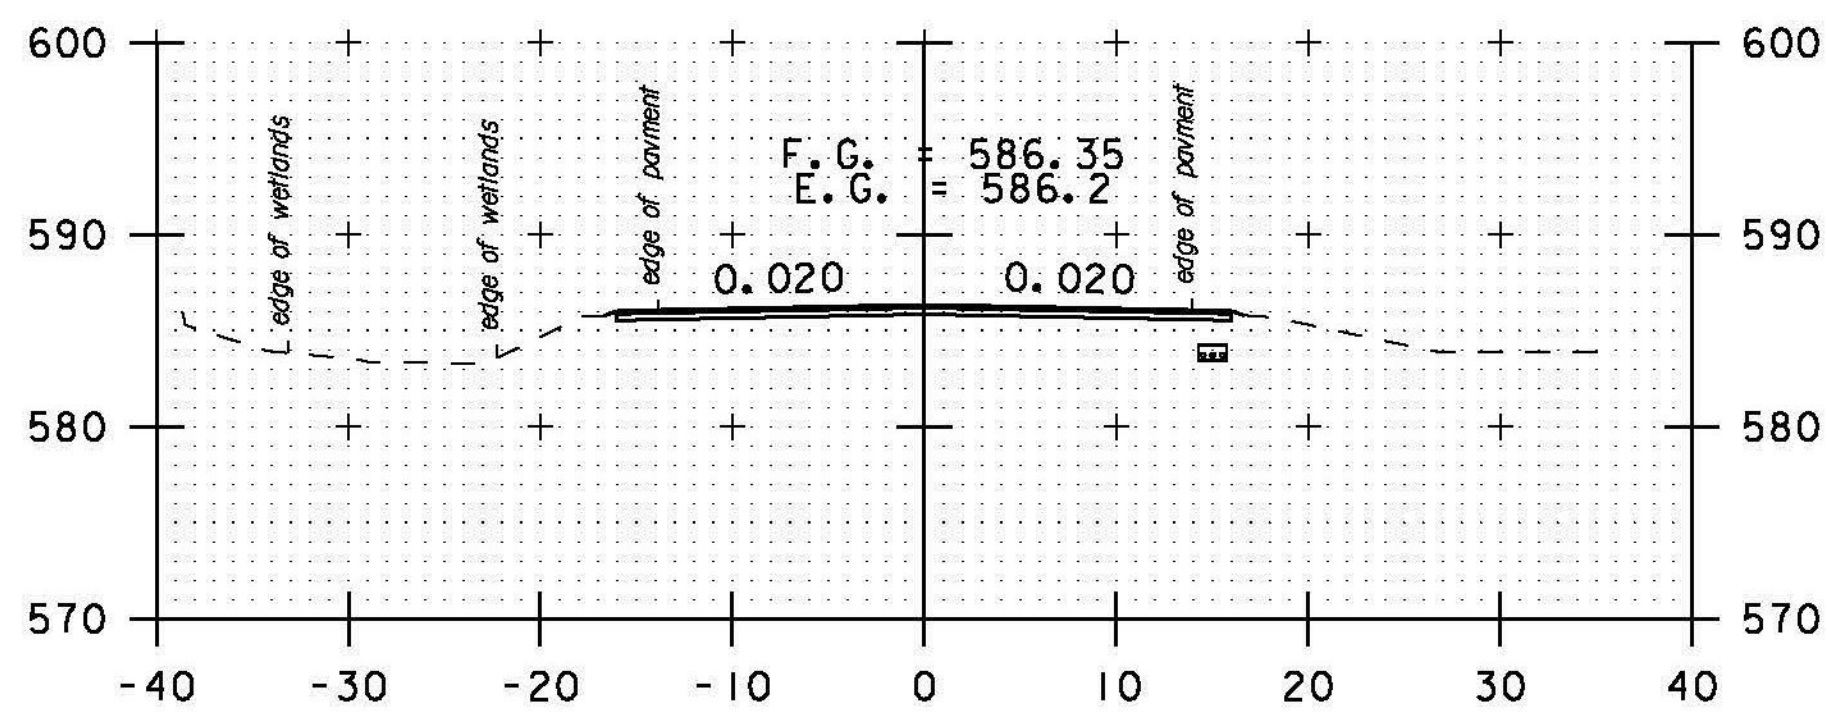


157+50

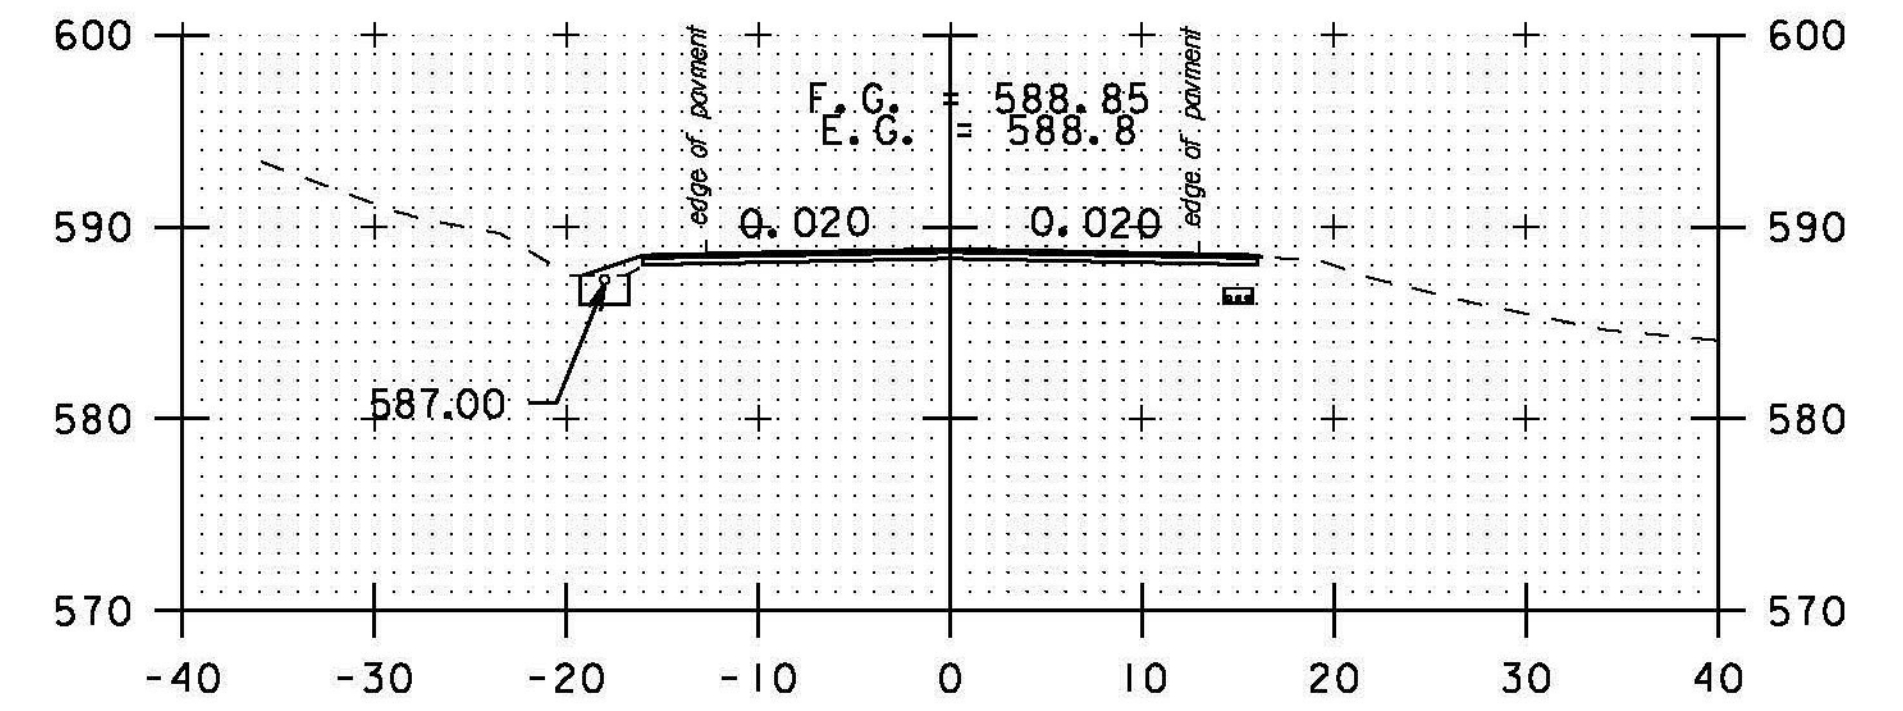

159+00

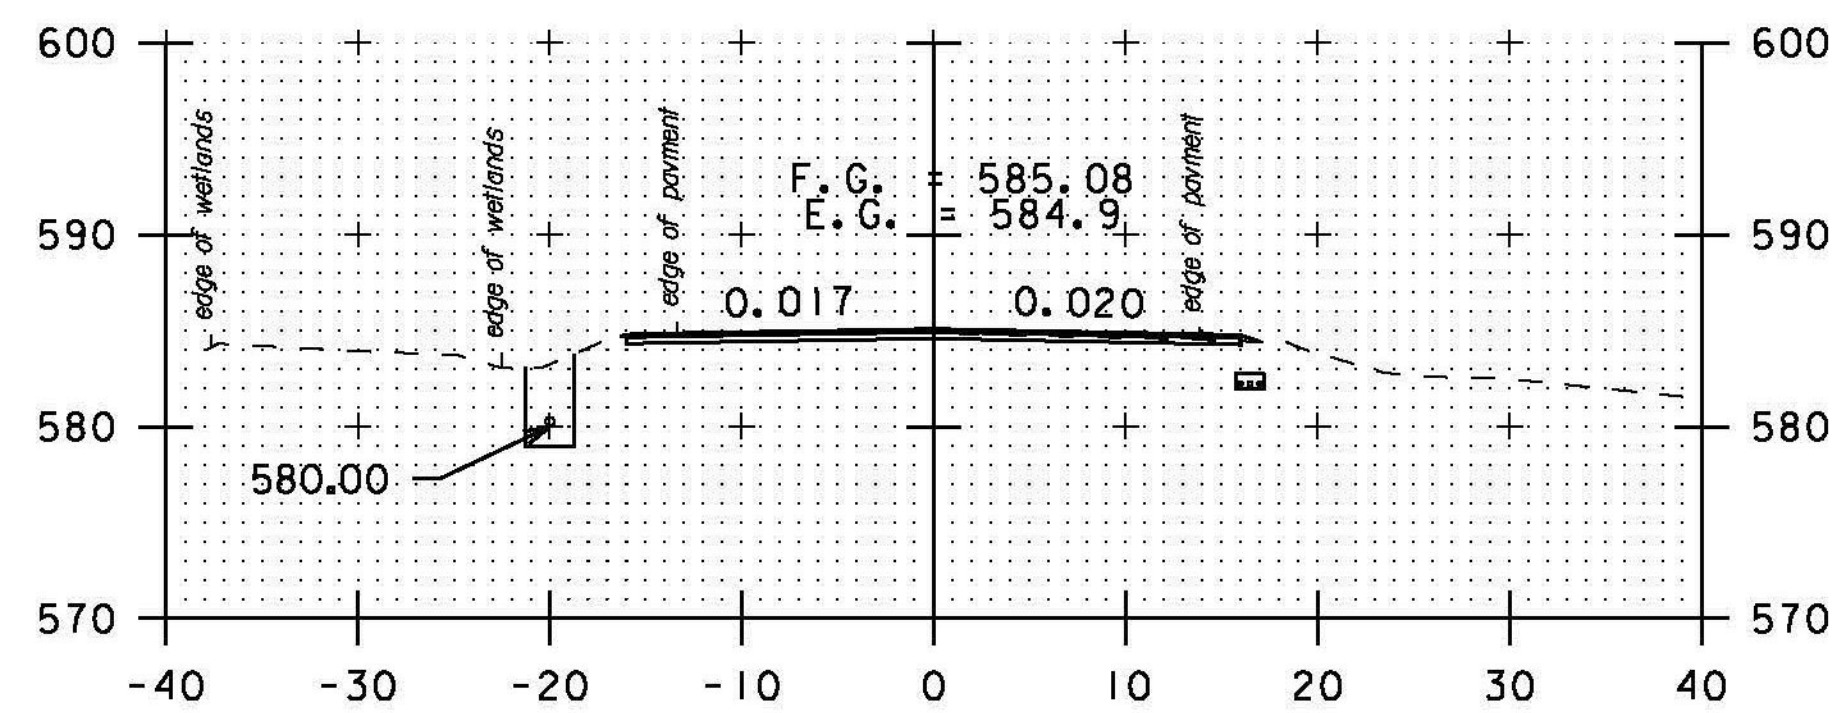


155+50

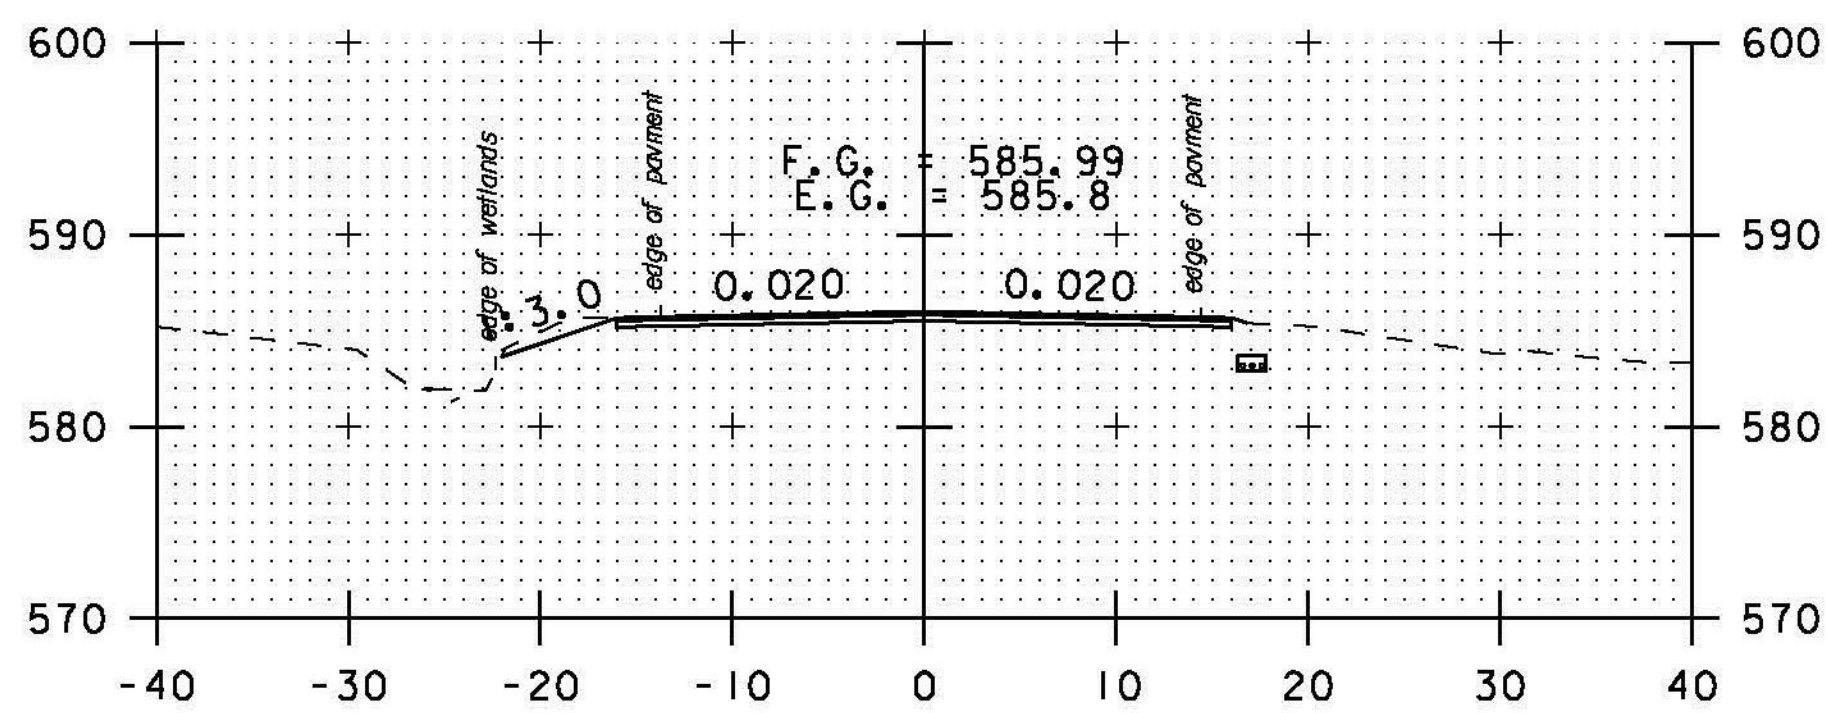


PULL OFF RT


157+00

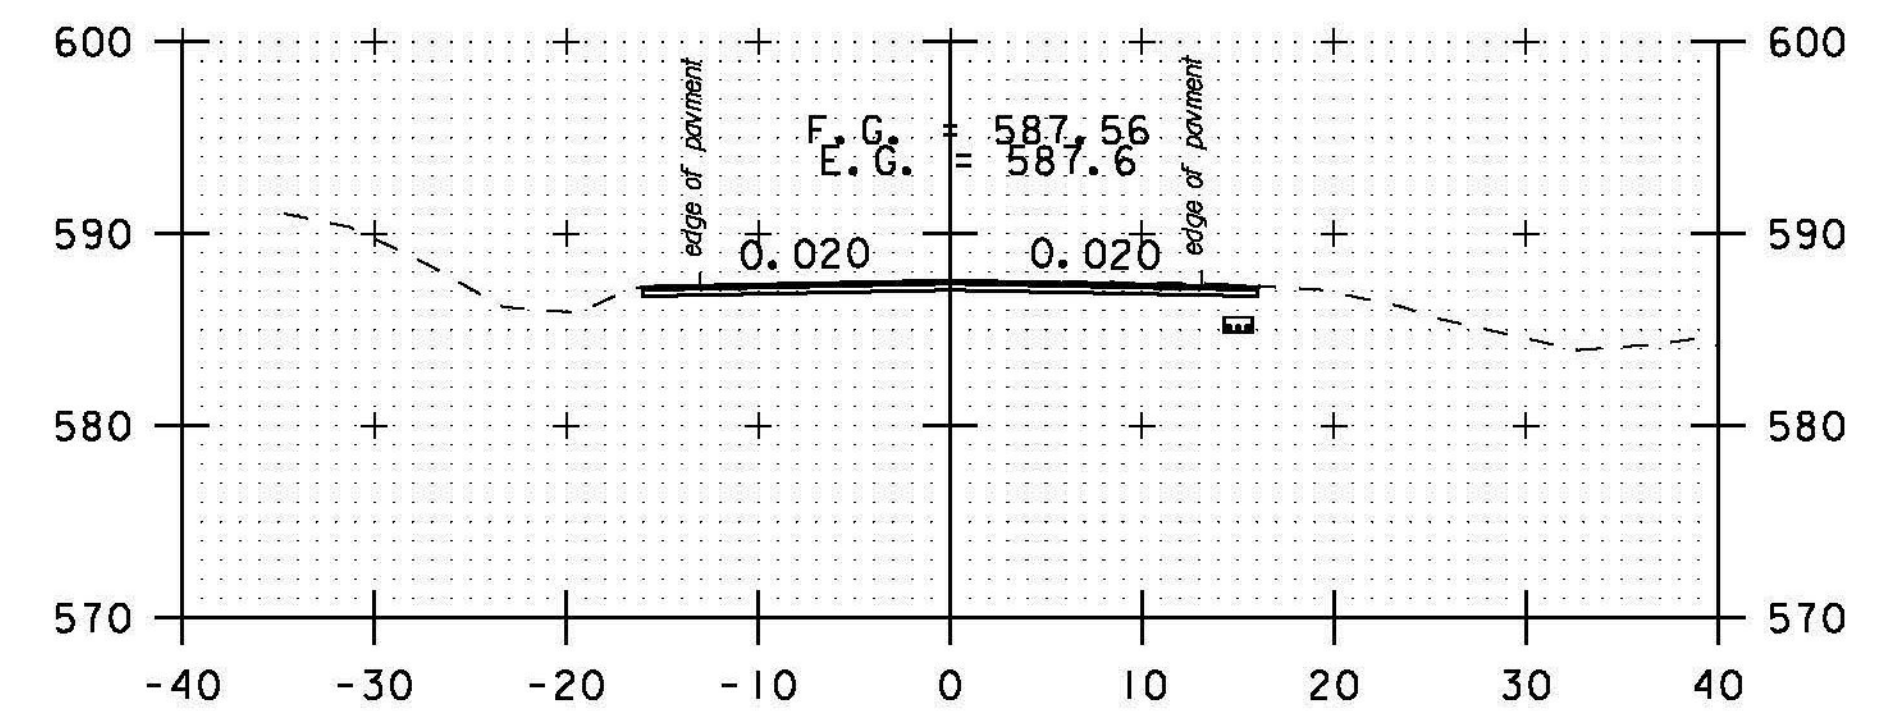

158+50

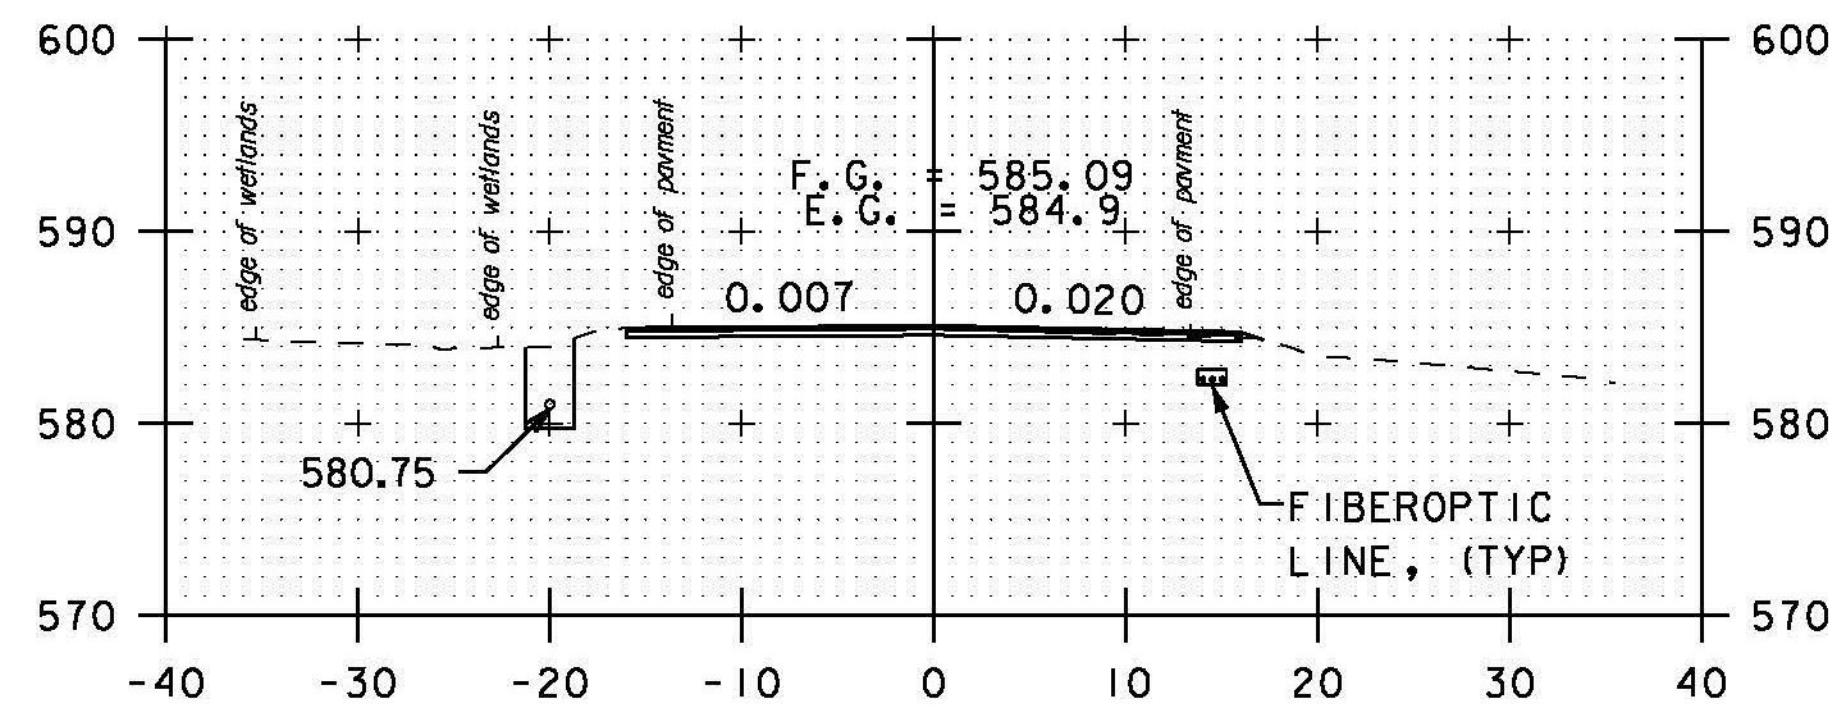


155+00

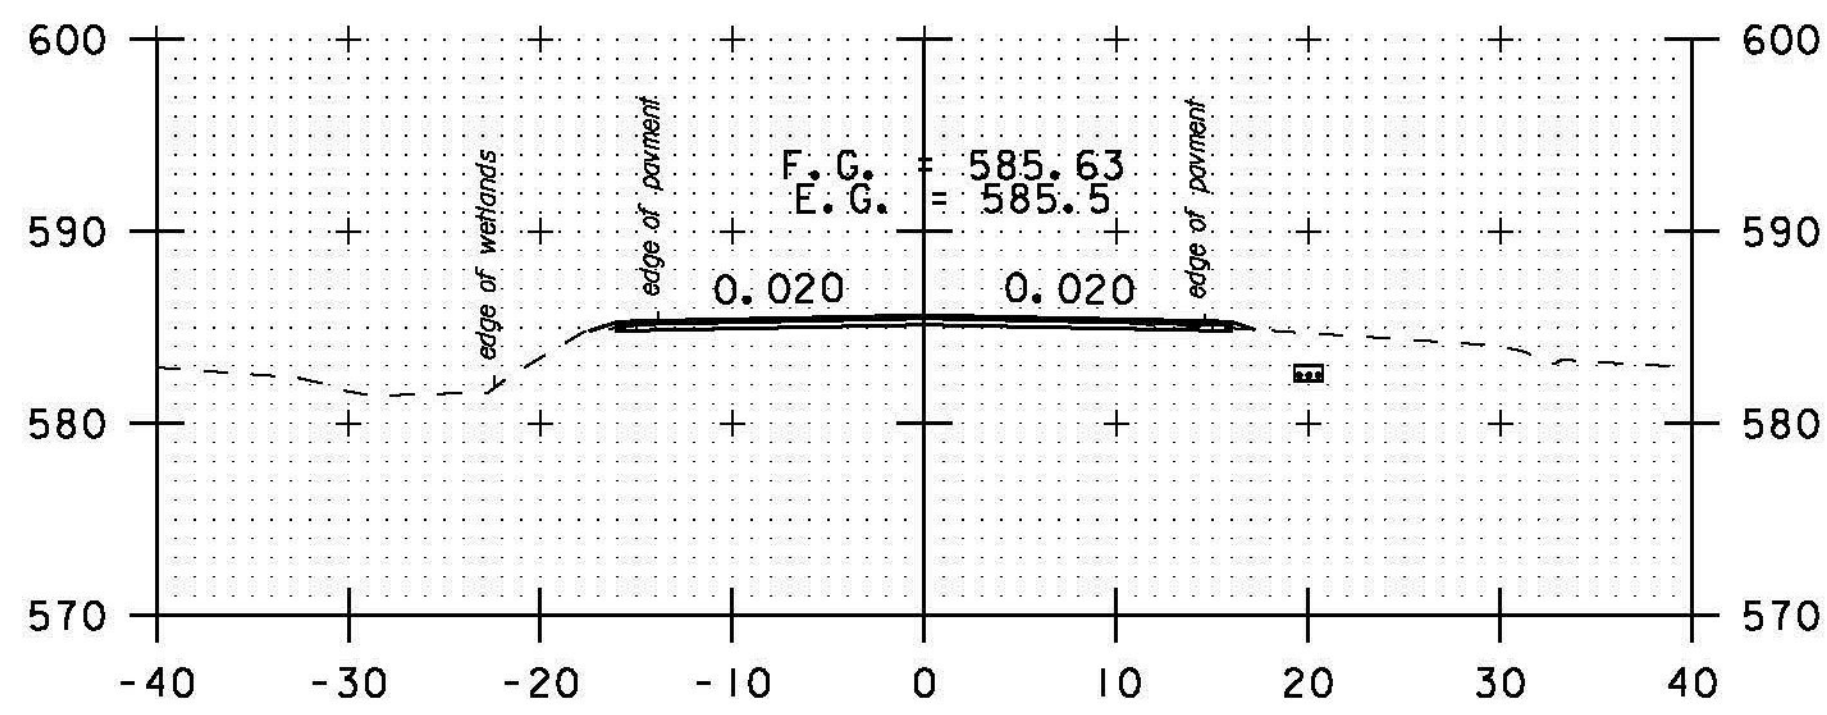

PULL OFF RT

156+50

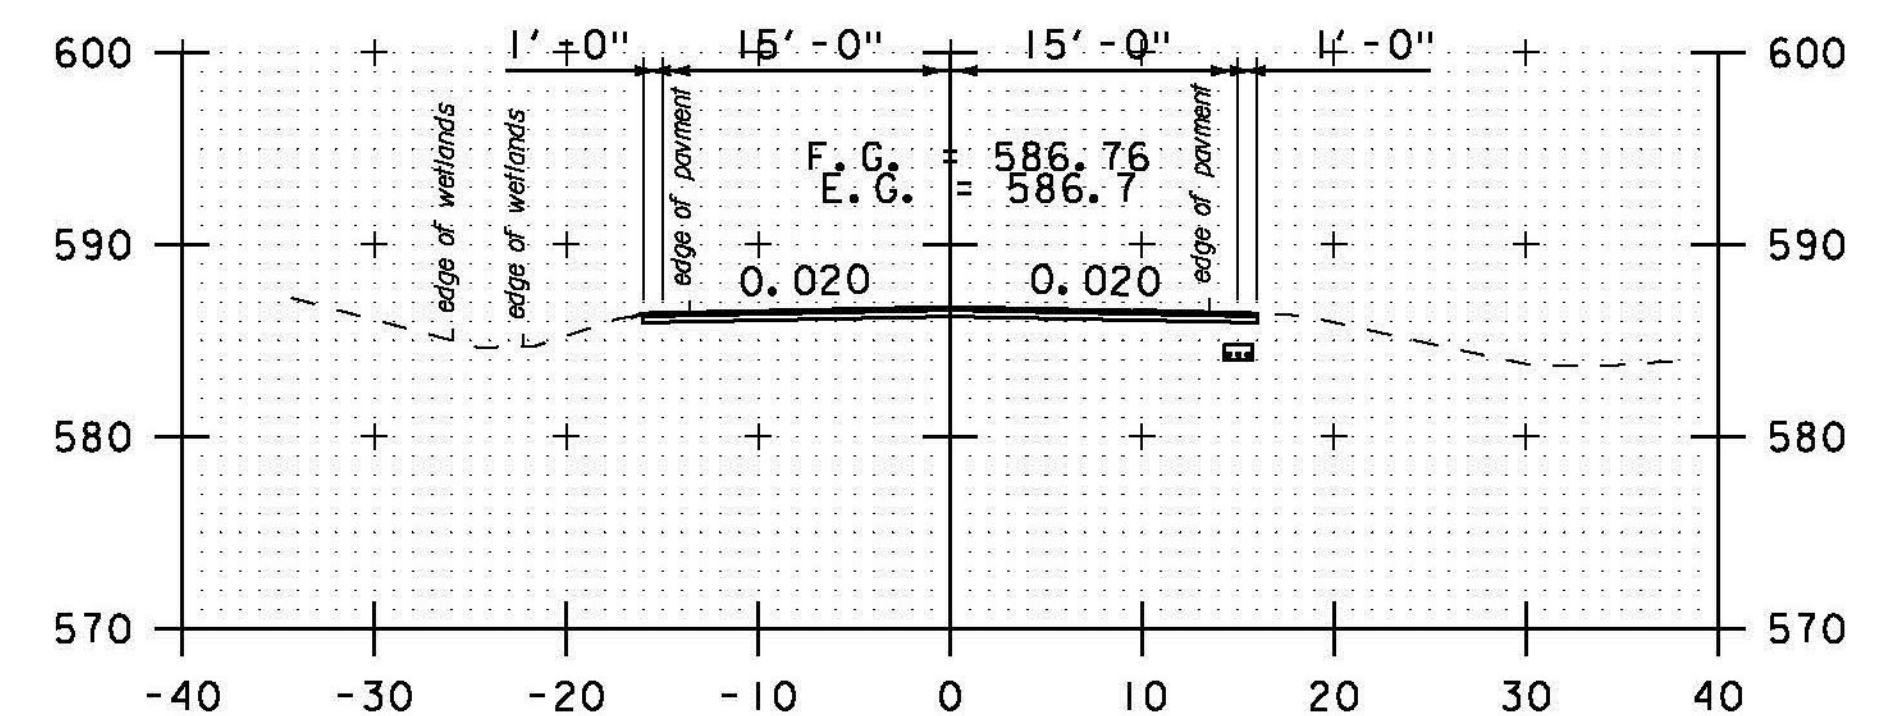


158+00

PROJECT NAME: BETHEL-RANDOLPH
PROJECT NUMBER: STP 292(I)

FILE NAME: piOC244.dgn
PROJECT LEADER: C. LATHROP
DESIGNED BY: S. LAMPHERE
CROSS SECTION SHEET 7

PLOT DATE: 4/23/2015
DRAWN BY: S. LAMPHERE
CHECKED BY: C. LATHROP
SHEET 141 OF 211

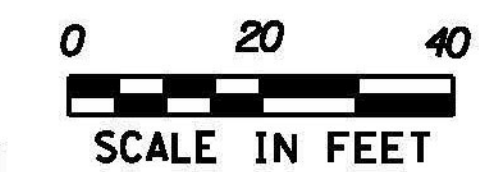

SCALE IN FEET

STA. 155+00 TO STA. 159+00