




160+50

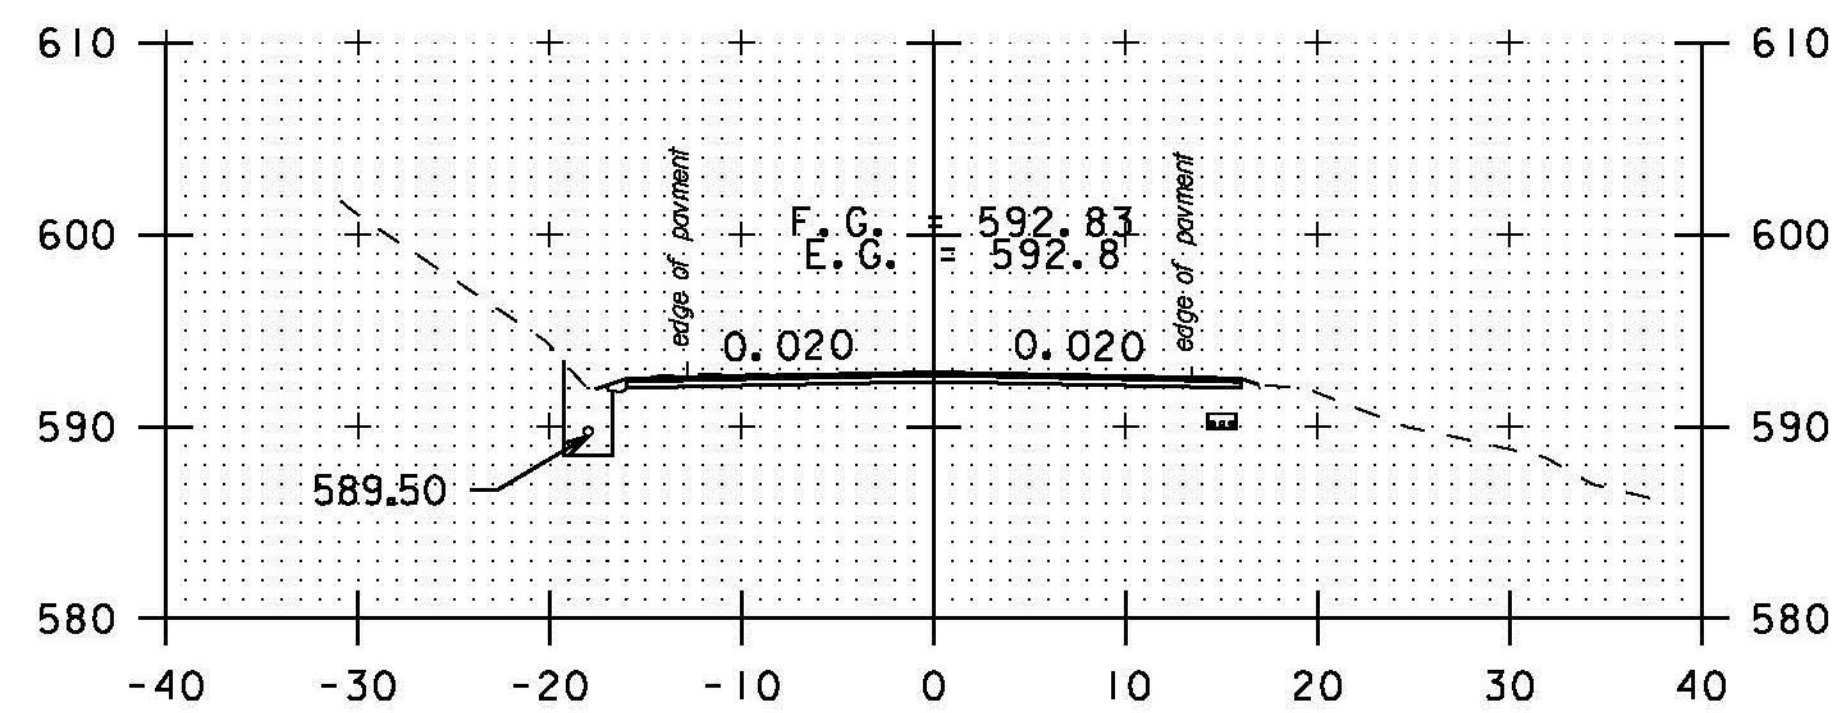


160+00

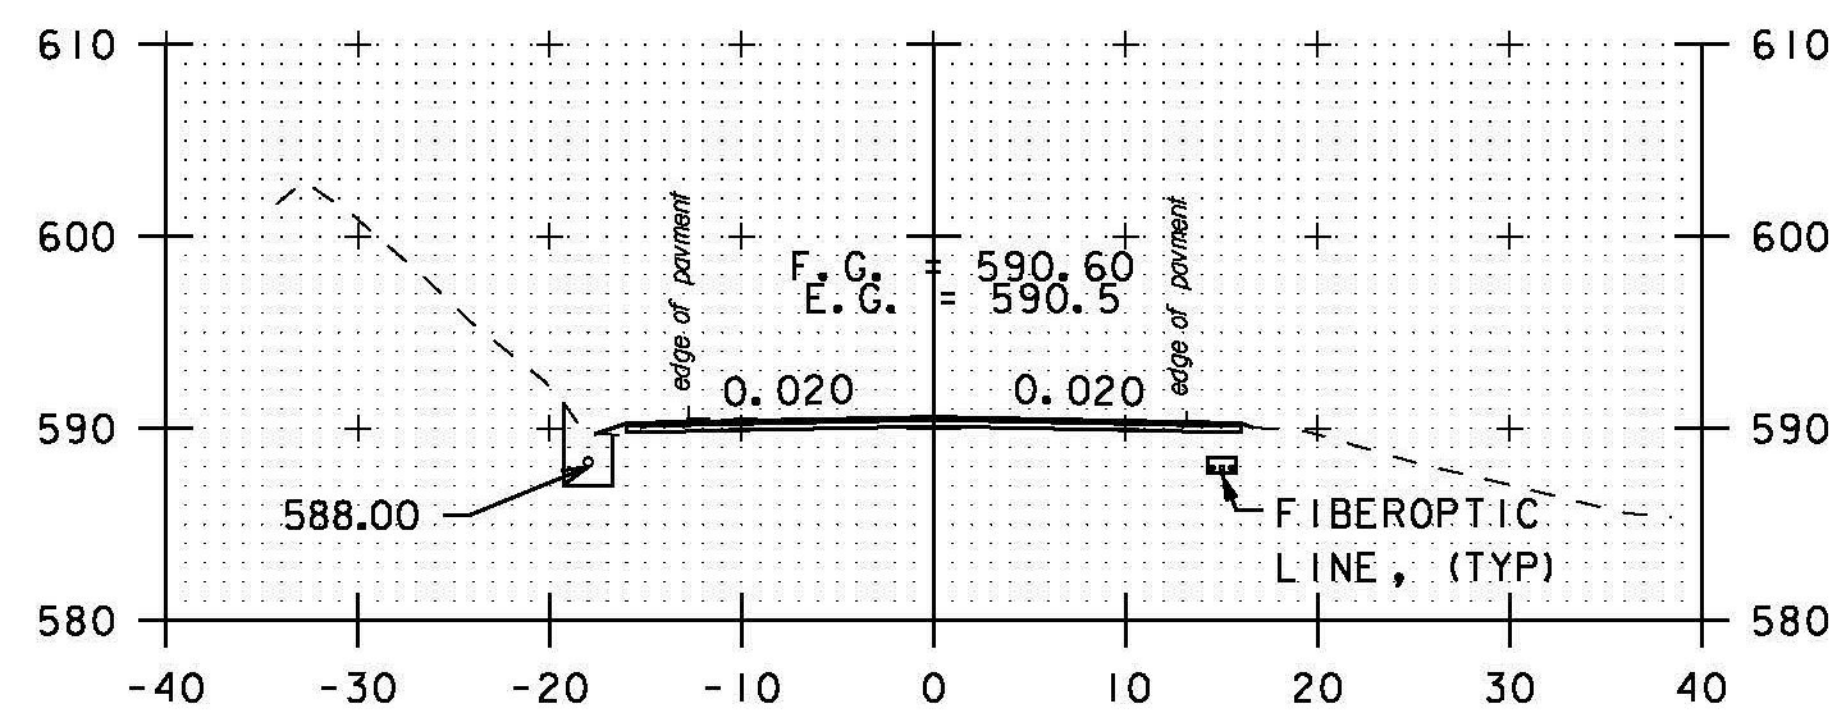


159+50

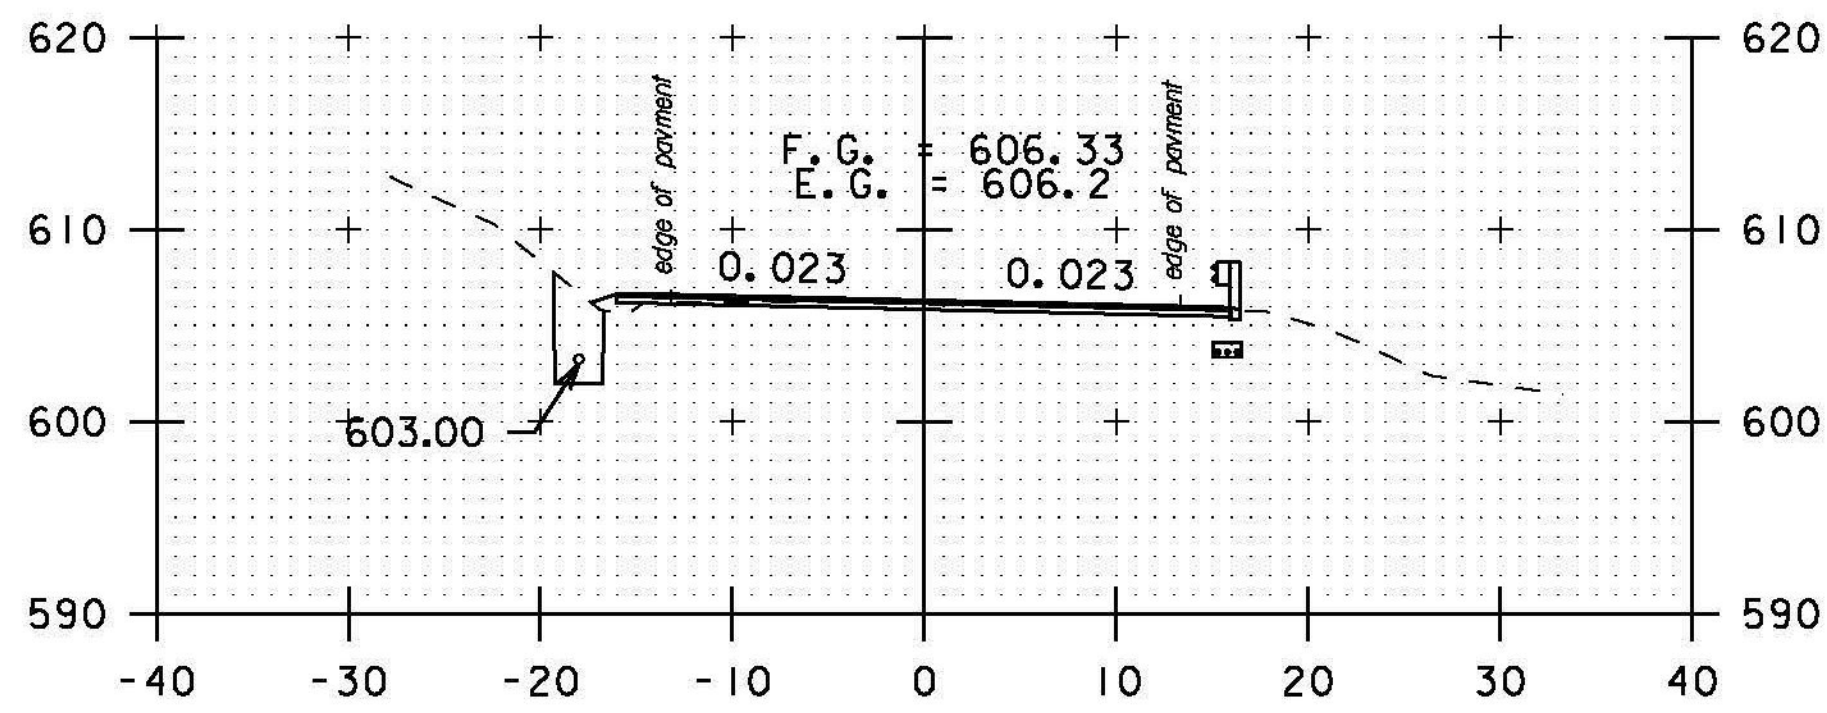


162+00

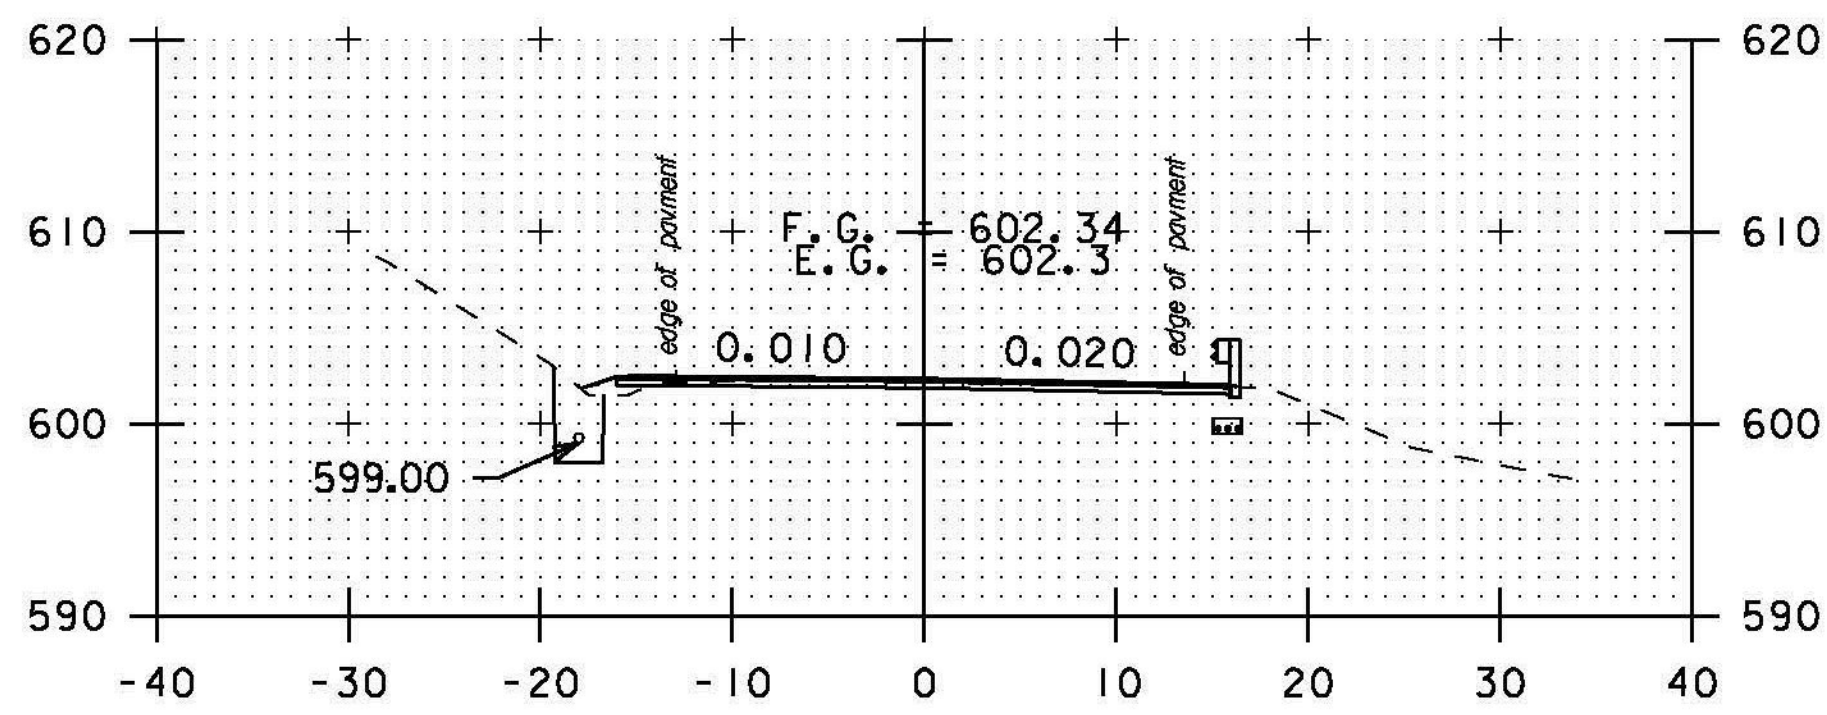


161+50

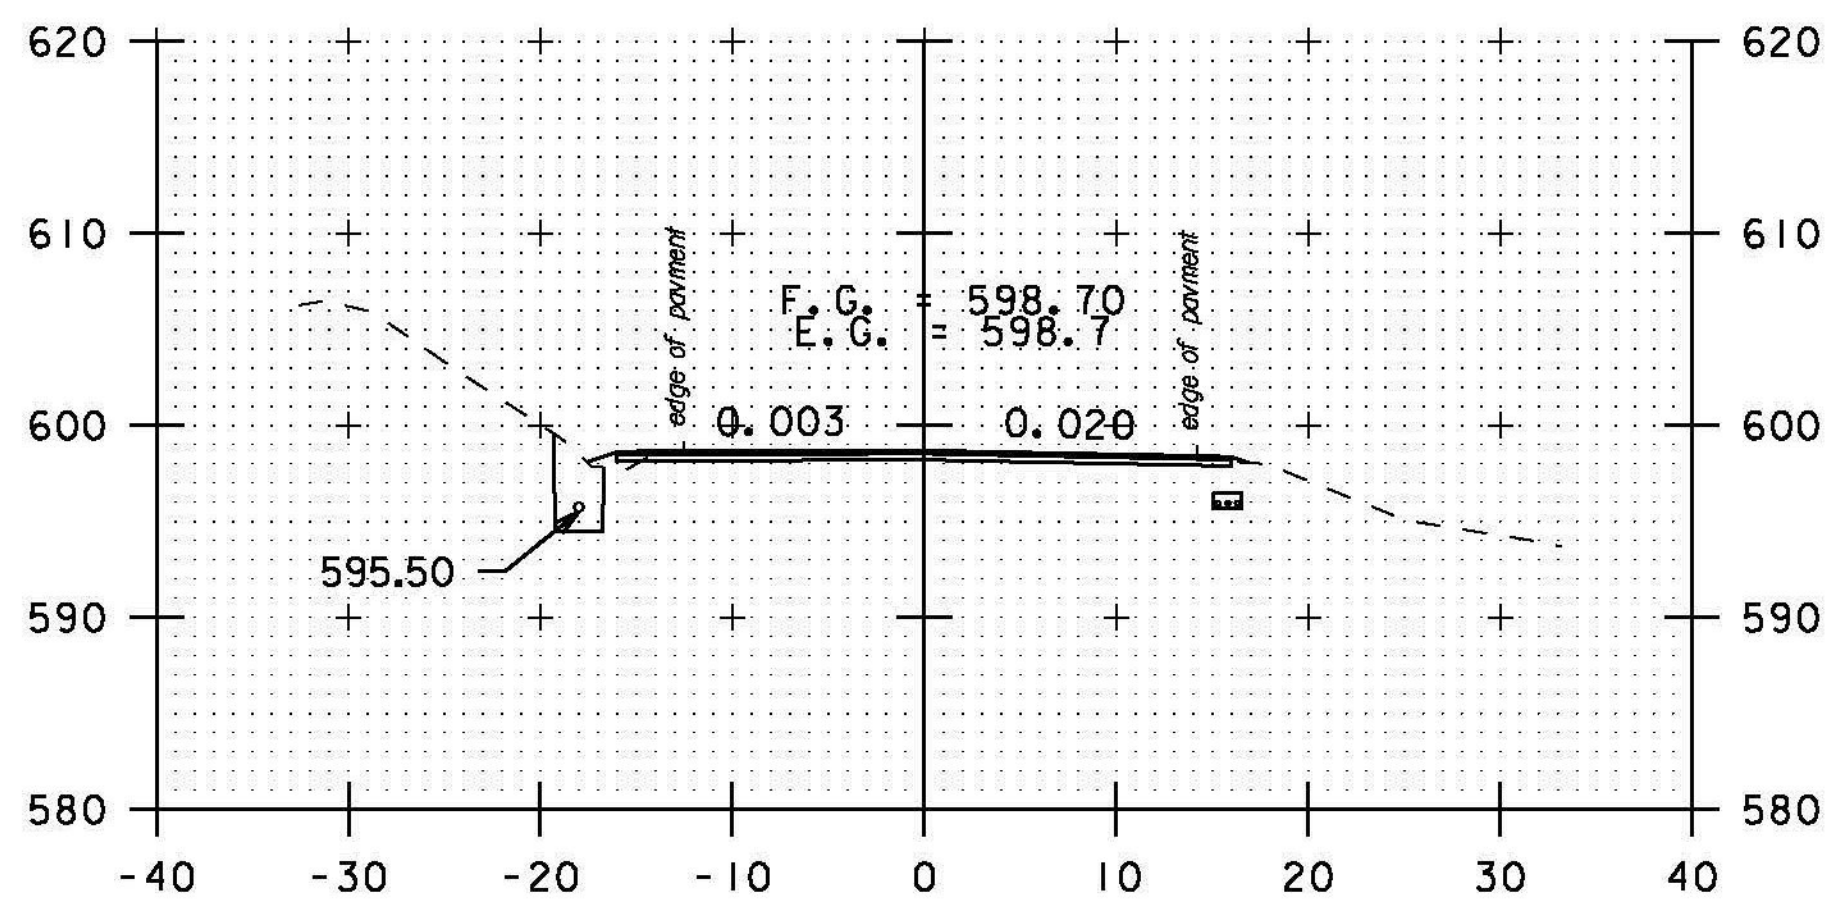


161+00

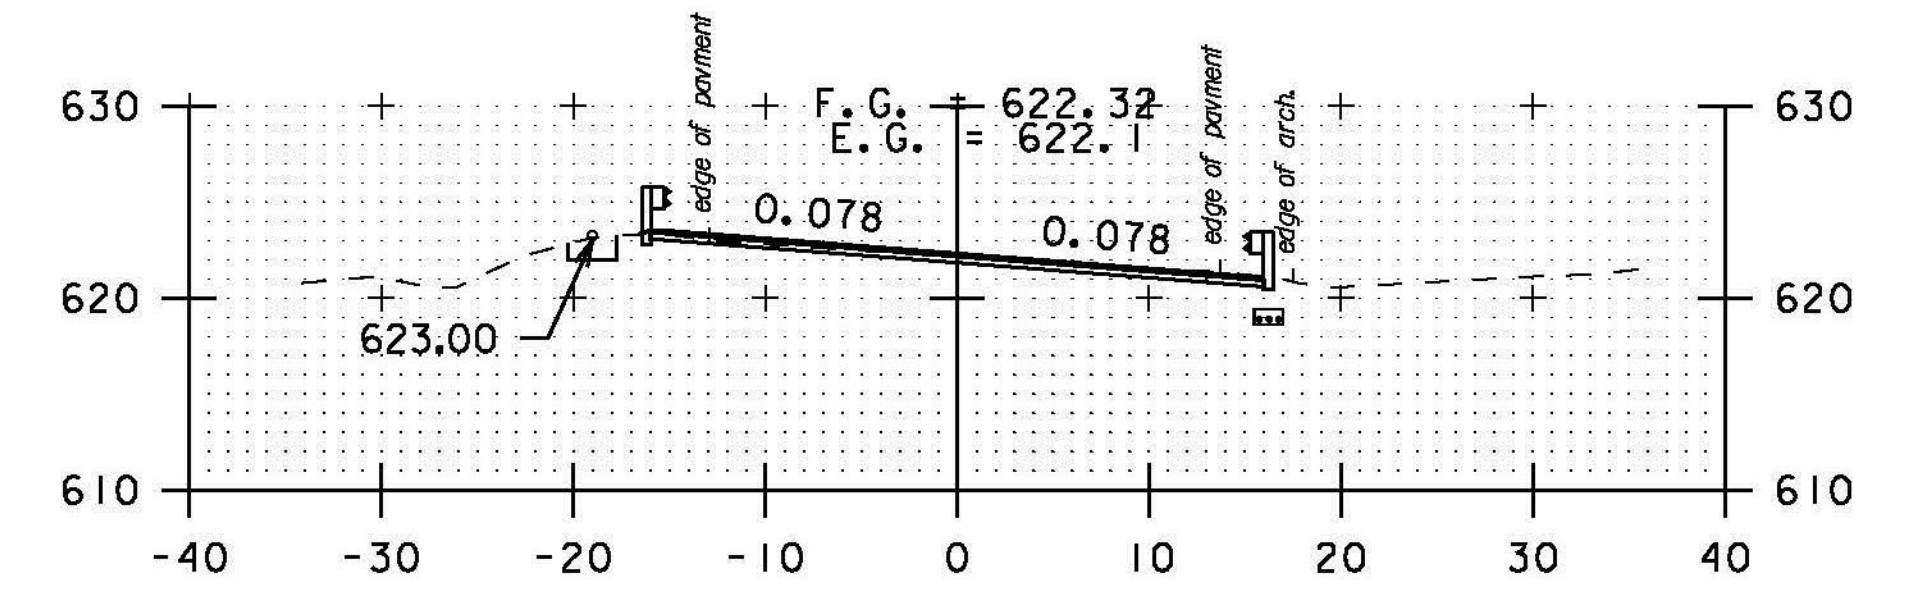


164+00

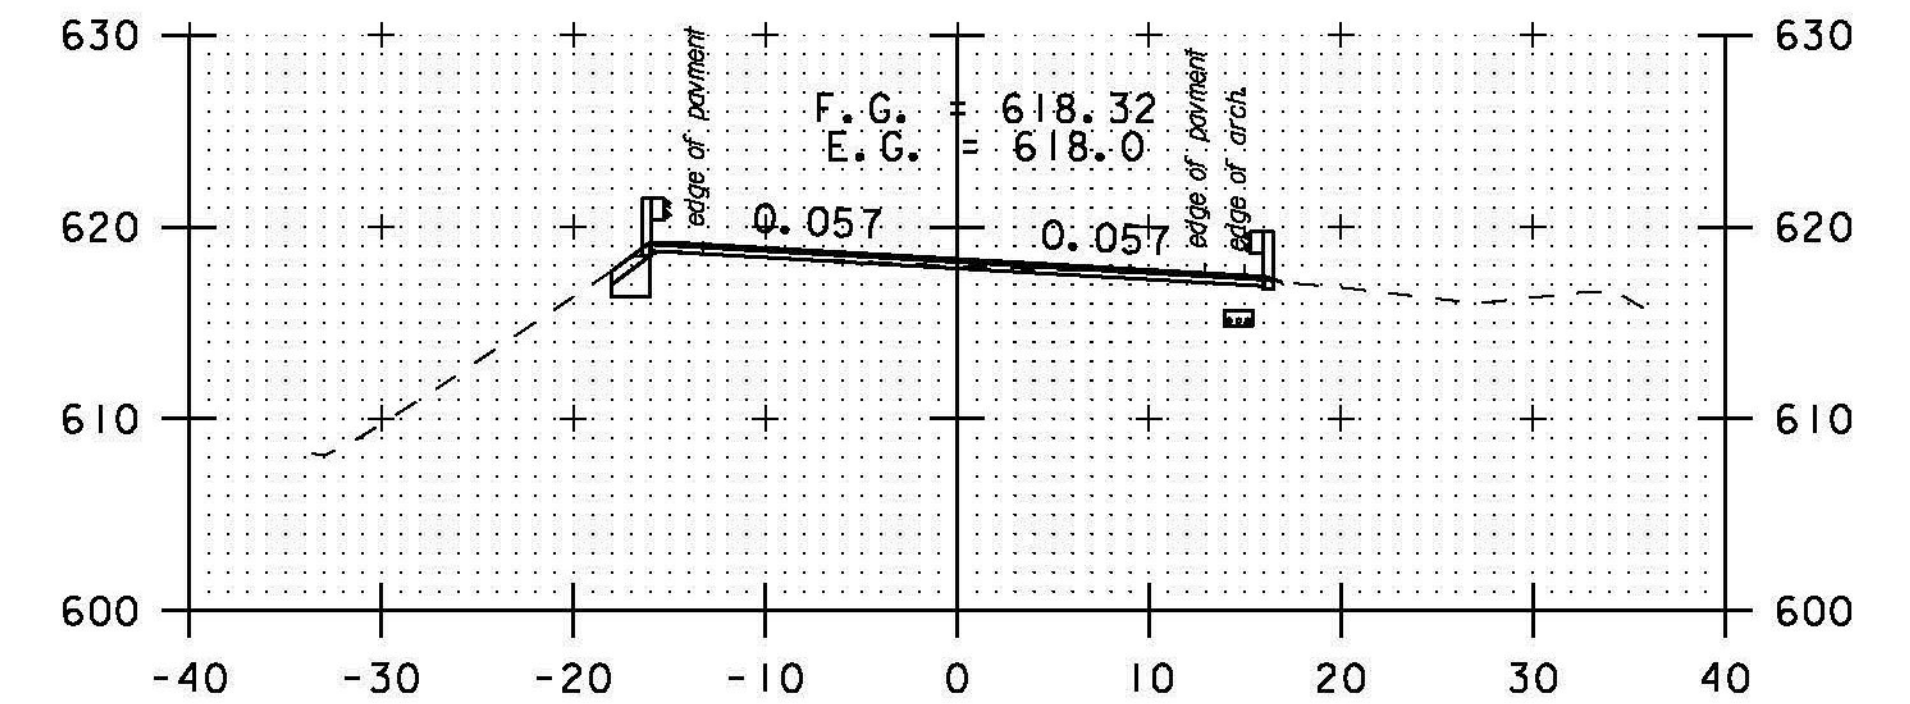

163+50

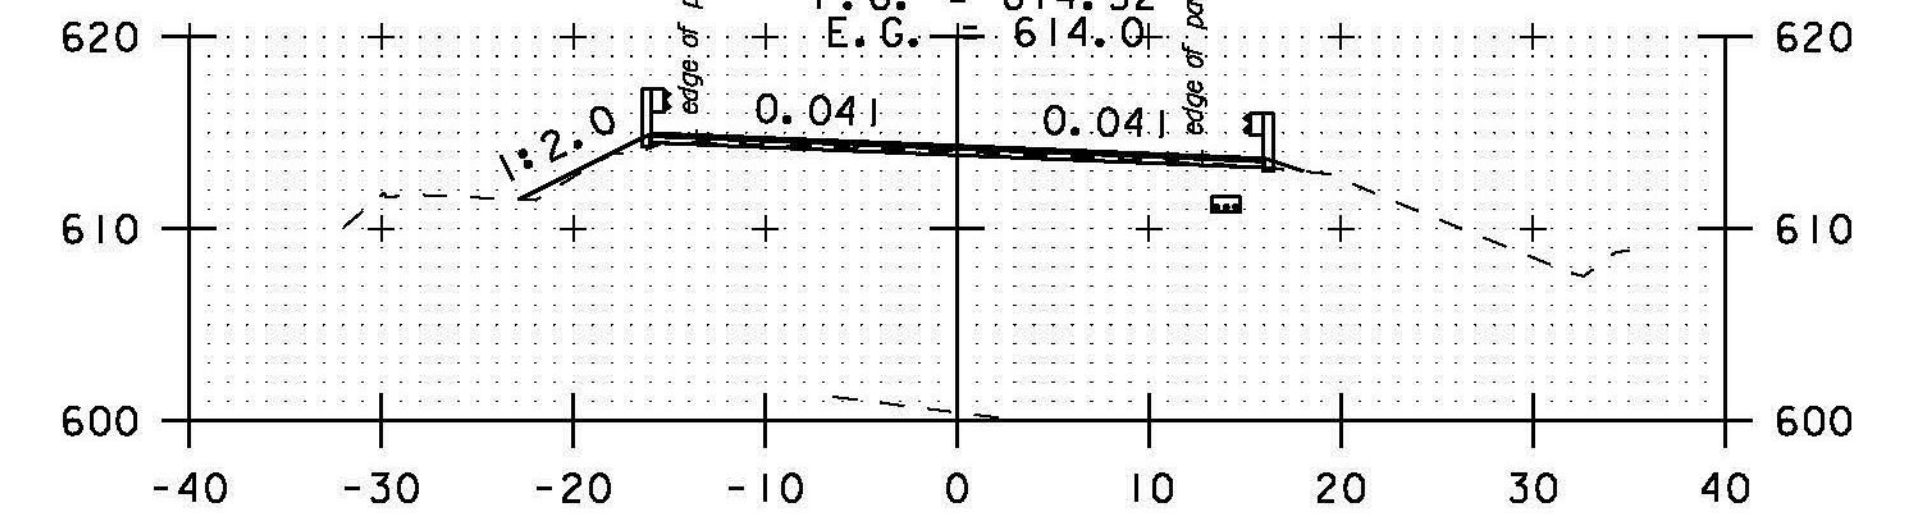


163+00

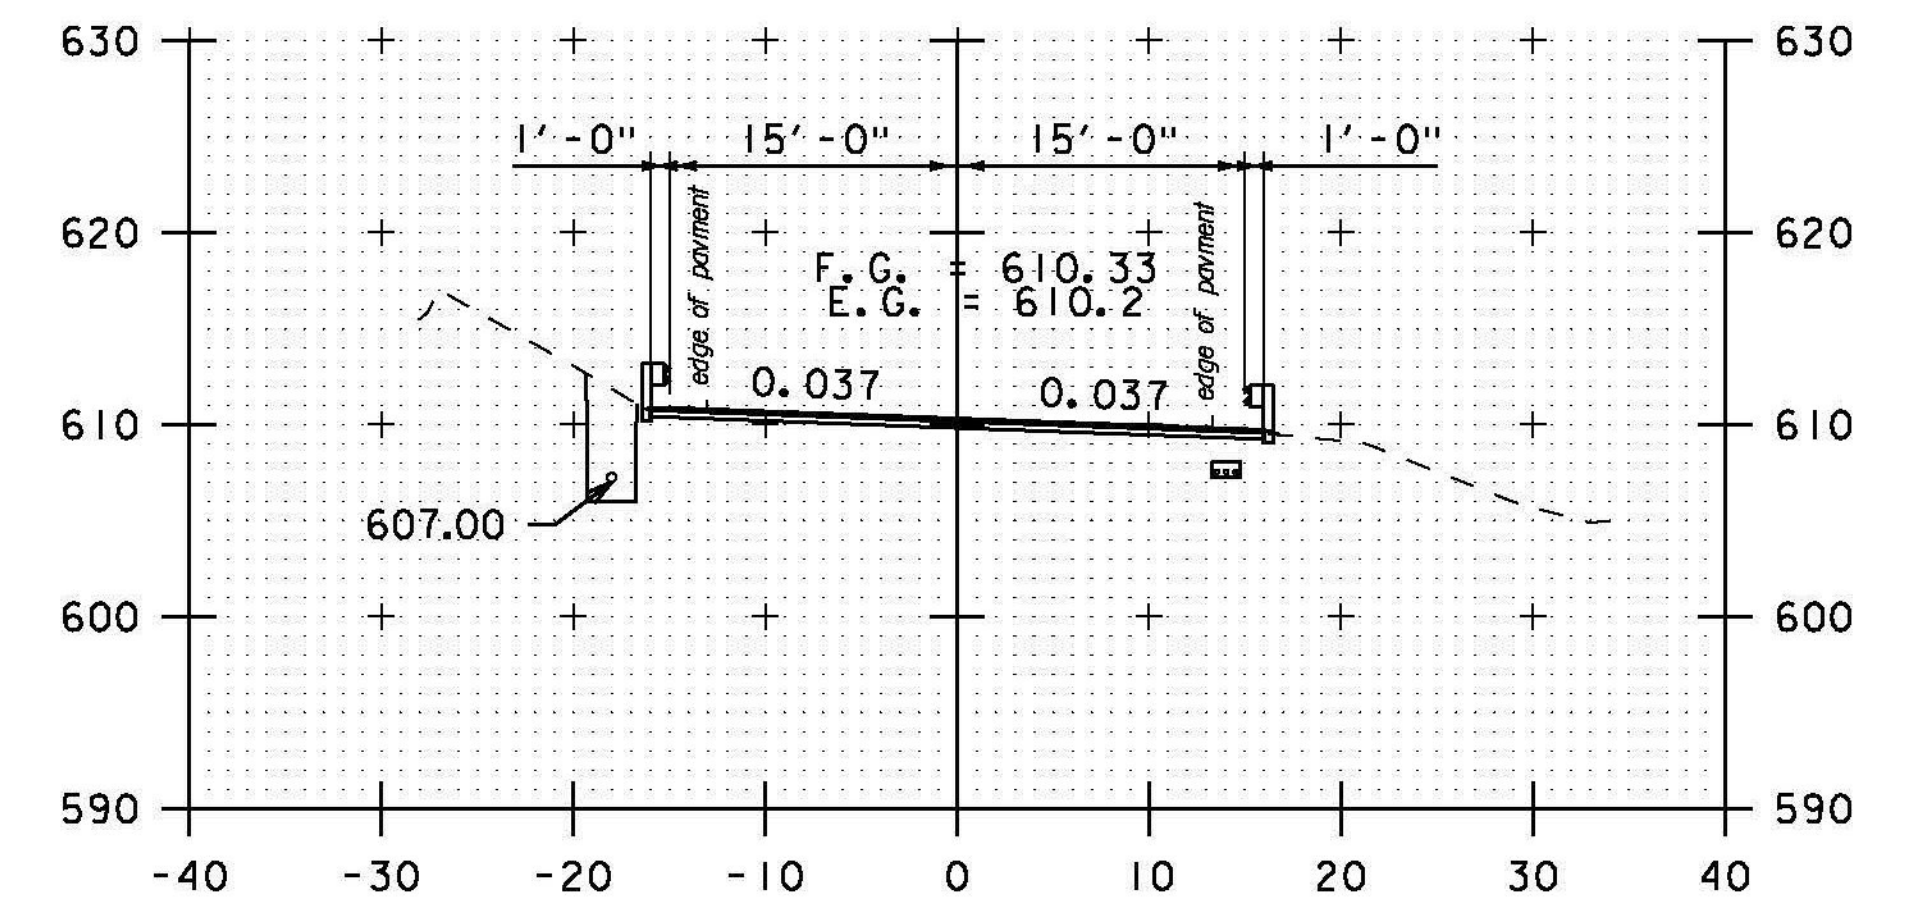

162+50

STA. 159+50 TO STA. 164+00

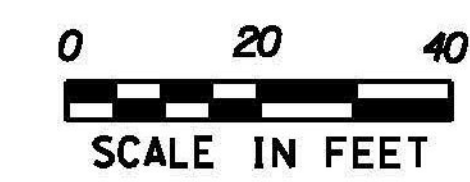

SCALE IN FEET

PROJECT NAME: BETHEL-RANDOLPH
PROJECT NUMBER: STP 292(I)

FILE NAME: piOC244.dgn
PROJECT LEADER: C. LATHROP
DESIGNED BY: S. LAMPHERE
CROSS SECTION SHEET 8

PLOT DATE: 4/23/2015
DRAWN BY: S. LAMPHERE
CHECKED BY: C. LATHROP
SHEET 142 OF 211