




165+50

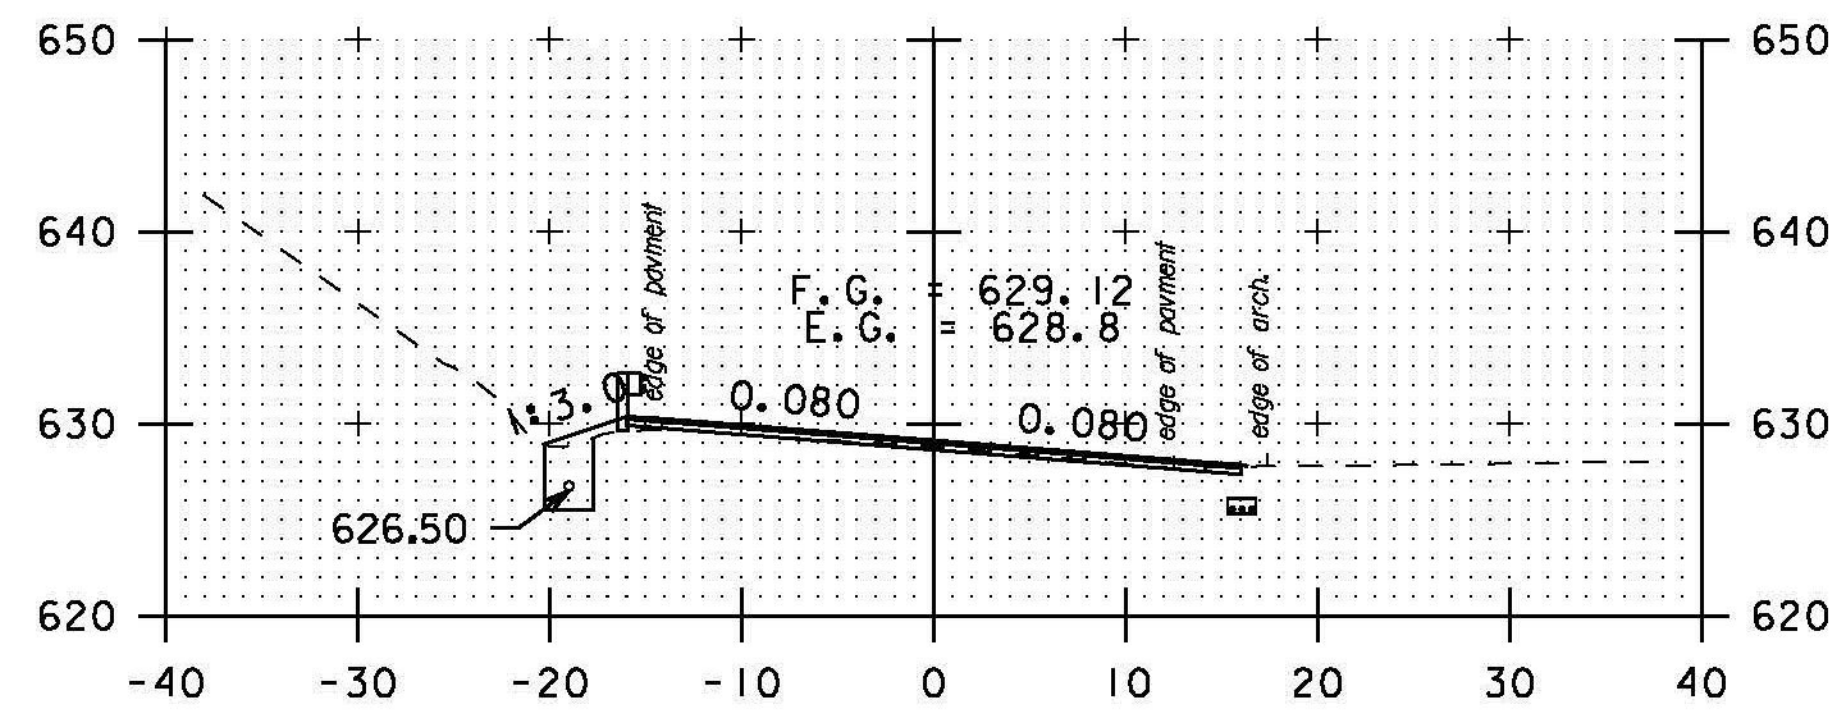


165+00

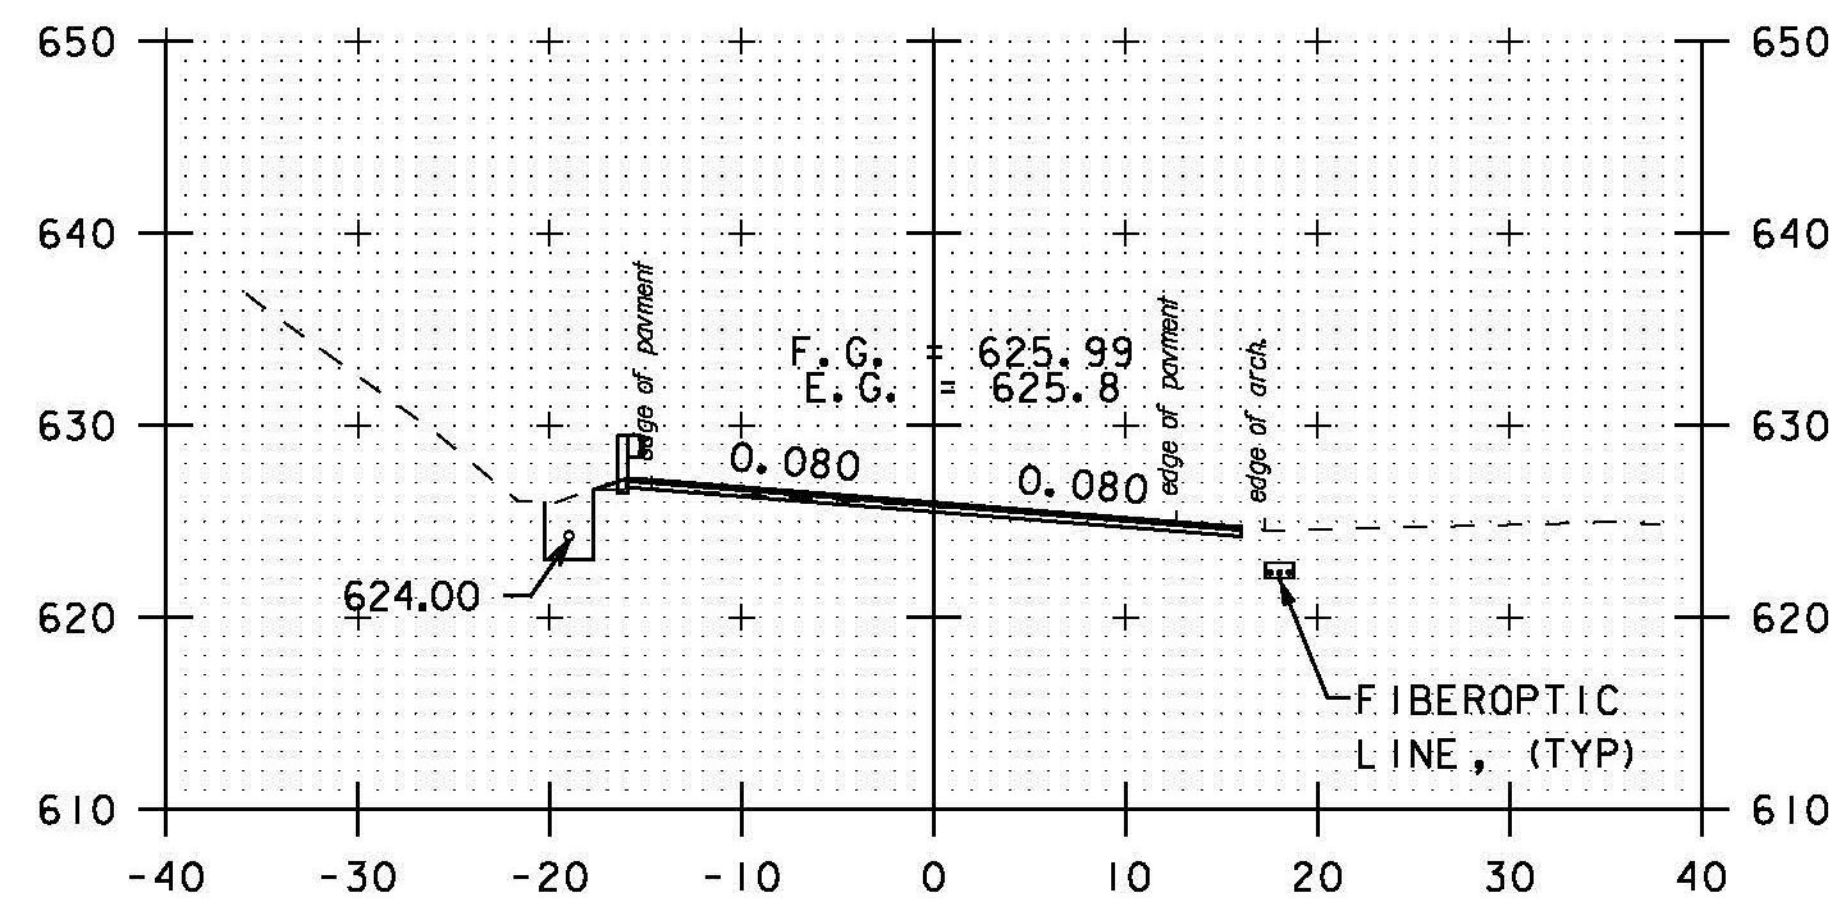


164+50

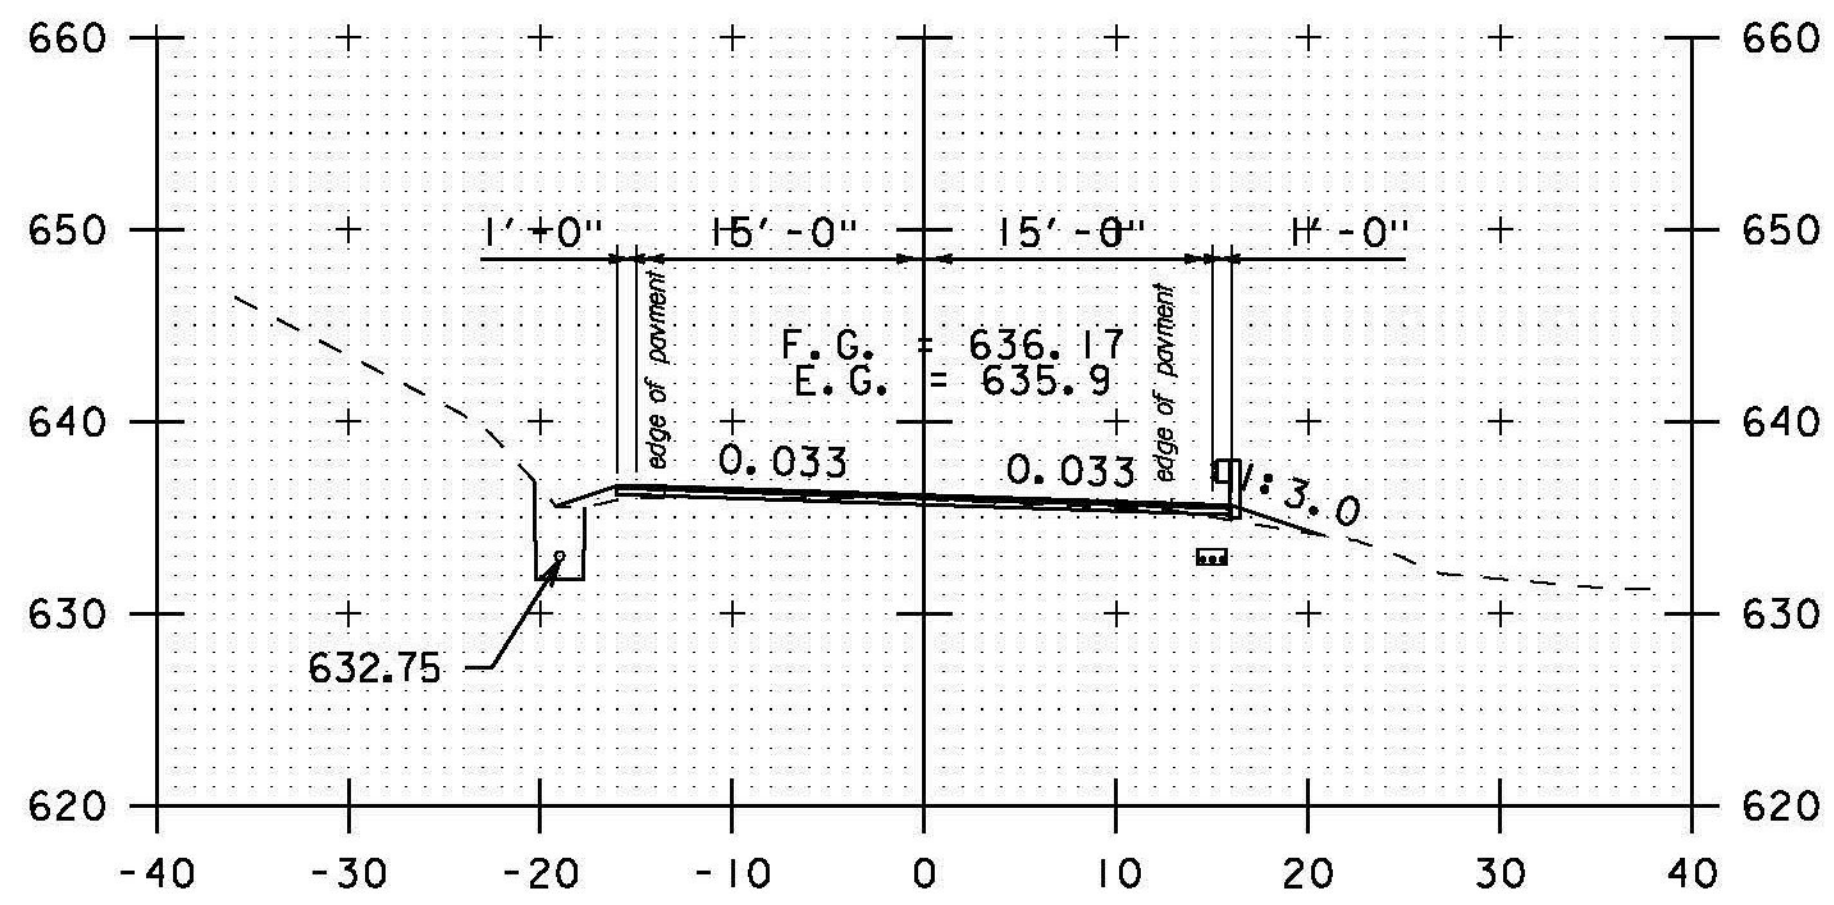


167+00

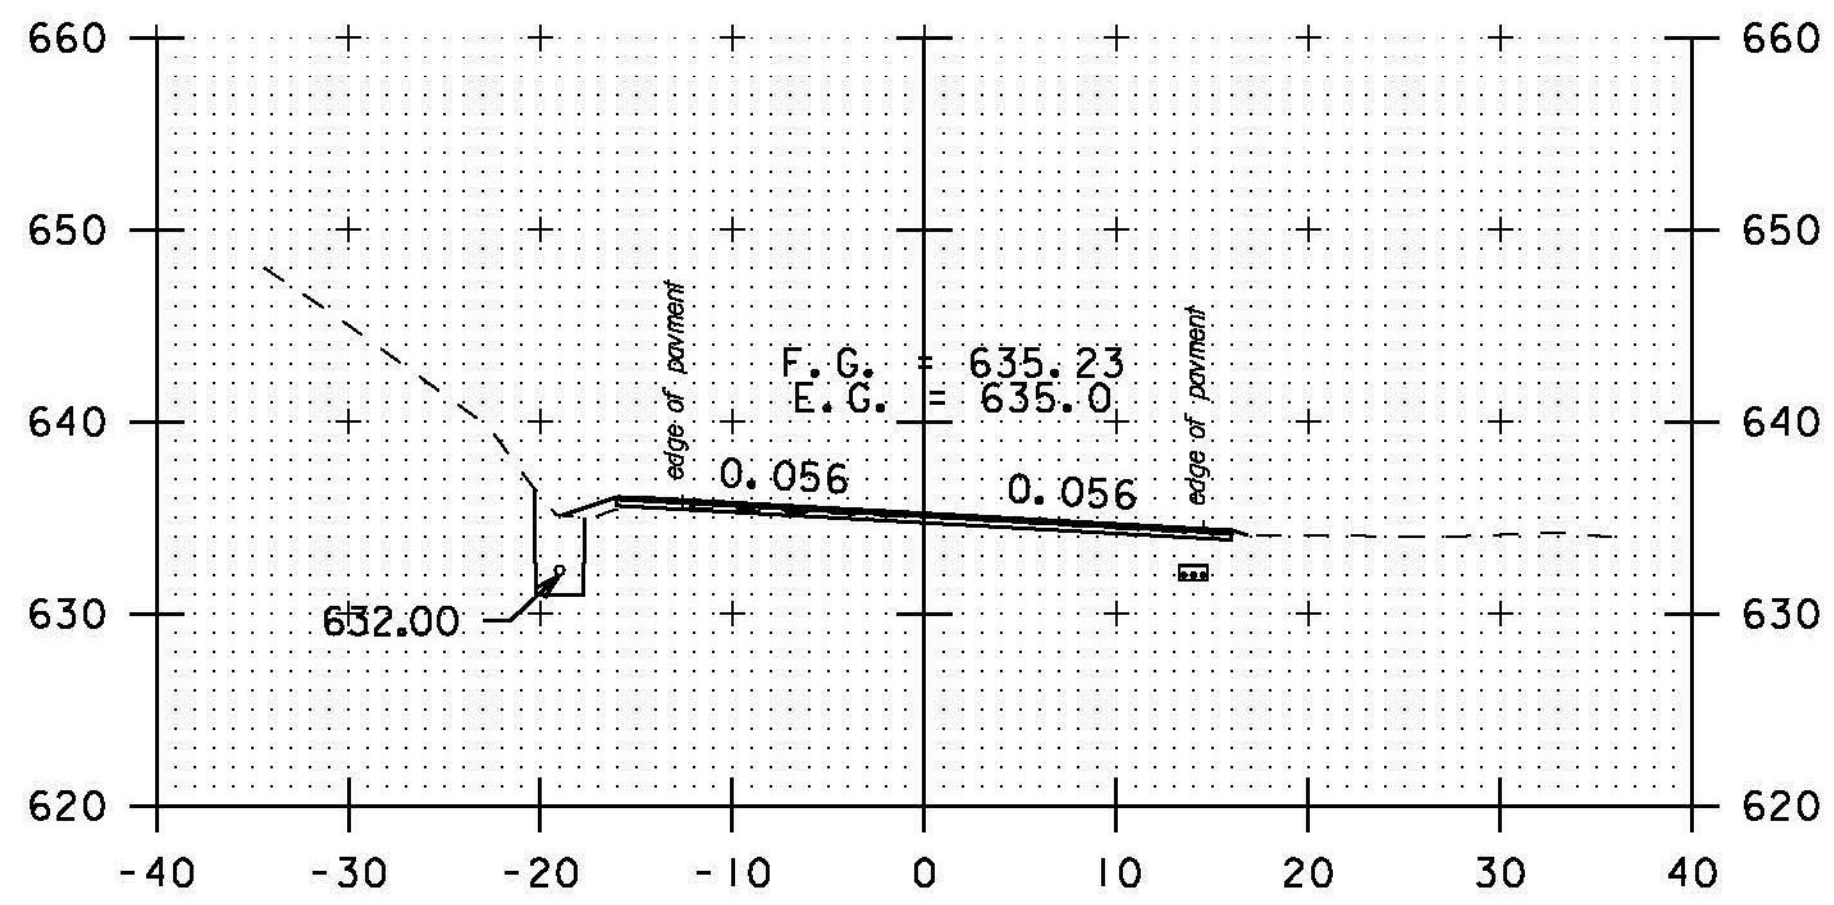


166+50

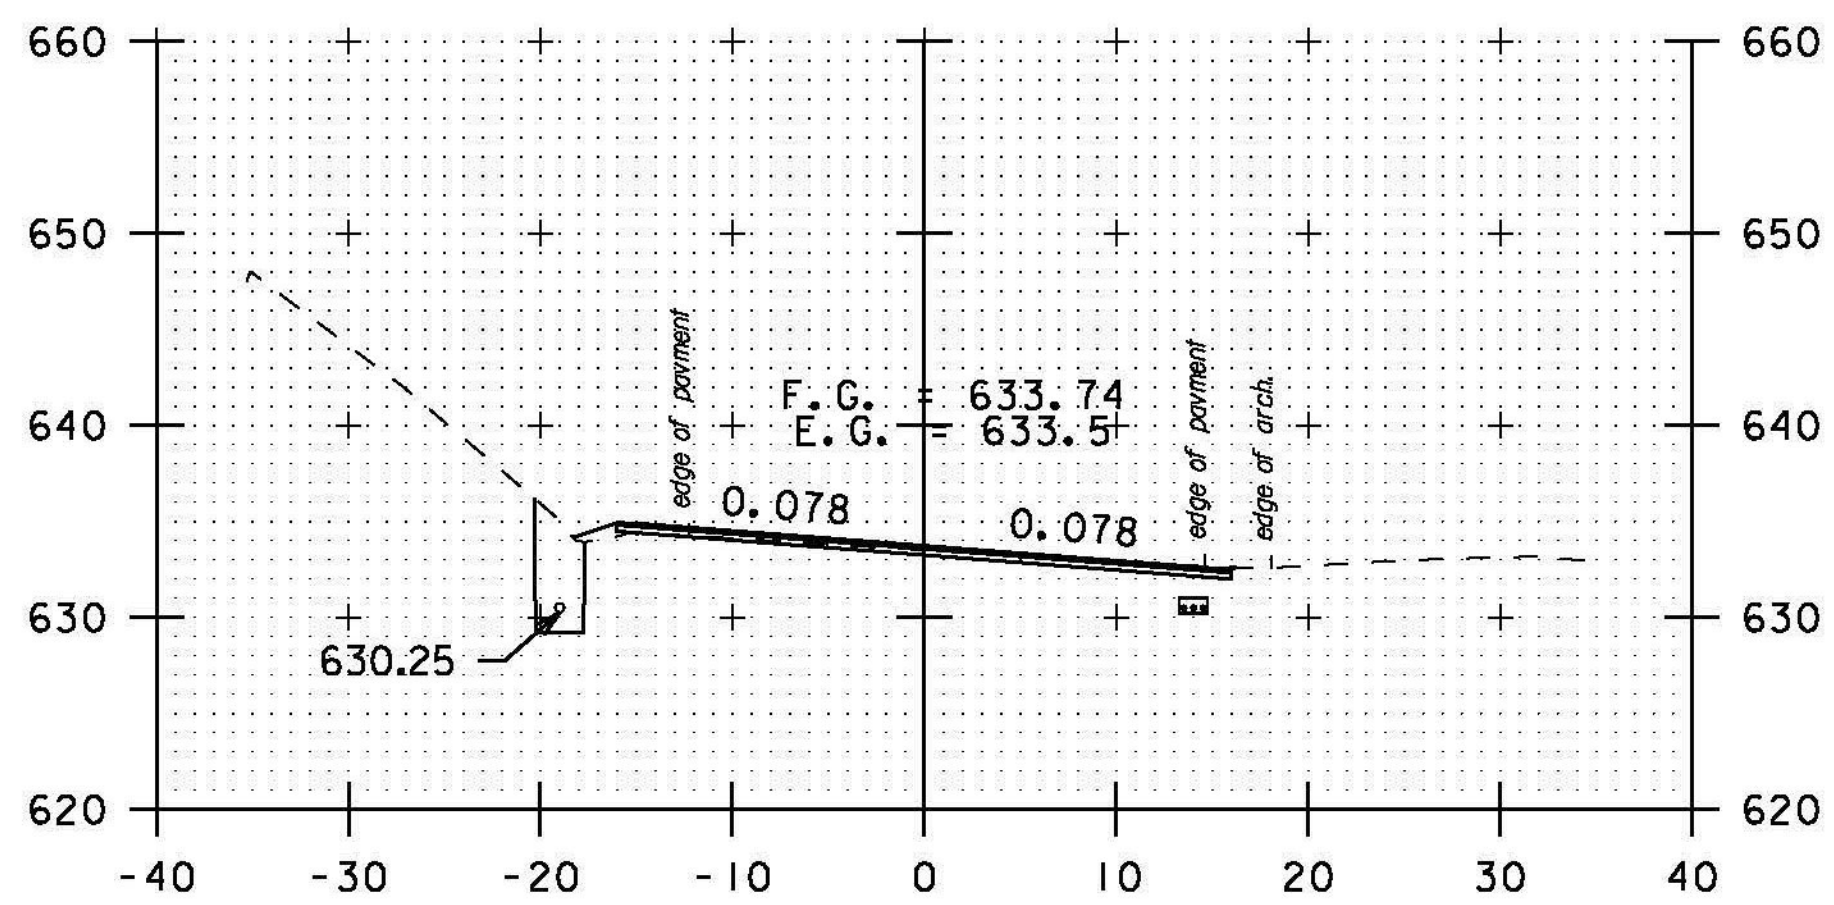

166+00

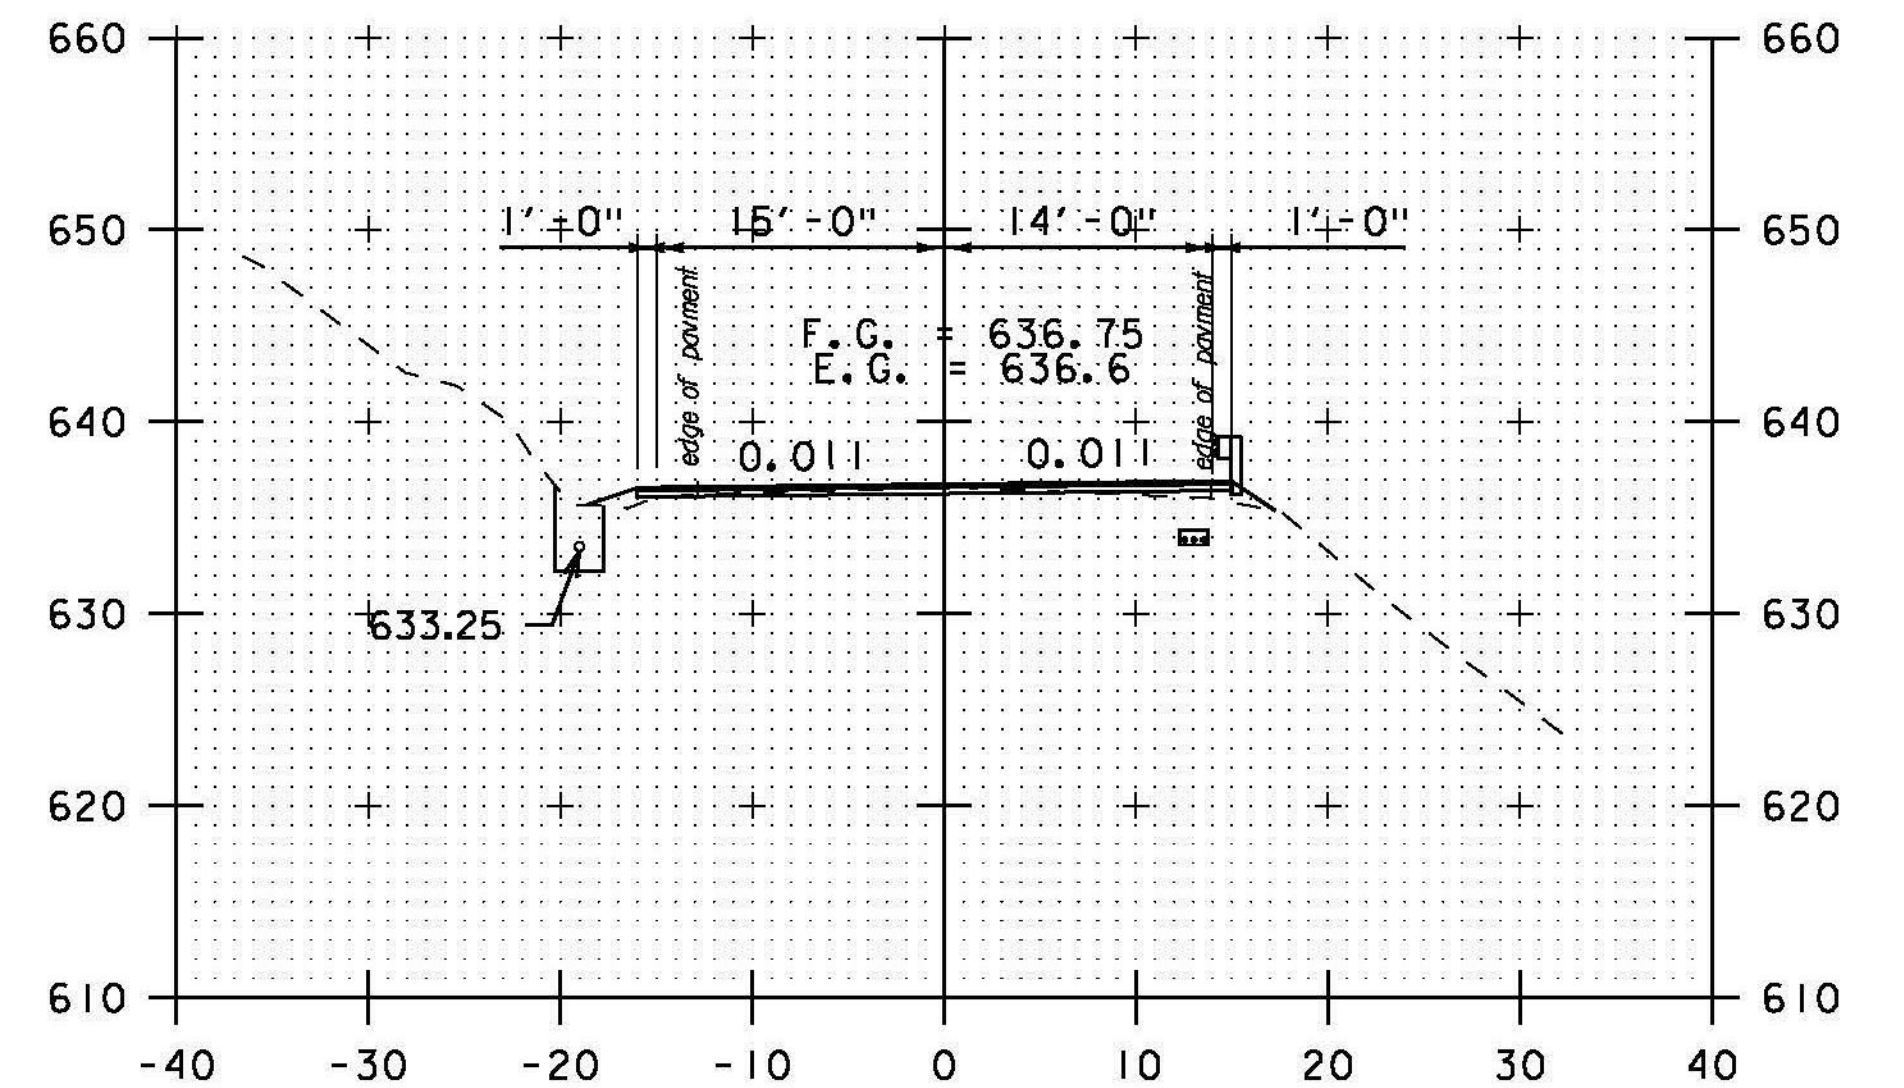


168+00

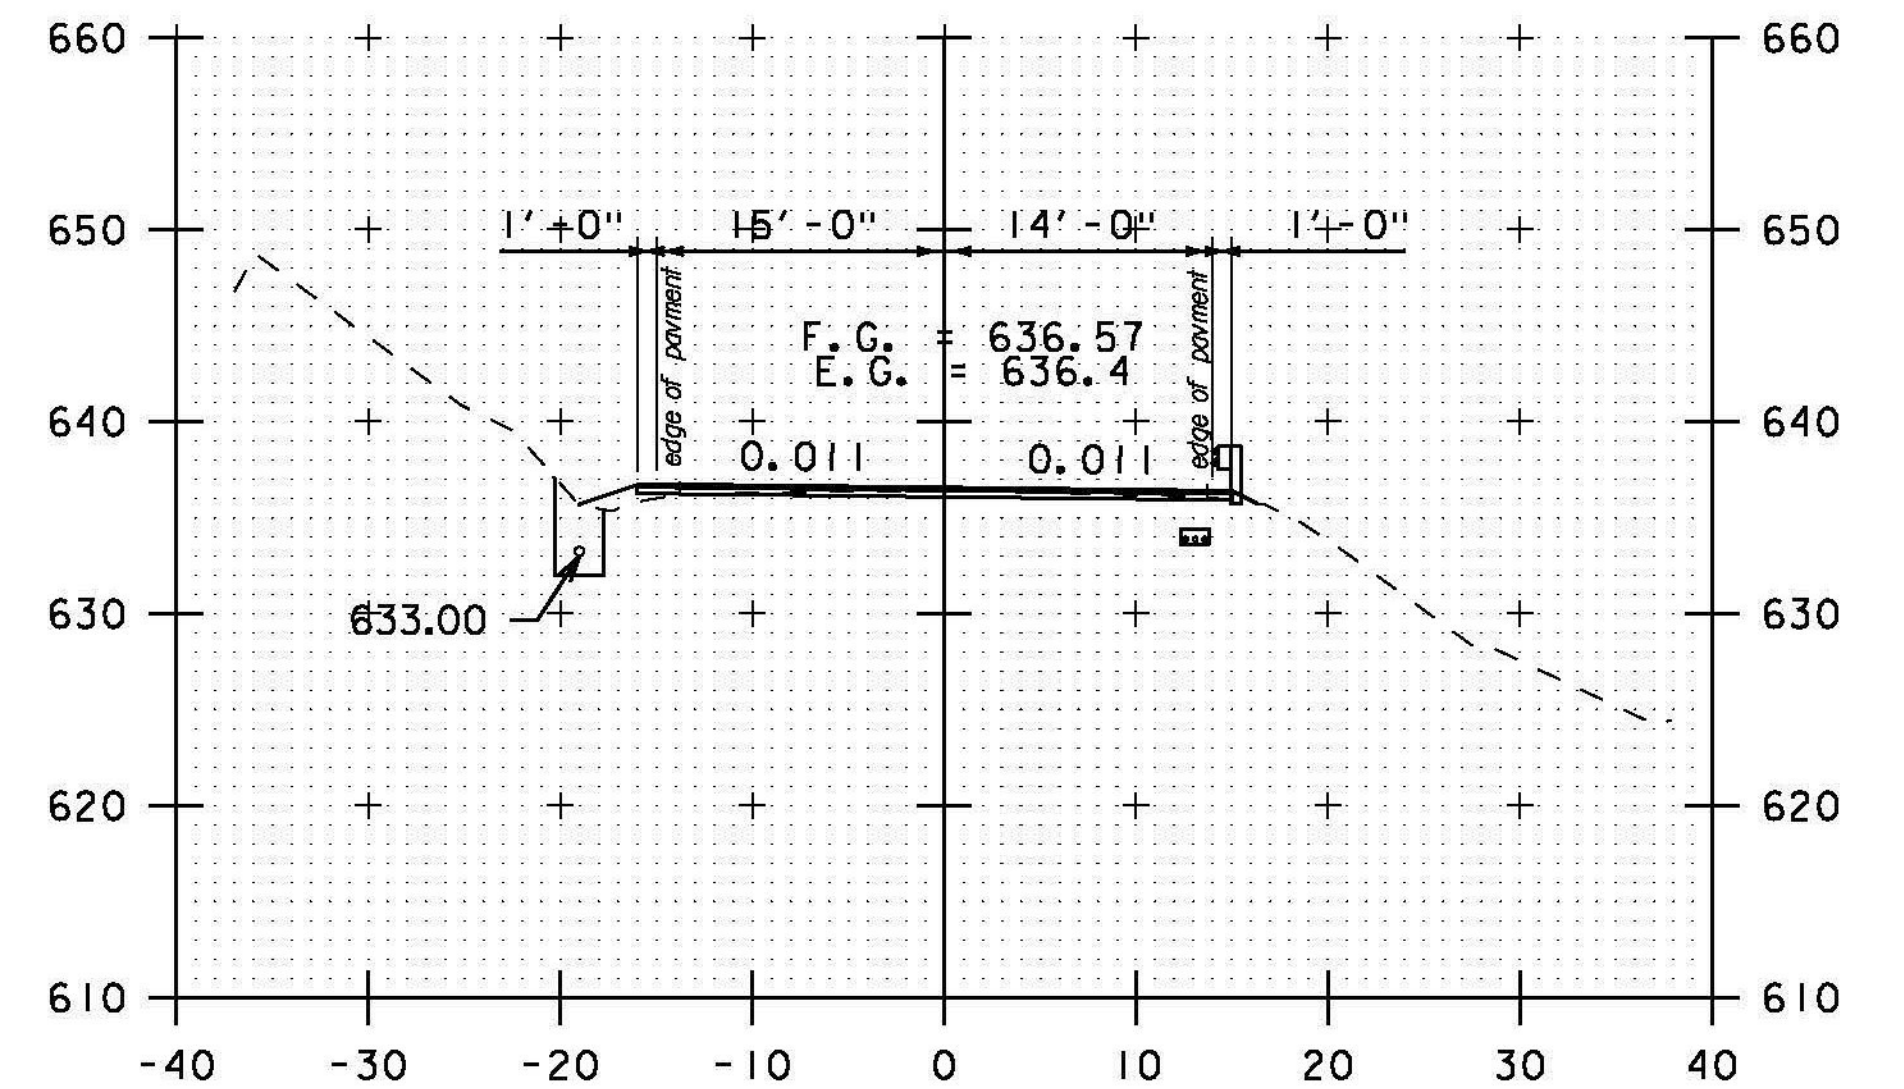

167+50

DRIVE RT

STA. 164+50 TO STA. 168+00

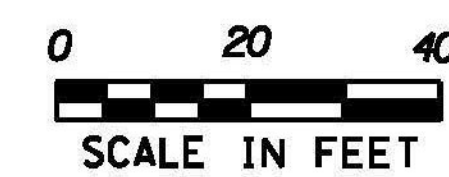

PROJECT NAME: BETHEL-RANDOLPH  
PROJECT NUMBER: STP 292(I)

FILE NAME: piOC244.dgn  
PROJECT LEADER: C. LATHROP  
DESIGNED BY: S. LAMPHERE  
CROSS SECTION SHEET 9

PLOT DATE: 4/23/2015  
DRAWN BY: S. LAMPHERE  
CHECKED BY: C. LATHROP  
SHEET 143 OF 211