




178+50

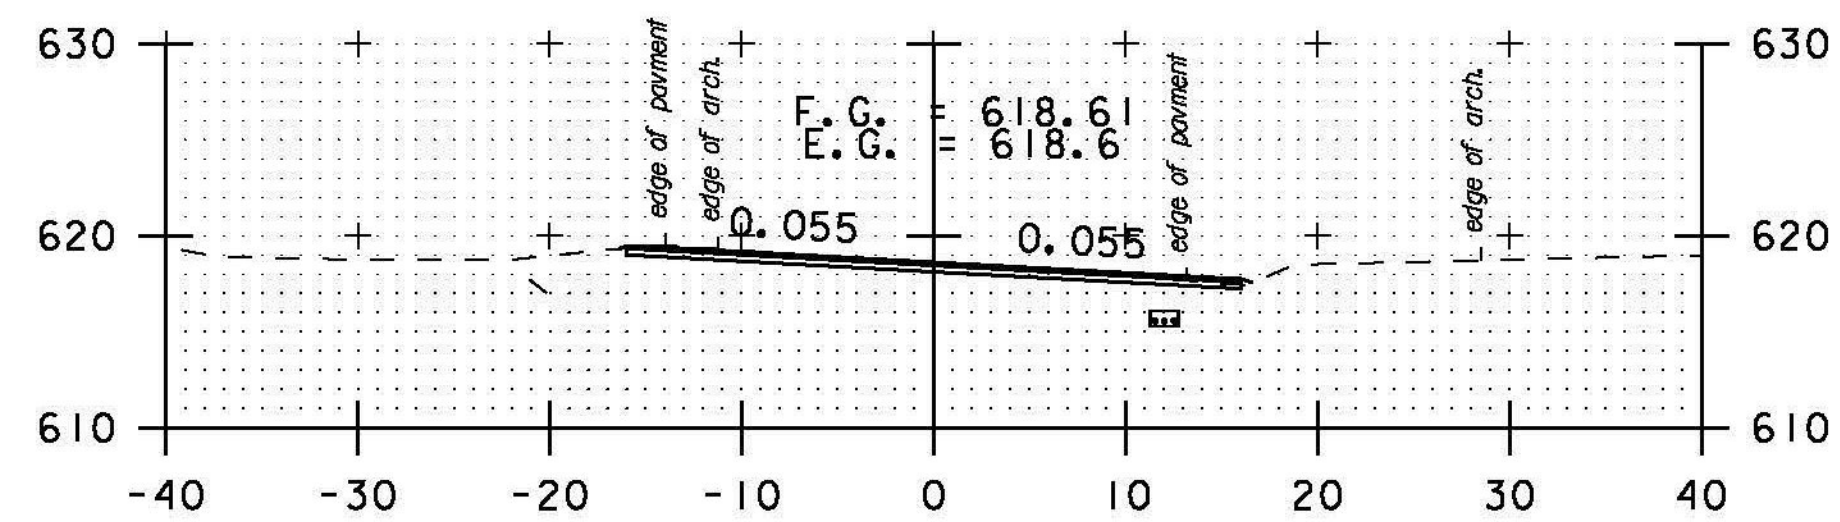


178+00

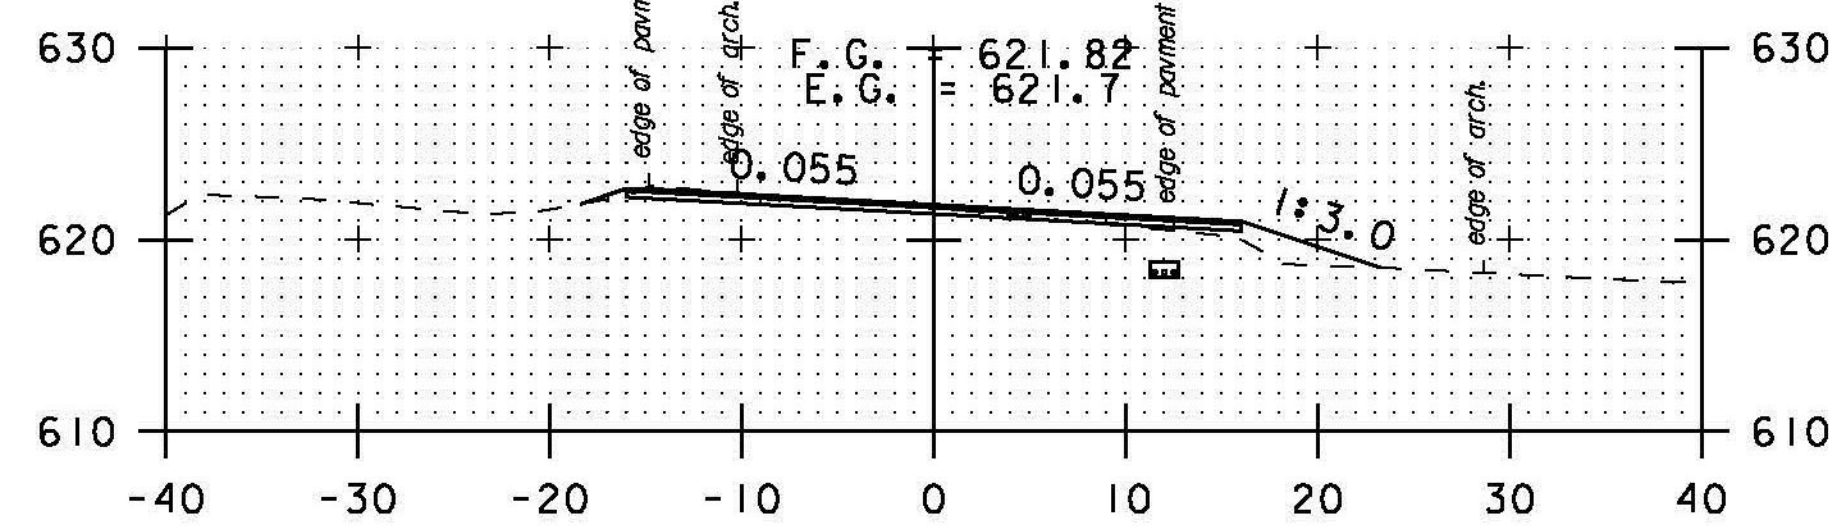


177+50

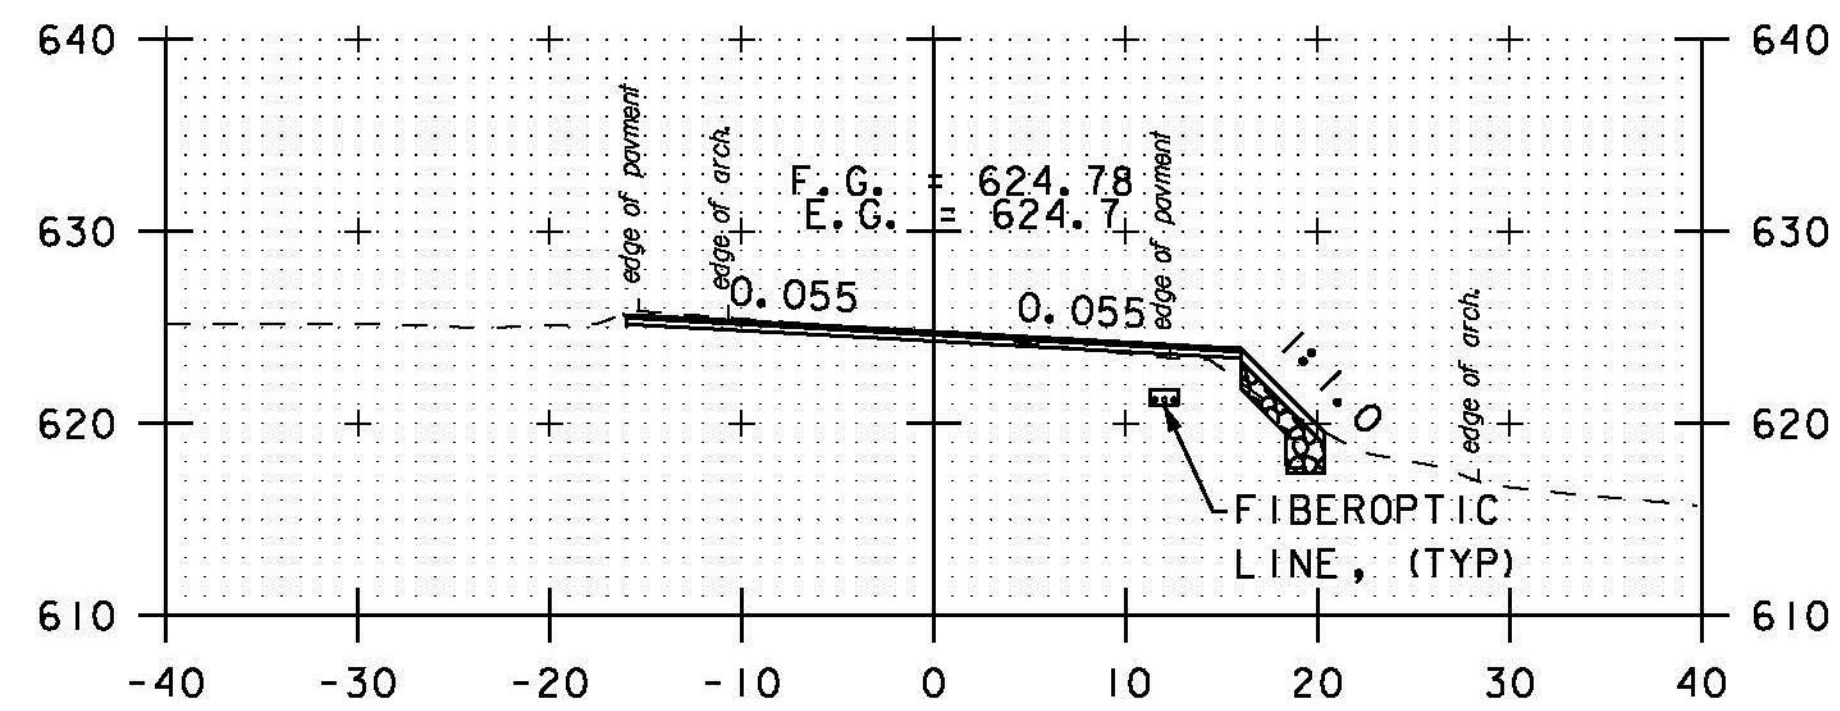


177+00

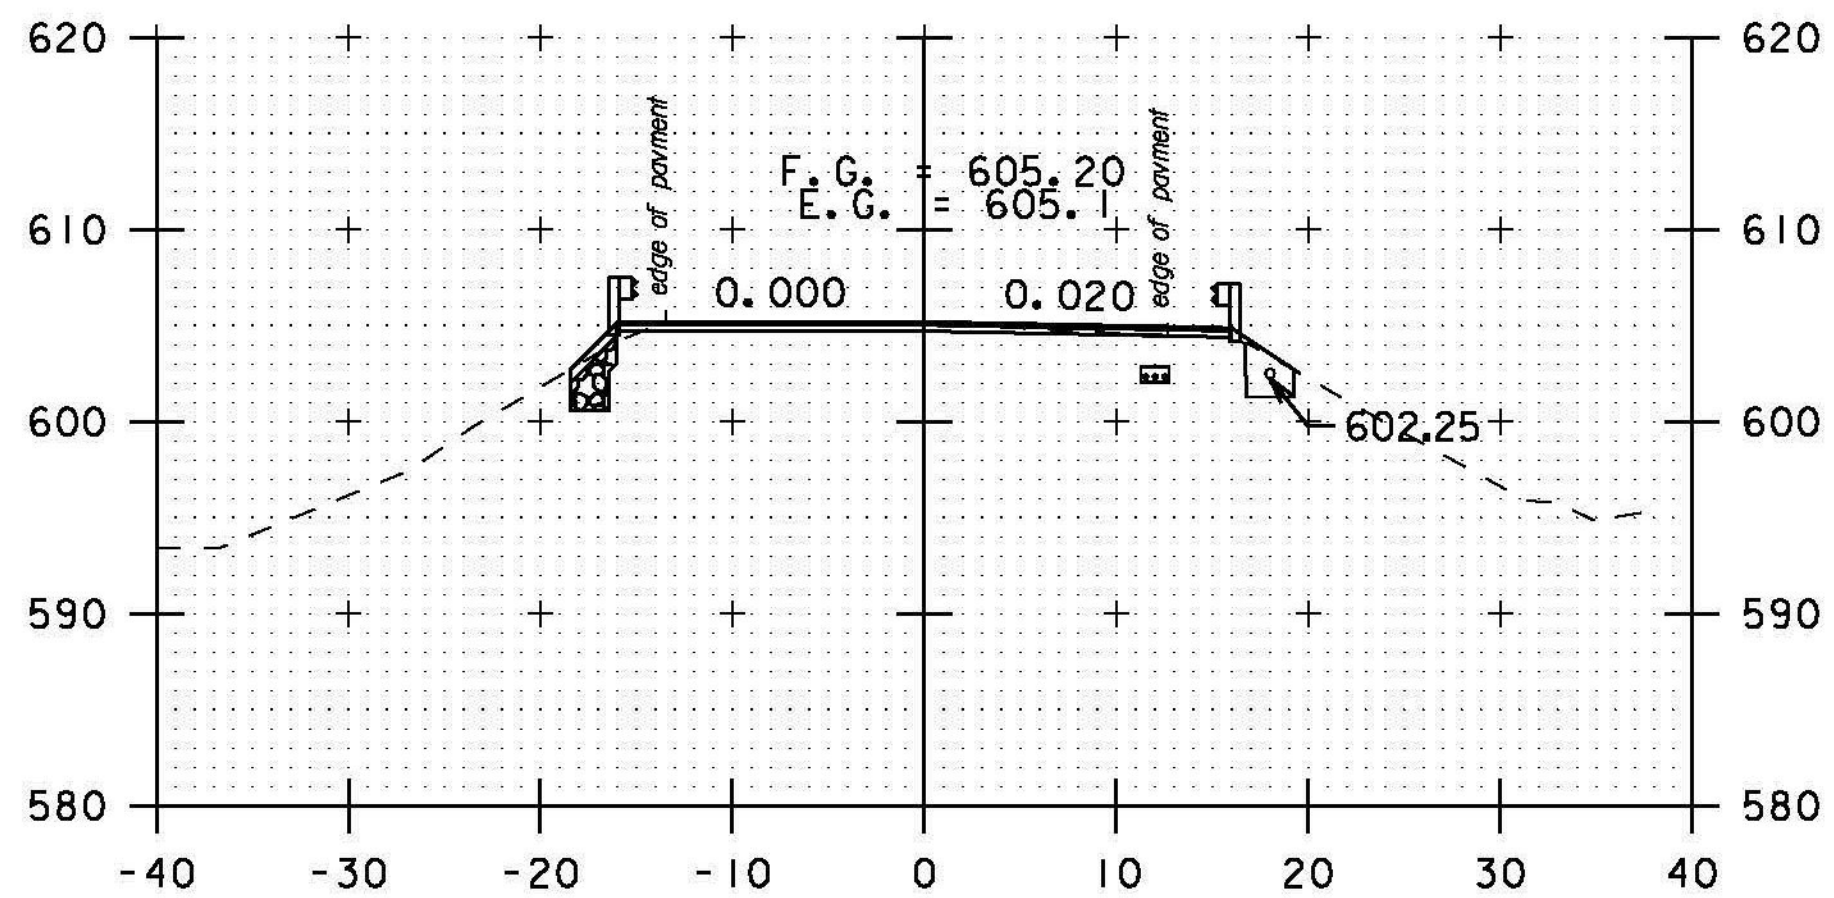


180+00

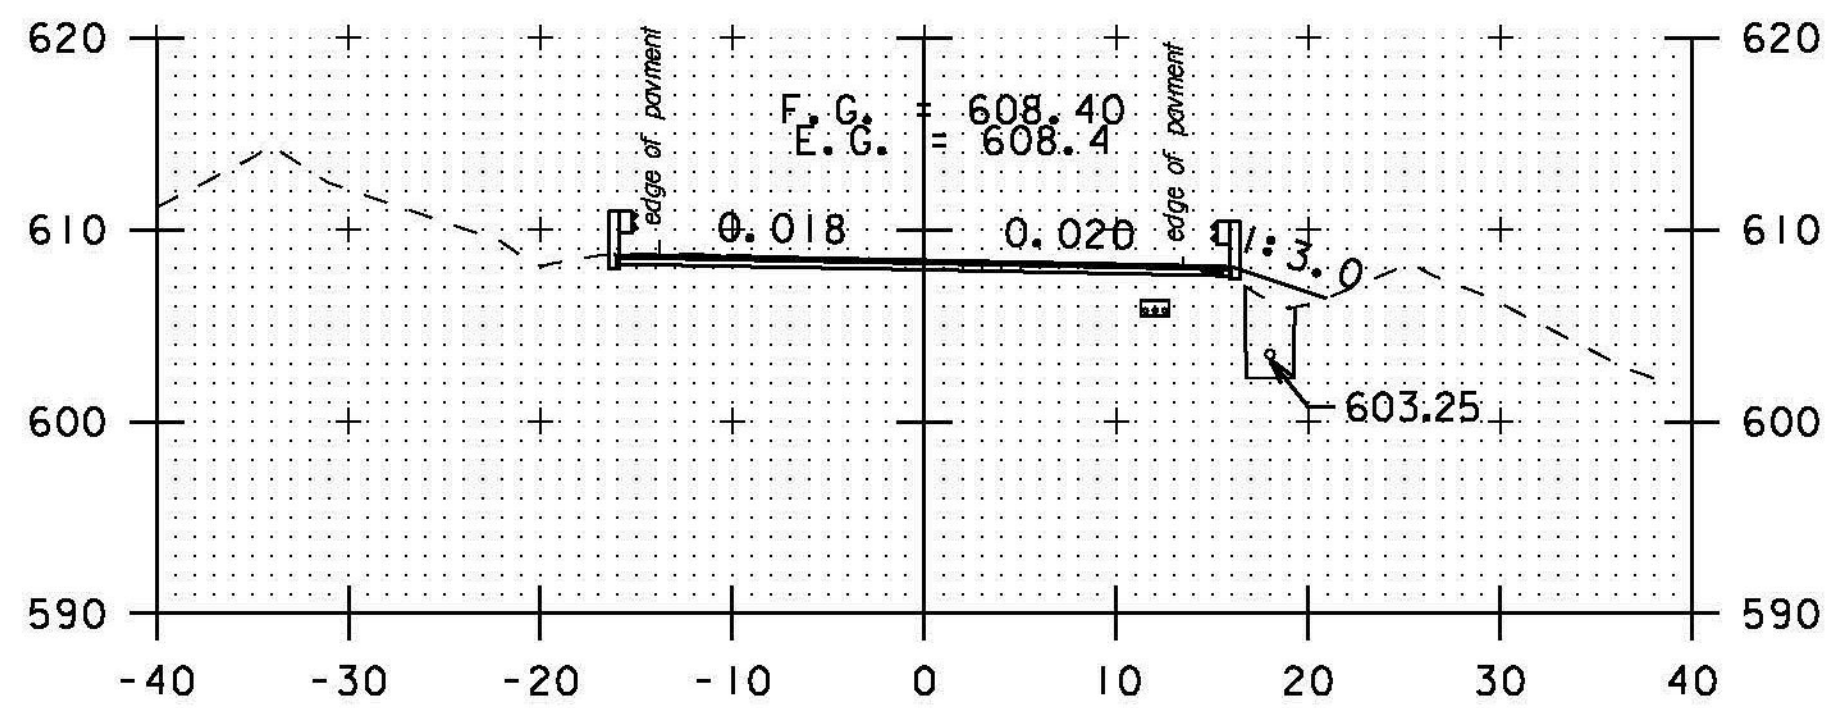


179+50

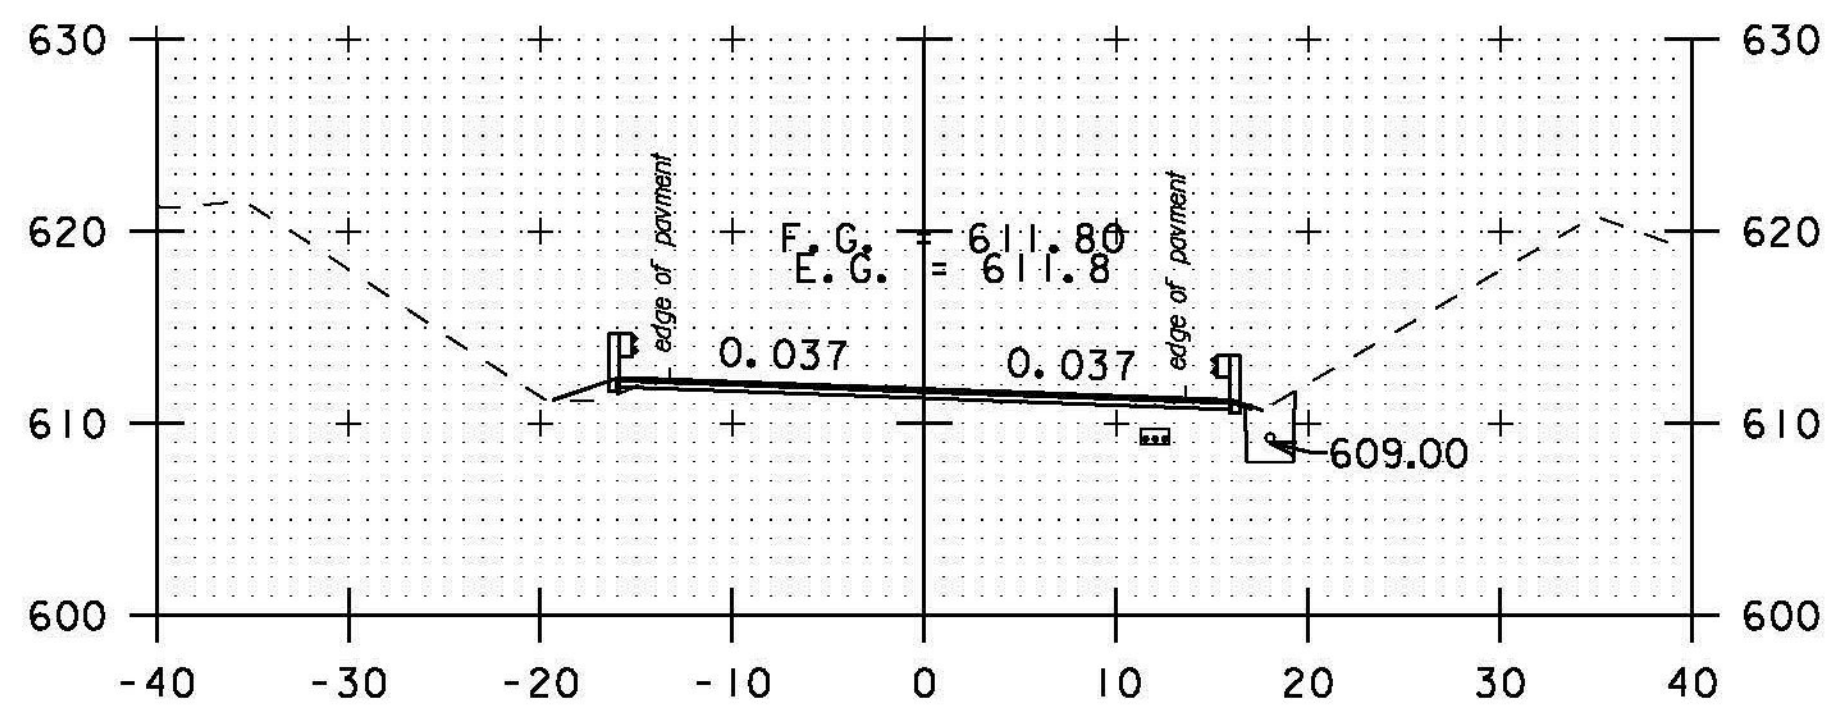


179+00

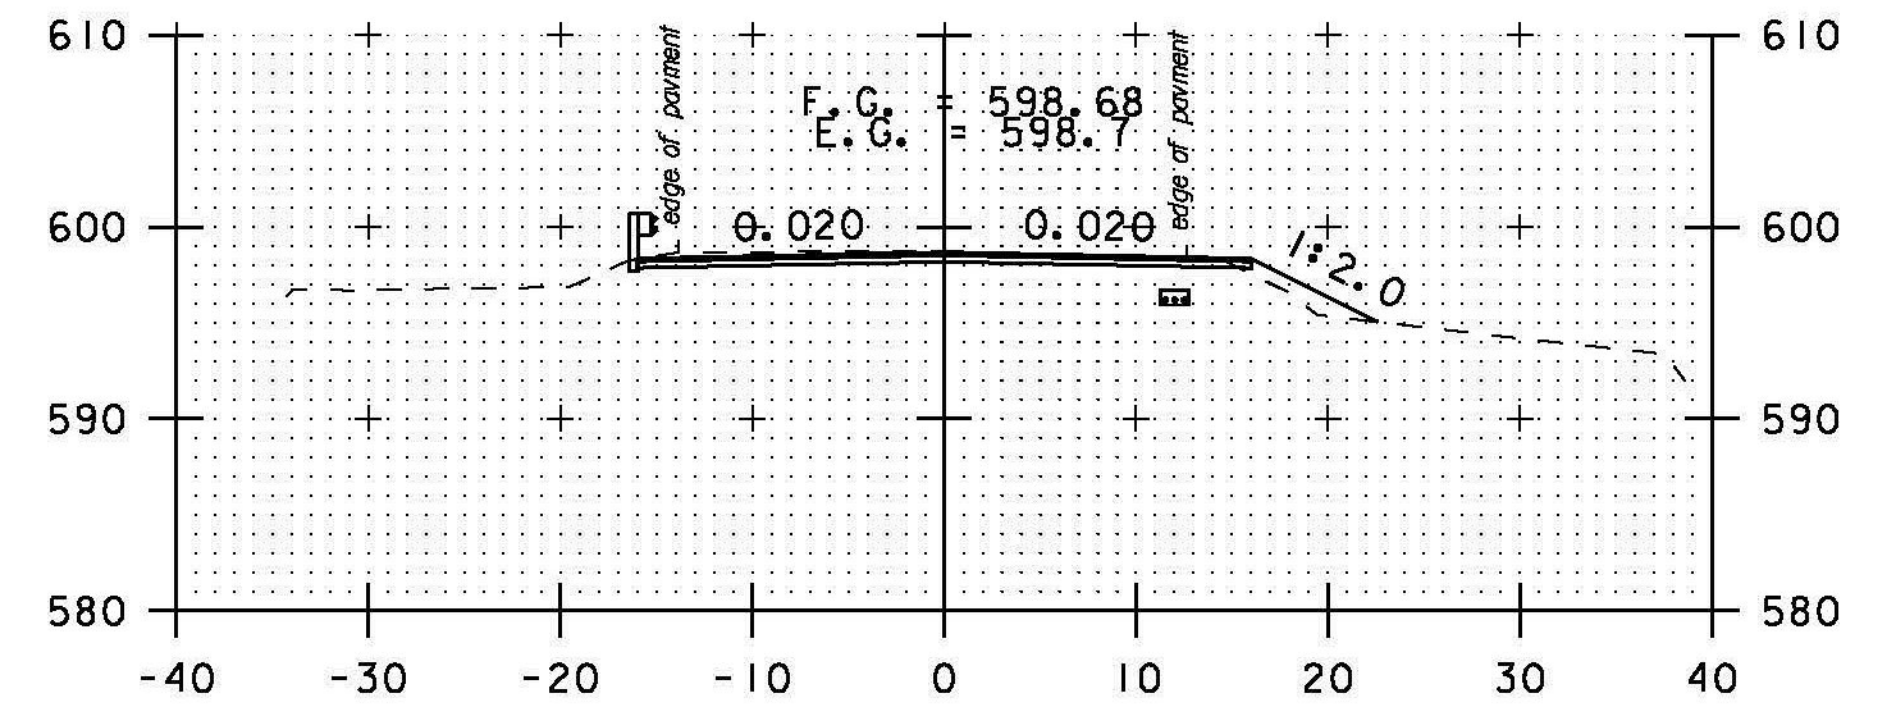

181+50

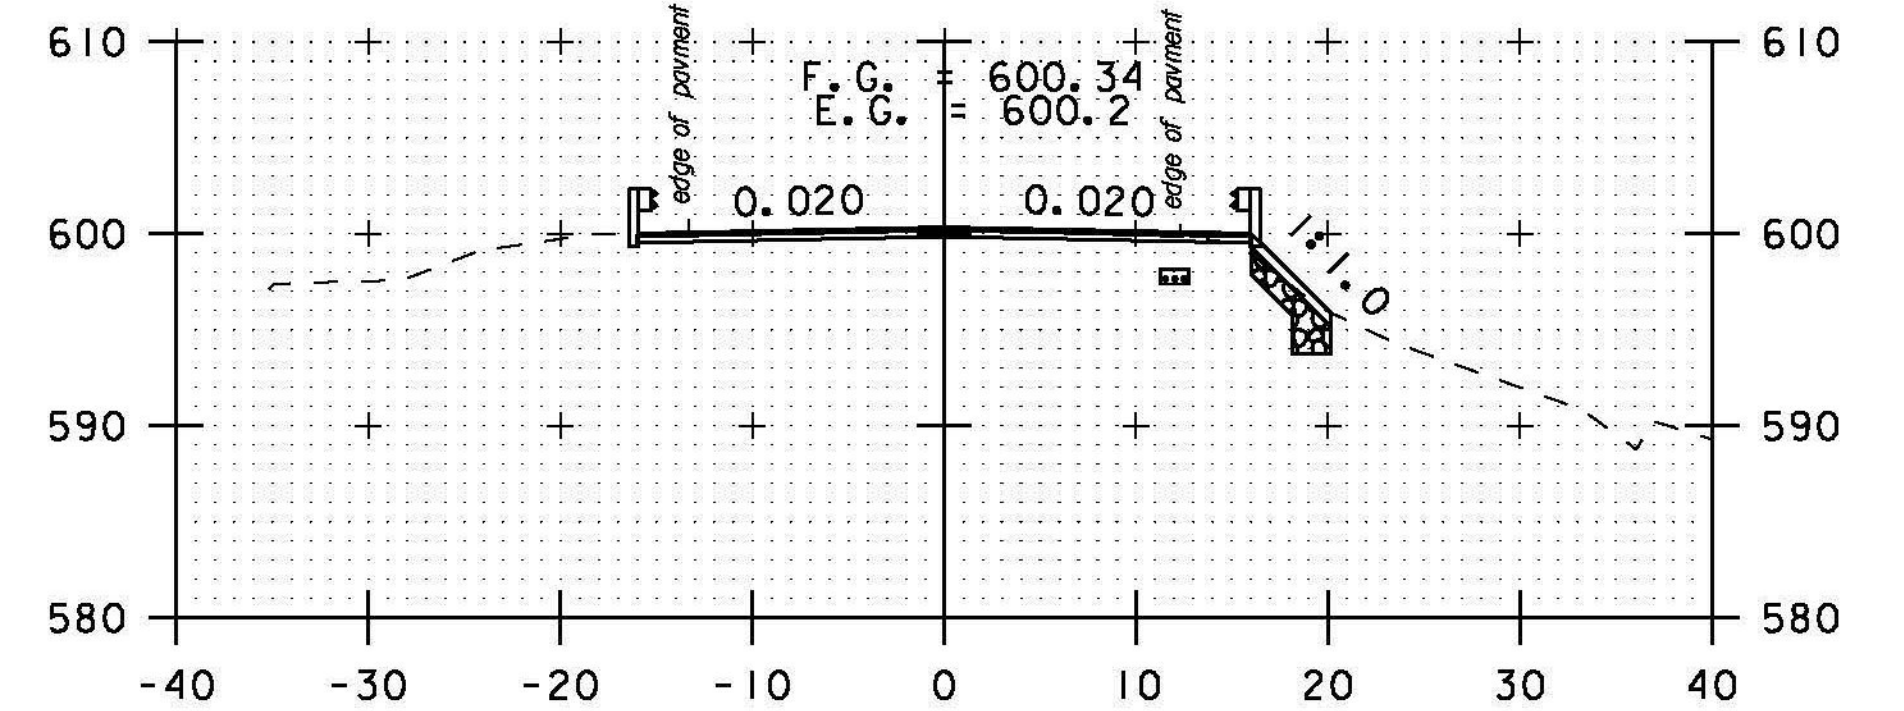


181+00

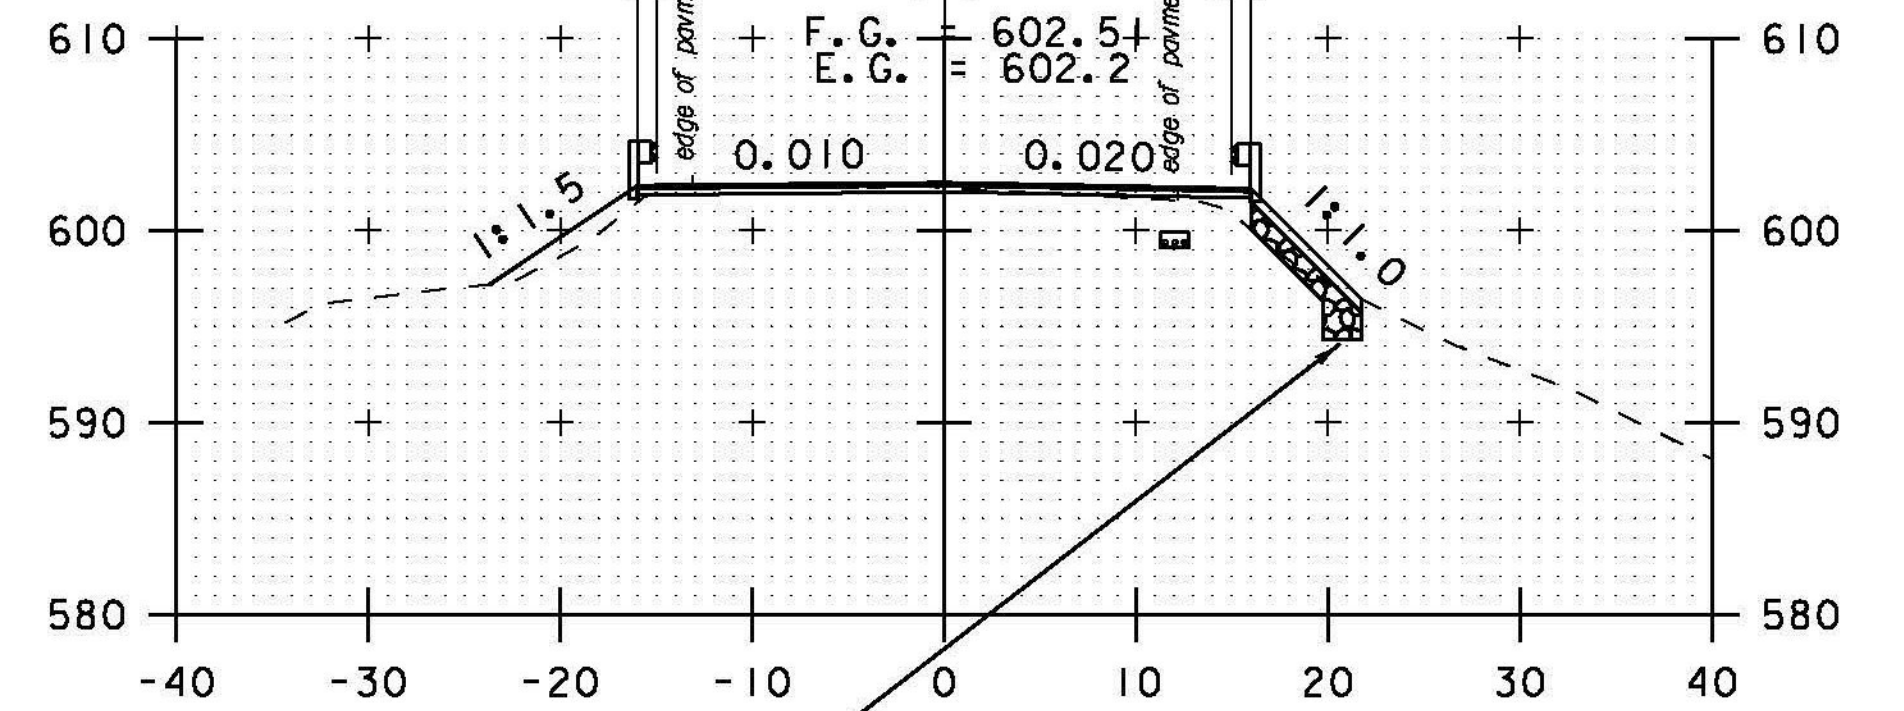

180+50

12" STONE FILL, TYPE I (TYP.)
6" GRUBBING MATERIAL (TYP.)
GEOTEXTILE UNDER STONE FILL (TYP.)

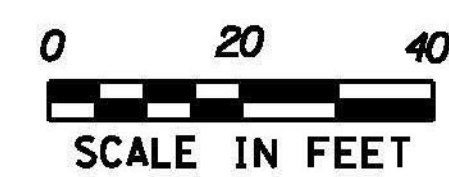

SCALE IN FEET

STA. 177+00 TO STA. 181+50

PROJECT NAME: BETHEL-RANDOLPH
PROJECT NUMBER: STP 292(K)

FILE NAME: piOC244.dgn
PROJECT LEADER: C. LATHROP
DESIGNED BY: S. LAMPHERE
CROSS SECTION SHEET 12

PLOT DATE: 4/23/2015
DRAWN BY: S. LAMPHERE
CHECKED BY: C. LATHROP
SHEET 146 OF 211