




183+00

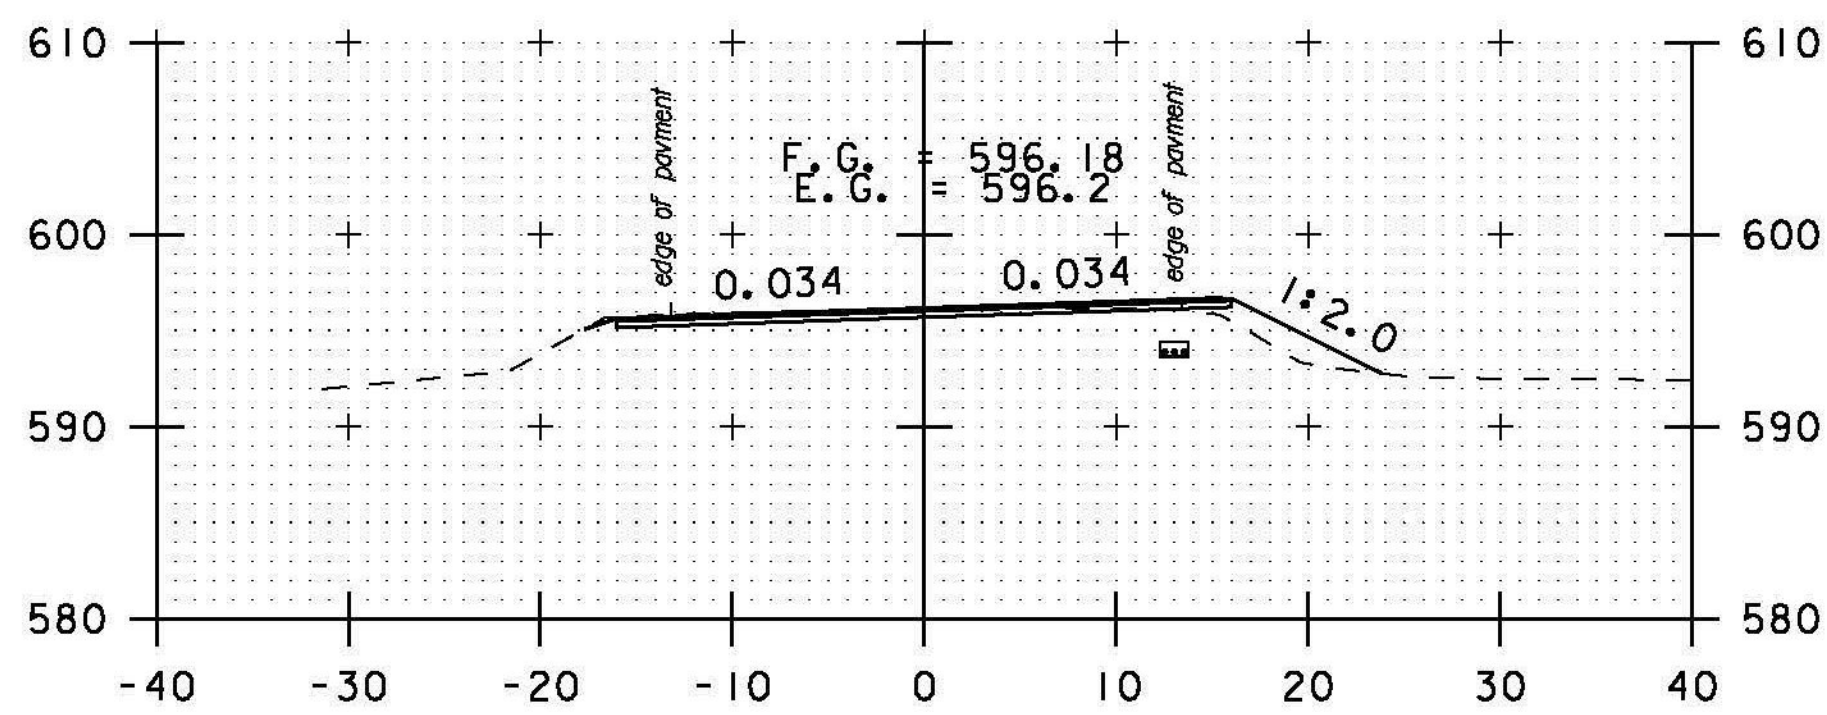


184+50

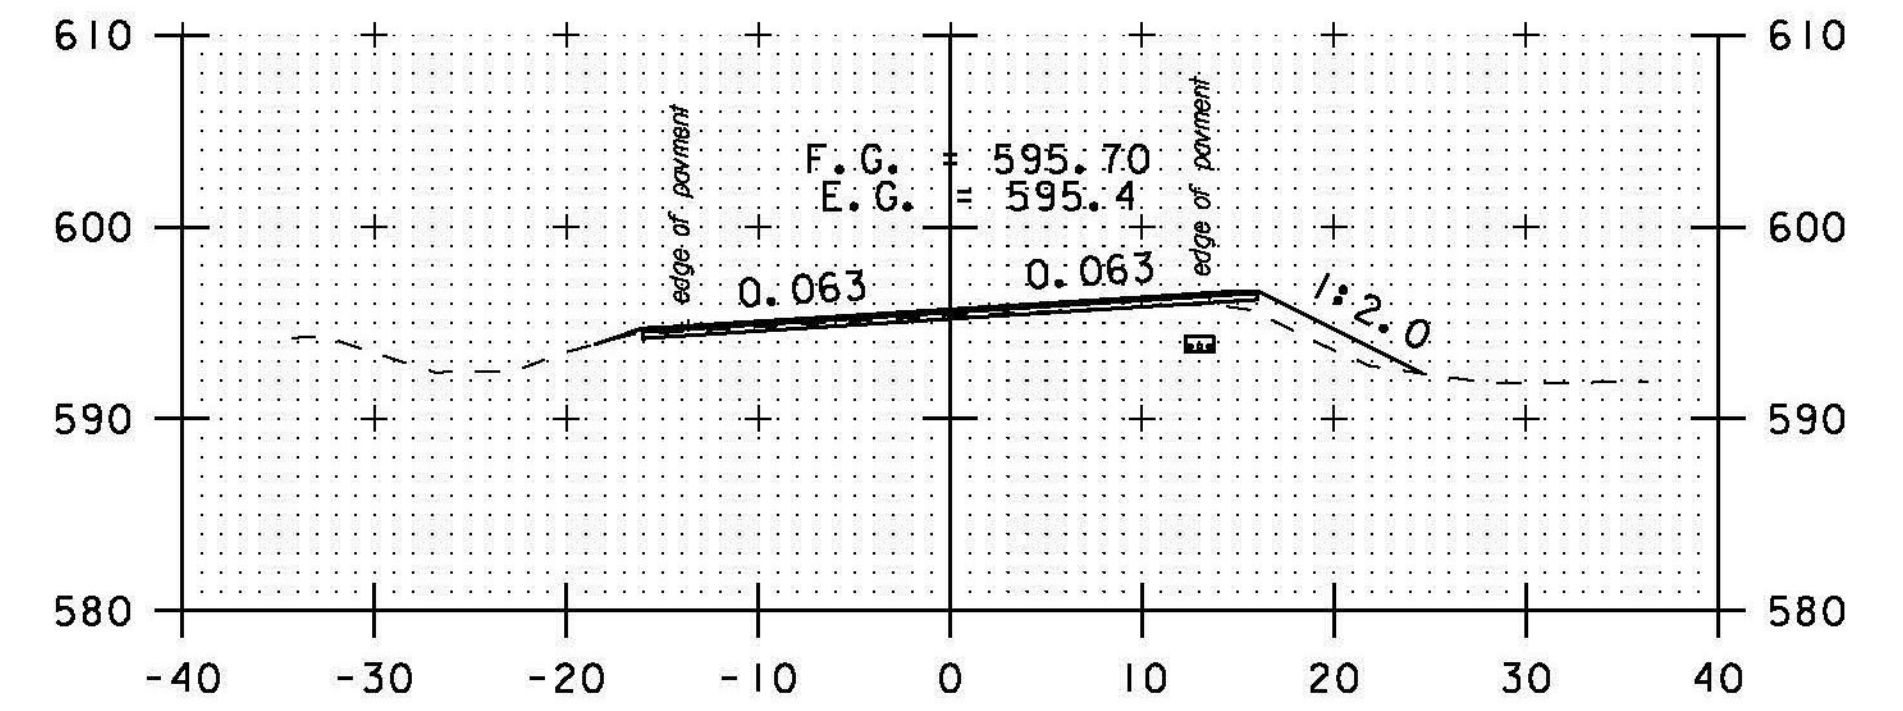


186+00

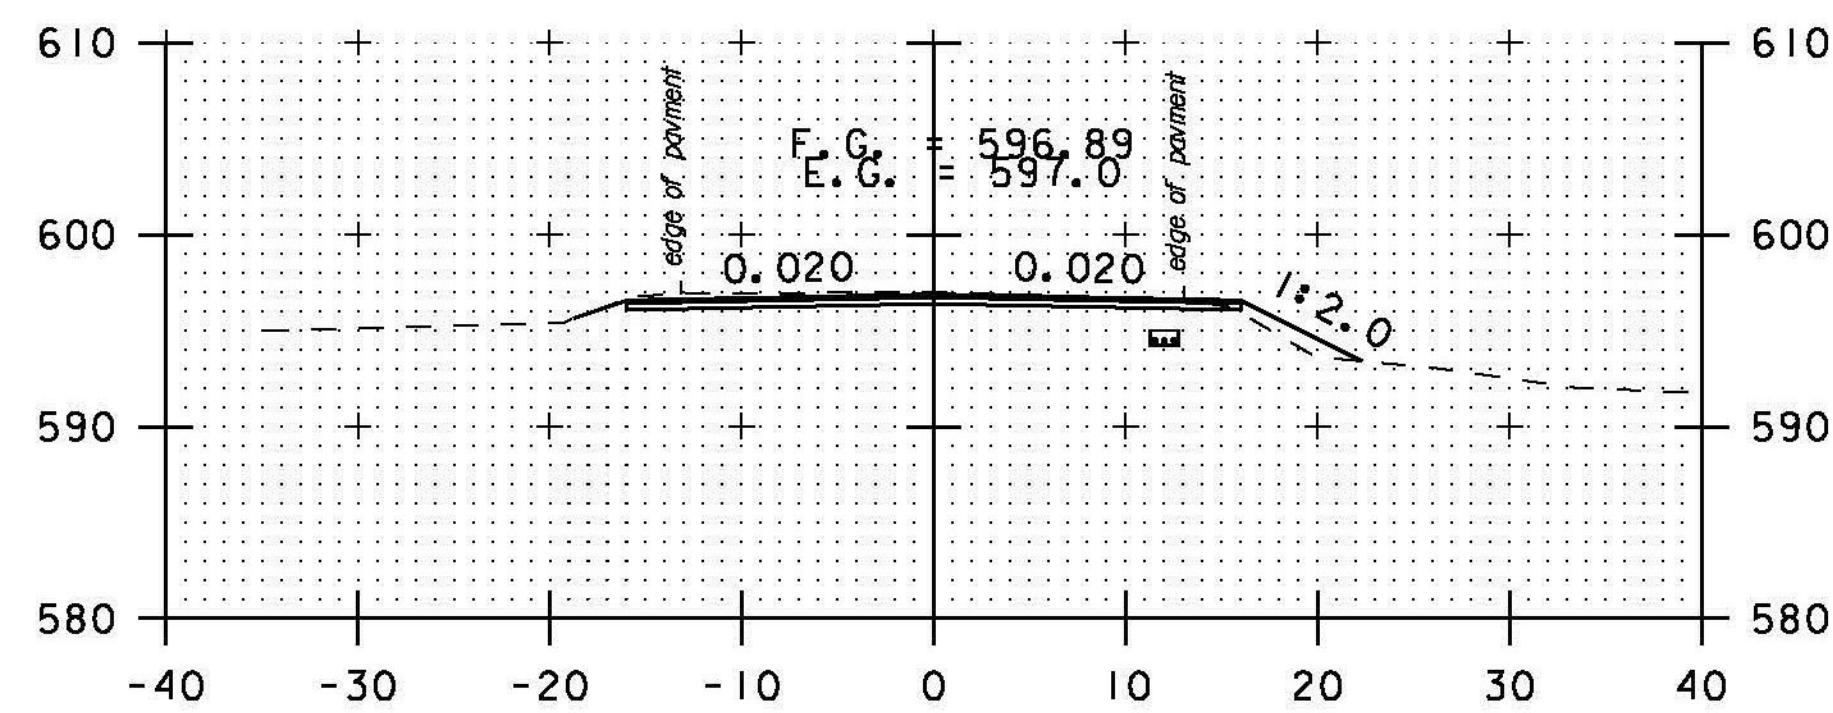


182+50

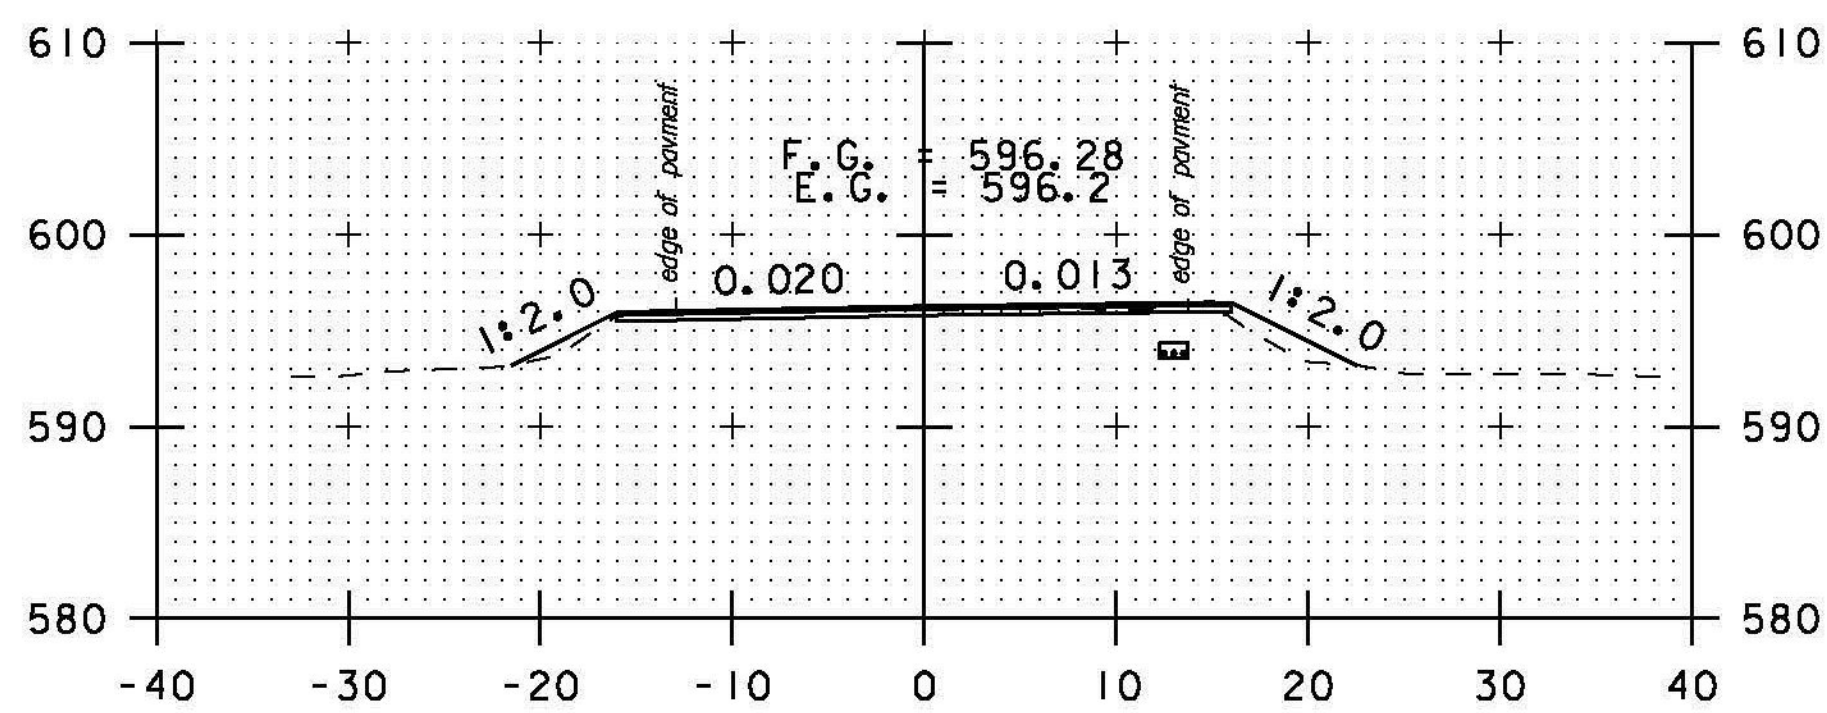


184+00

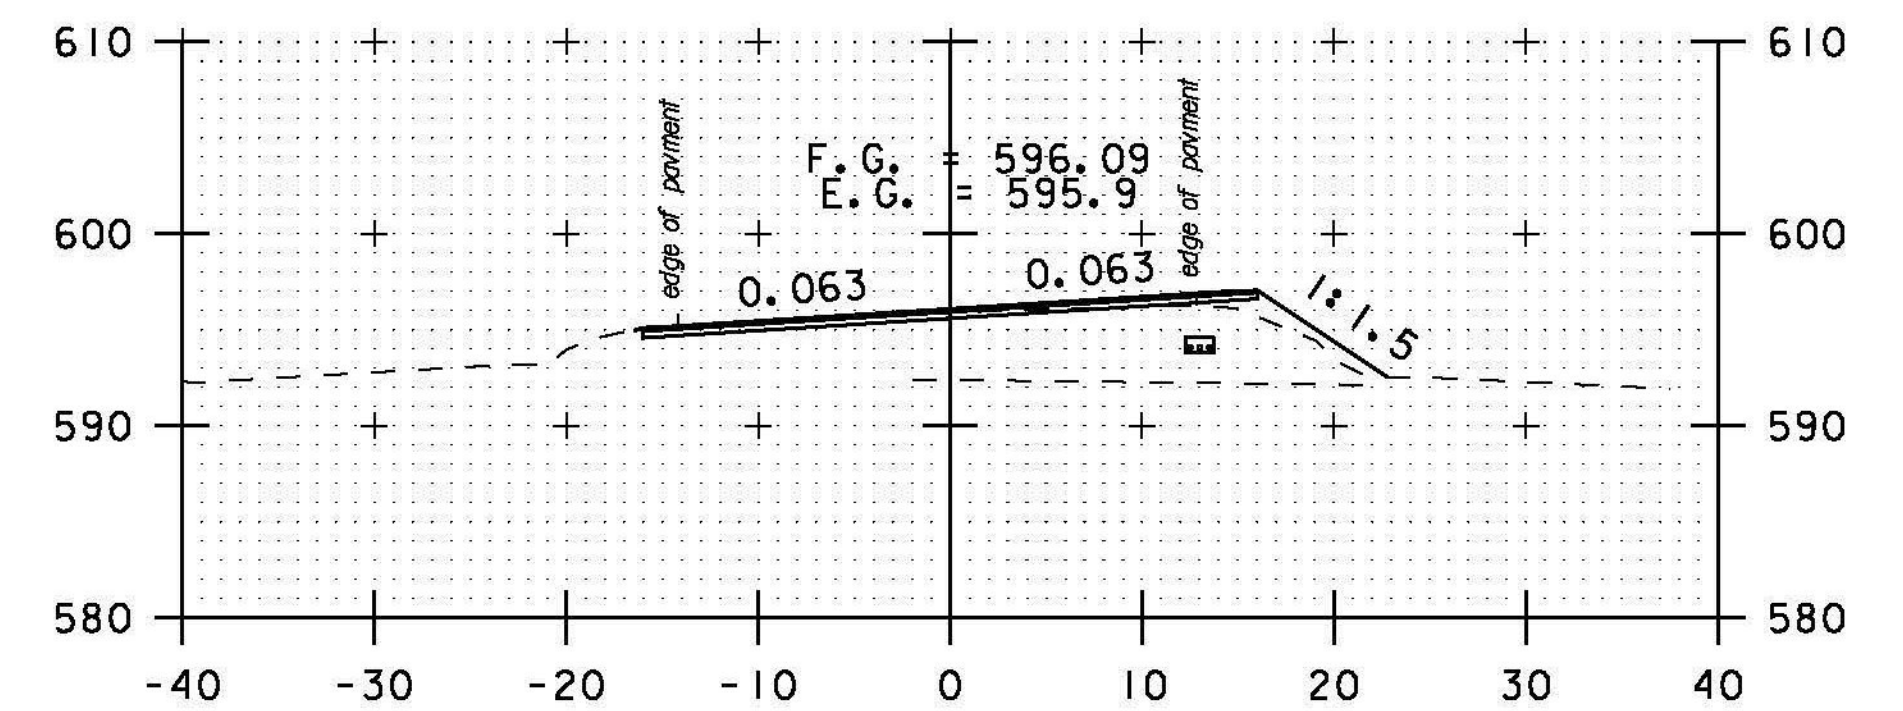


185+50

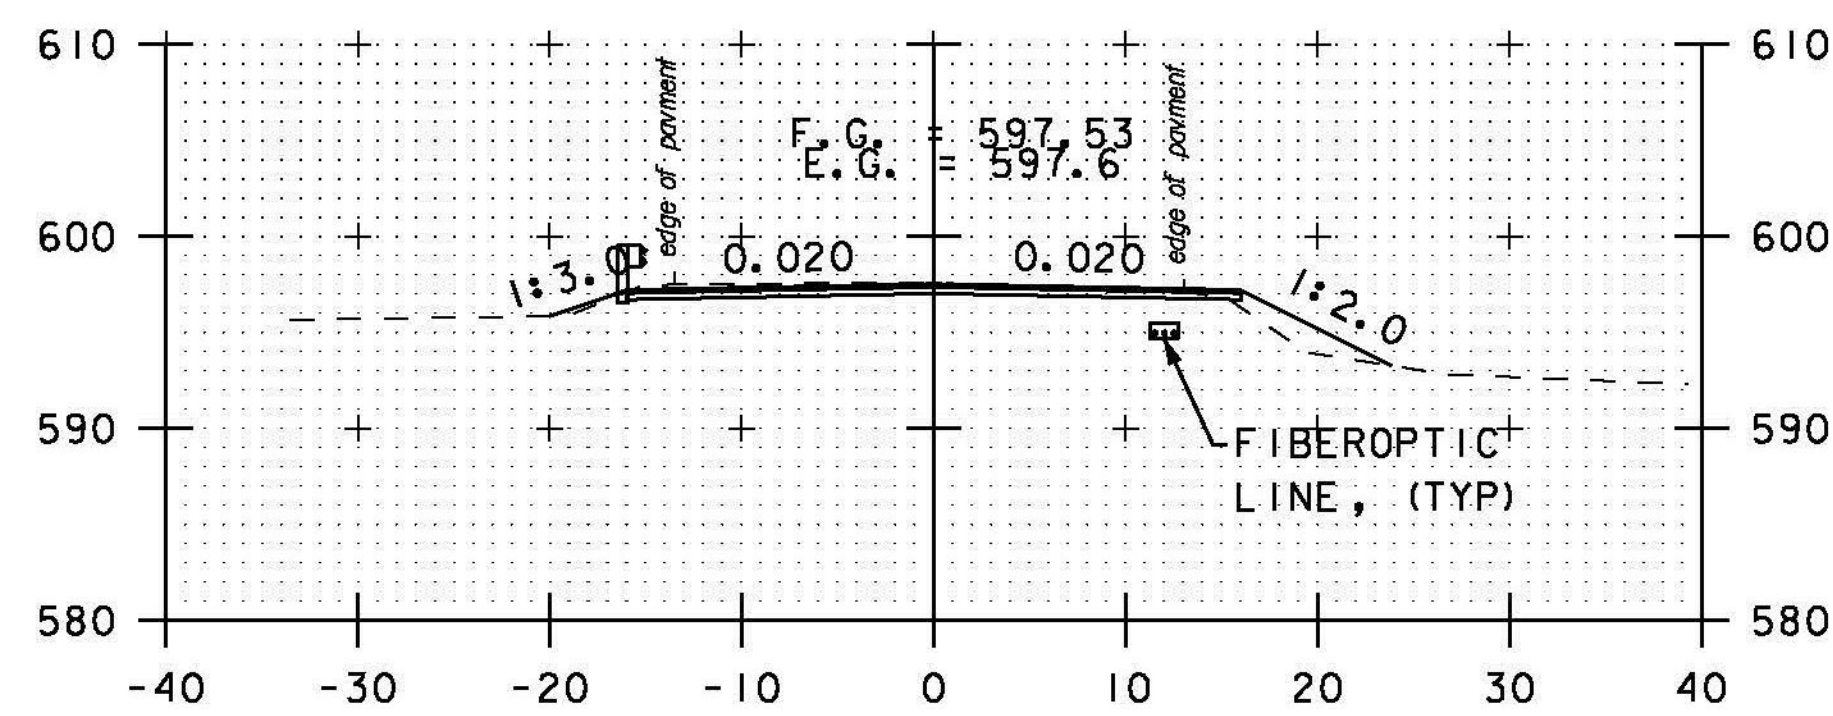

182+00

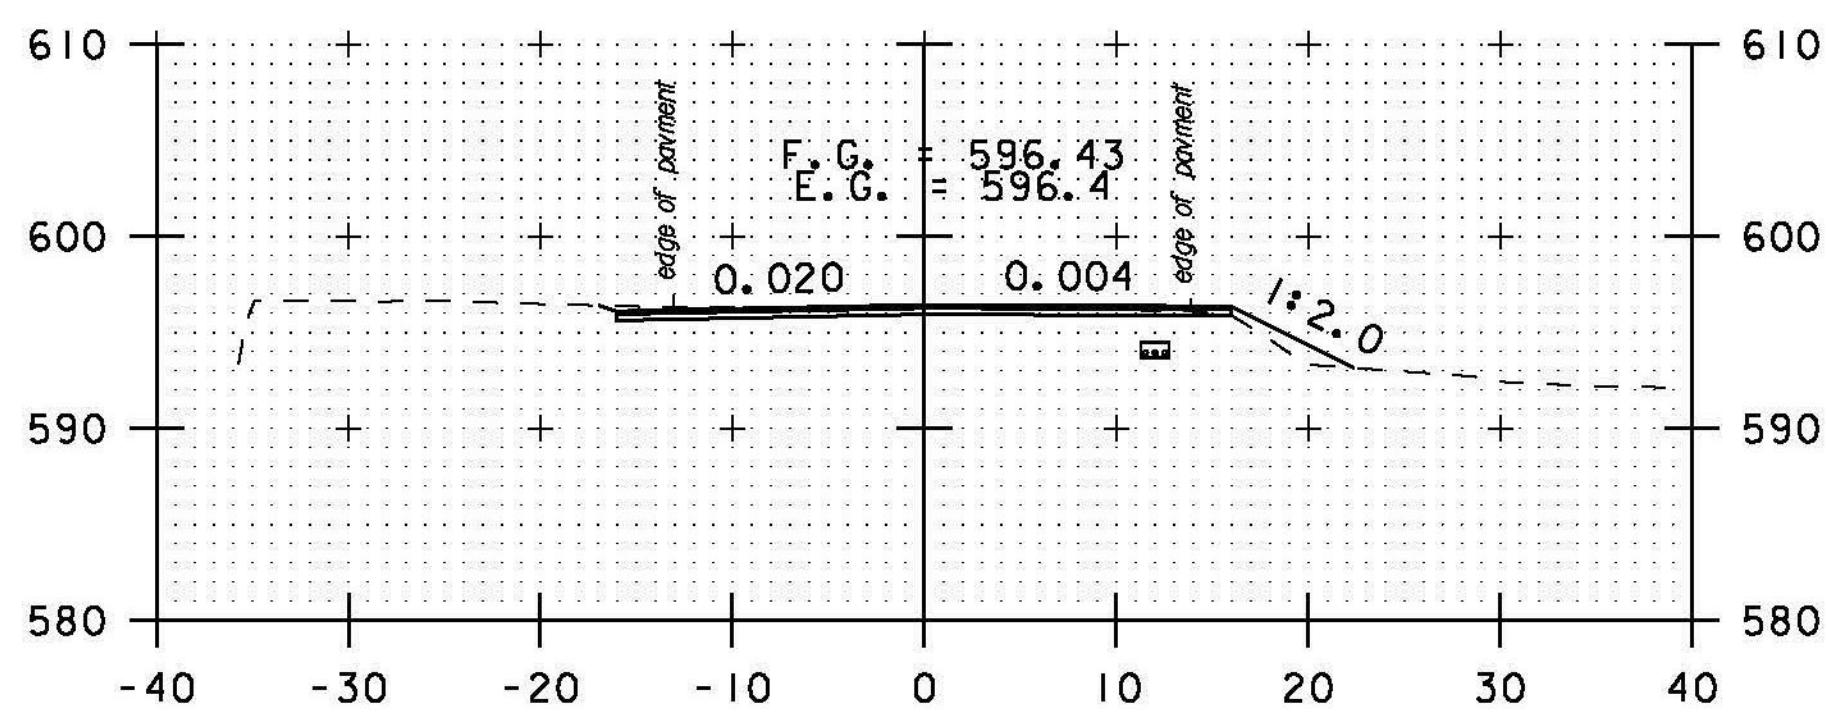


DRIVE LT
183+50

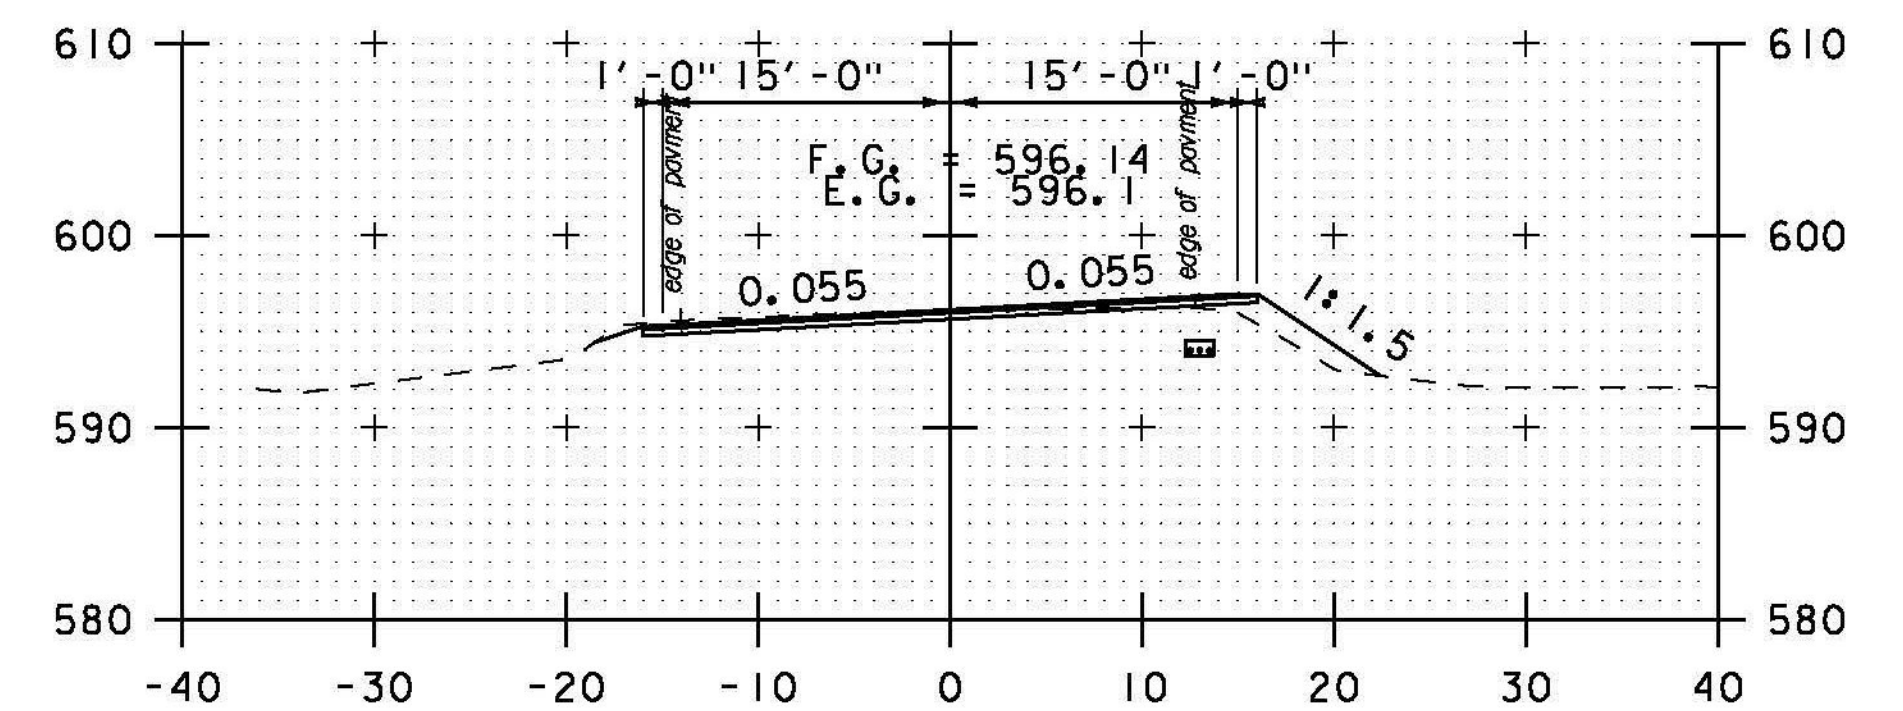

185+00

STA. 182+00 TO STA. 186+00

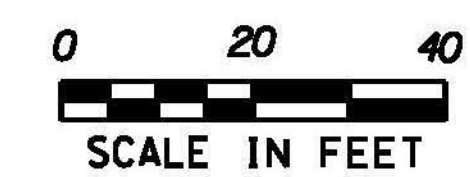

PROJECT NAME:	BETHEL-RANDOLPH	PLOT DATE:	4/23/2015
PROJECT NUMBER:	STP 292(I)	DRAWN BY:	S. LAMPHERE
FILE NAME:	plOC244.dgn	CHECKED BY:	C. LATHROP
PROJECT LEADER:	C. LATHROP	CROSS SECTION SHEET	13
DESIGNED BY:	S. LAMPHERE	SHEET	147 OF 211