




187+50

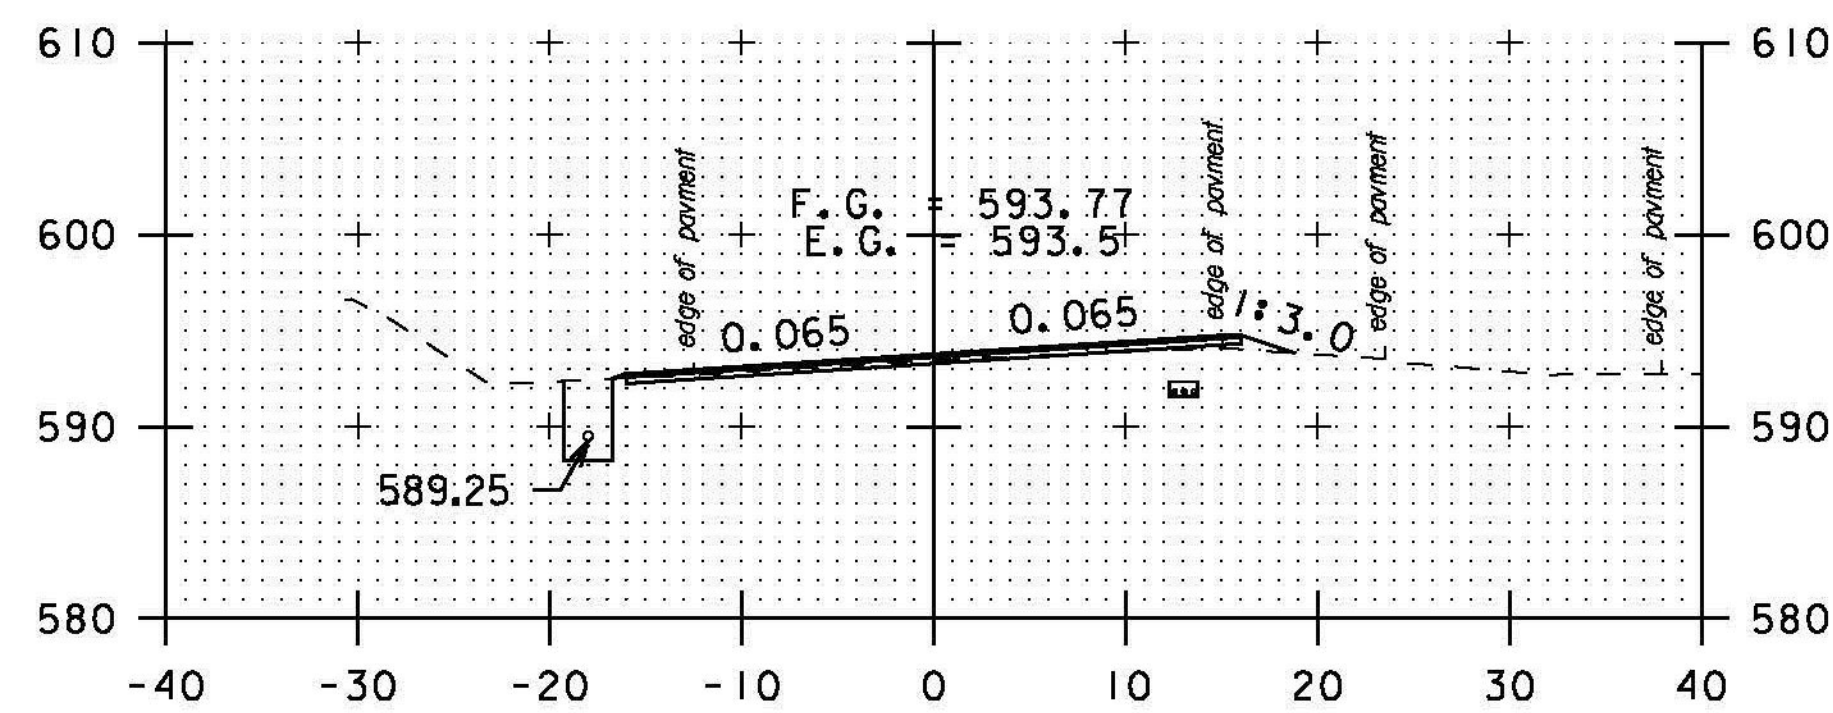


TH#92 RT  
187+00

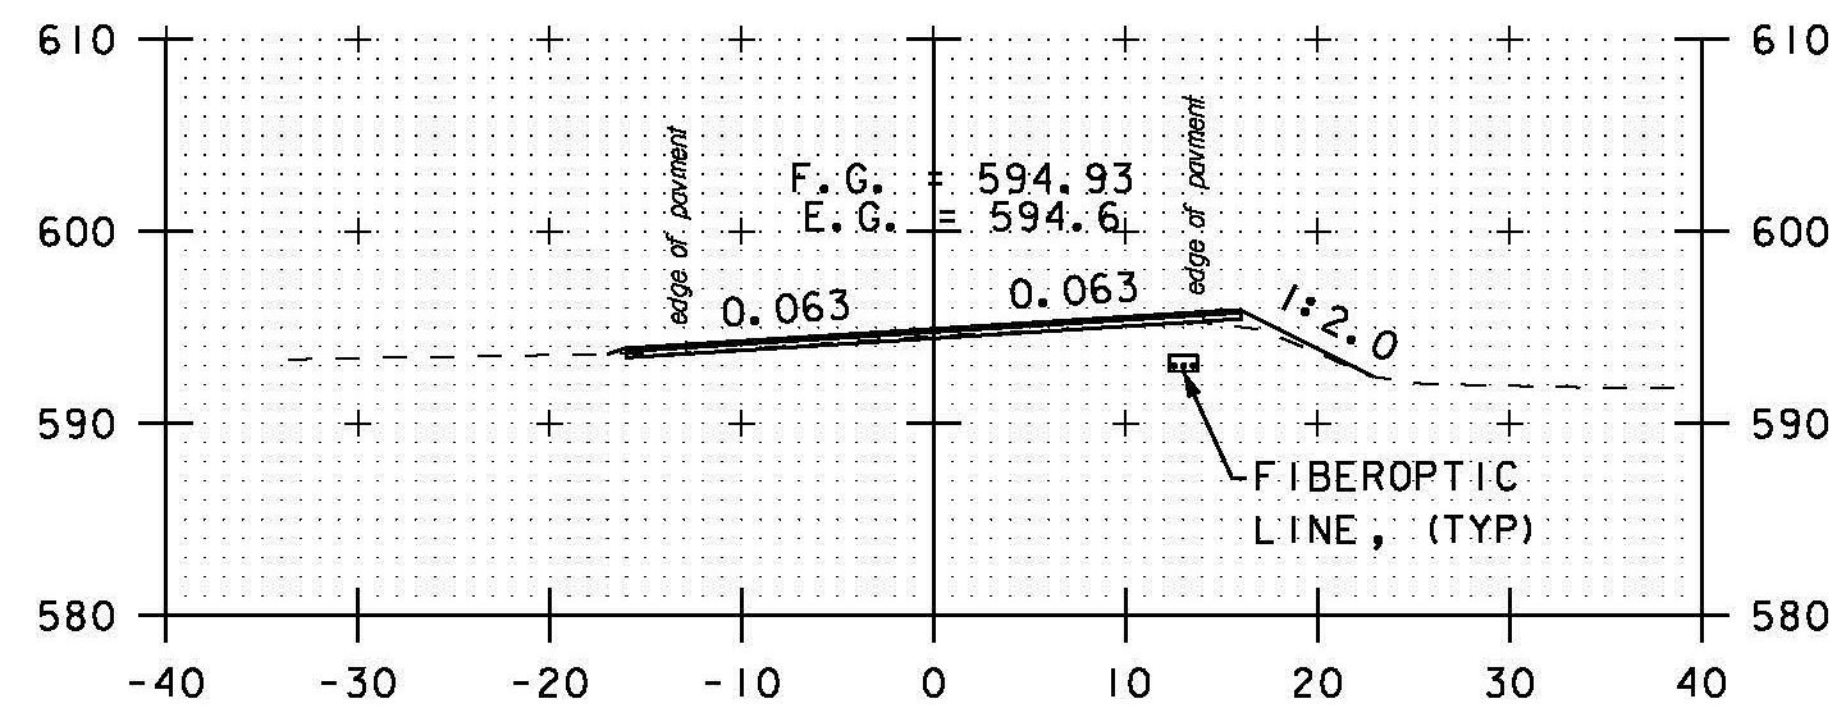


186+50

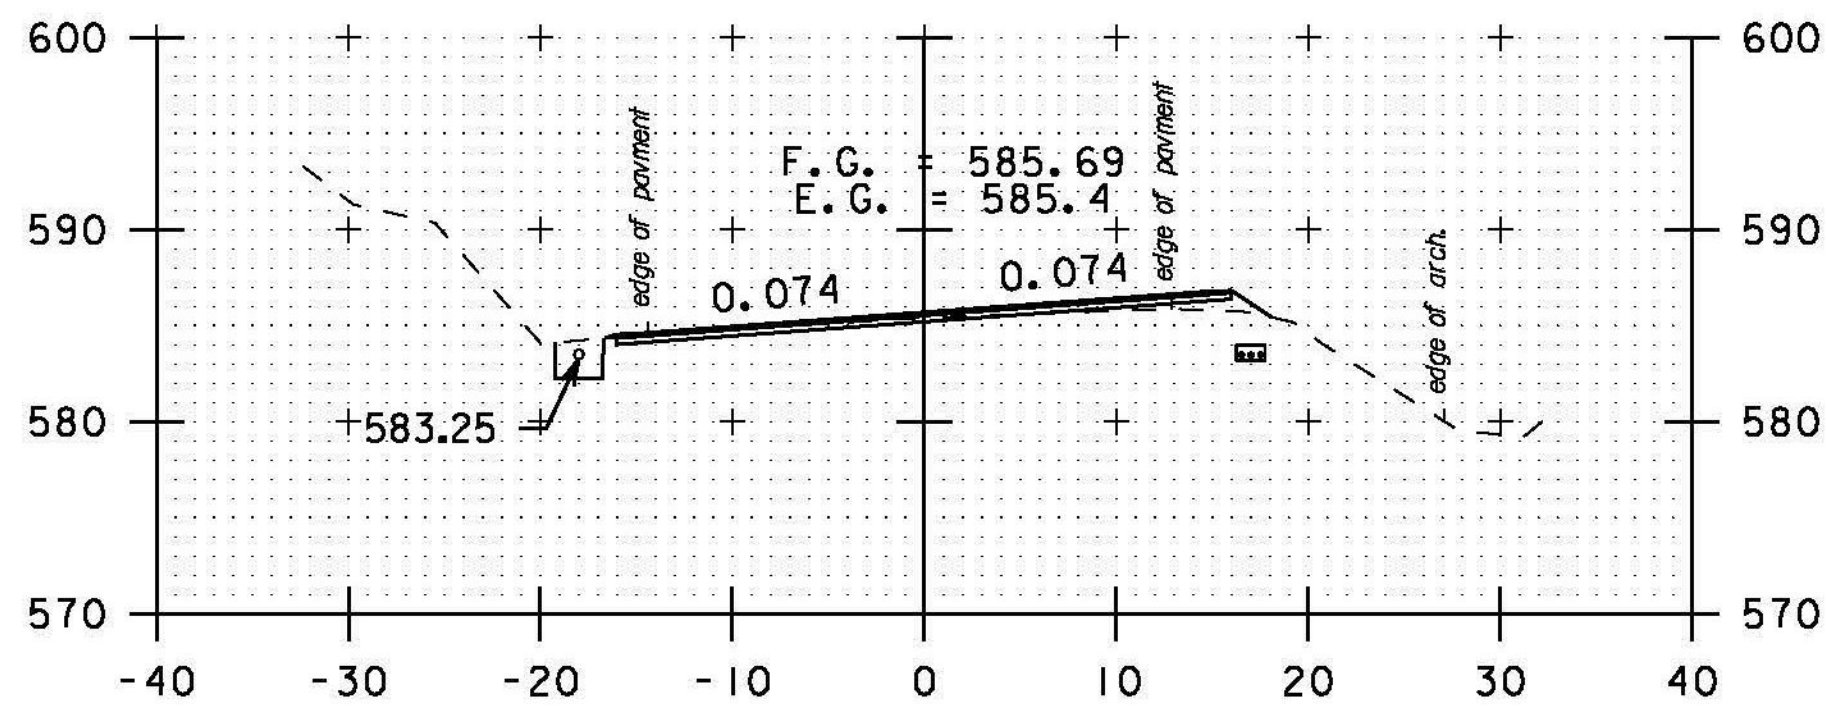


189+00

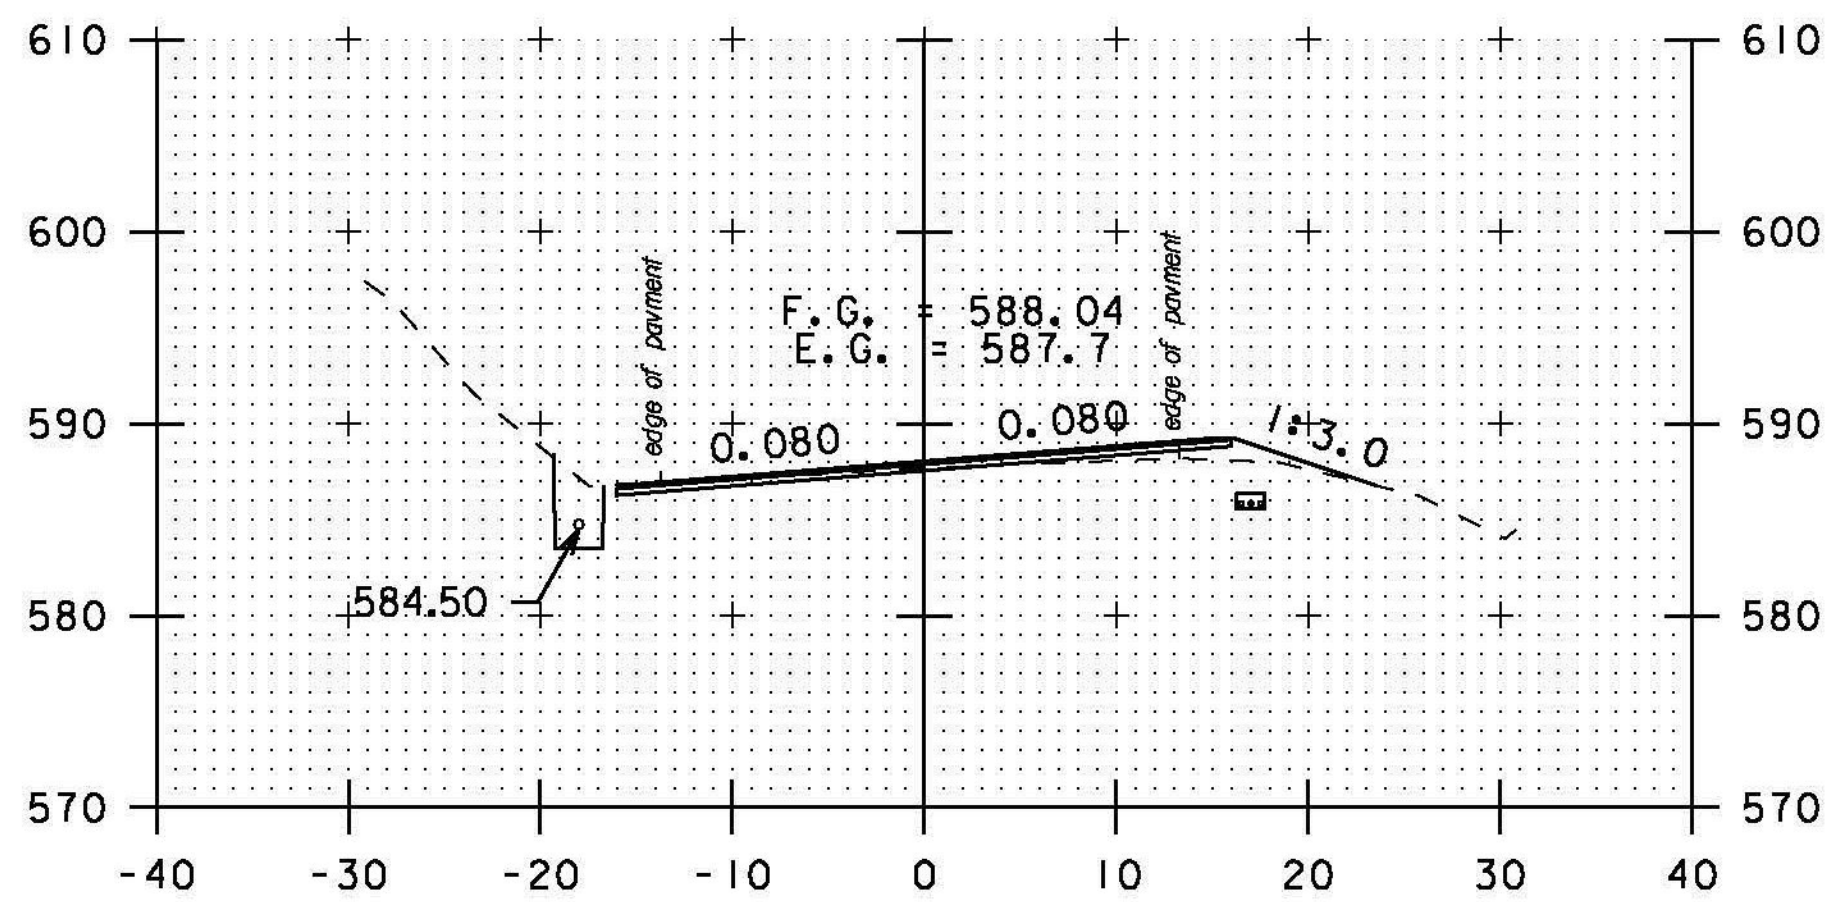


188+50

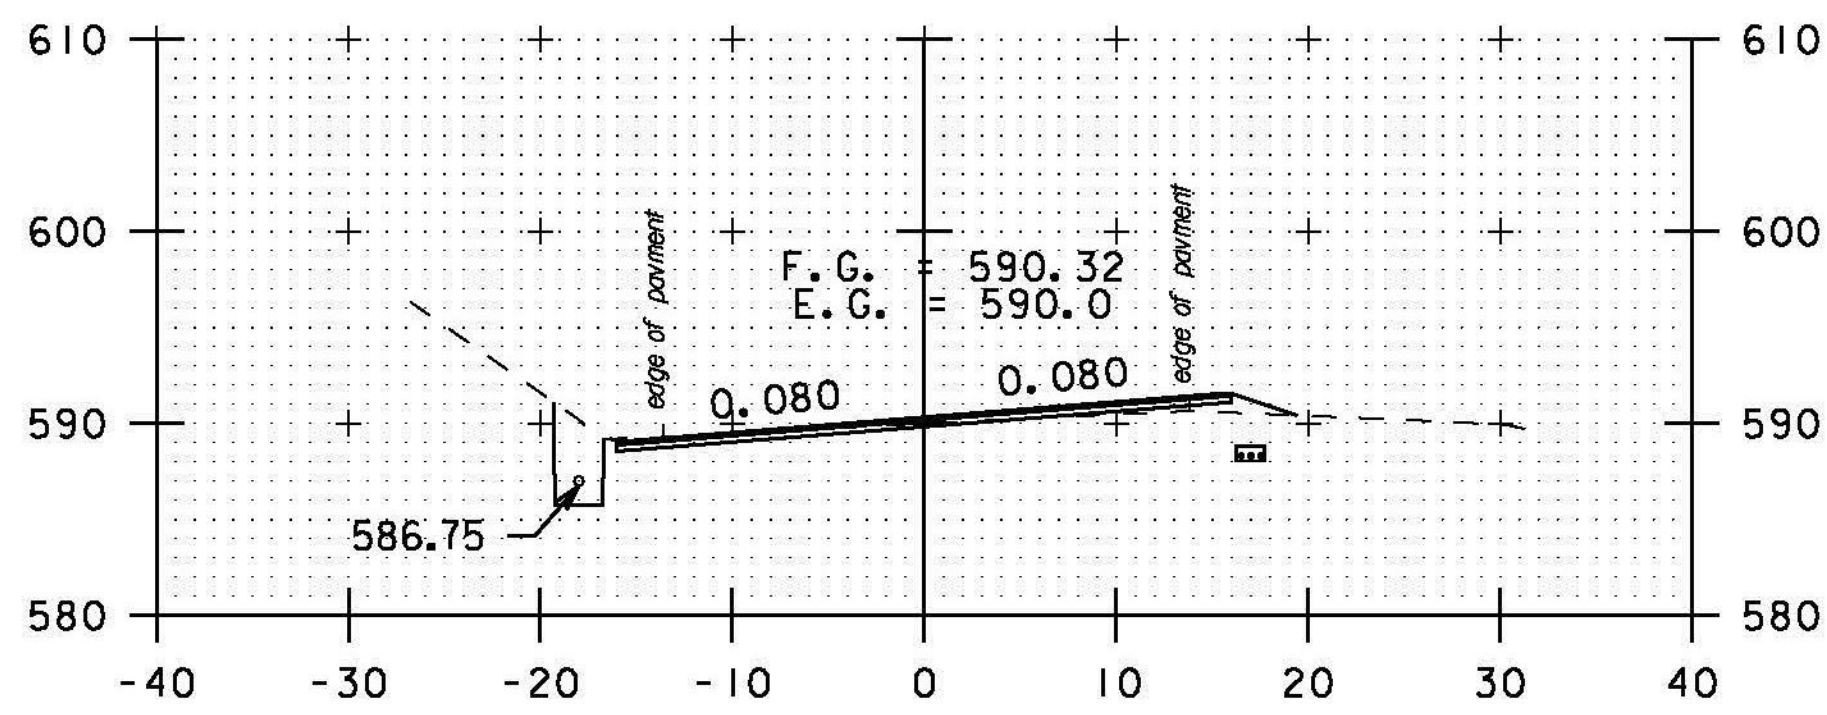


188+00

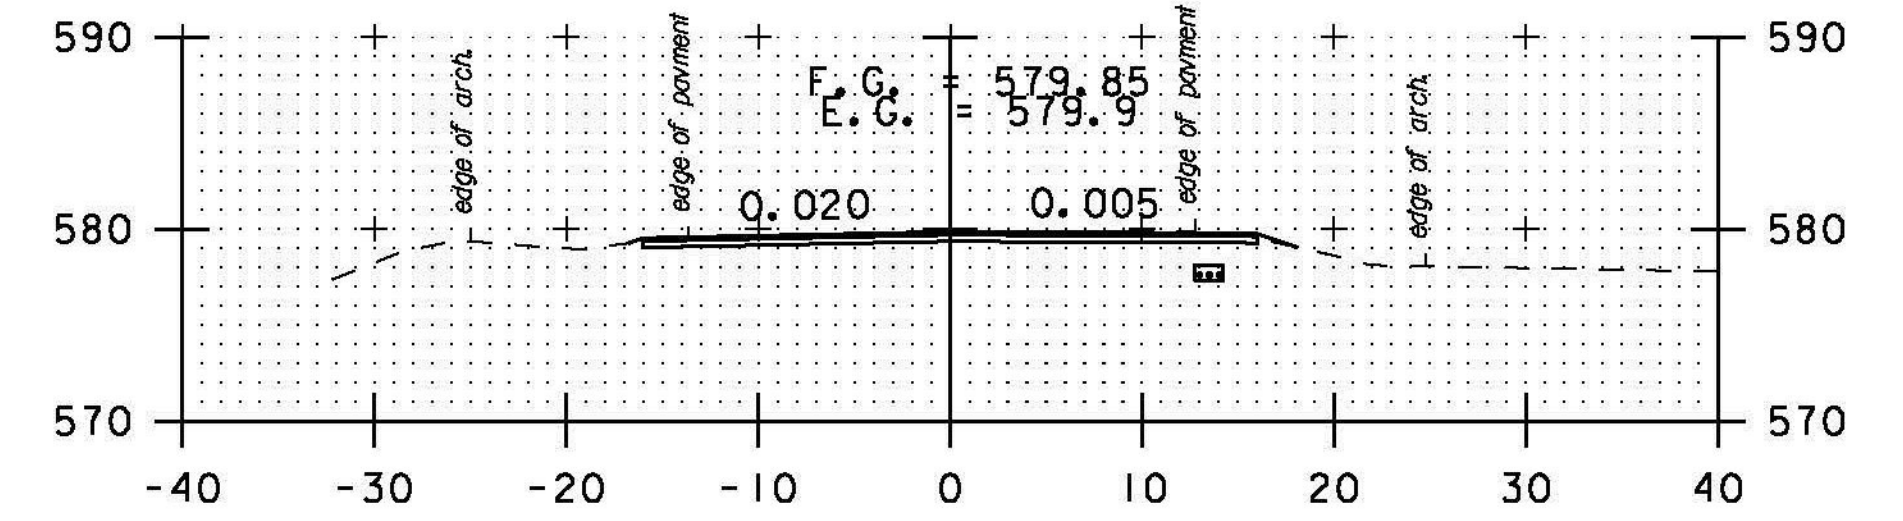


191+00

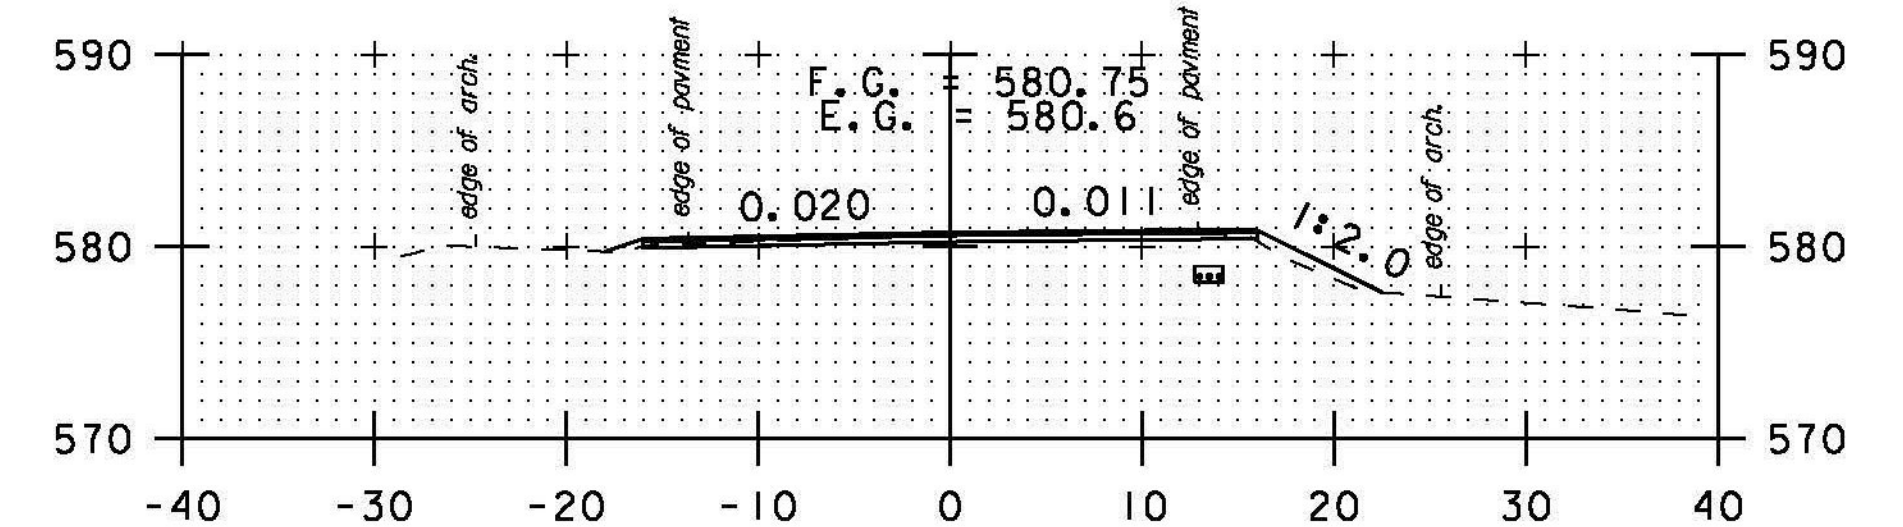

190+50

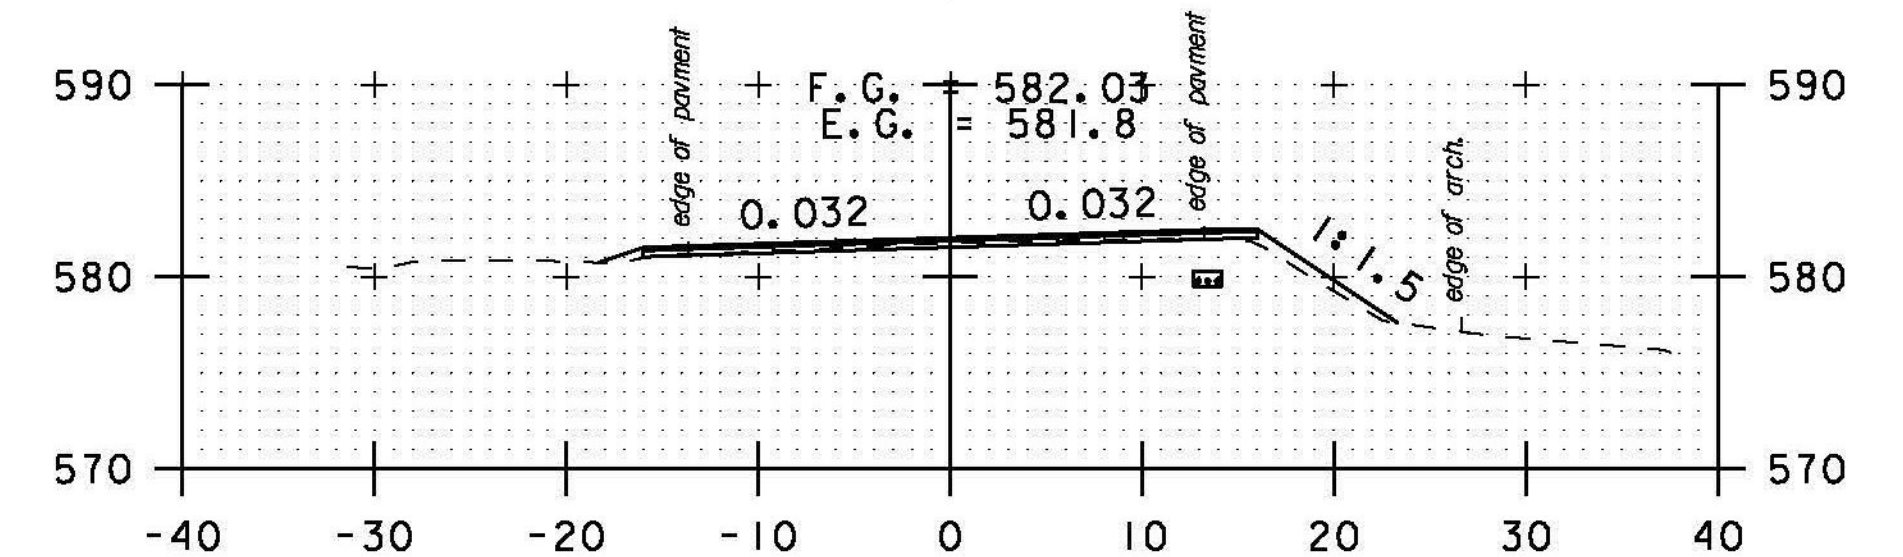


190+00

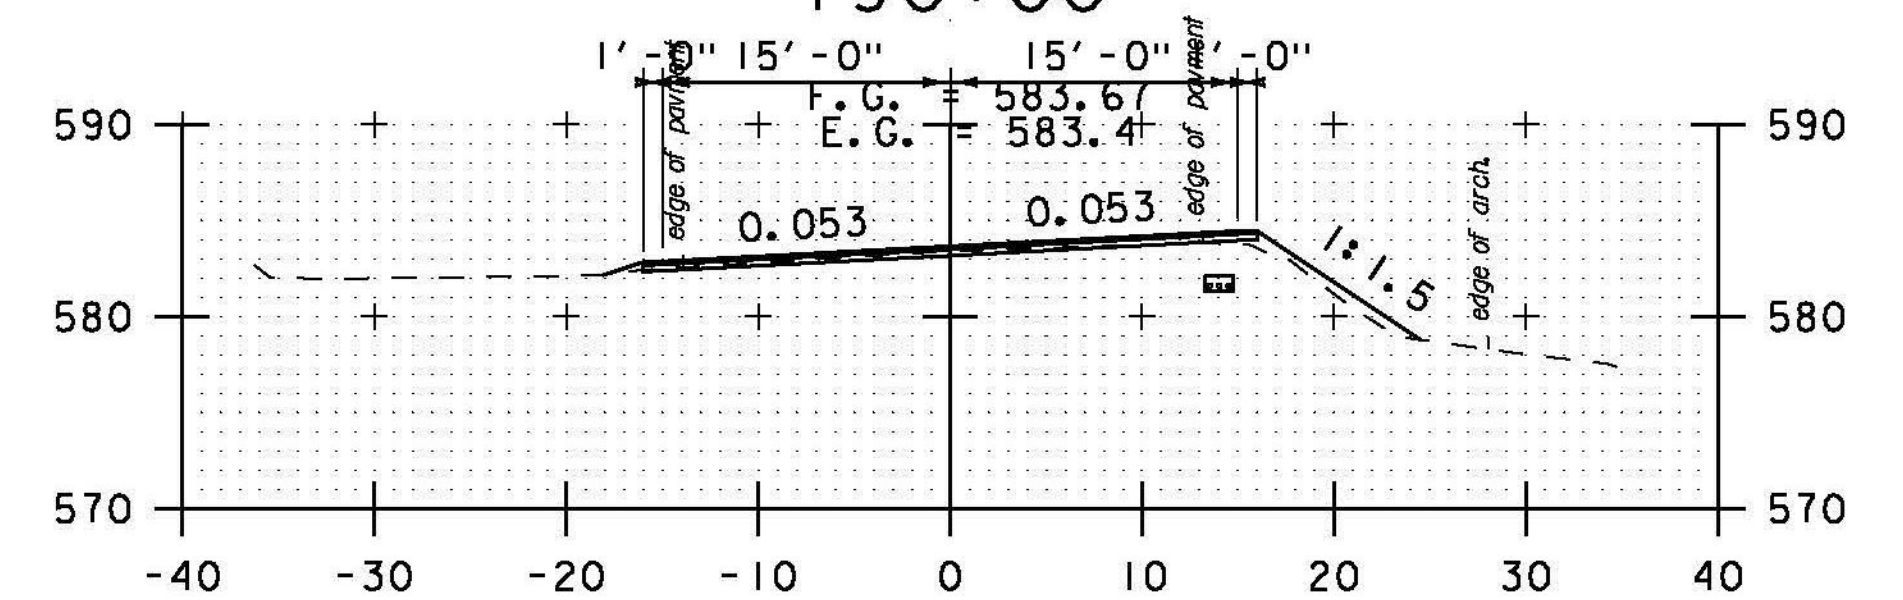

189+50

PROJECT NAME: BETHEL-RANDOLPH  
 PROJECT NUMBER: STP 292(K)  
 FILE NAME: piOC244.dgn  
 PROJECT LEADER: C. LATHROP  
 DESIGNED BY: S. LAMPHERE  
 CROSS SECTION SHEET 14  
 PLOT DATE: 4/23/2015  
 DRAWN BY: S. LAMPHERE  
 CHECKED BY: C. LATHROP  
 SHEET 148 OF 211

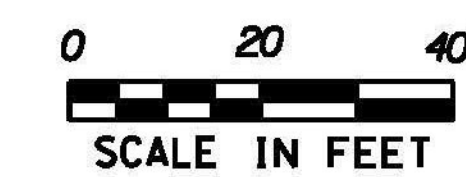

STA. 186+50 TO STA. 191+00