


PROJECT NAME: BETHEL-RANDOLPH
 PROJECT NUMBER: STP 292(K)
 FILE NAME: piOC244.dgn
 PROJECT LEADER: C. LATHROP
 DESIGNED BY: S. LAMPHERE
 CROSS SECTION SHEET 15
 PLOT DATE: 4/23/2015
 DRAWN BY: S. LAMPHERE
 CHECKED BY: C. LATHROP
 SHEET 149 OF 211

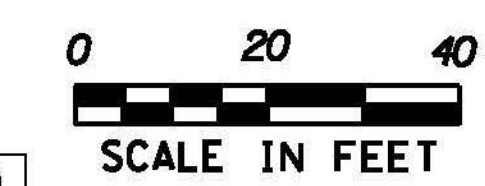

STA. 191+50 TO STA. 197+00