




199+00

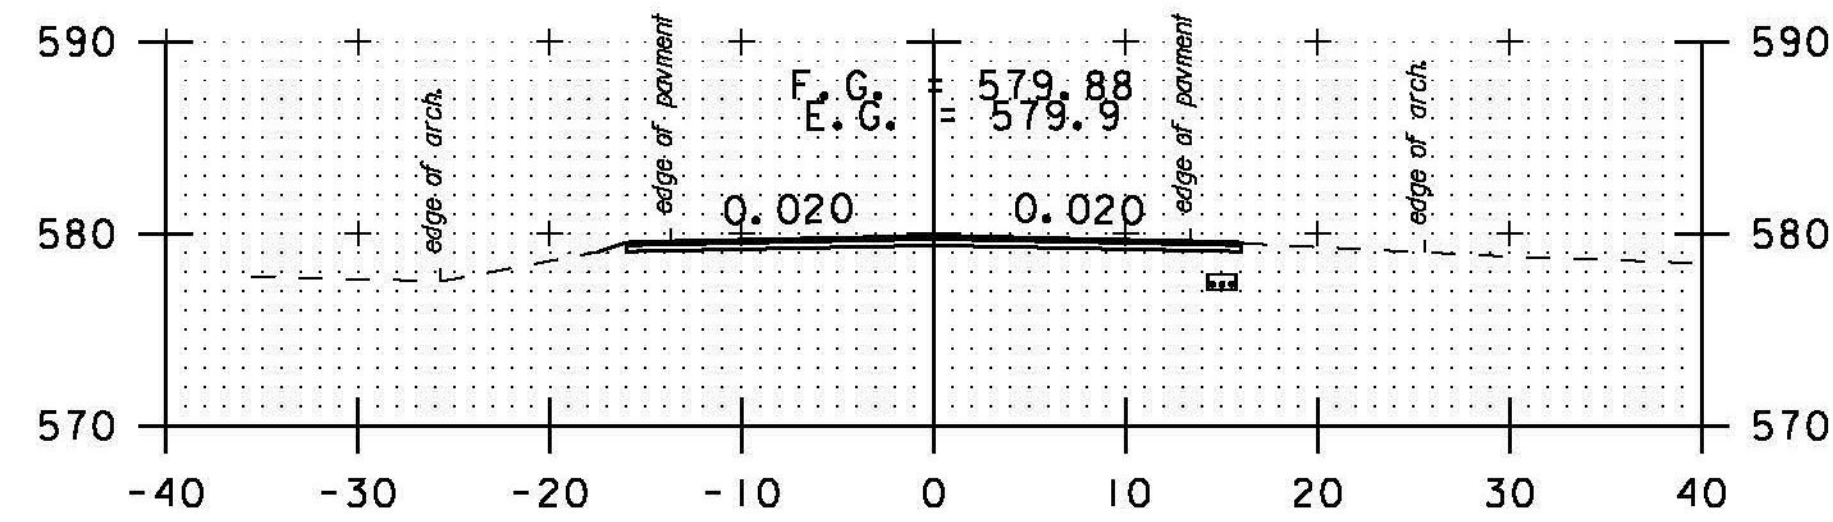


PULL OFF RT
198+50

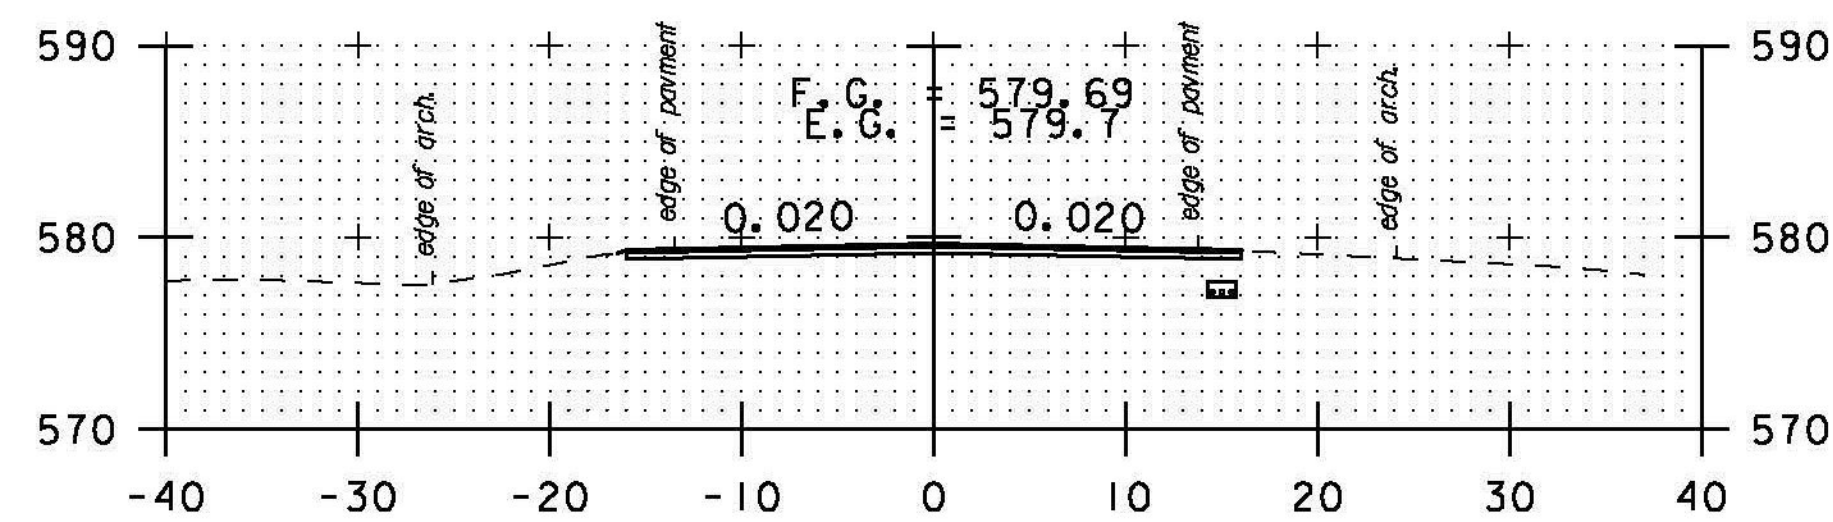


PULL OFF RT
198+00

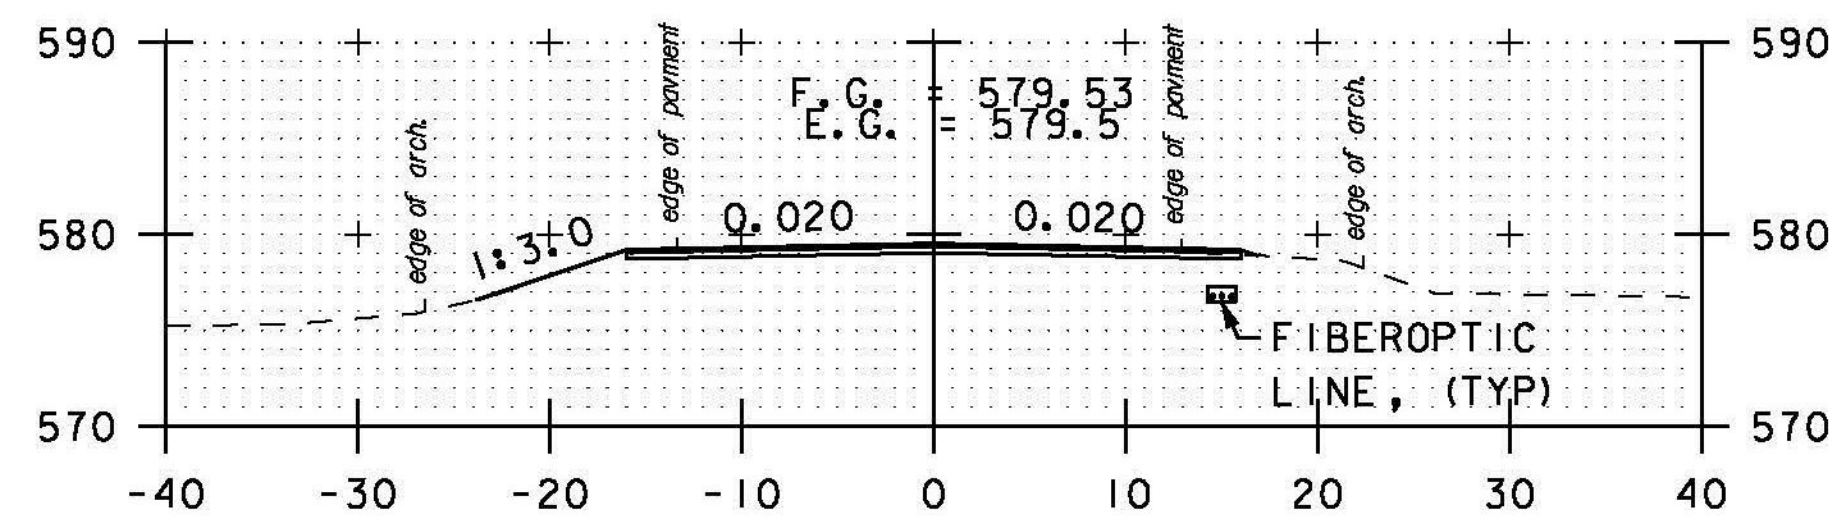


197+50

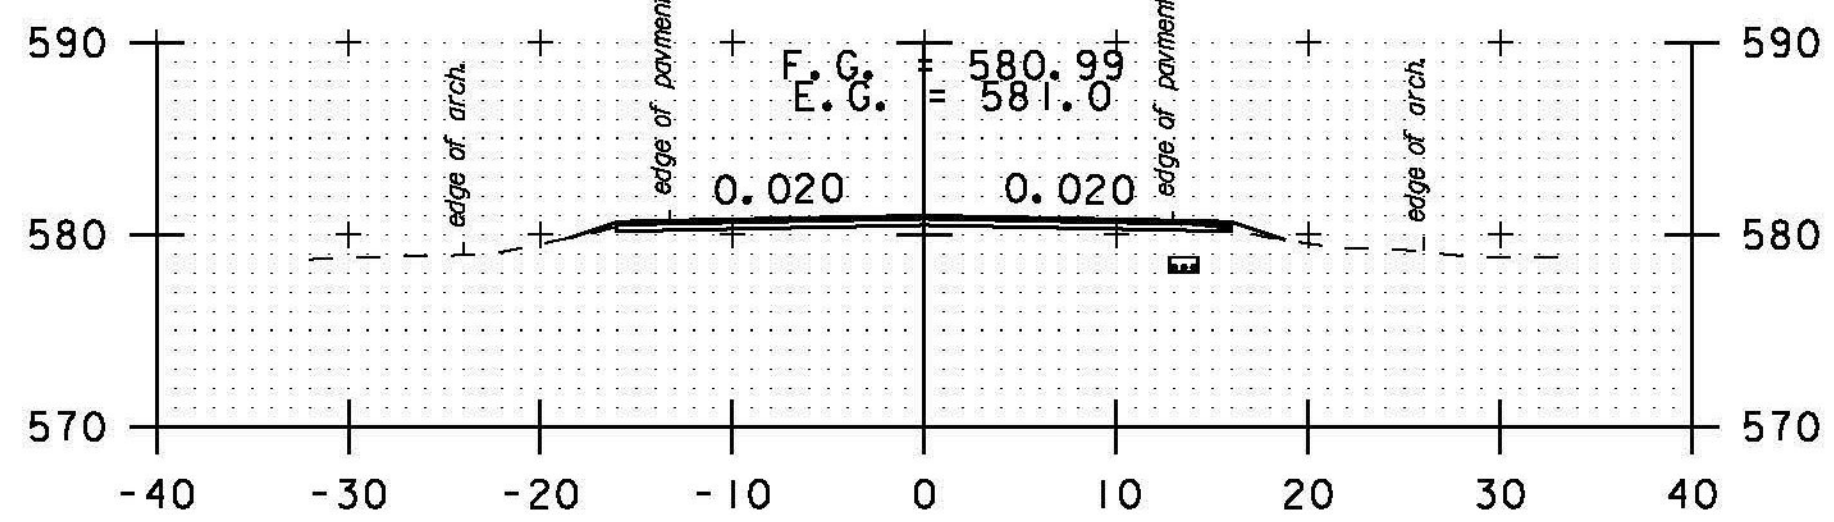


201+00

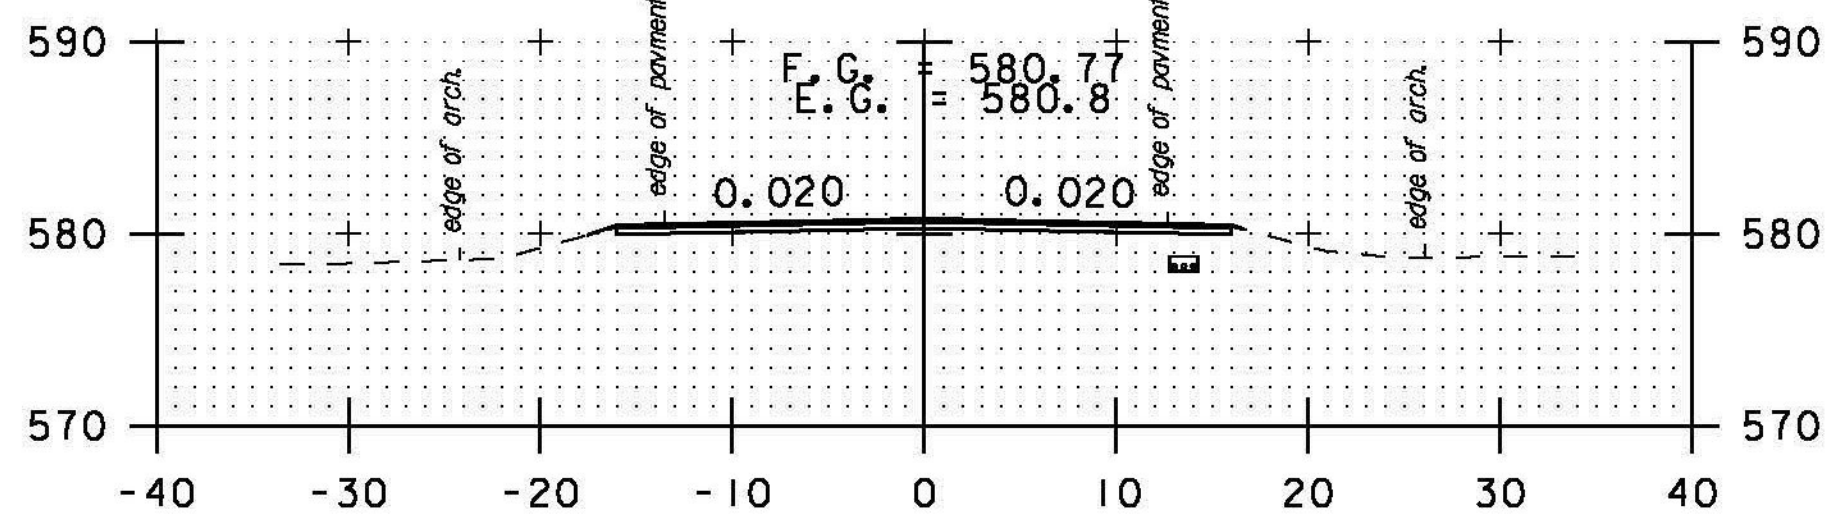


200+50

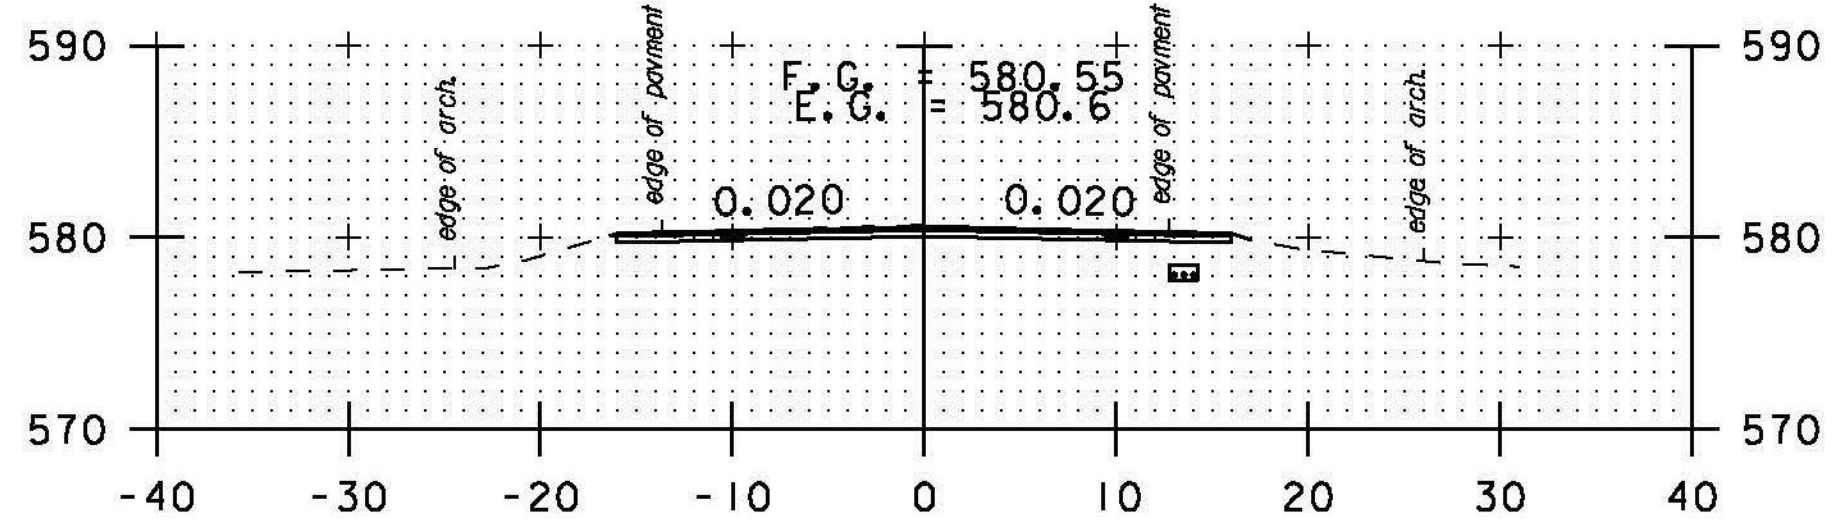


200+00

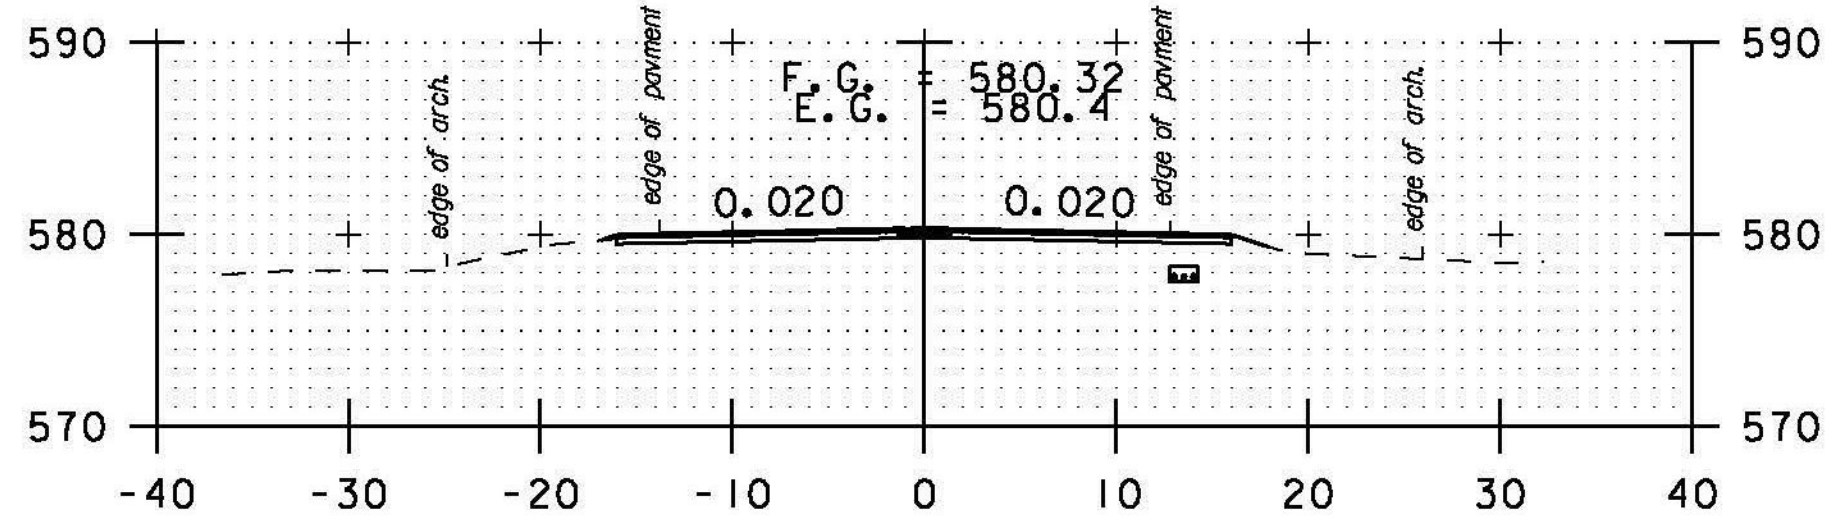


199+50

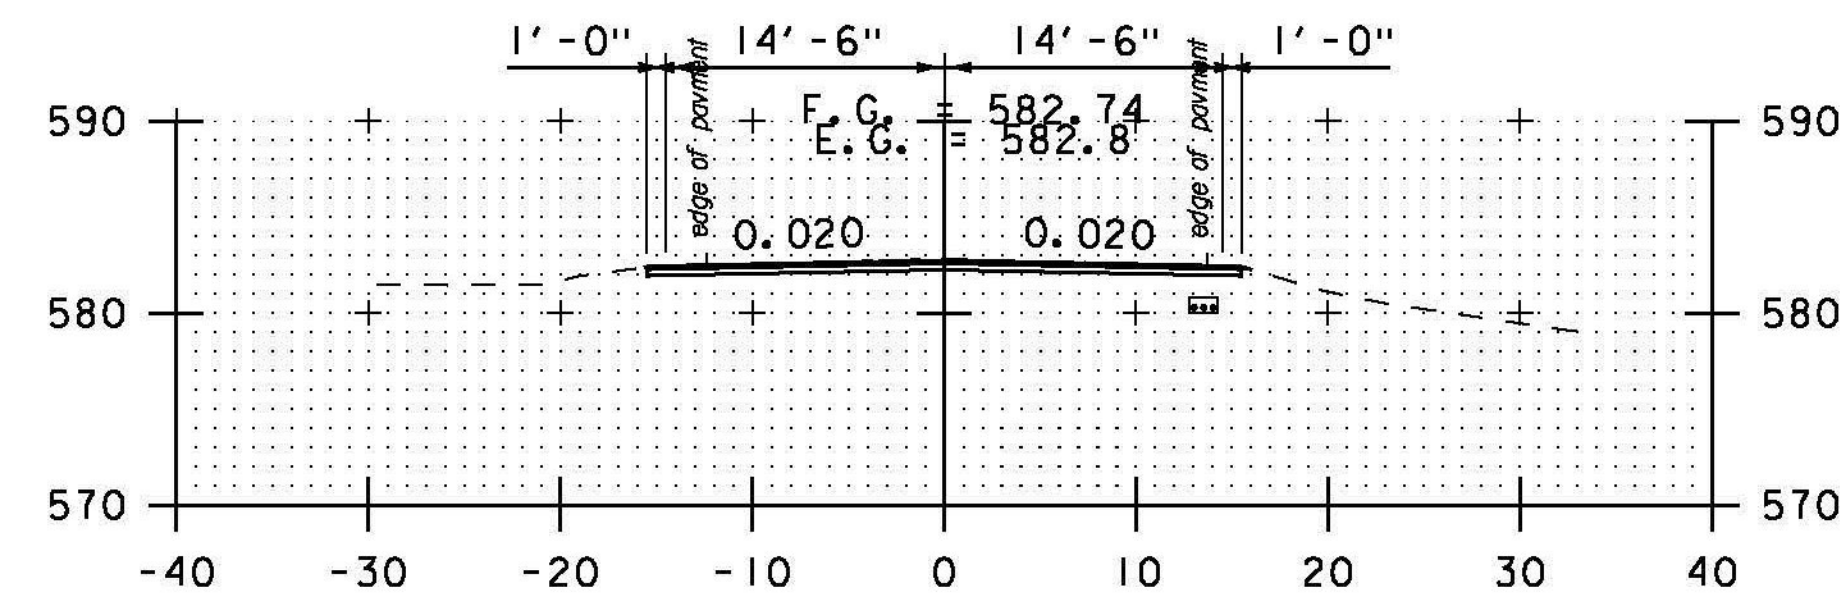


203+00

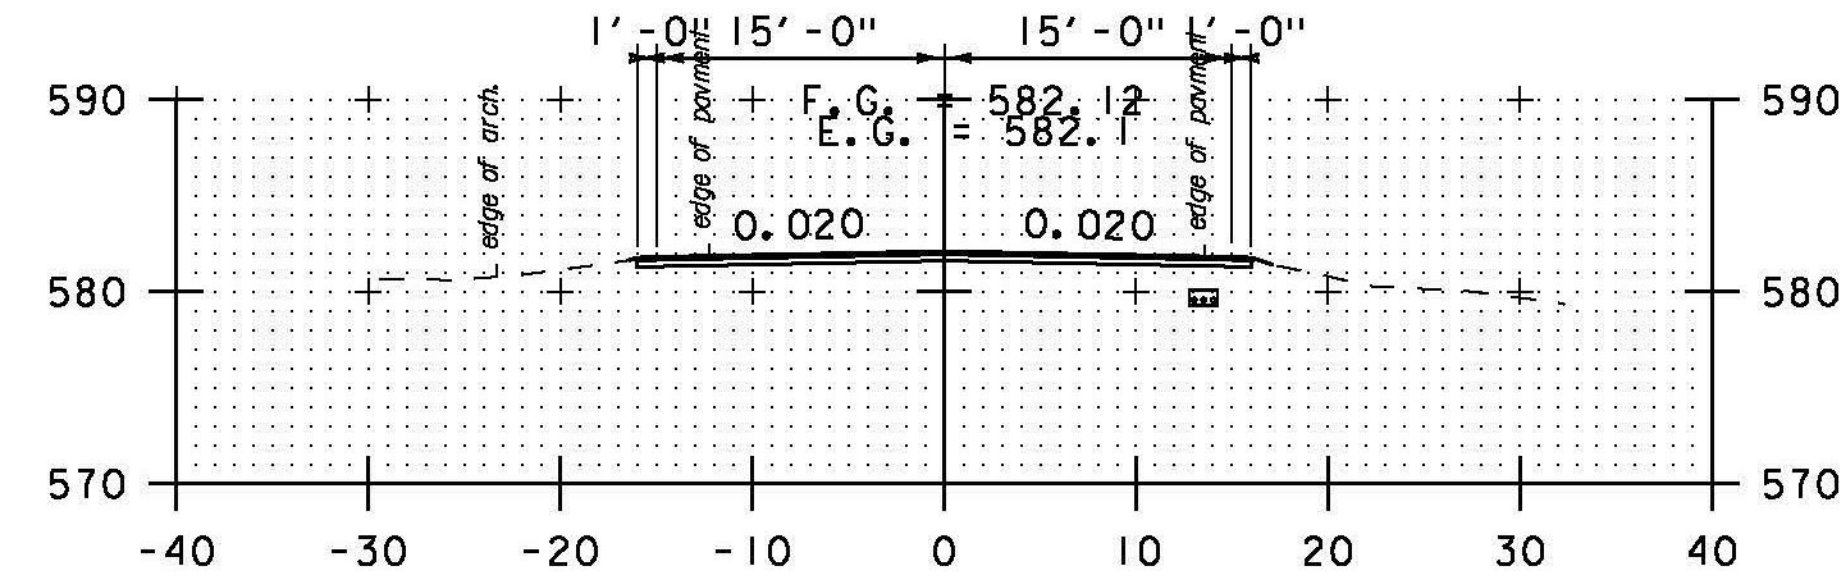

202+50

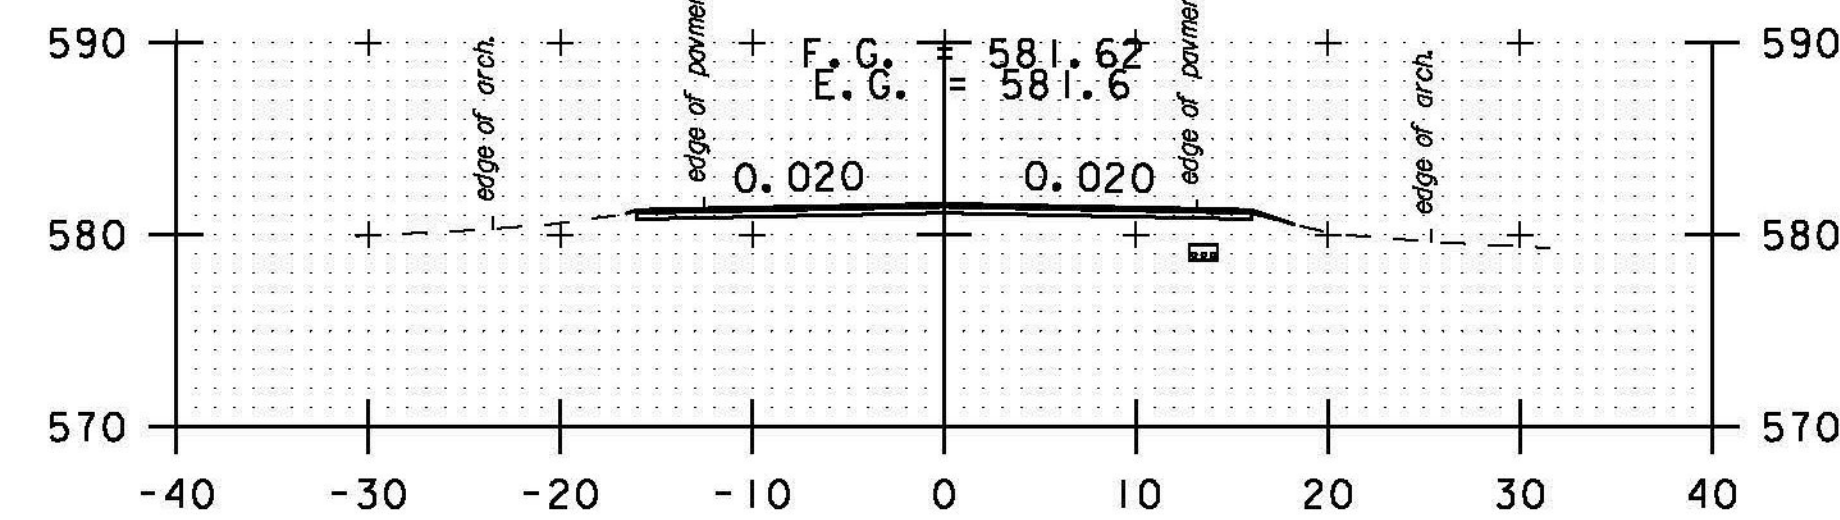

202+00

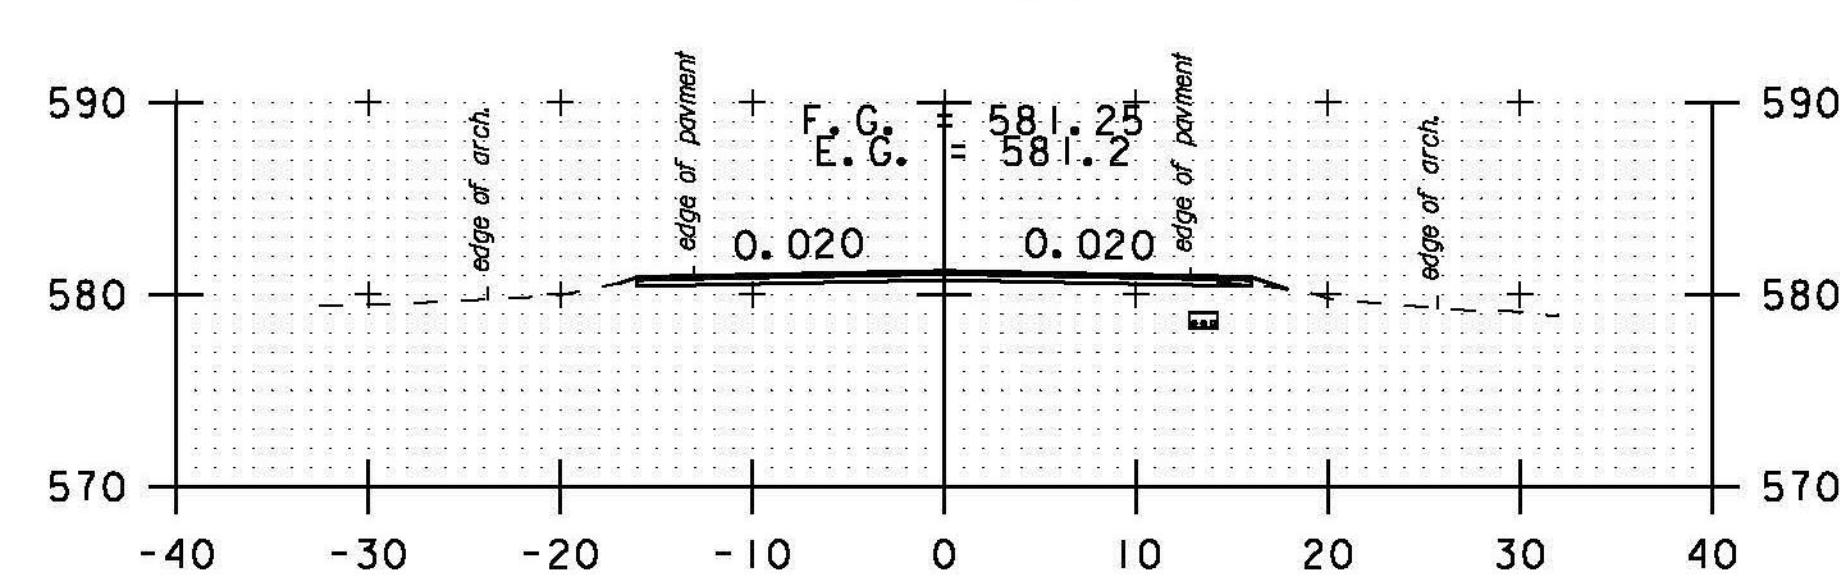


201+50

PROJECT NAME: BETHEL-RANDOLPH
PROJECT NUMBER: STP 292(I)

FILE NAME: piOC244.dgn
PROJECT LEADER: C. LATHROP
DESIGNED BY: S. LAMPHERE
CROSS SECTION SHEET 16

PLOT DATE: 4/23/2015
DRAWN BY: S. LAMPHERE
CHECKED BY: C. LATHROP
SHEET 150 OF 211

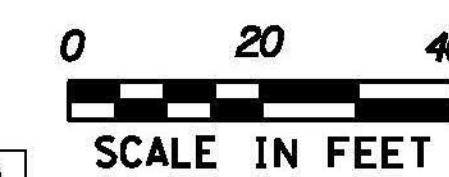

STA. 197+50 TO STA. 203+00

SCALE IN FEET