




DRIVE LT
209+50

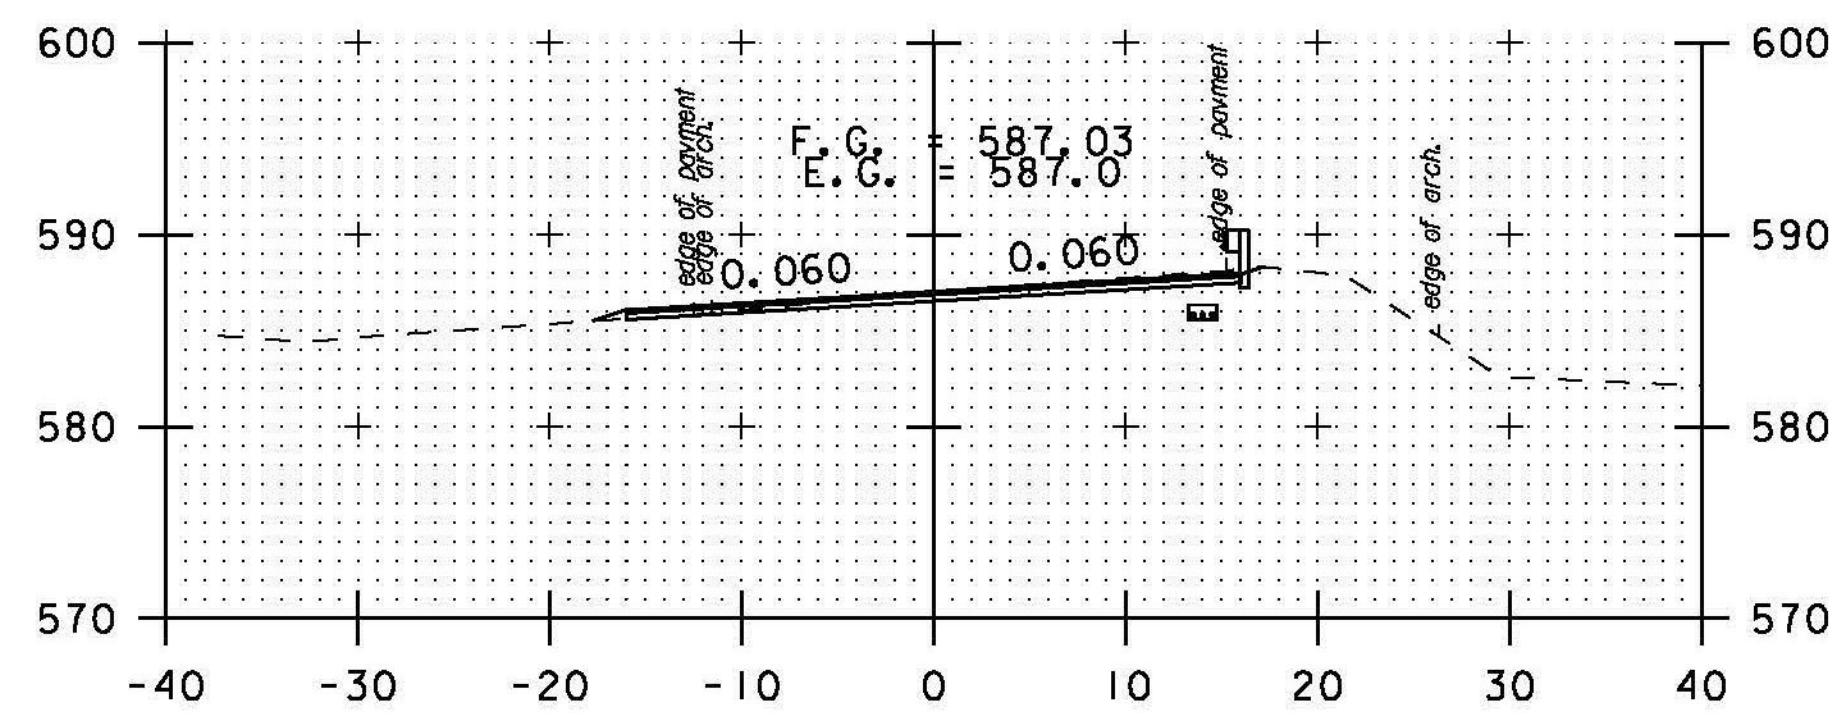


209+00

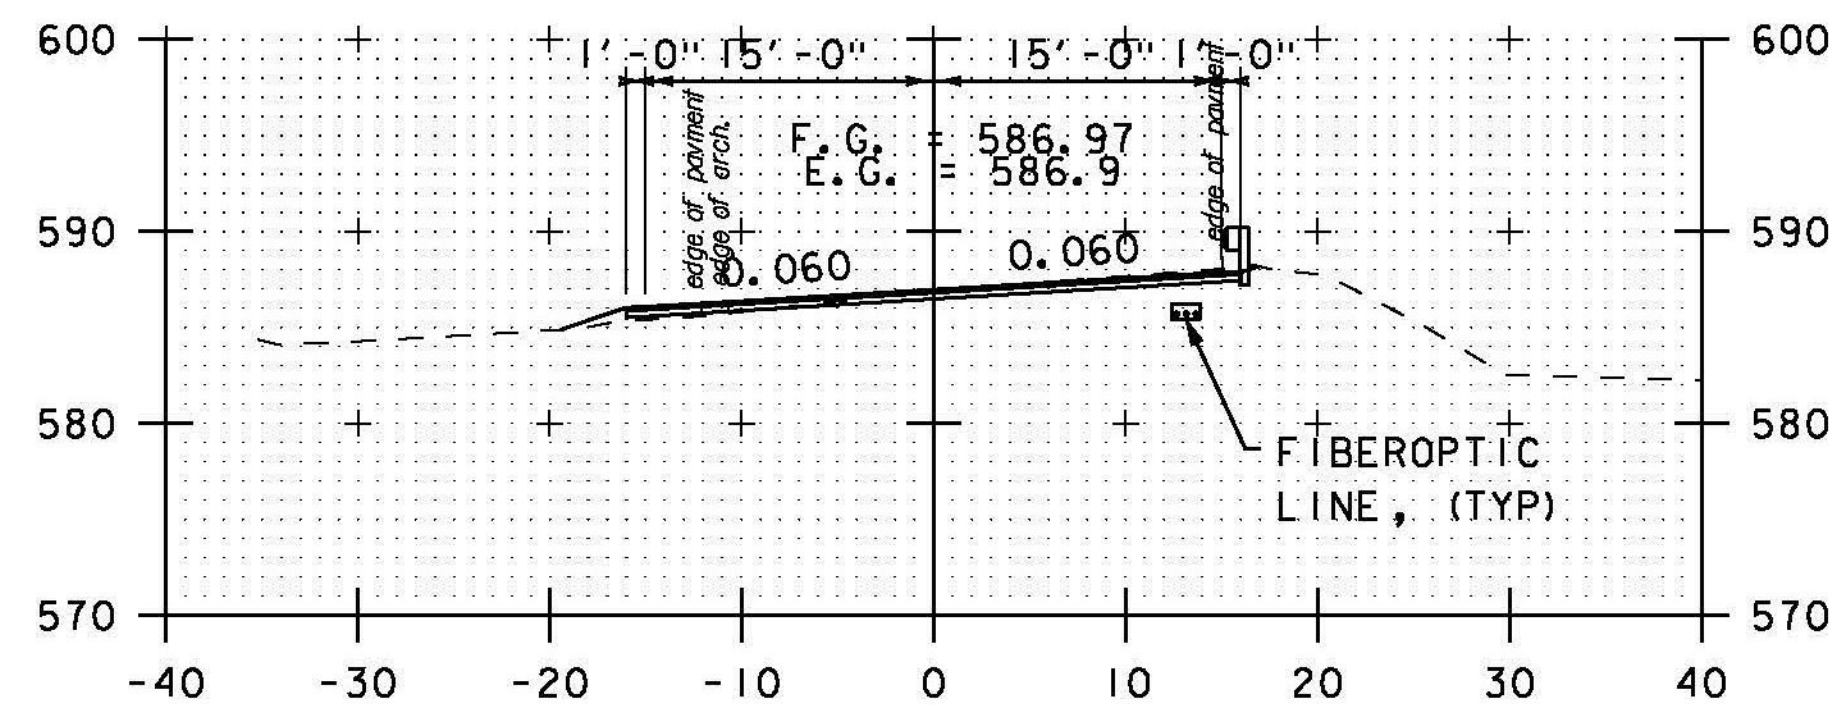


208+50

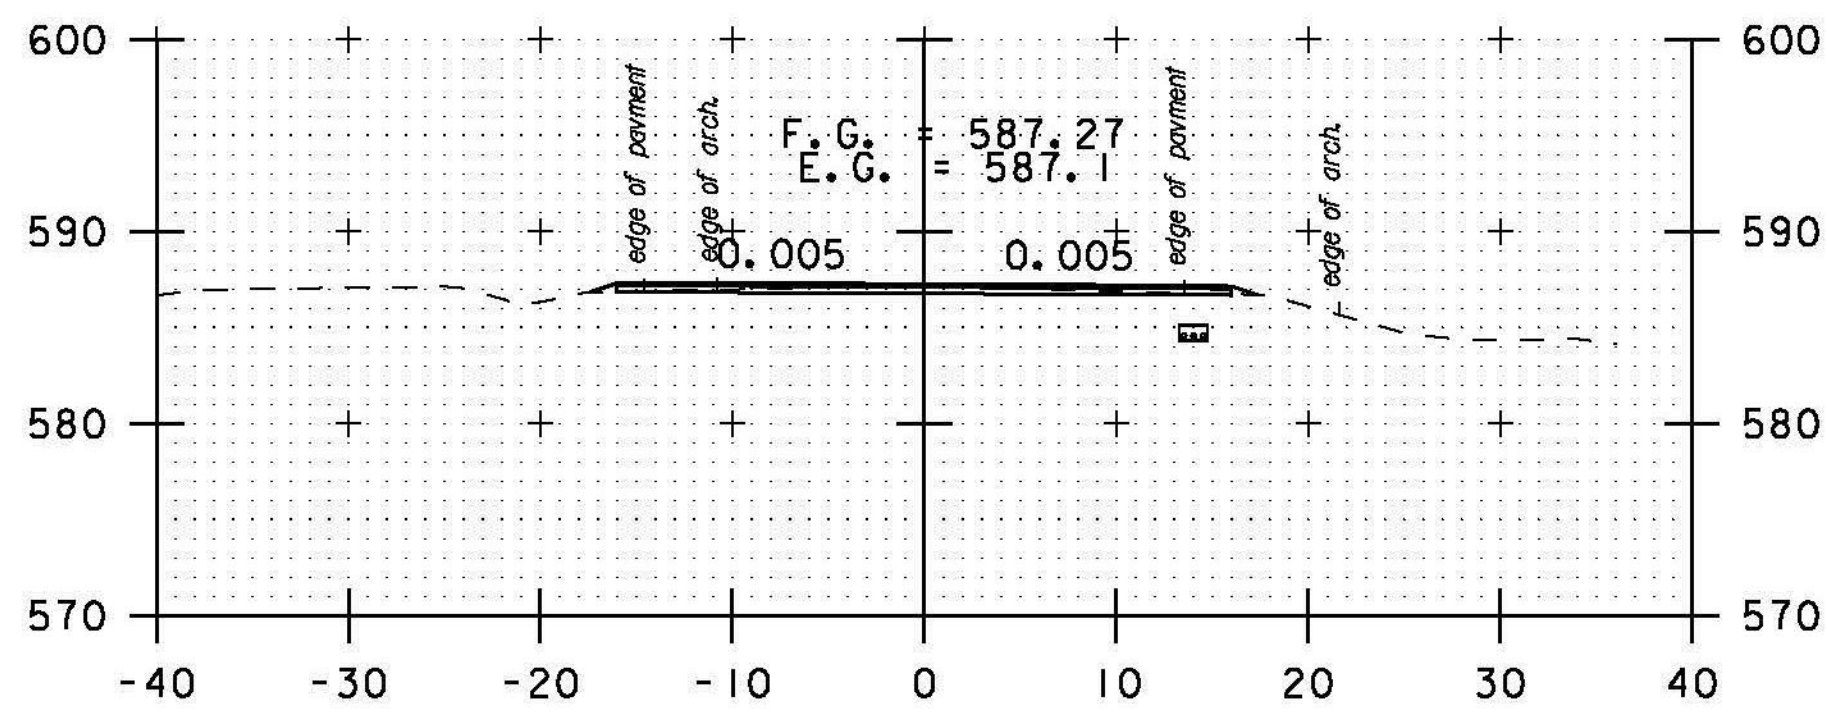

211+50

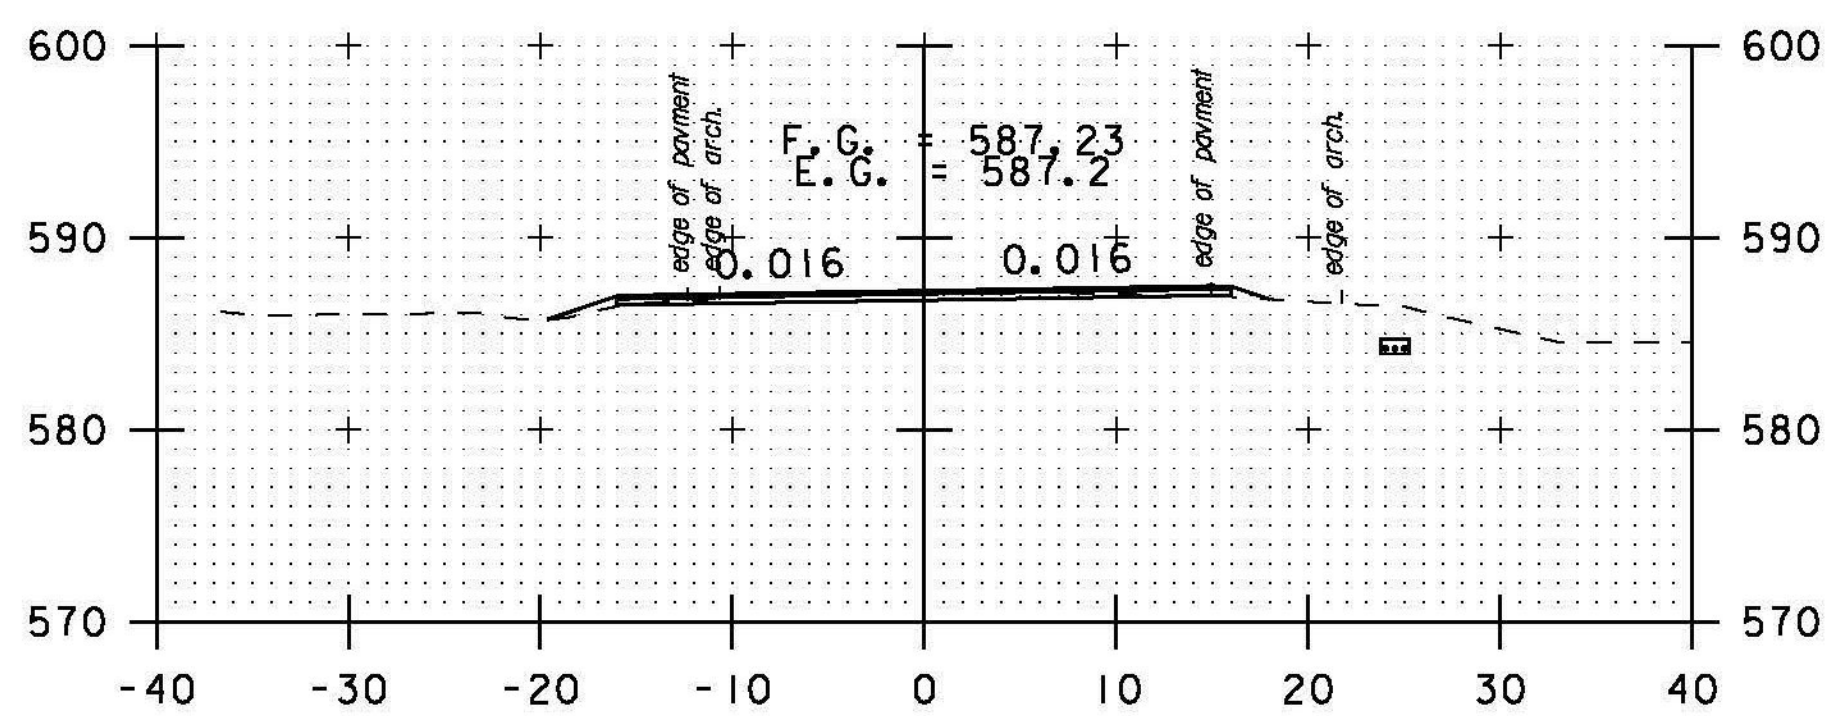


211+00

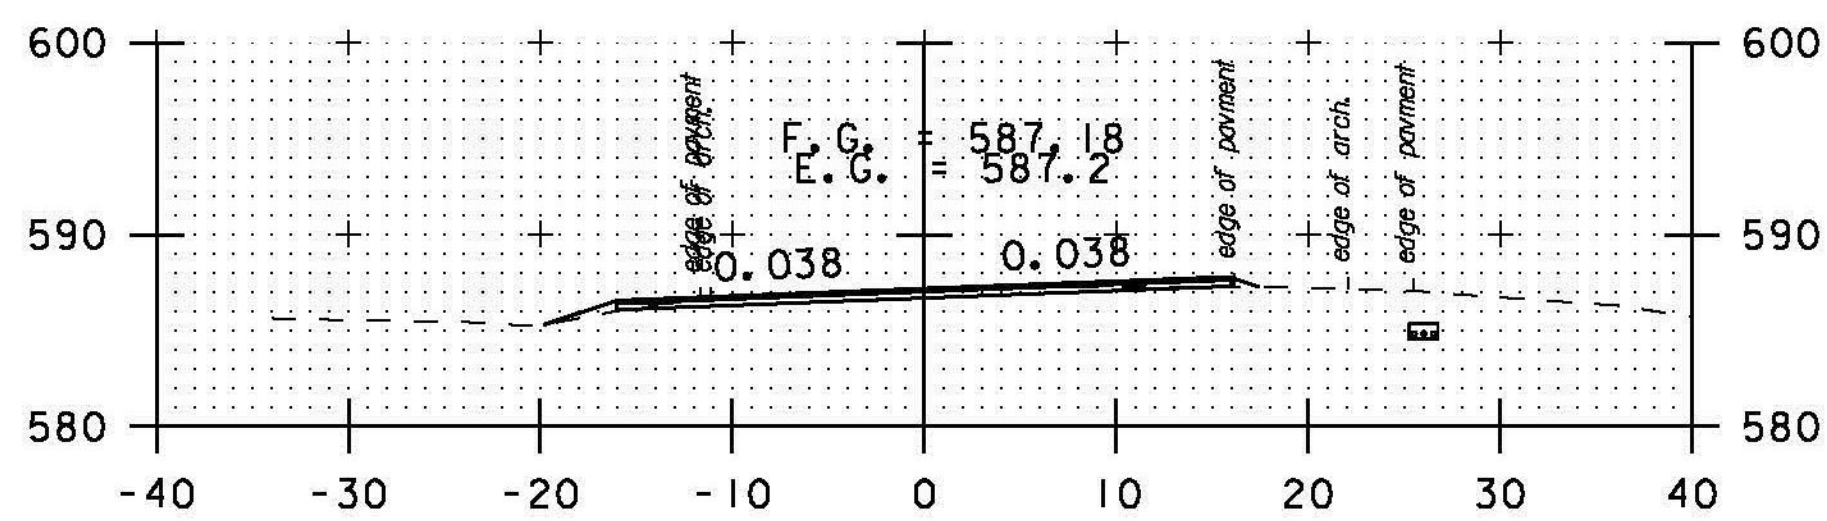


TH#24 RT

210+50

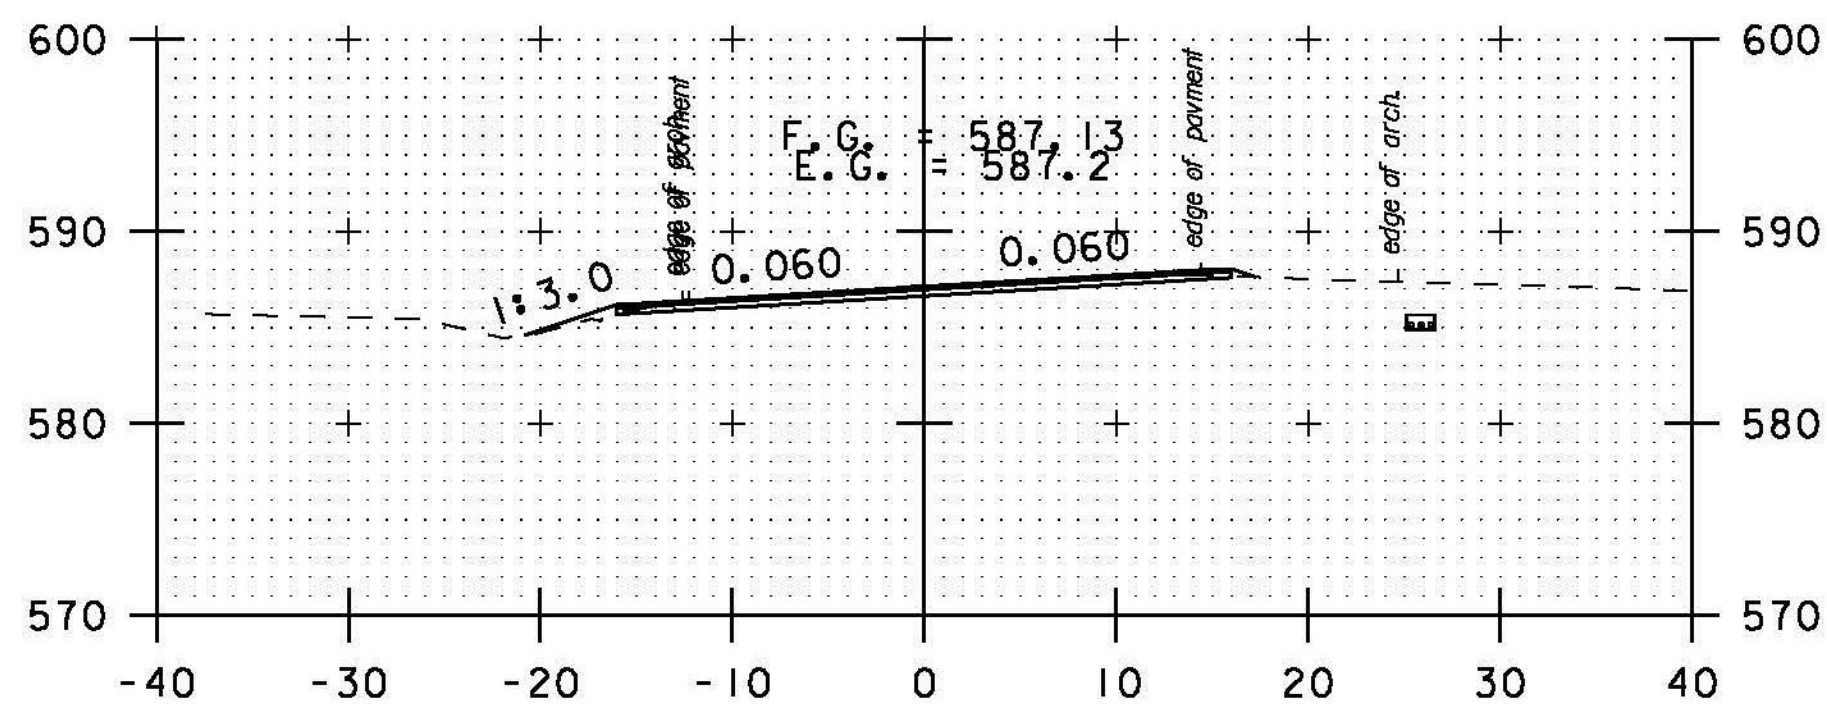


TH#24 RT


210+00

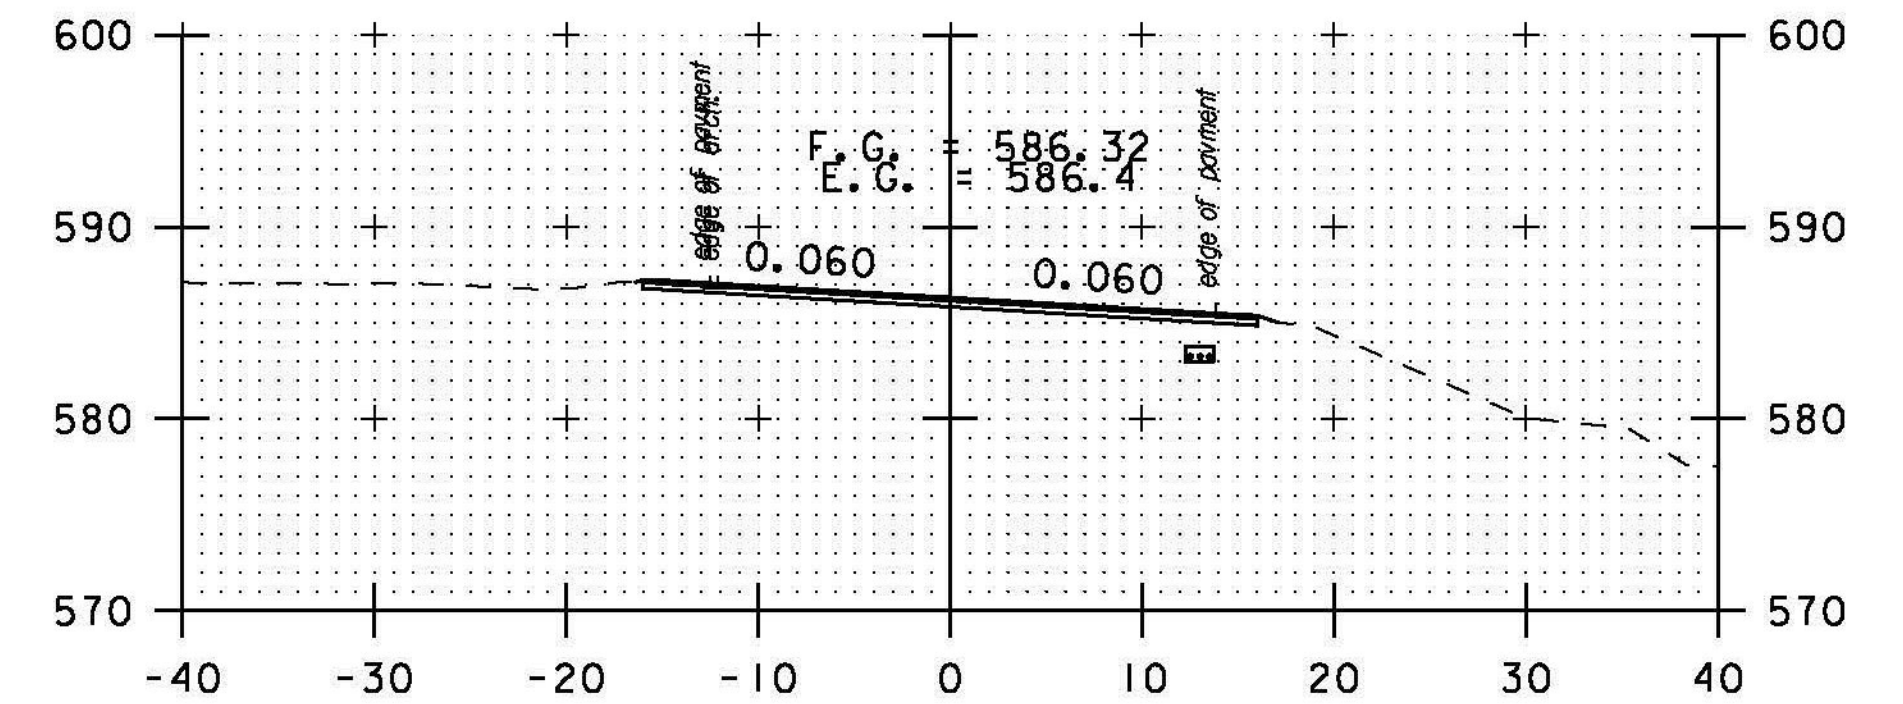

213+00

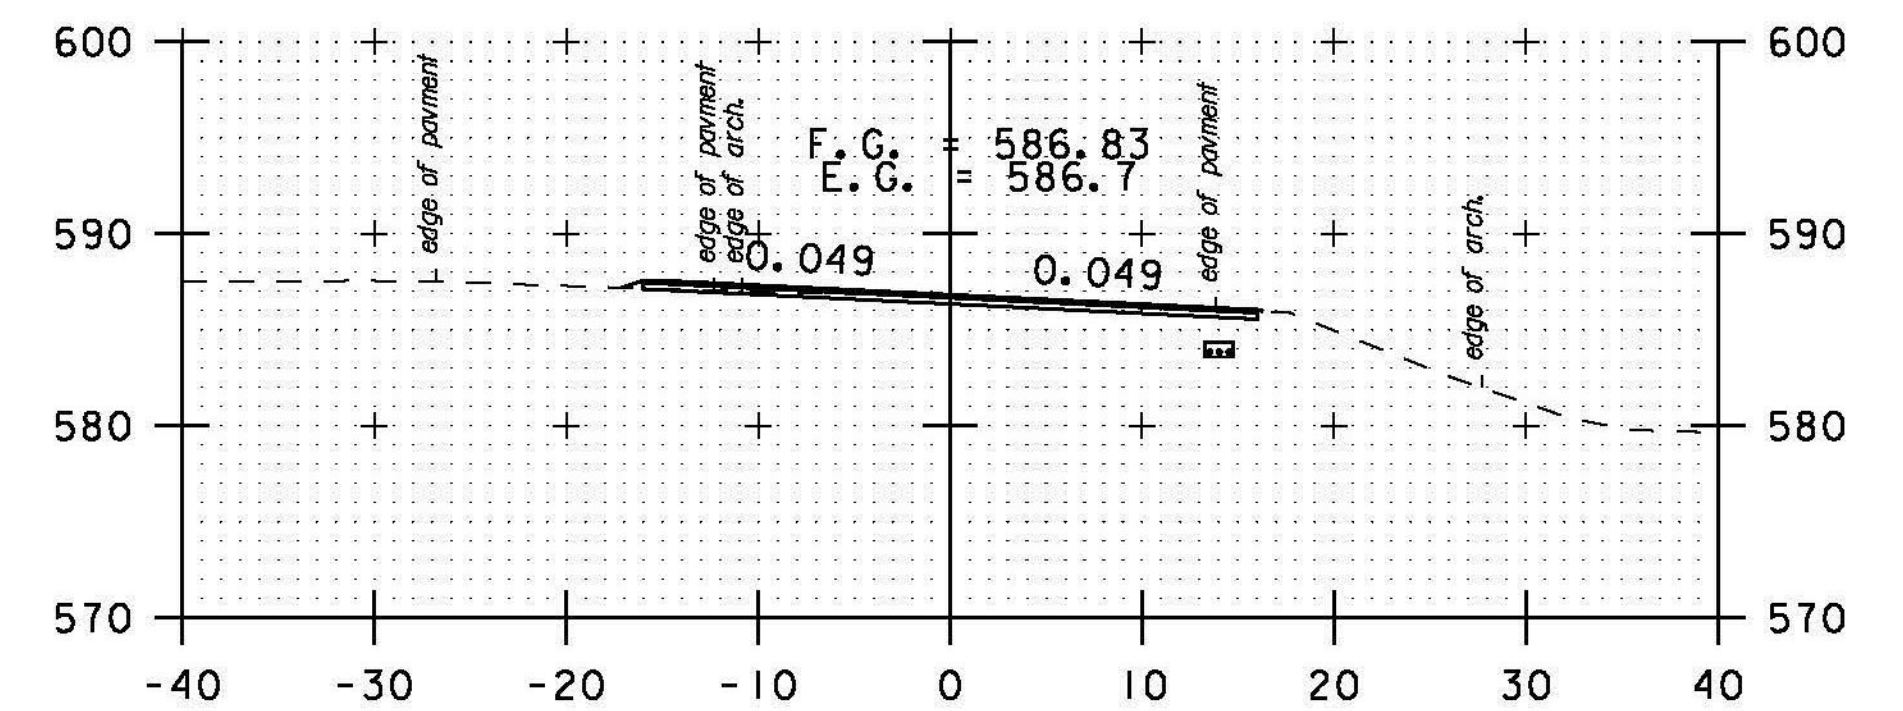


212+50

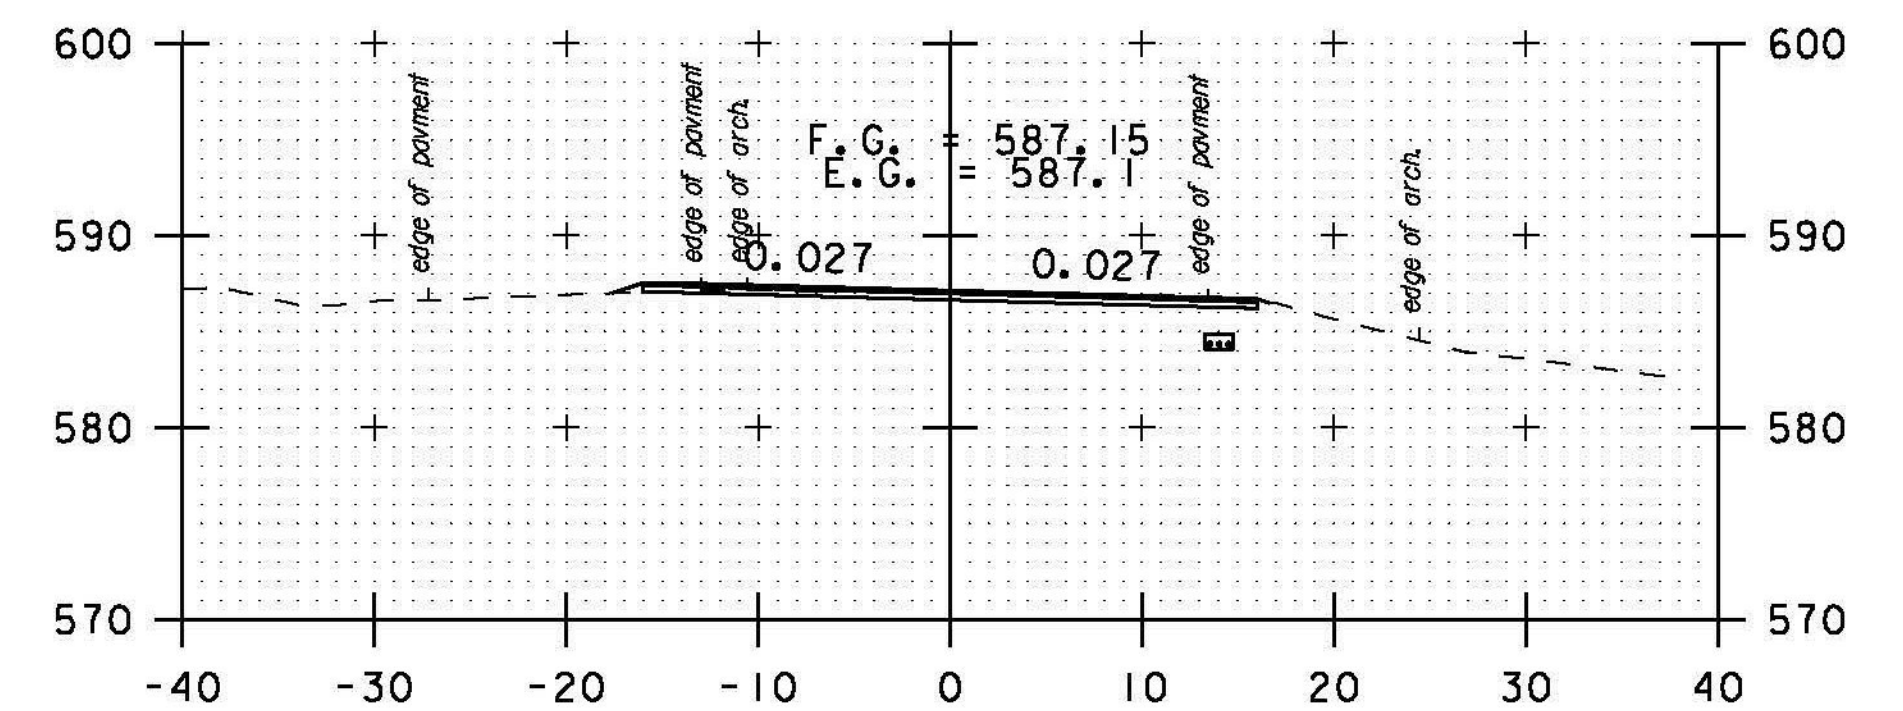

TH#2 LT

212+00

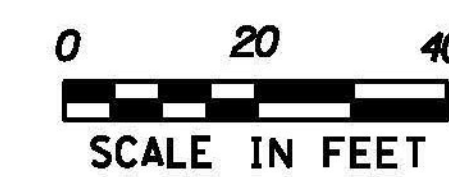

SCALE IN FEET

STA. 208+50 TO STA. 213+00

PROJECT NAME: BETHEL-RANDOLPH
PROJECT NUMBER: STP 292(K)

FILE NAME: piOC244.dgn
PROJECT LEADER: C. LATHROP
DESIGNED BY: S. LAMPHERE
CROSS SECTION SHEET 18

PLOT DATE: 4/23/2015
DRAWN BY: S. LAMPHERE
CHECKED BY: C. LATHROP
SHEET 152 OF 211