




220+50

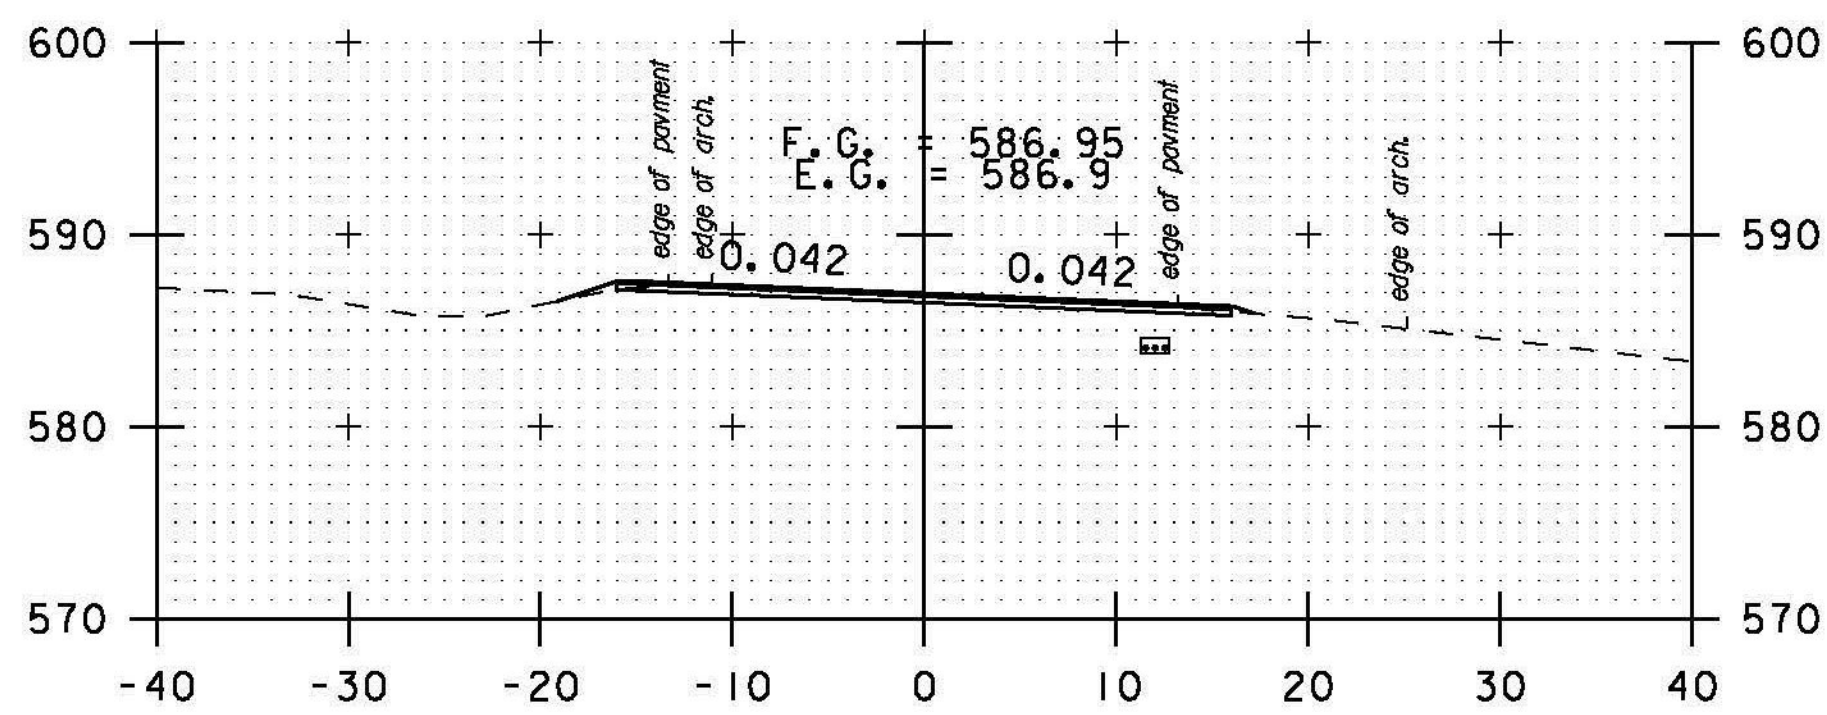


222+00

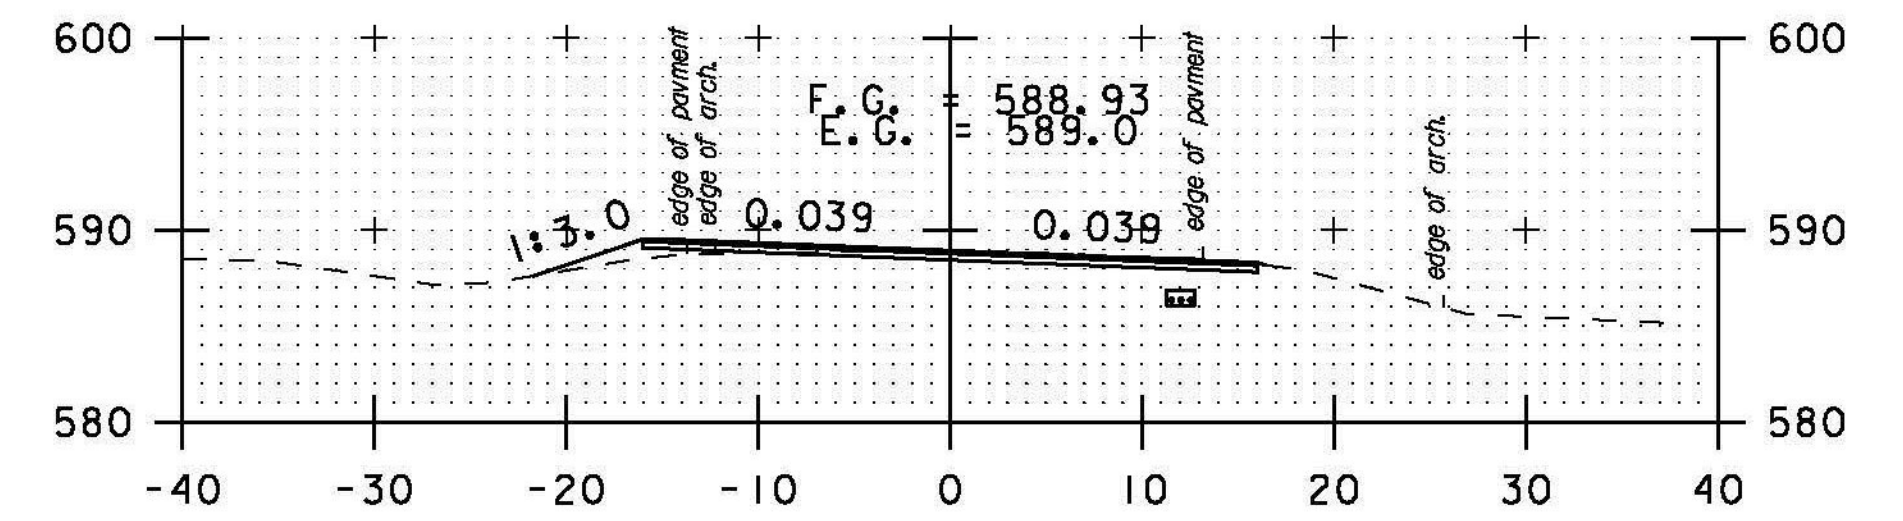


224+00

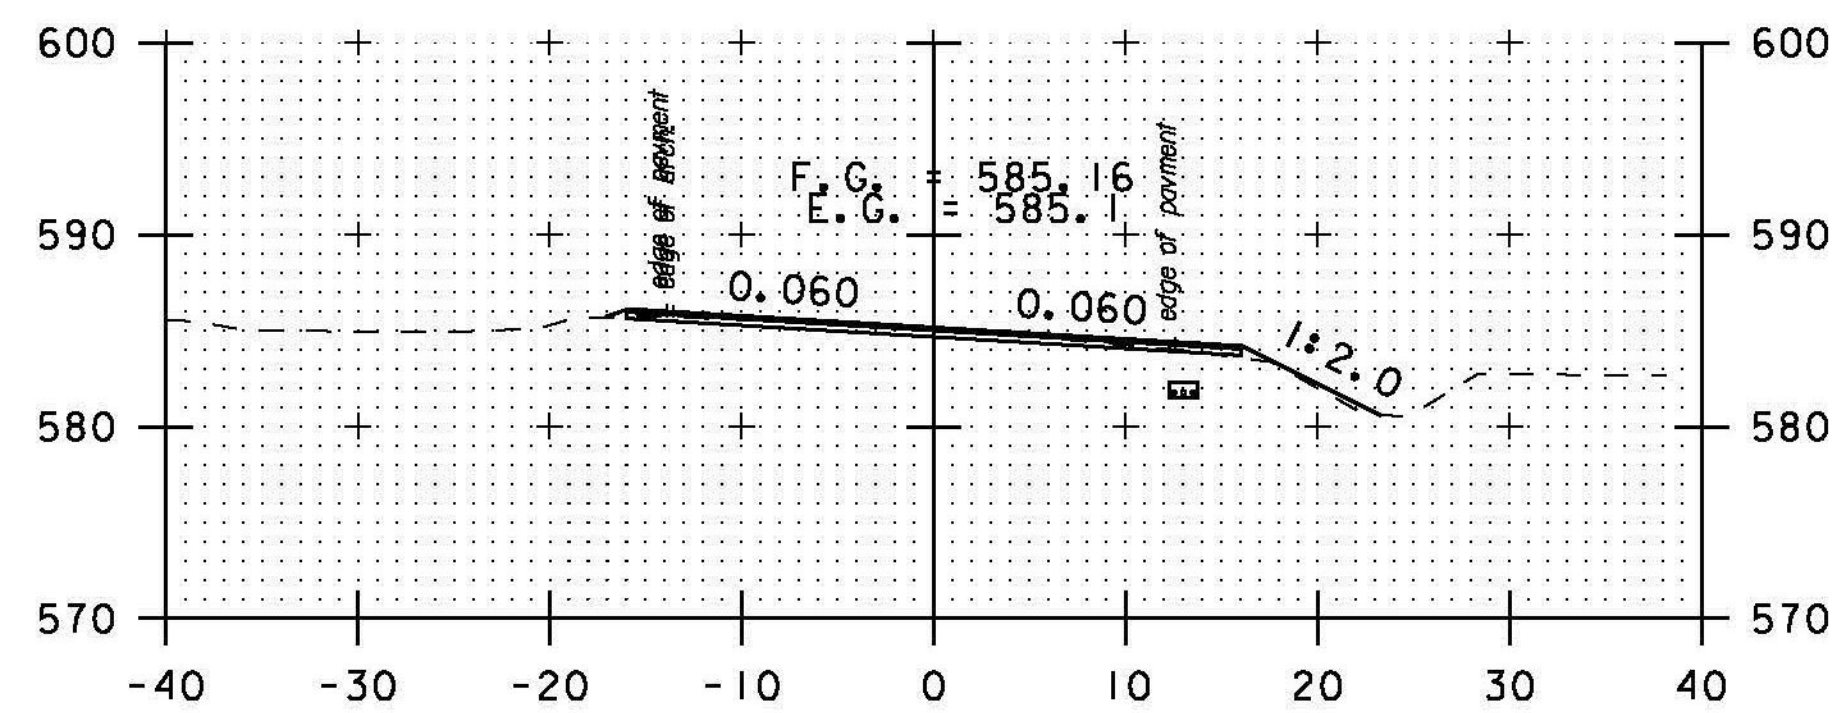


220+00

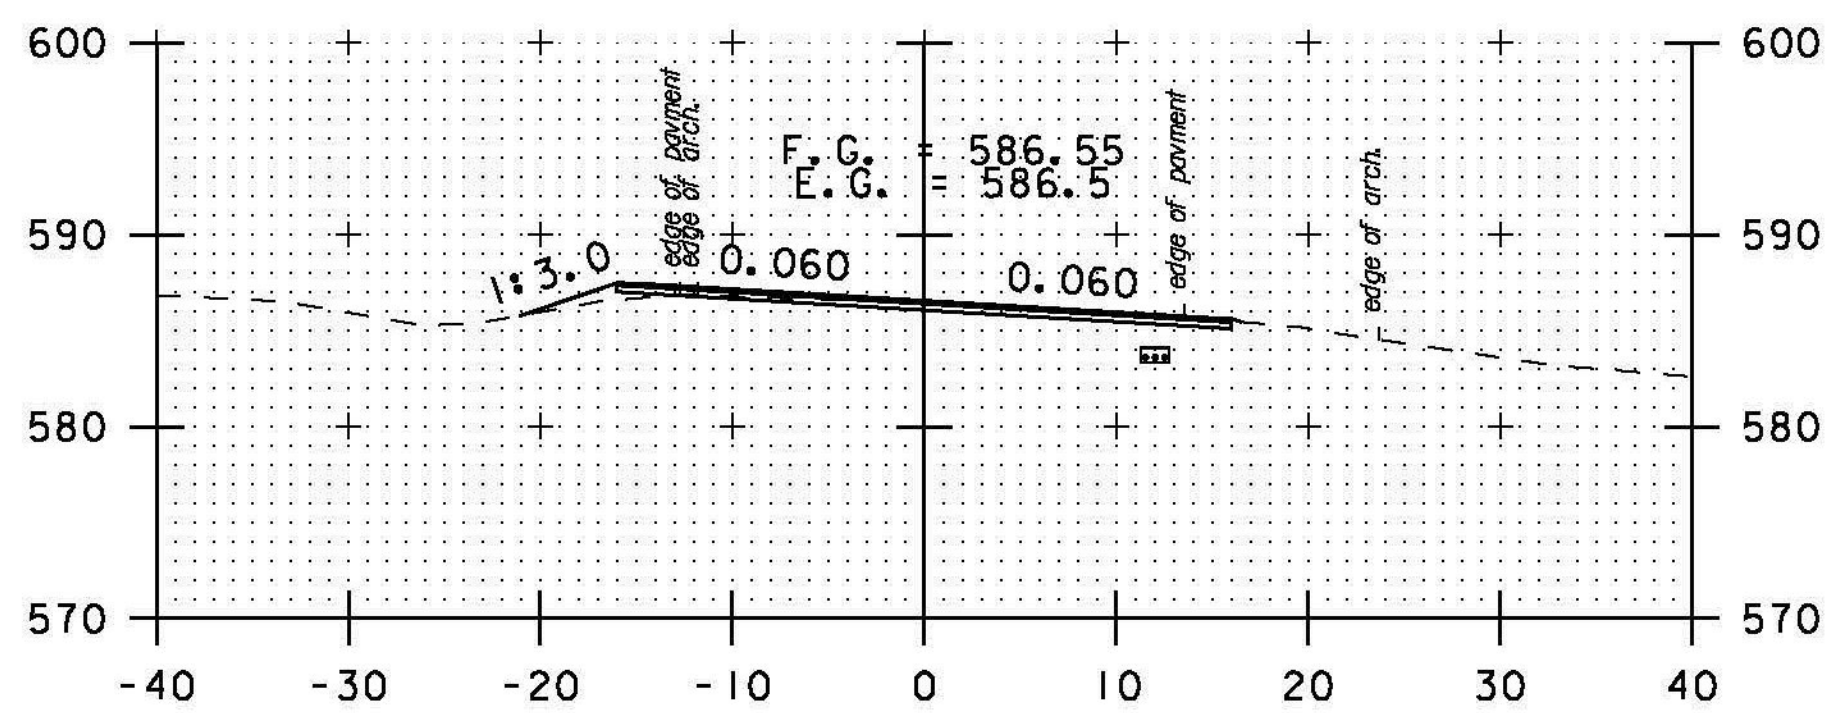


221+50

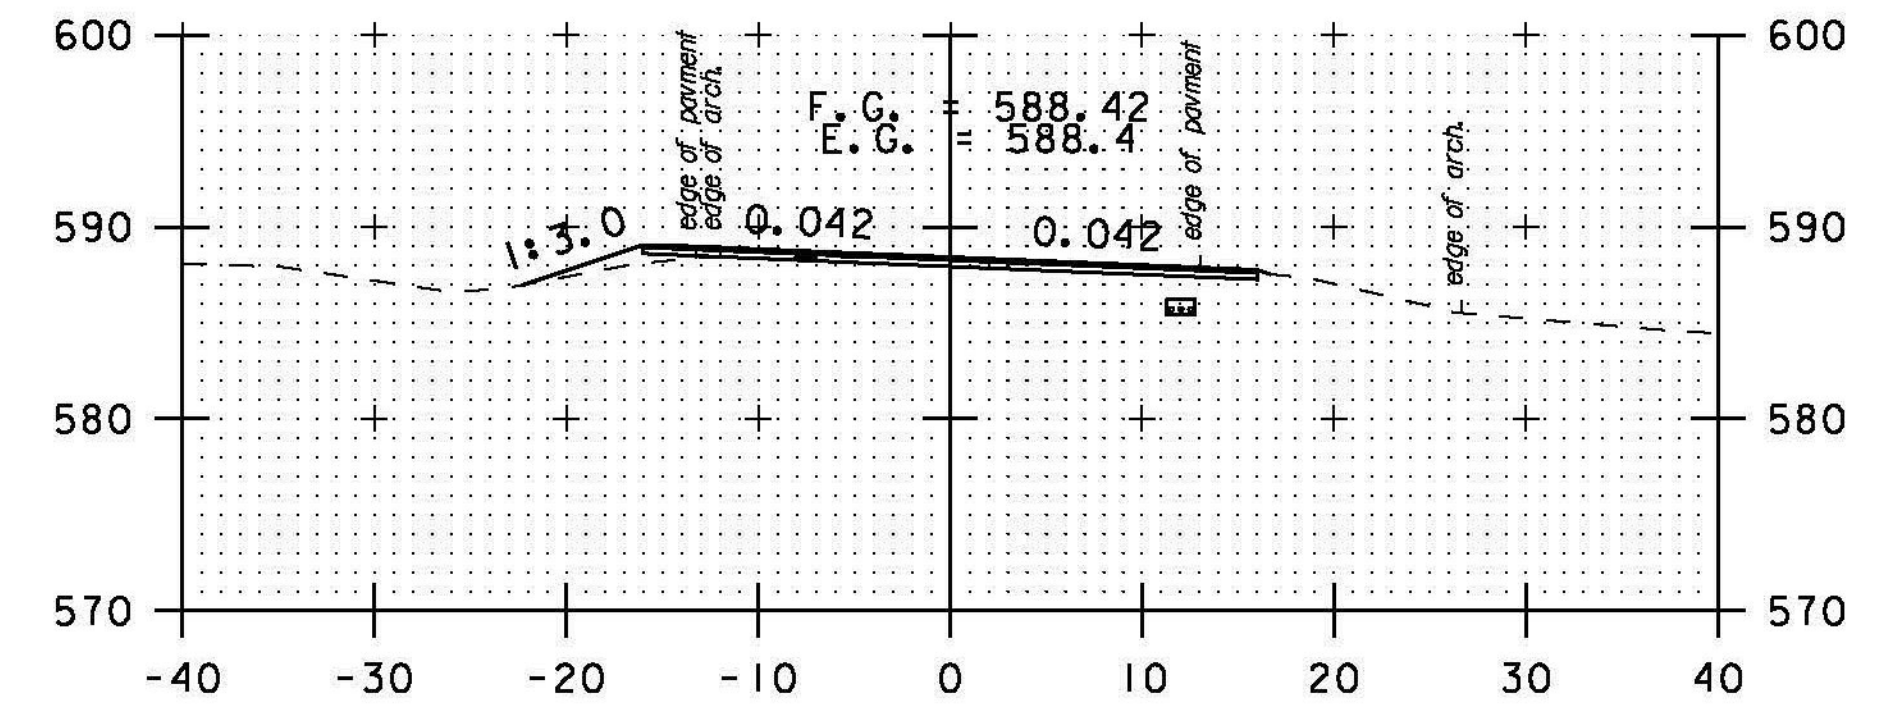


223+50

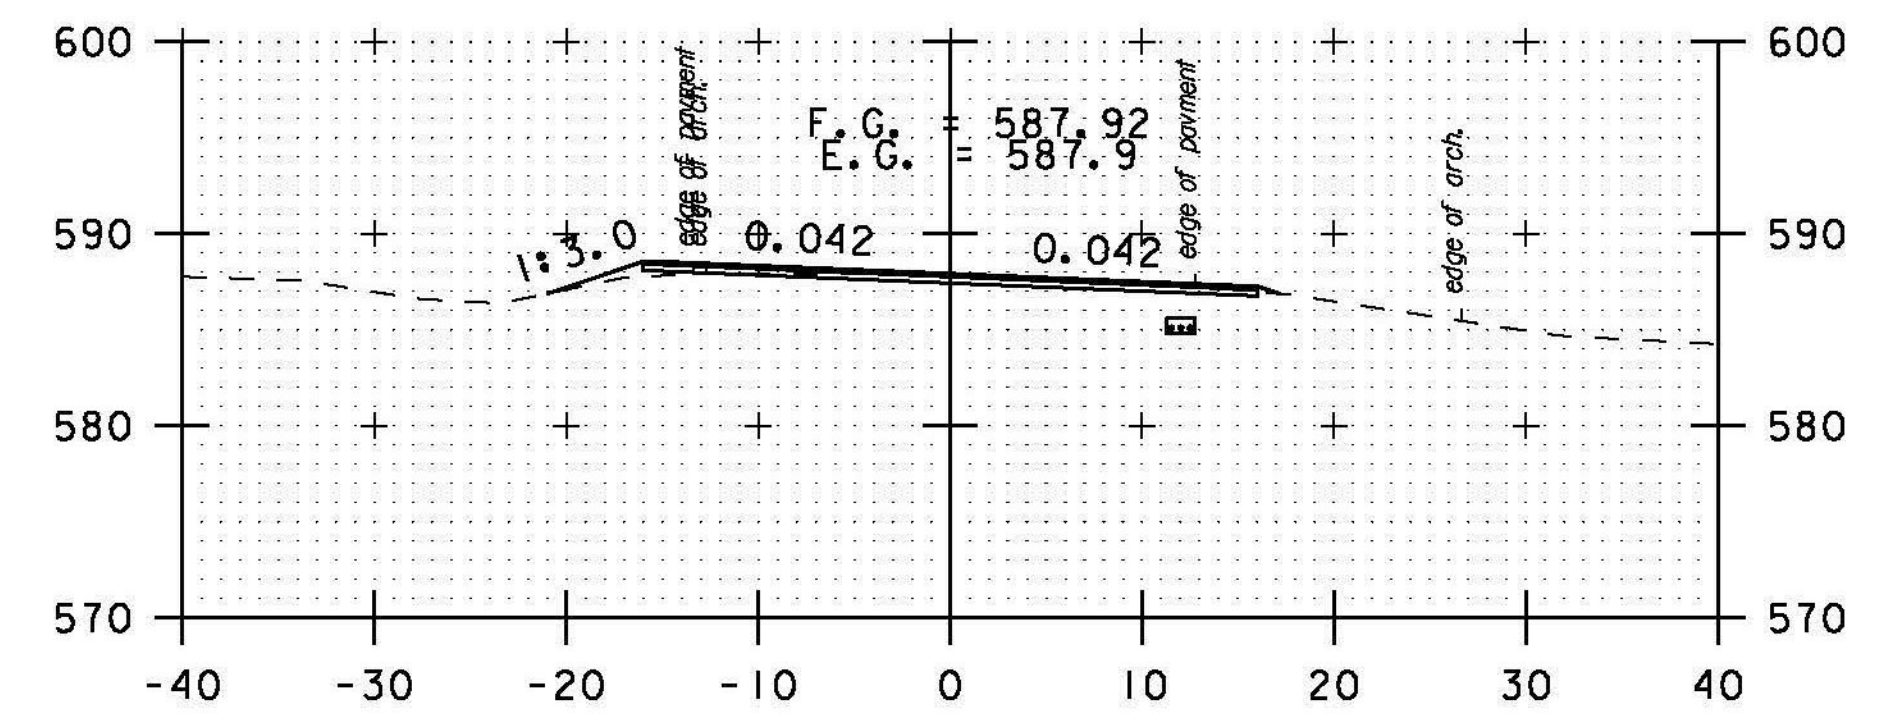


223+00

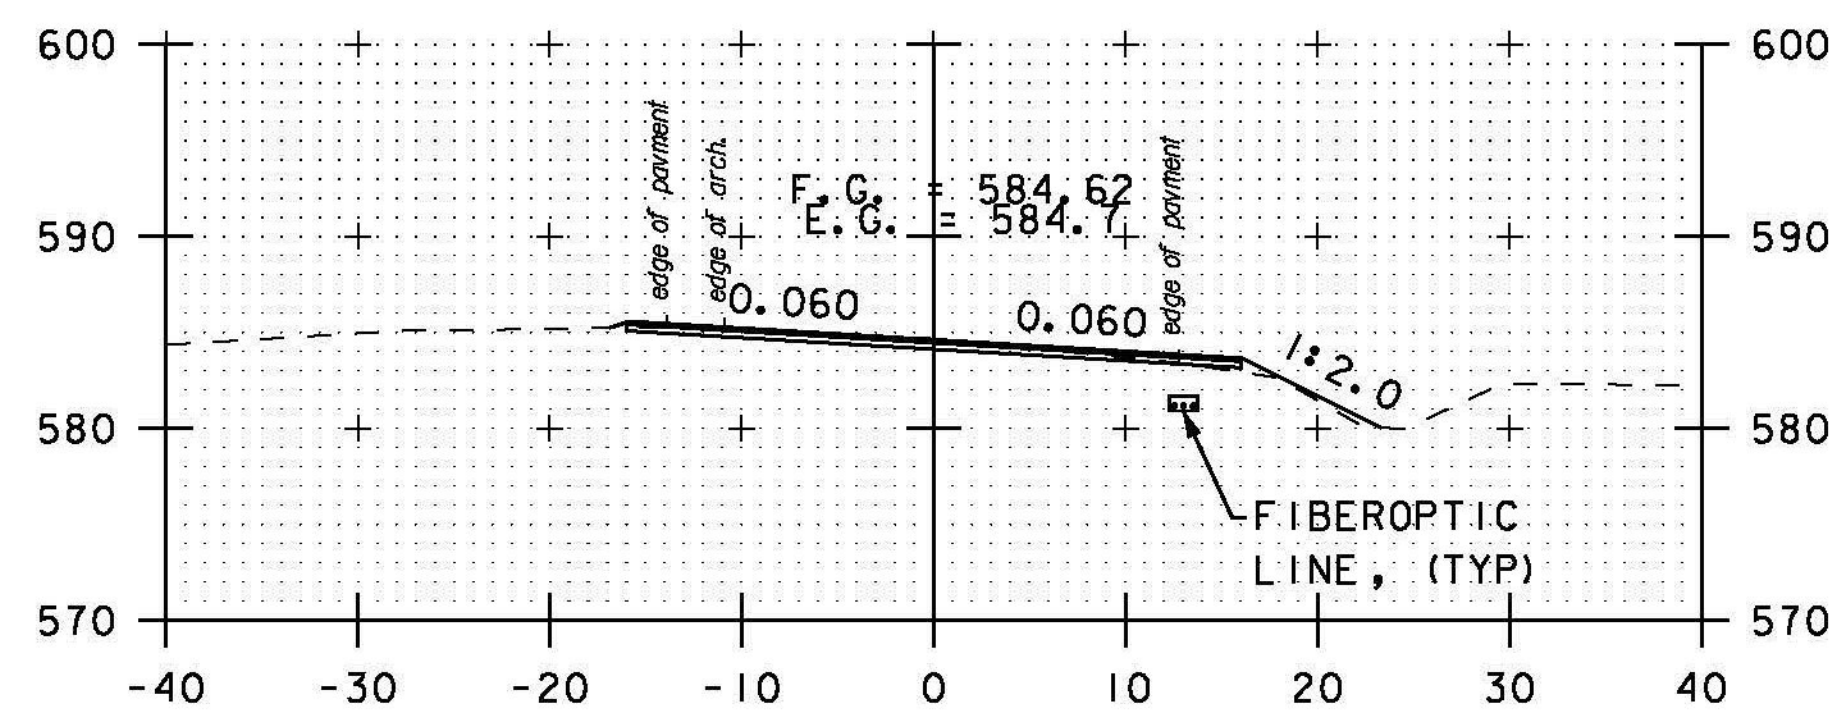


DRIVE LT
219+50

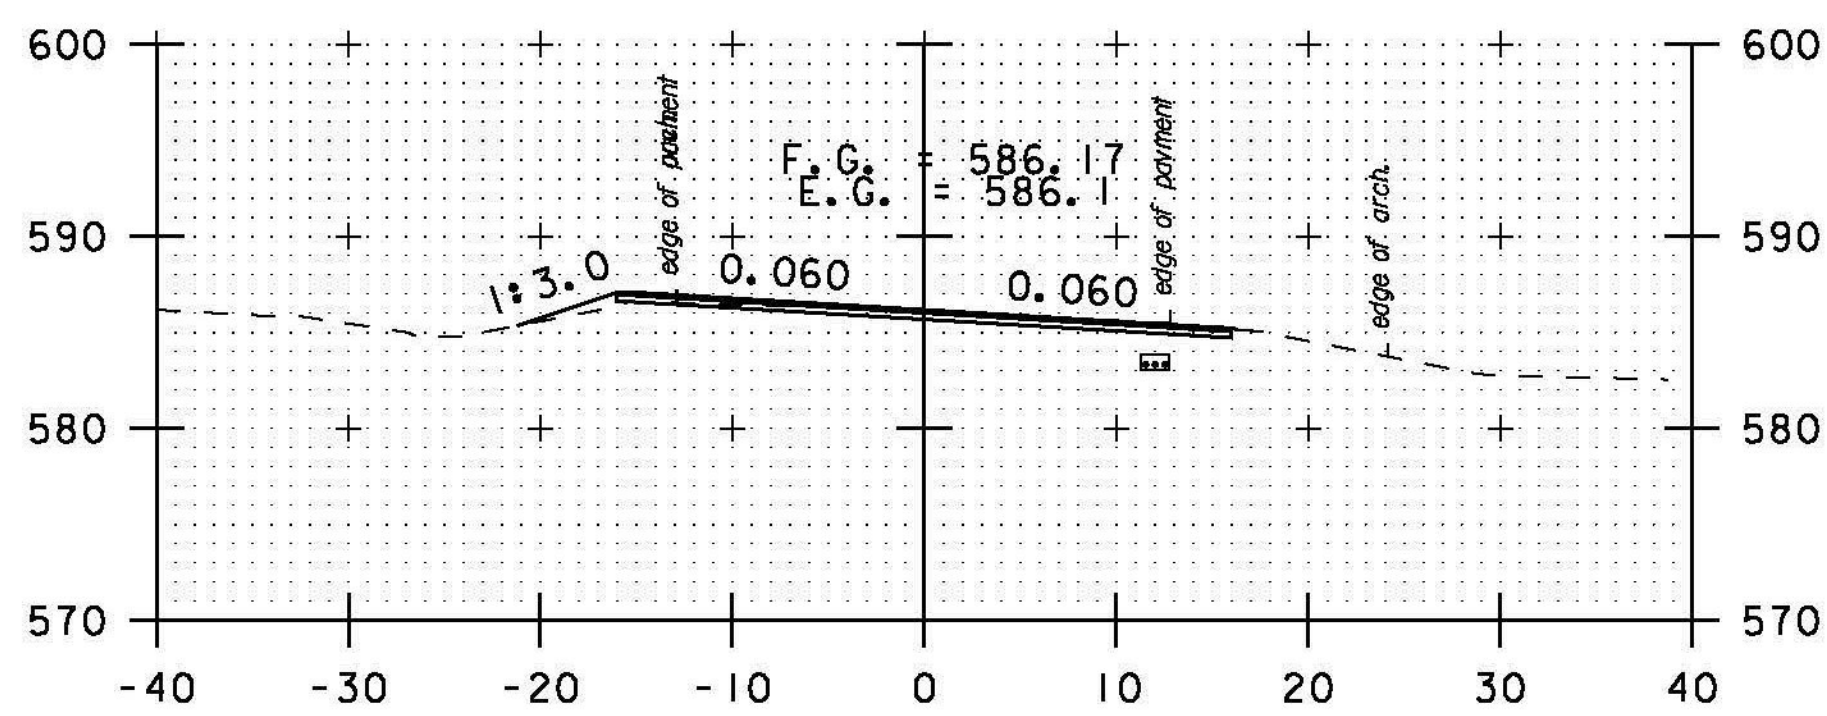

221+00

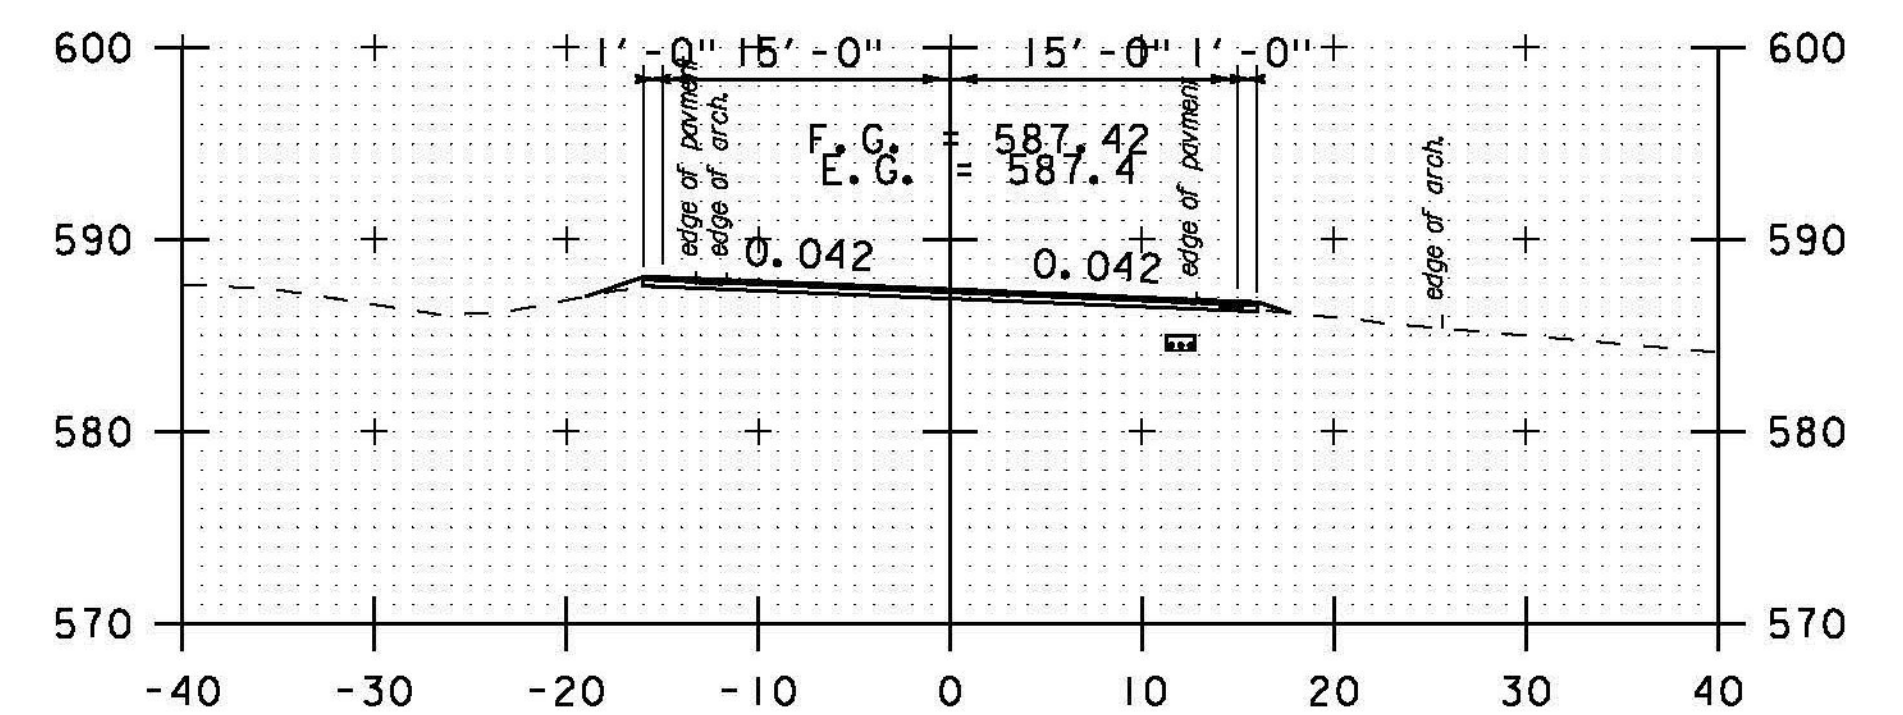

222+50

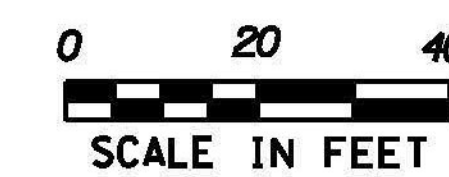

SCALE IN FEET

STA. 219+50 TO STA. 224+00

PROJECT NAME: BETHEL-RANDOLPH
PROJECT NUMBER: STP 292(K)

FILE NAME: piOC244.dgn
PROJECT LEADER: C. LATHROP
DESIGNED BY: S. LAMPHERE
CROSS SECTION SHEET 20

PLOT DATE: 4/23/2015
DRAWN BY: S. LAMPHERE
CHECKED BY: C. LATHROP
SHEET 154 OF 211