




226+00

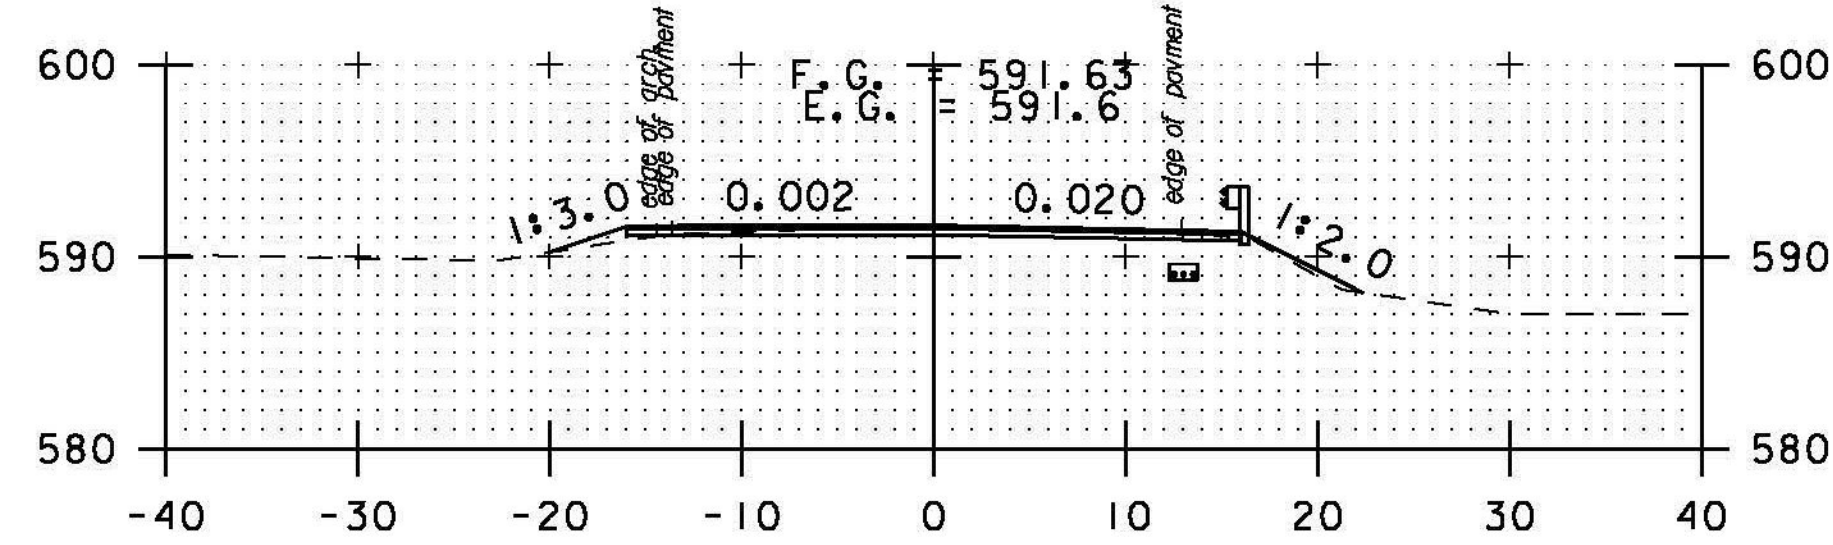


225+50

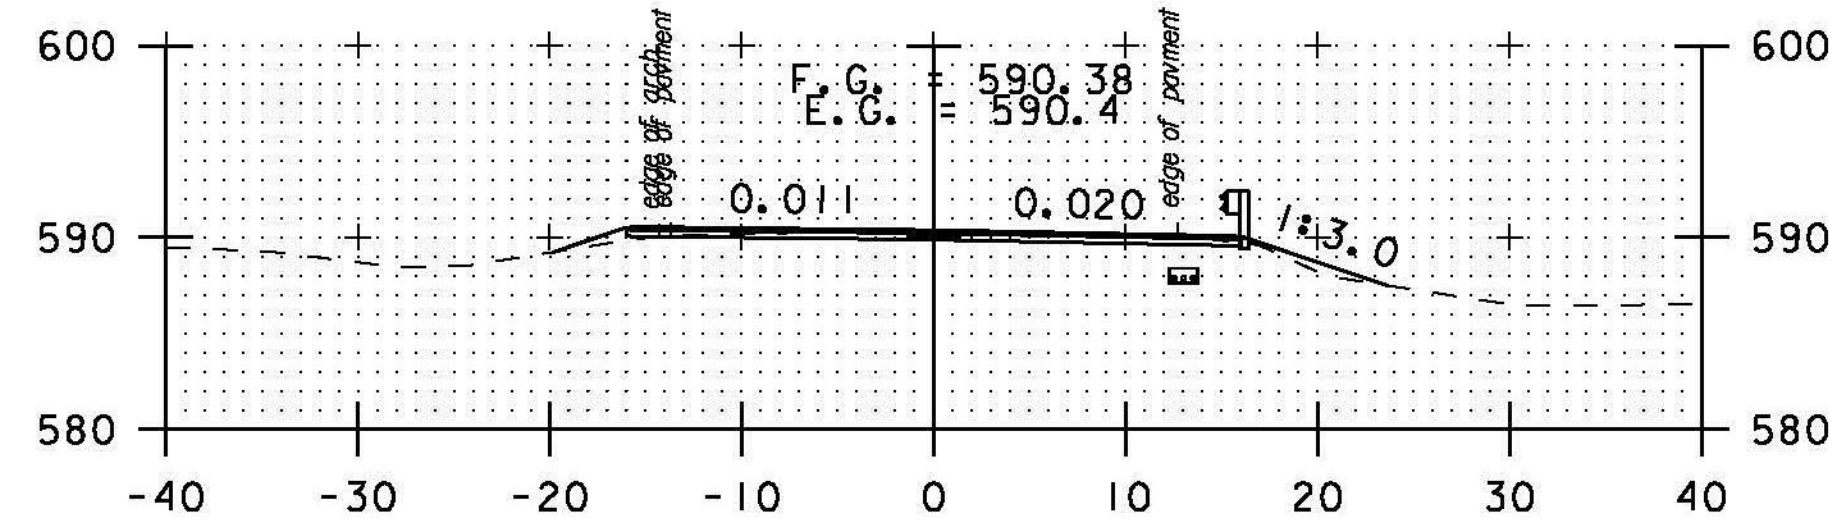


225+00

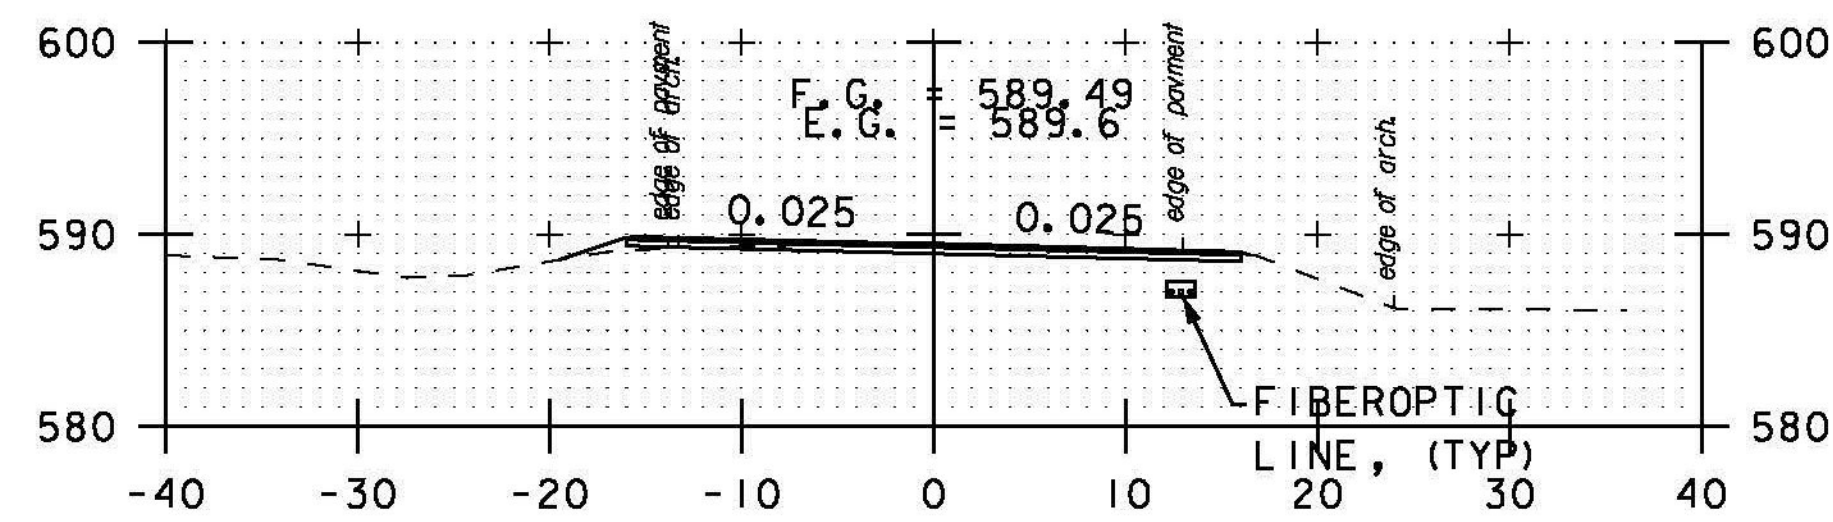


224+50

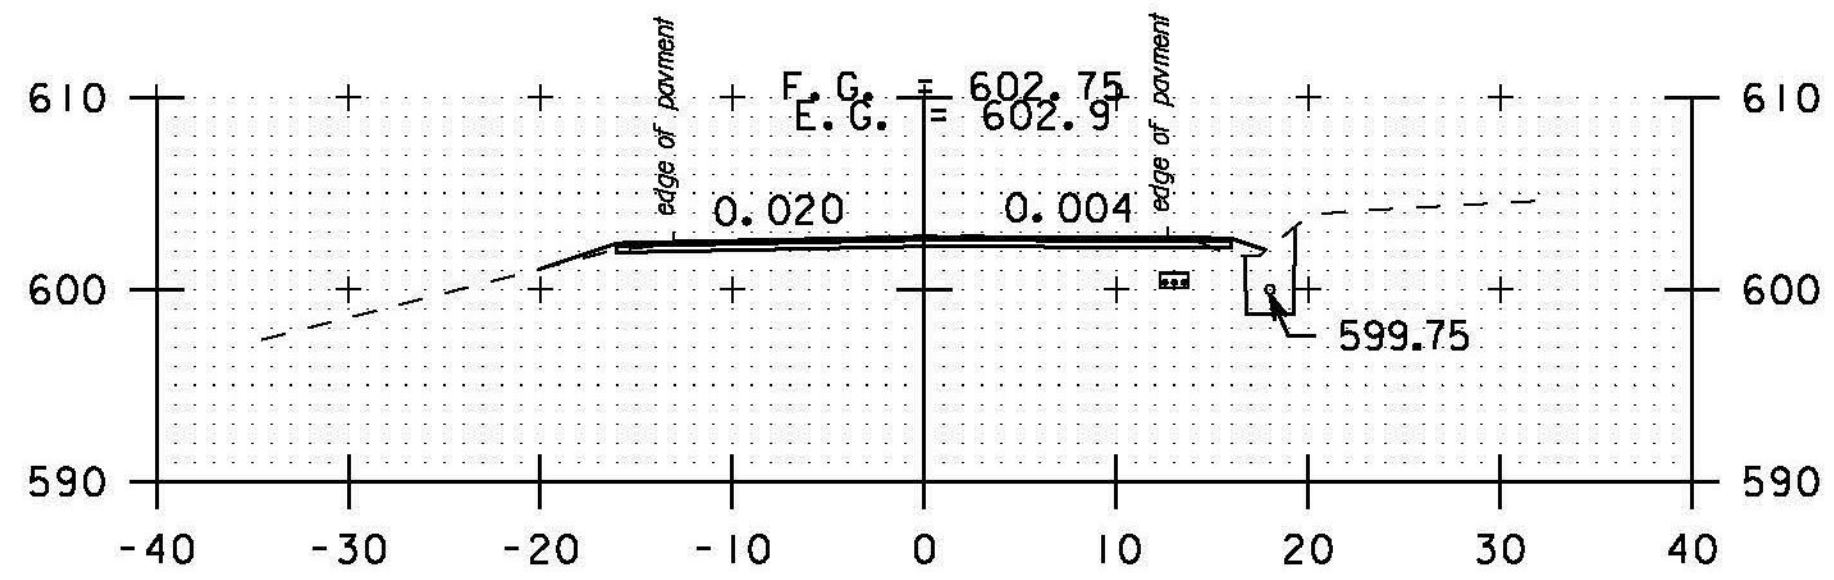


228+00

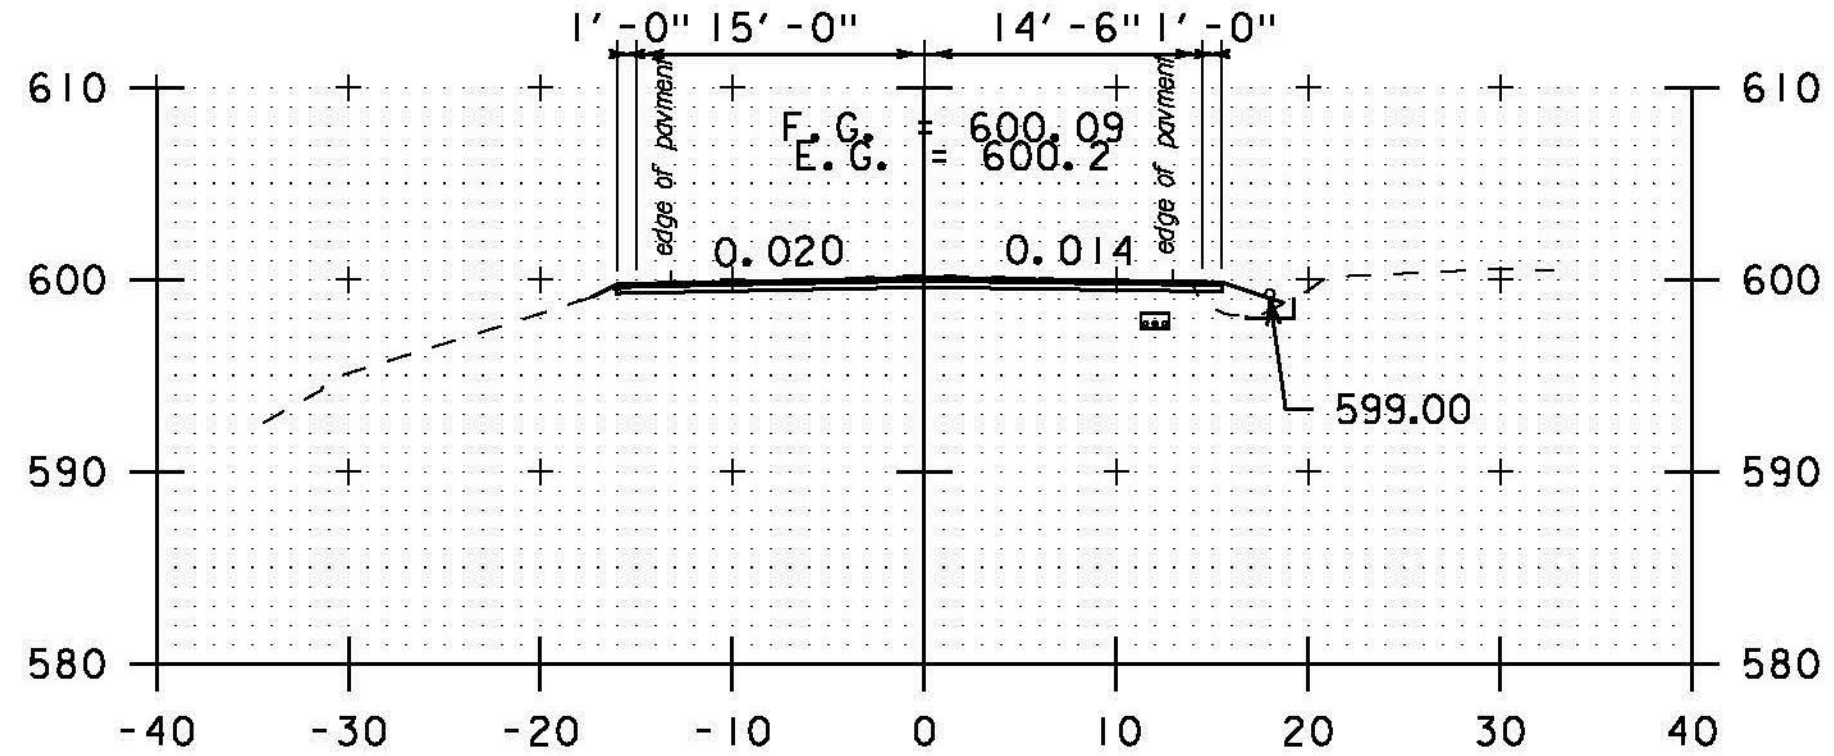


227+50

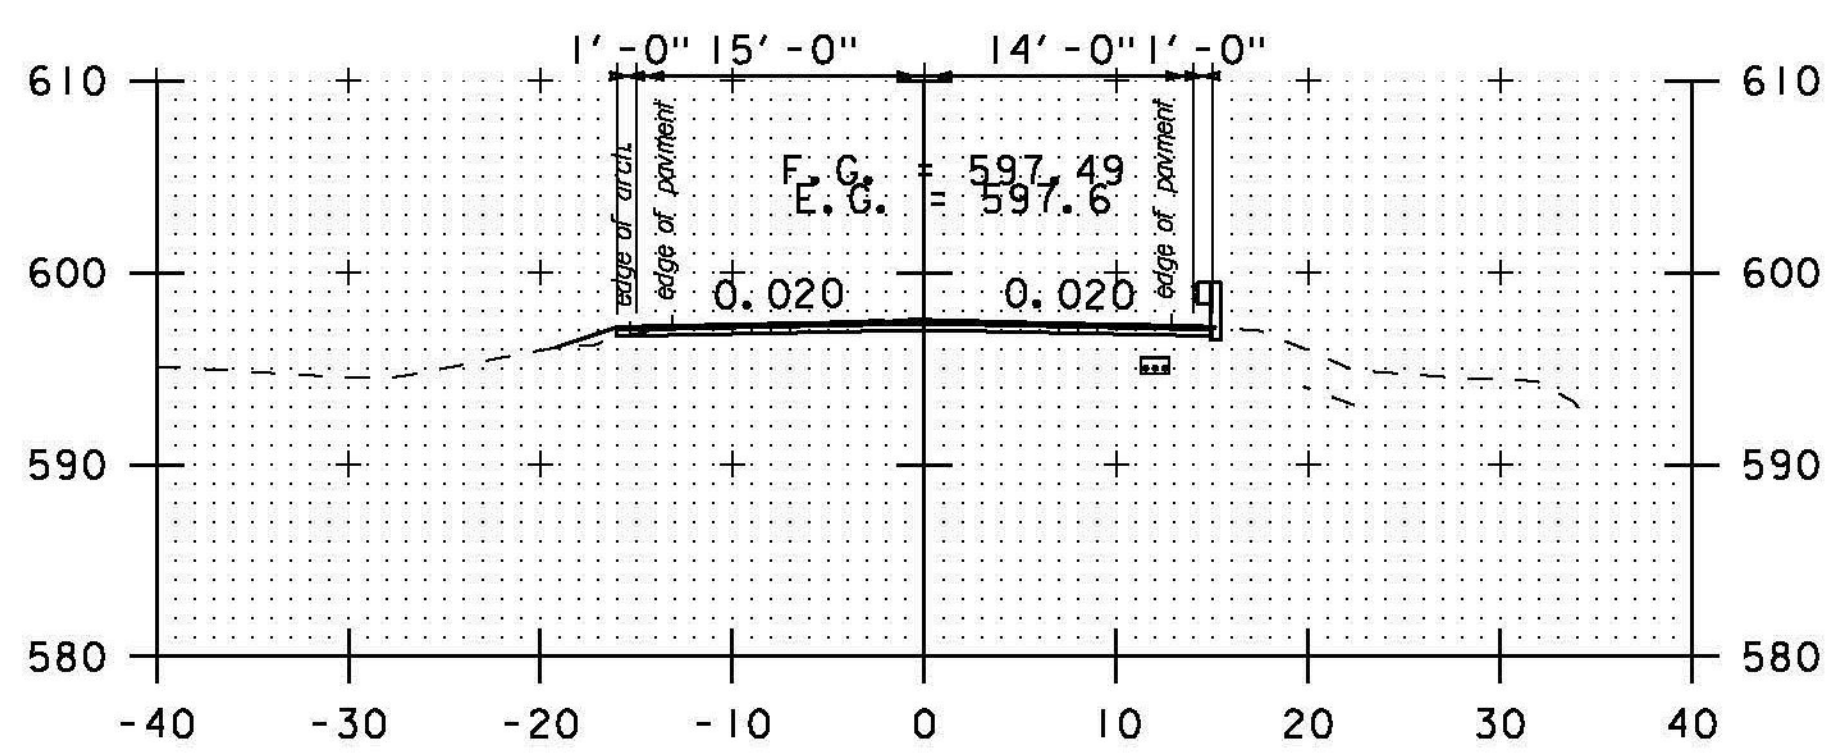


227+00

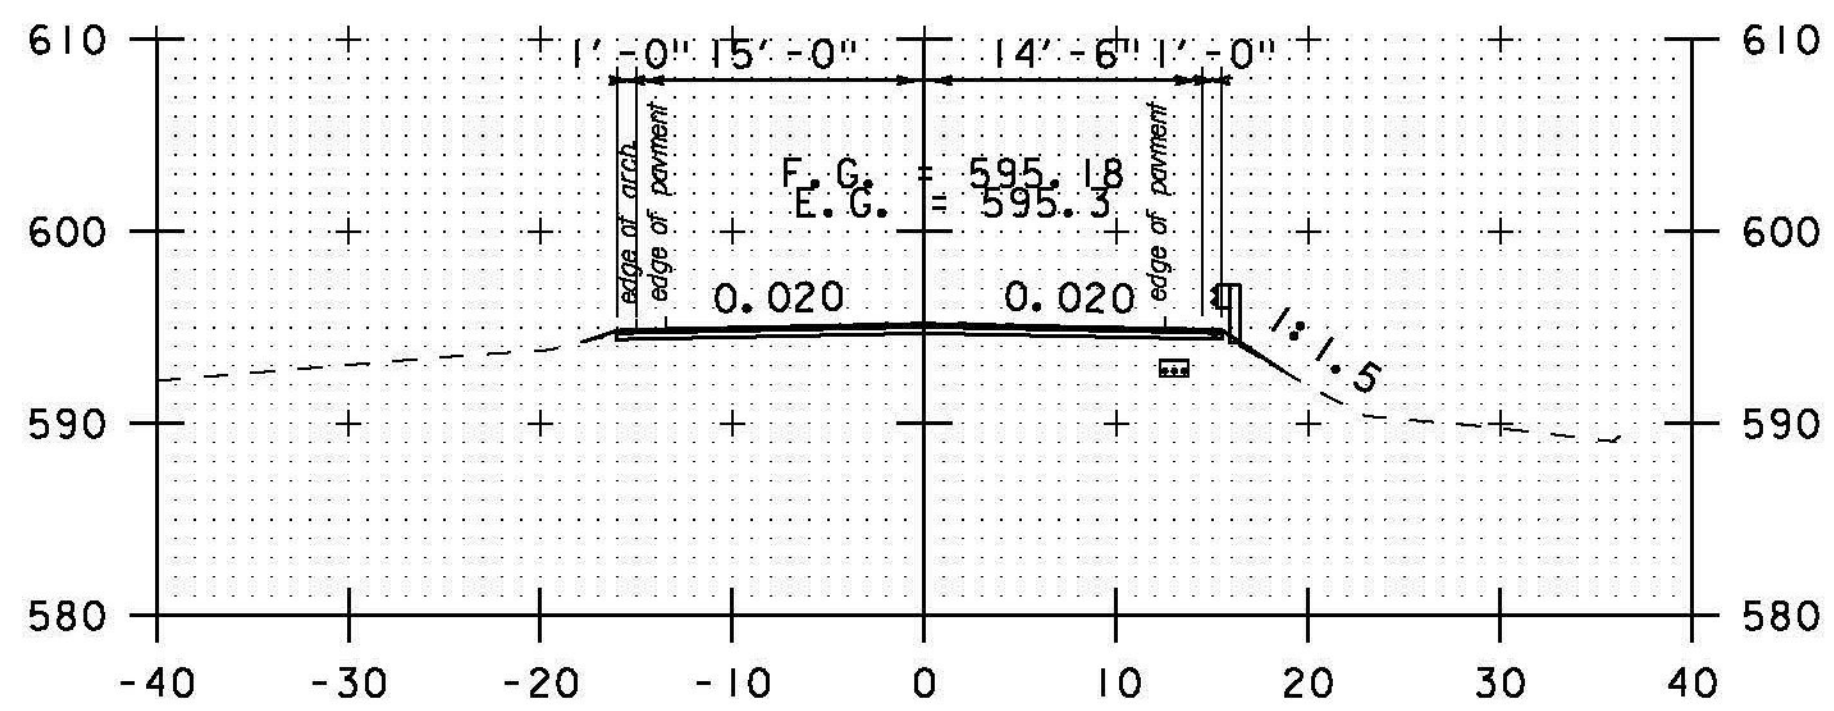


226+50

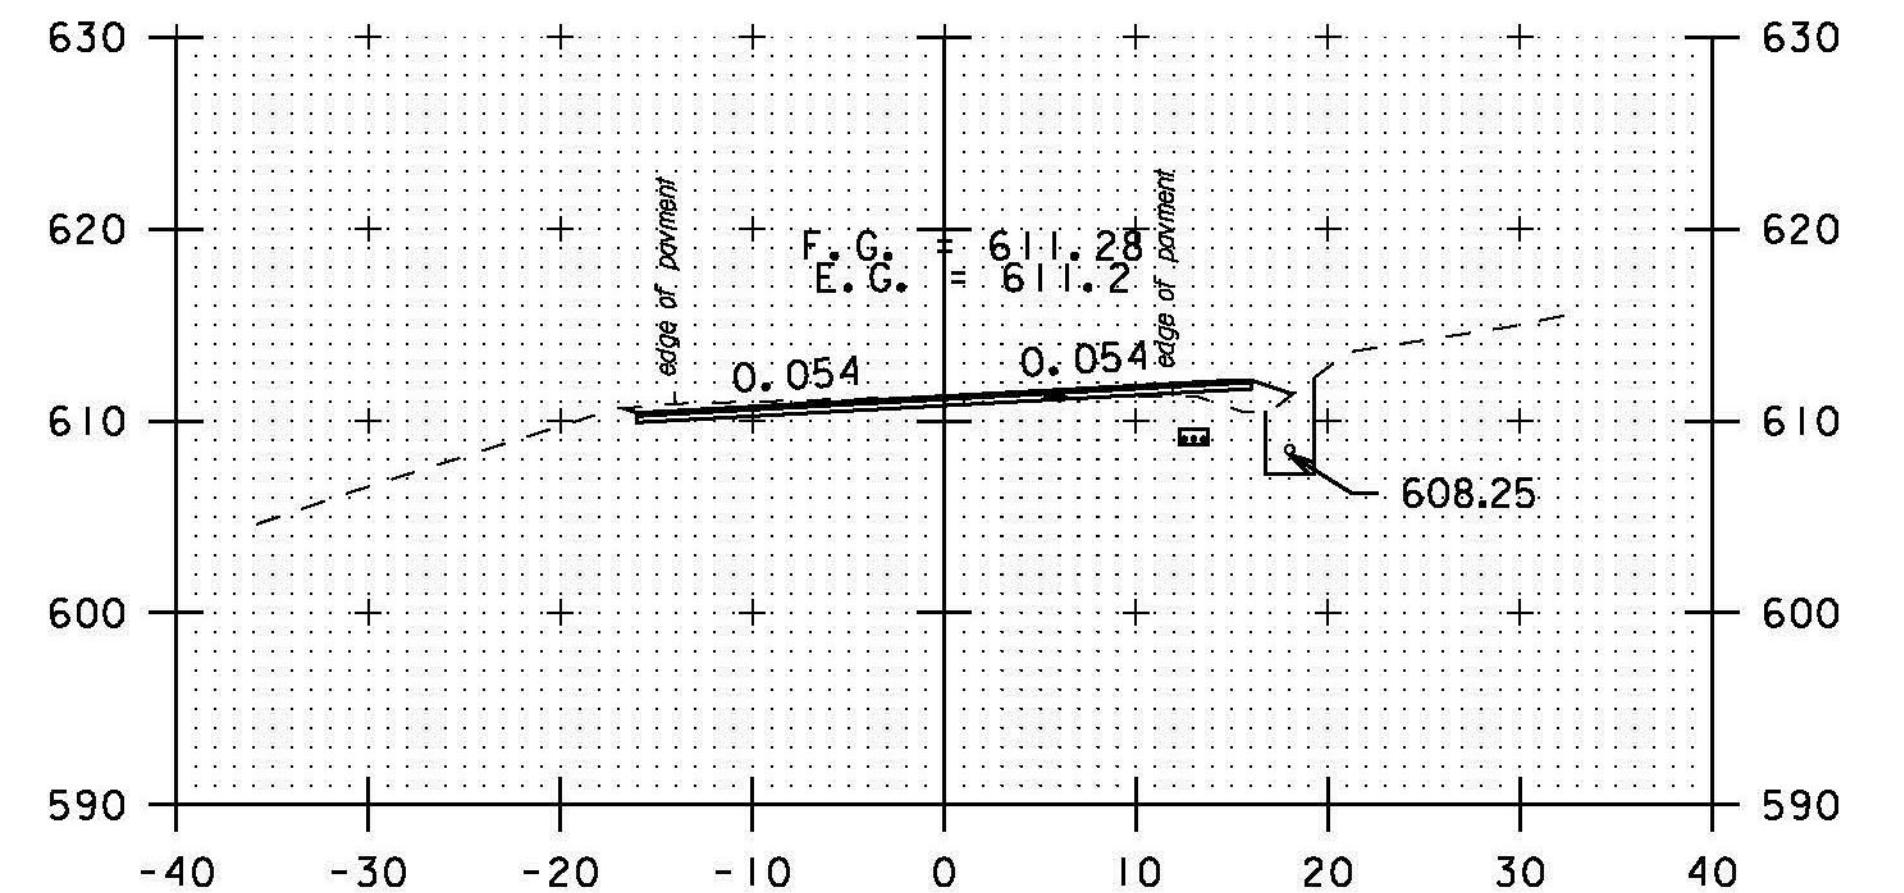


229+50

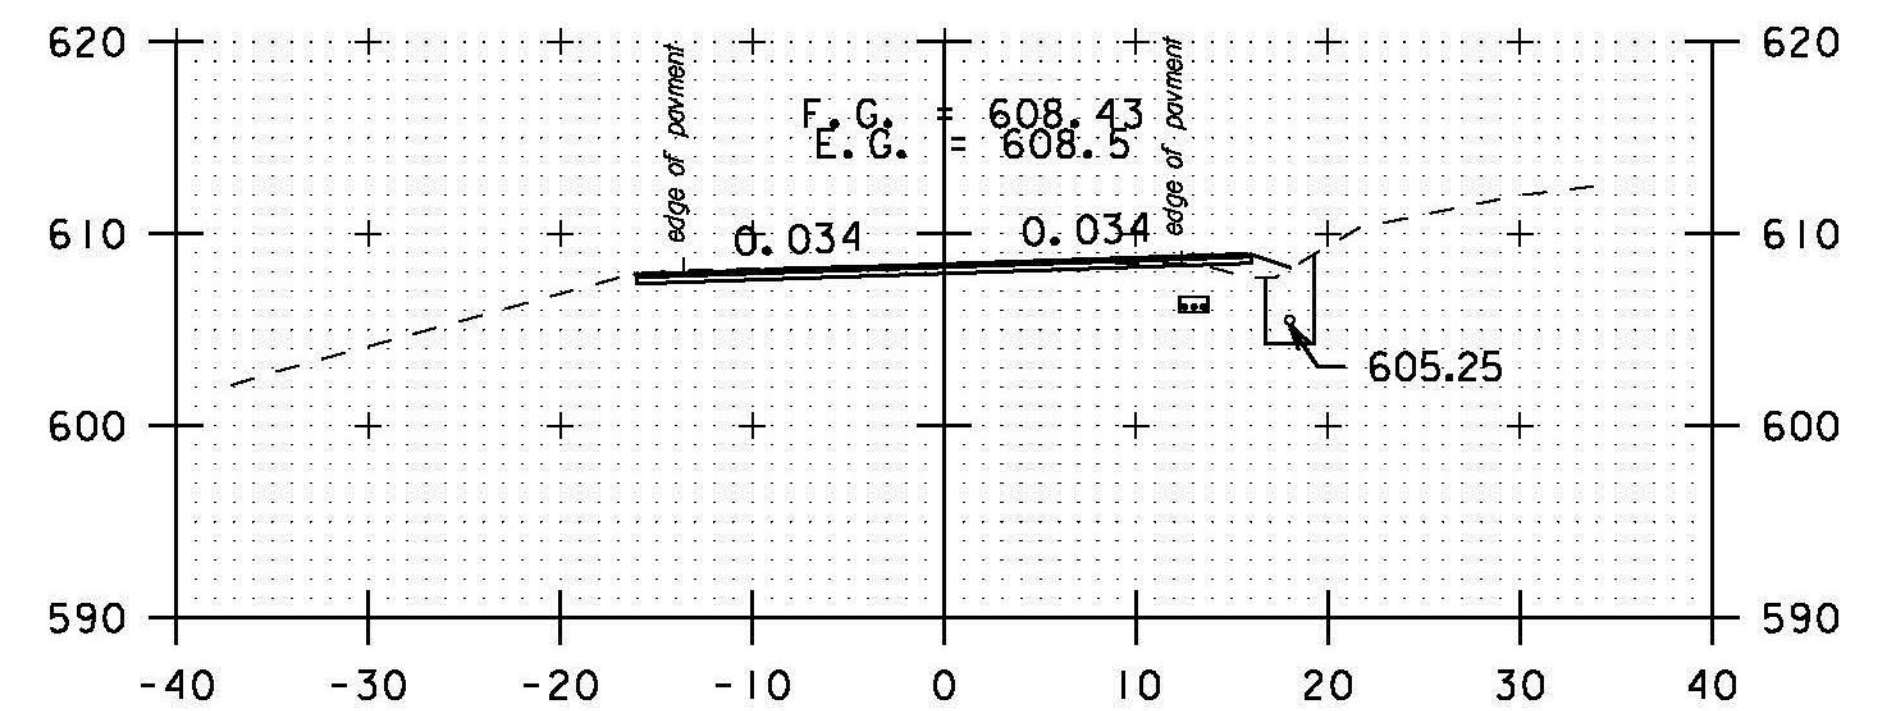

229+00

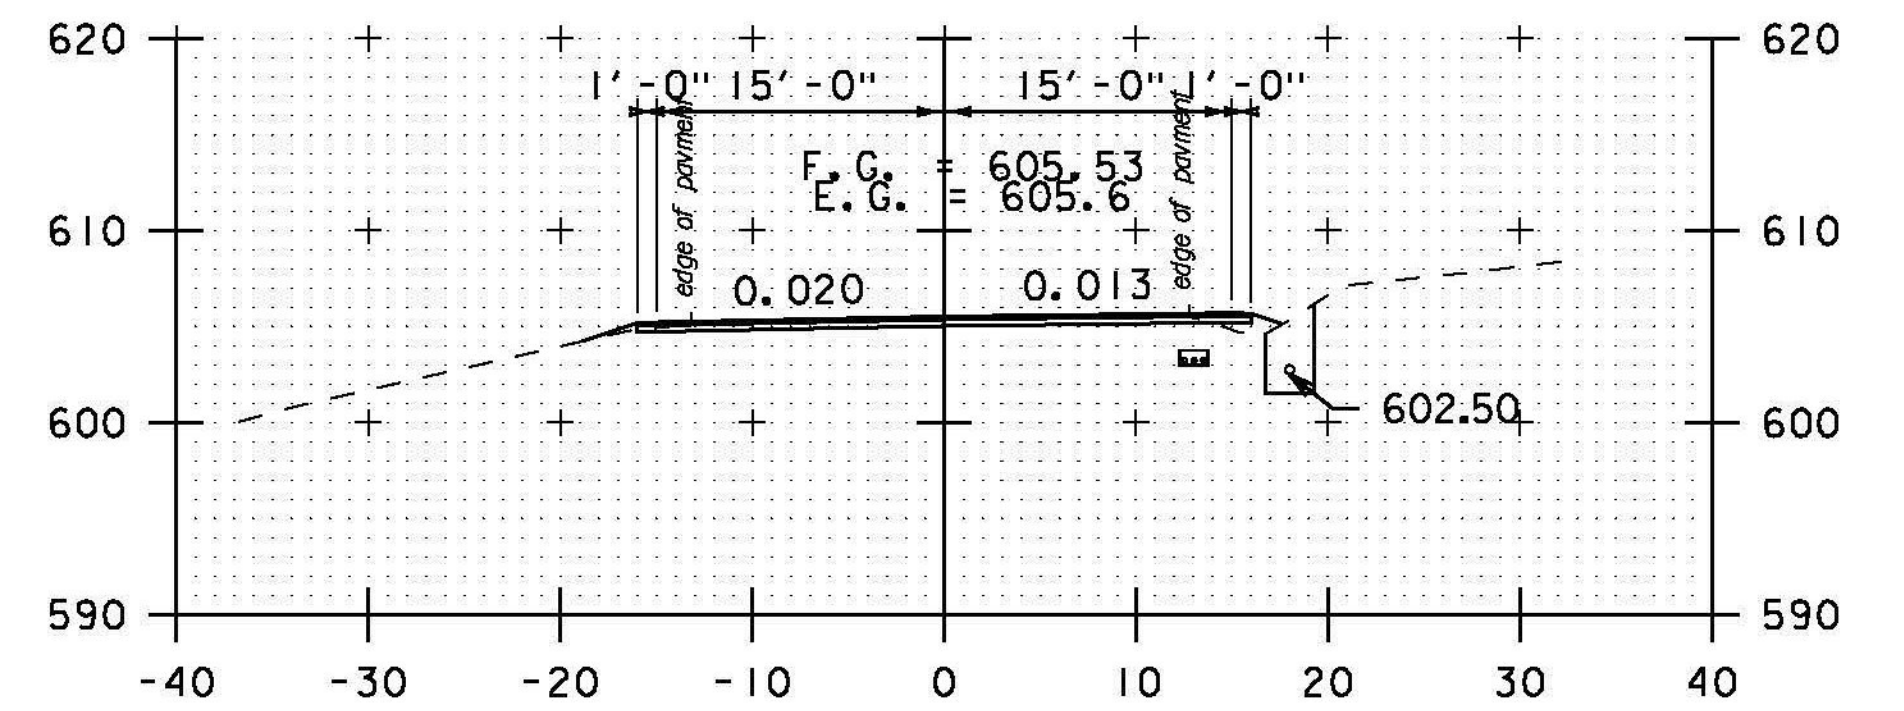

228+50

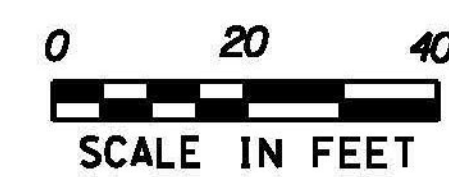

SCALE IN FEET

STA. 224+50 TO STA. 229+50

PROJECT NAME: BETHEL-RANDOLPH  
PROJECT NUMBER: STP 292(I)

FILE NAME: piOC244.dgn  
PROJECT LEADER: C. LATHROP  
DESIGNED BY: S. LAMPHERE  
CROSS SECTION SHEET 21

PLOT DATE: 4/23/2015  
DRAWN BY: S. LAMPHERE  
CHECKED BY: C. LATHROP  
SHEET 155 OF 211