




DRIVE RT  
241+00

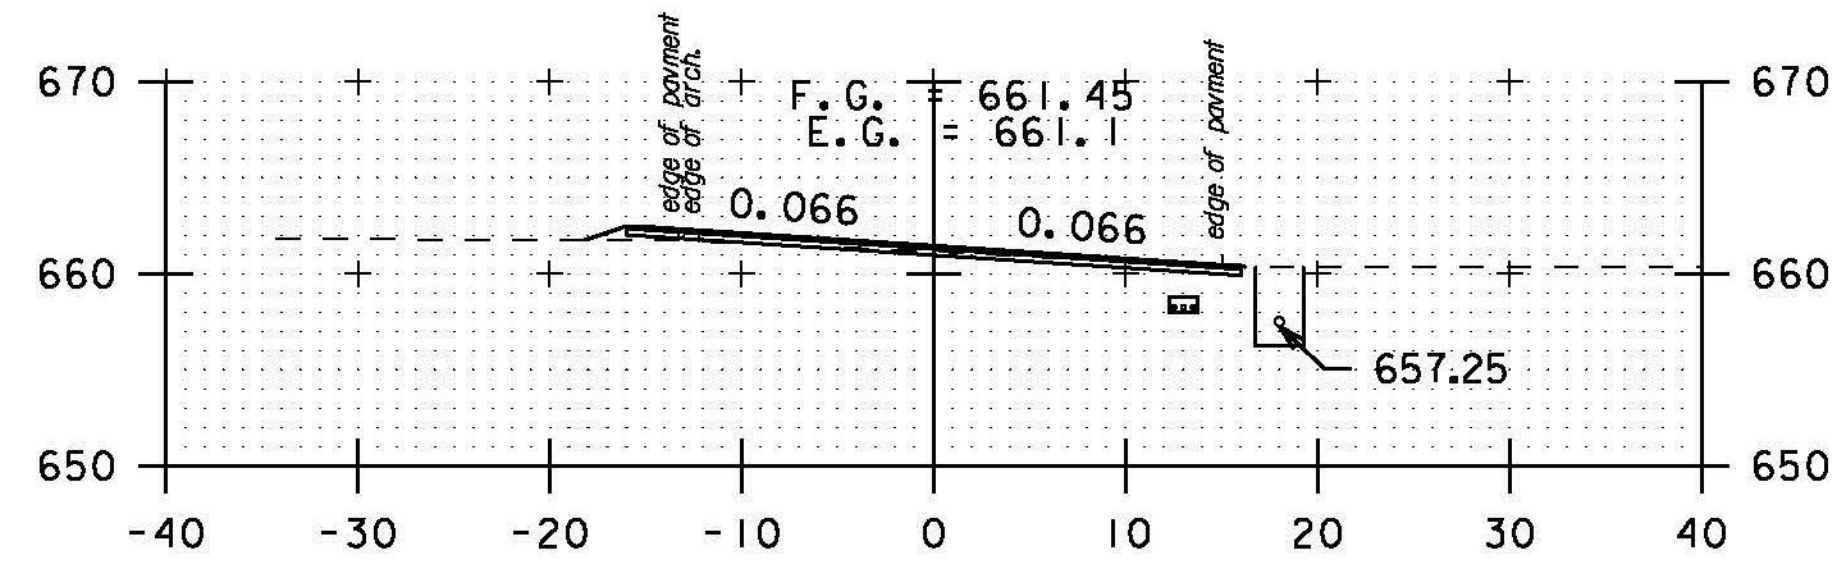


240+50

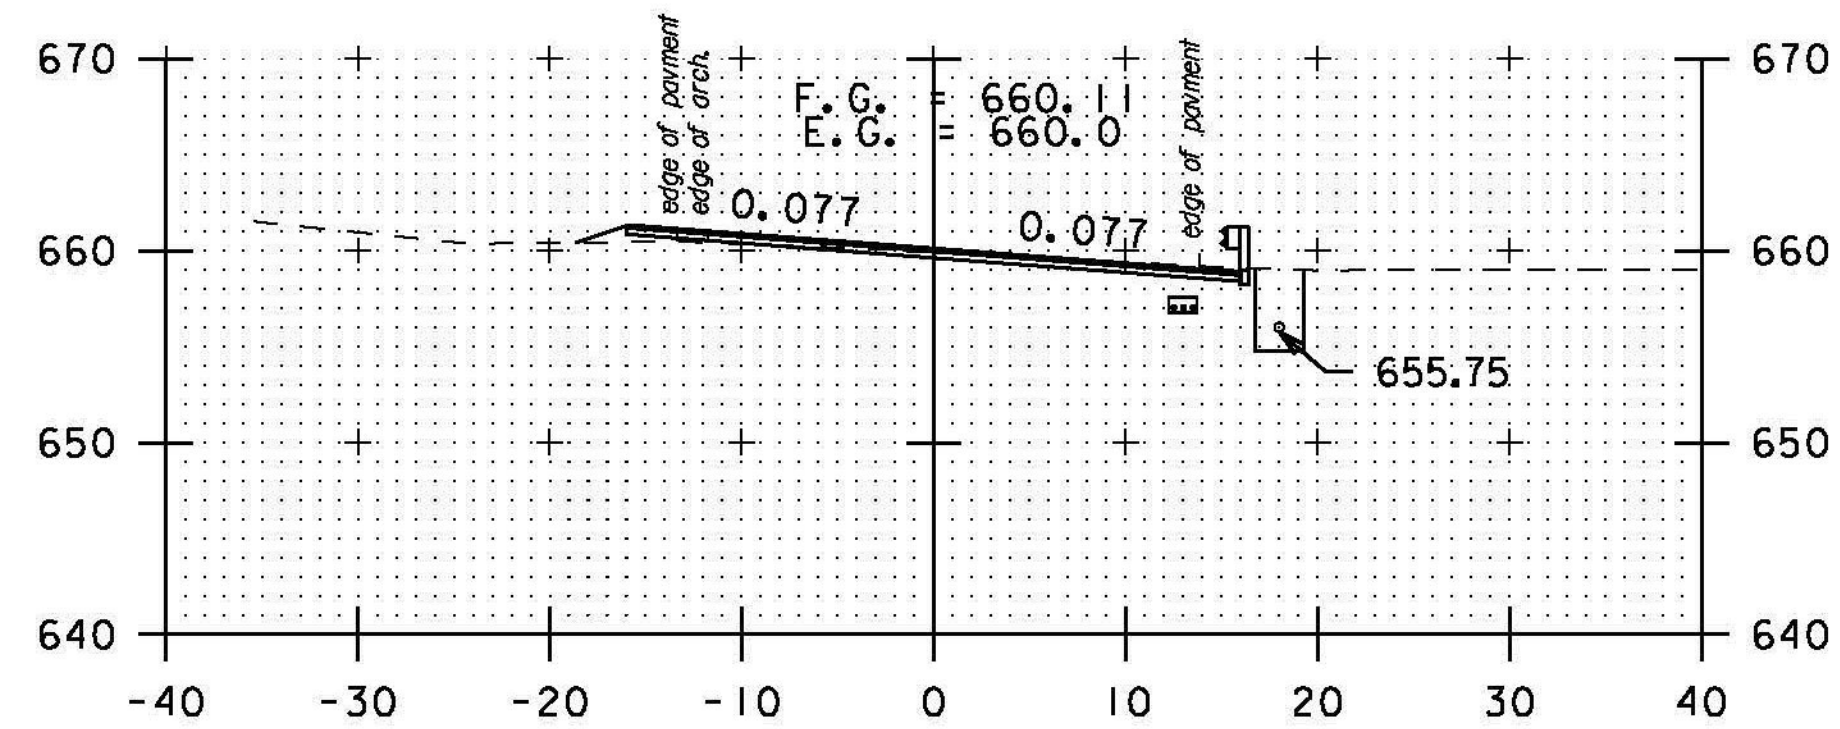


240+00

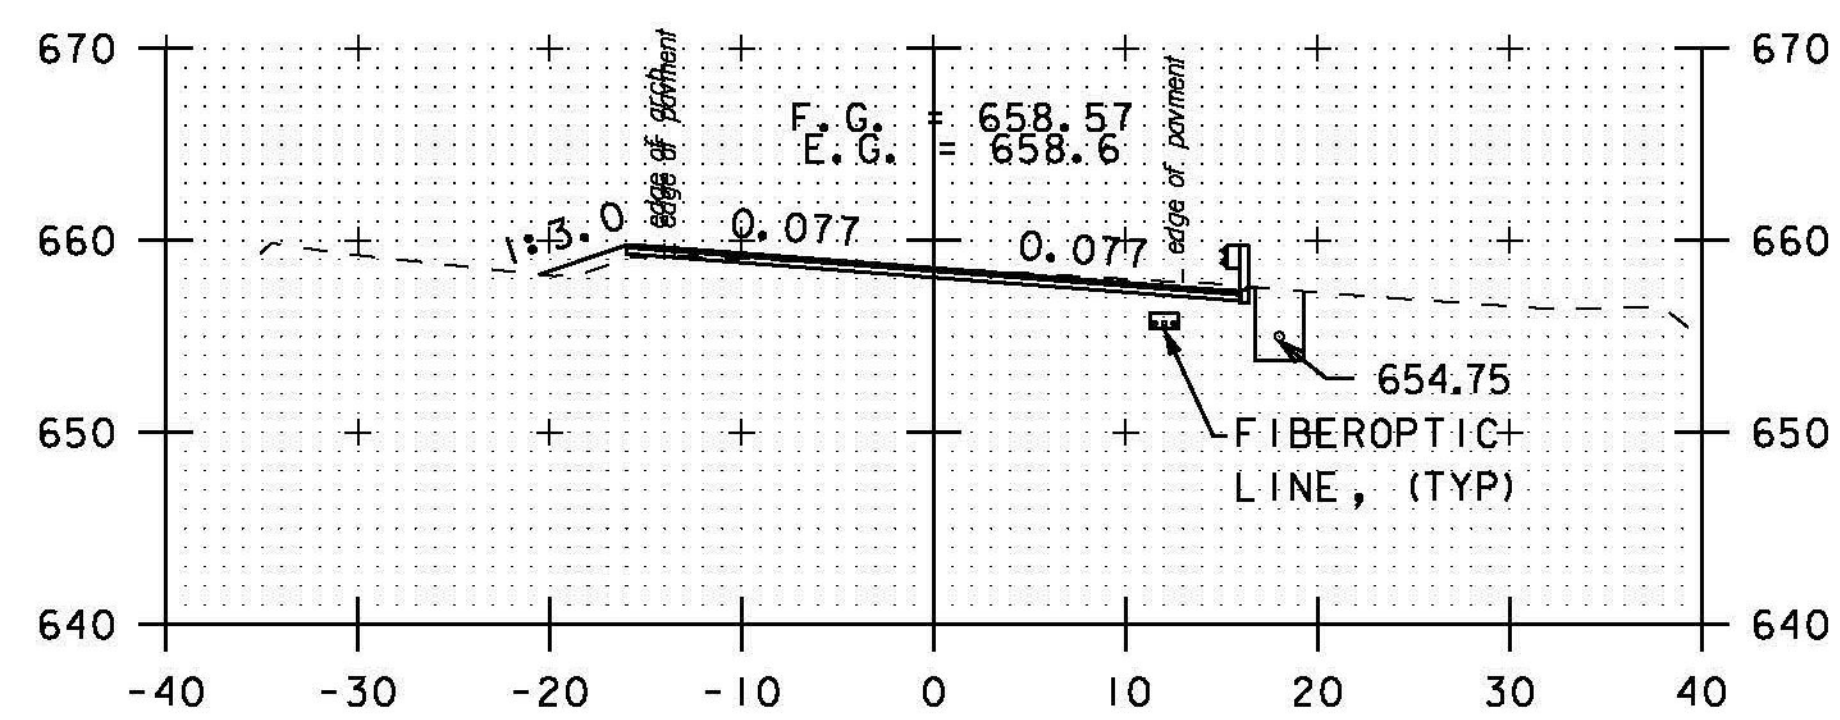


239+50

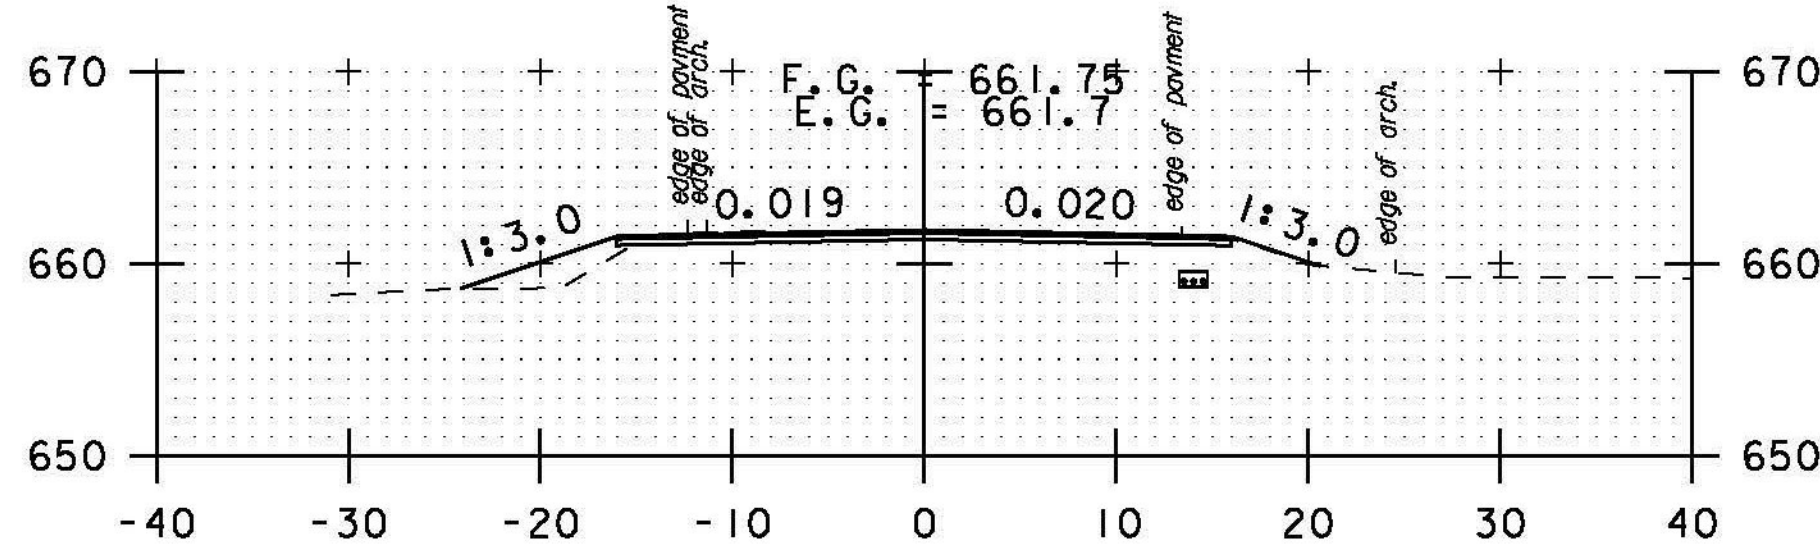


243+00

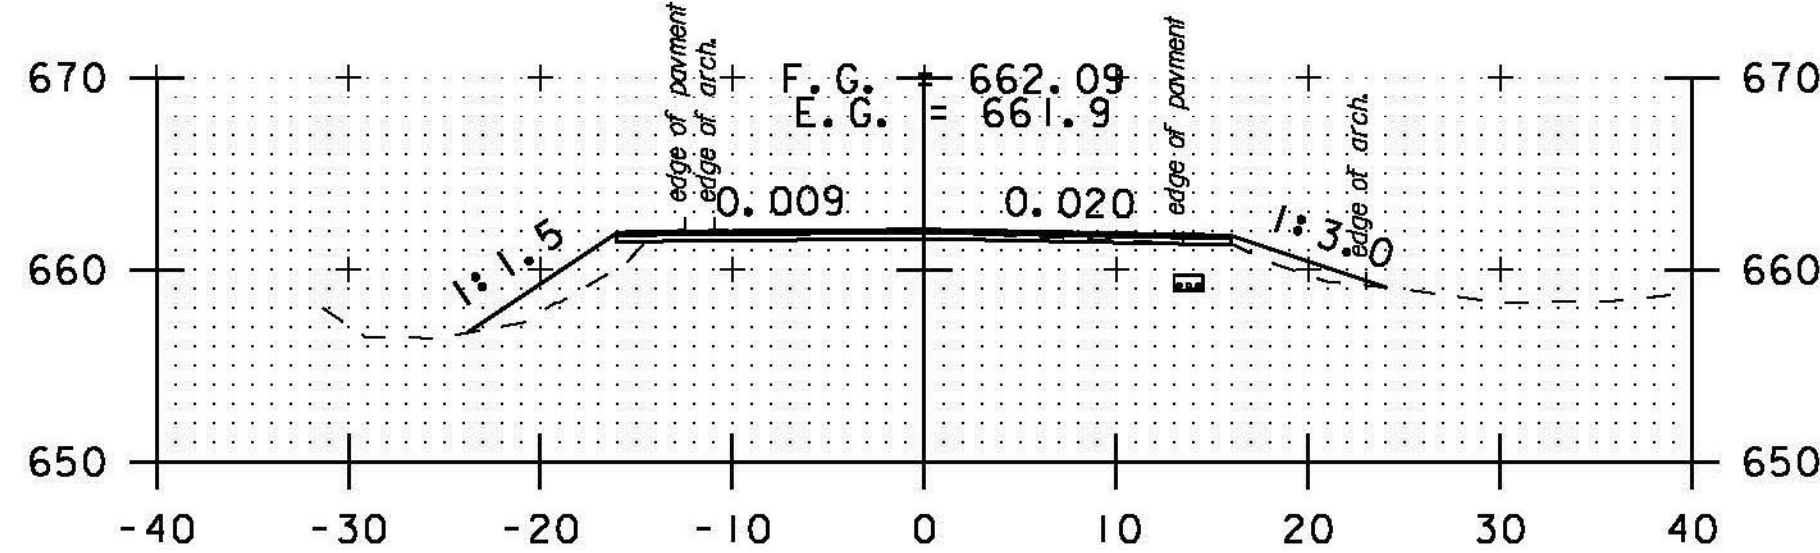


242+50

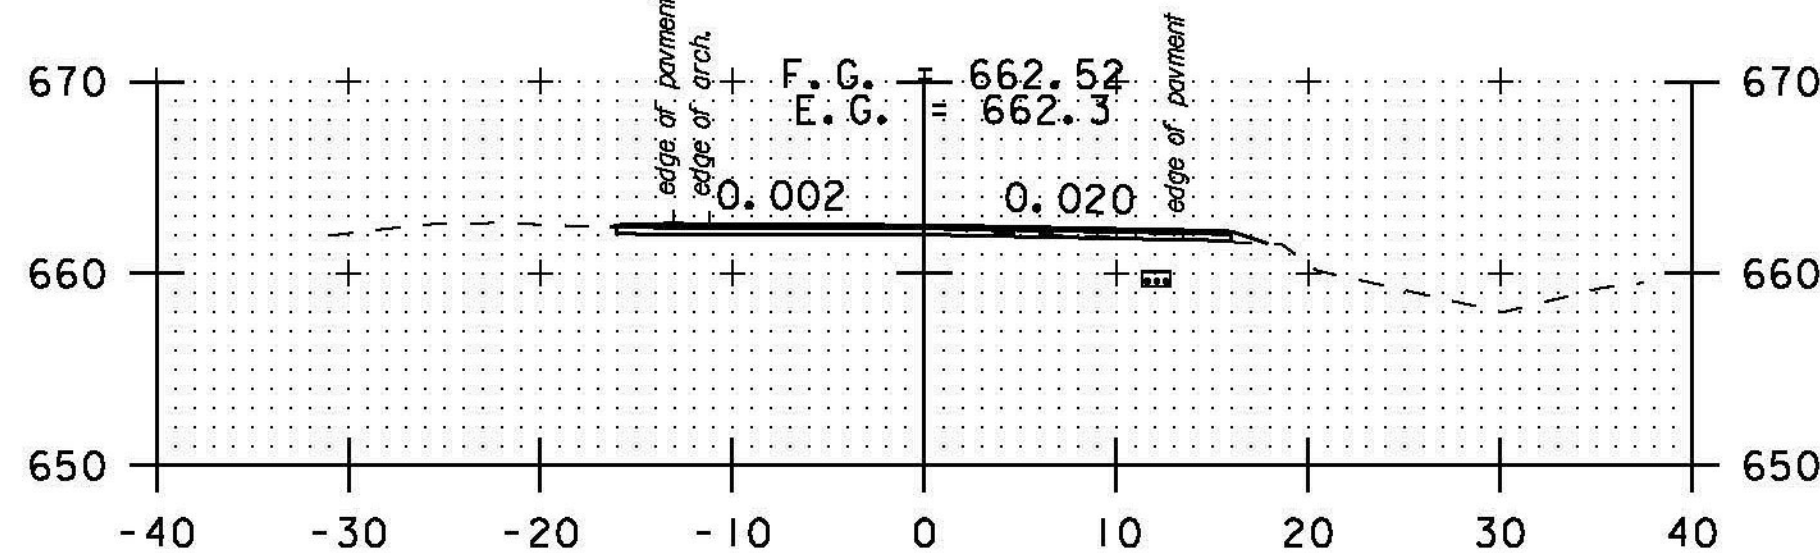


242+00

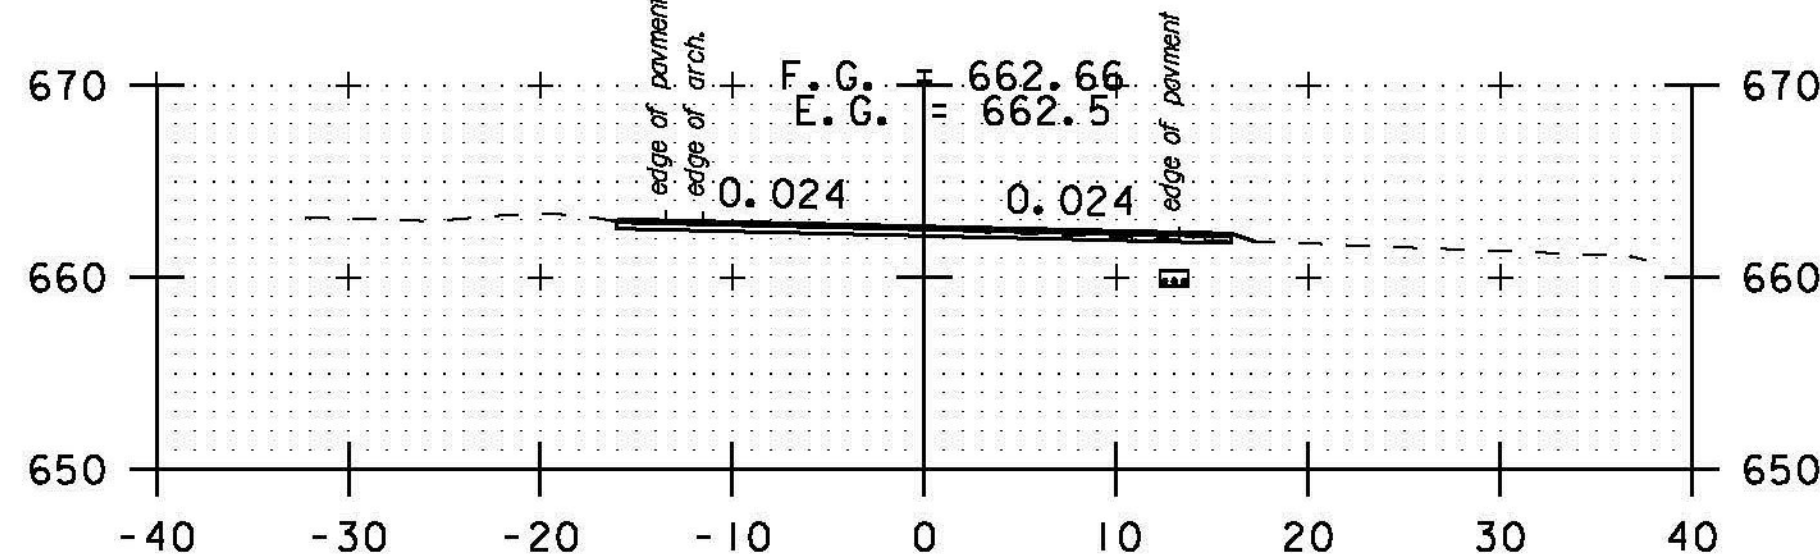


241+50

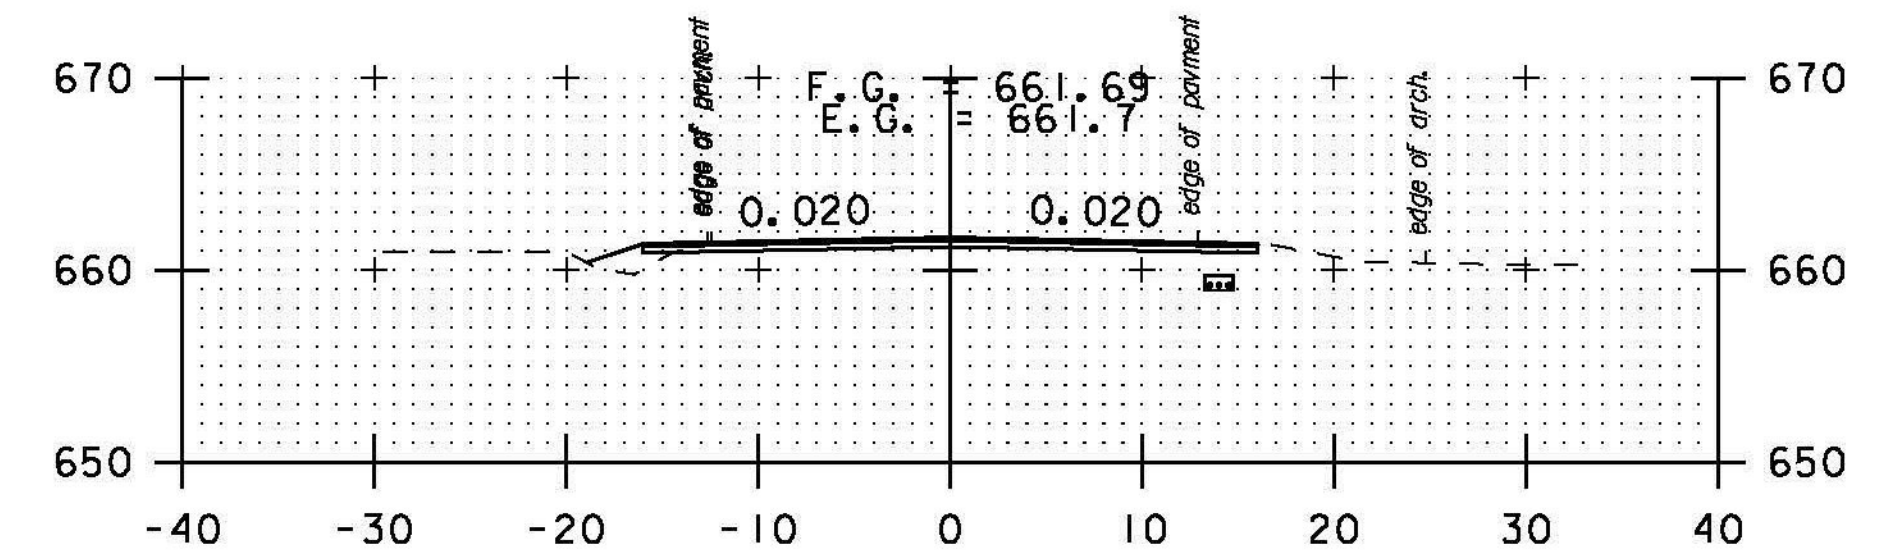


245+00

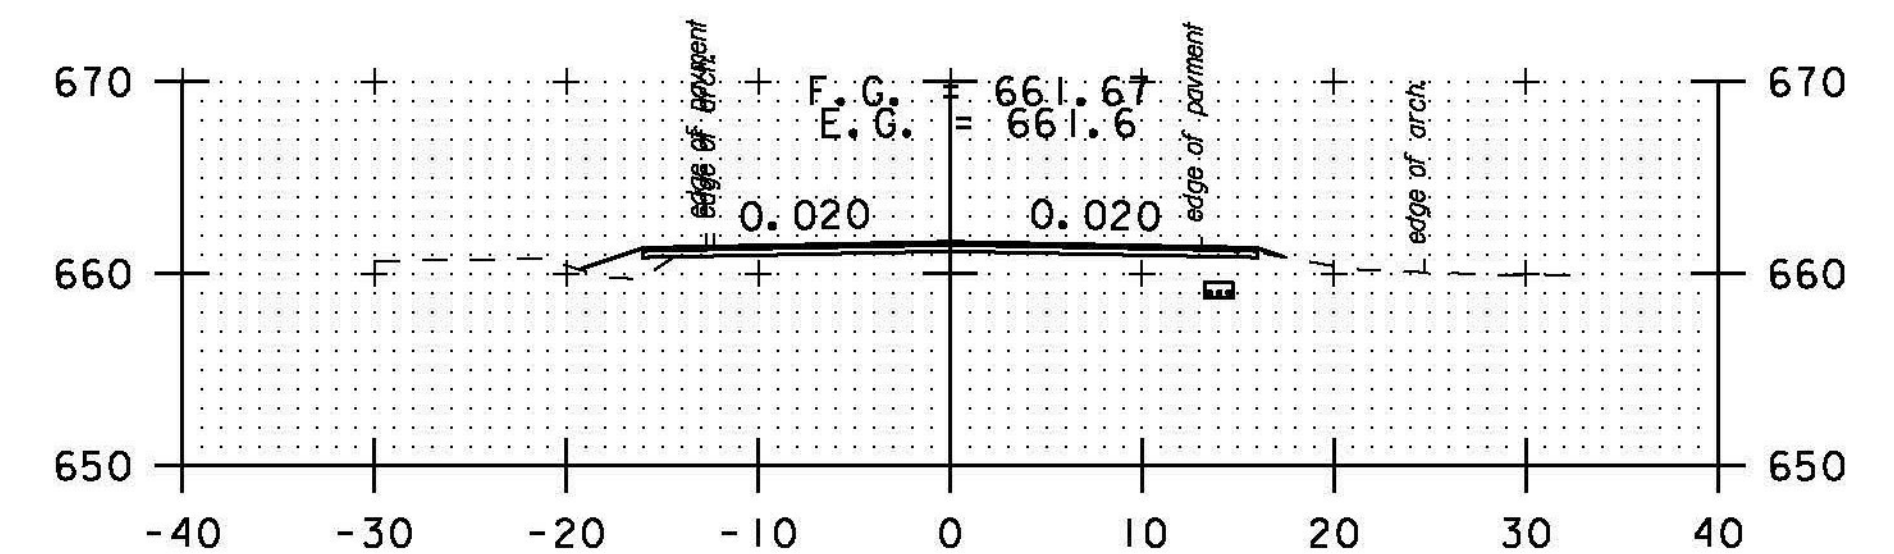

244+50

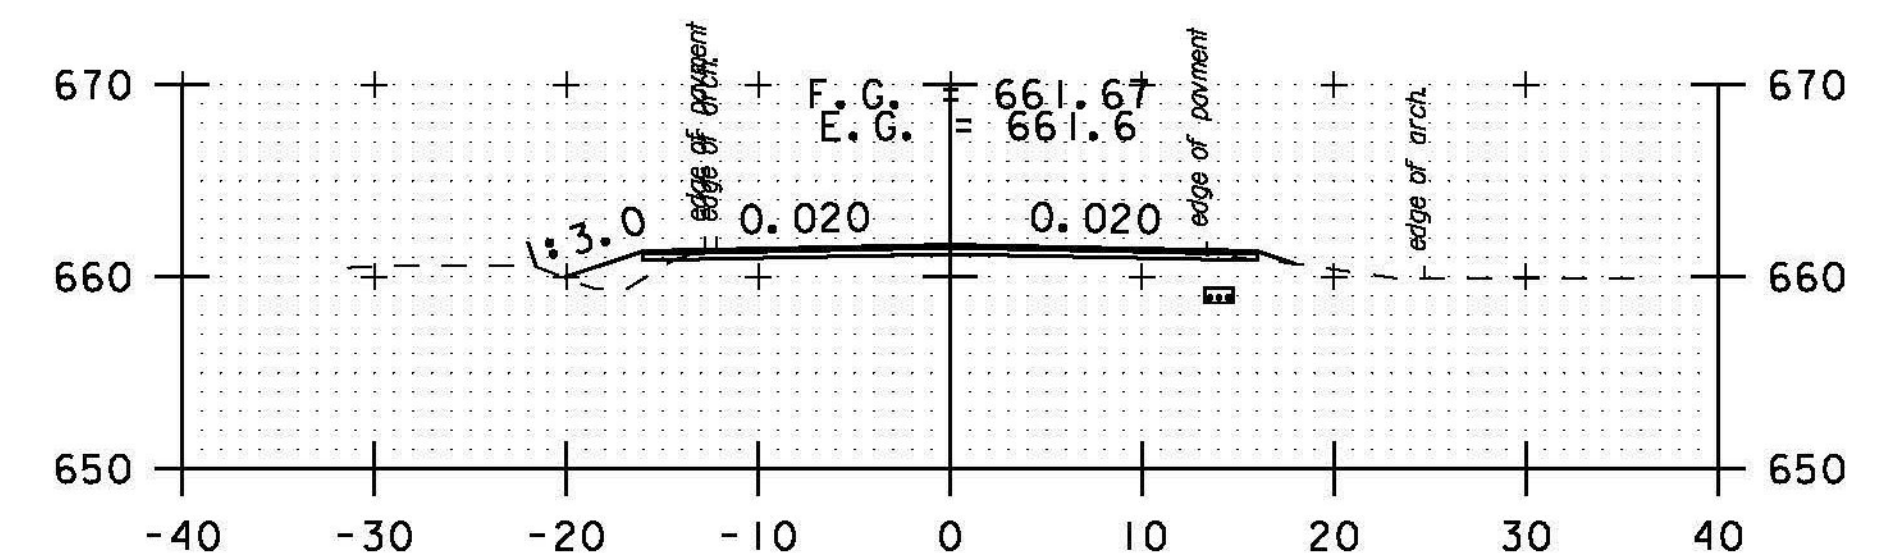


244+00

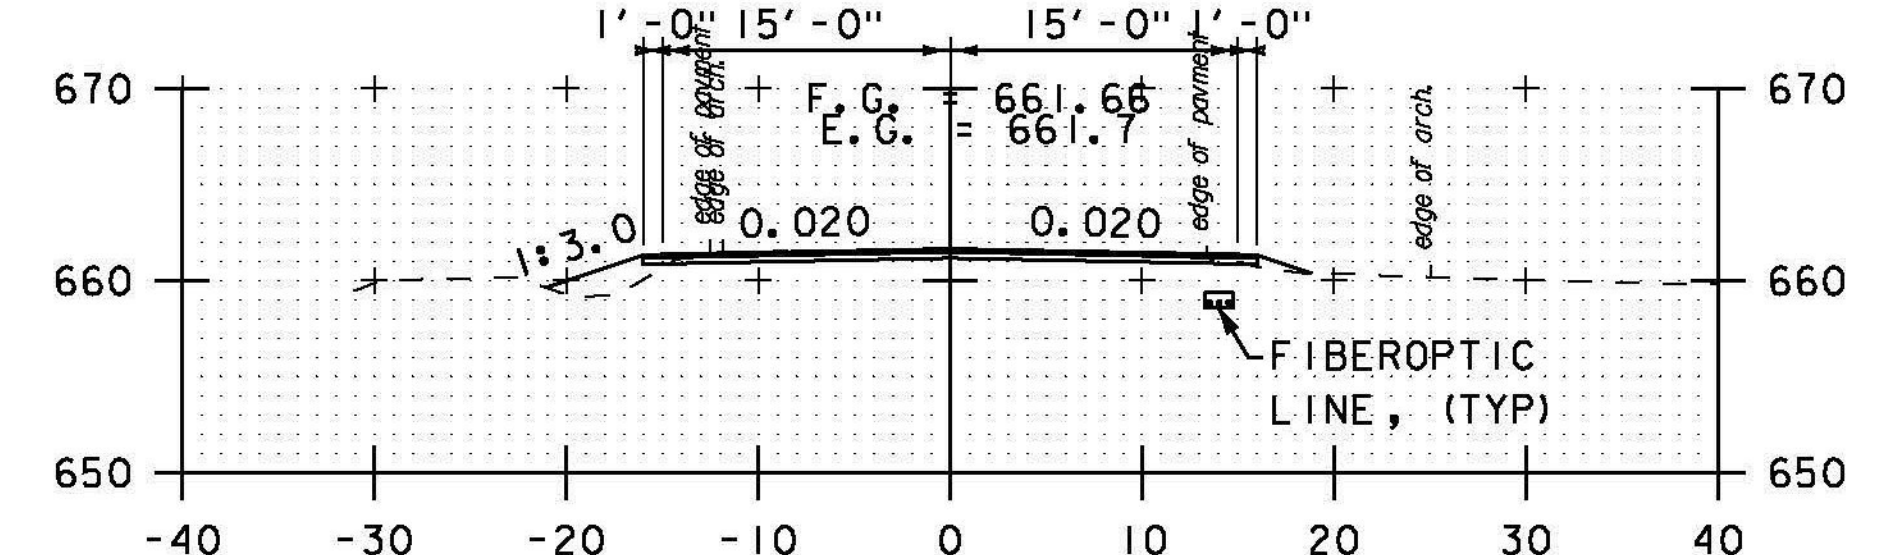

243+50

STA. 239+50 TO STA. 245+00

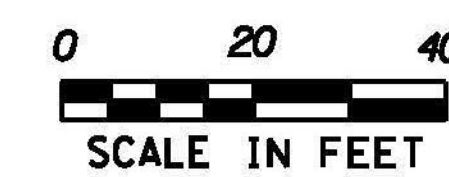

PROJECT NAME: BETHEL-RANDOLPH  
PROJECT NUMBER: STP 292(K)

FILE NAME: piOC244.dgn  
PROJECT LEADER: C. LATHROP  
DESIGNED BY: S. LAMPHERE  
CROSS SECTION SHEET 24

PLOT DATE: 4/23/2015  
DRAWN BY: S. LAMPHERE  
CHECKED BY: C. LATHROP  
SHEET 158 OF 211