



DRIVE LT & RT


247+00

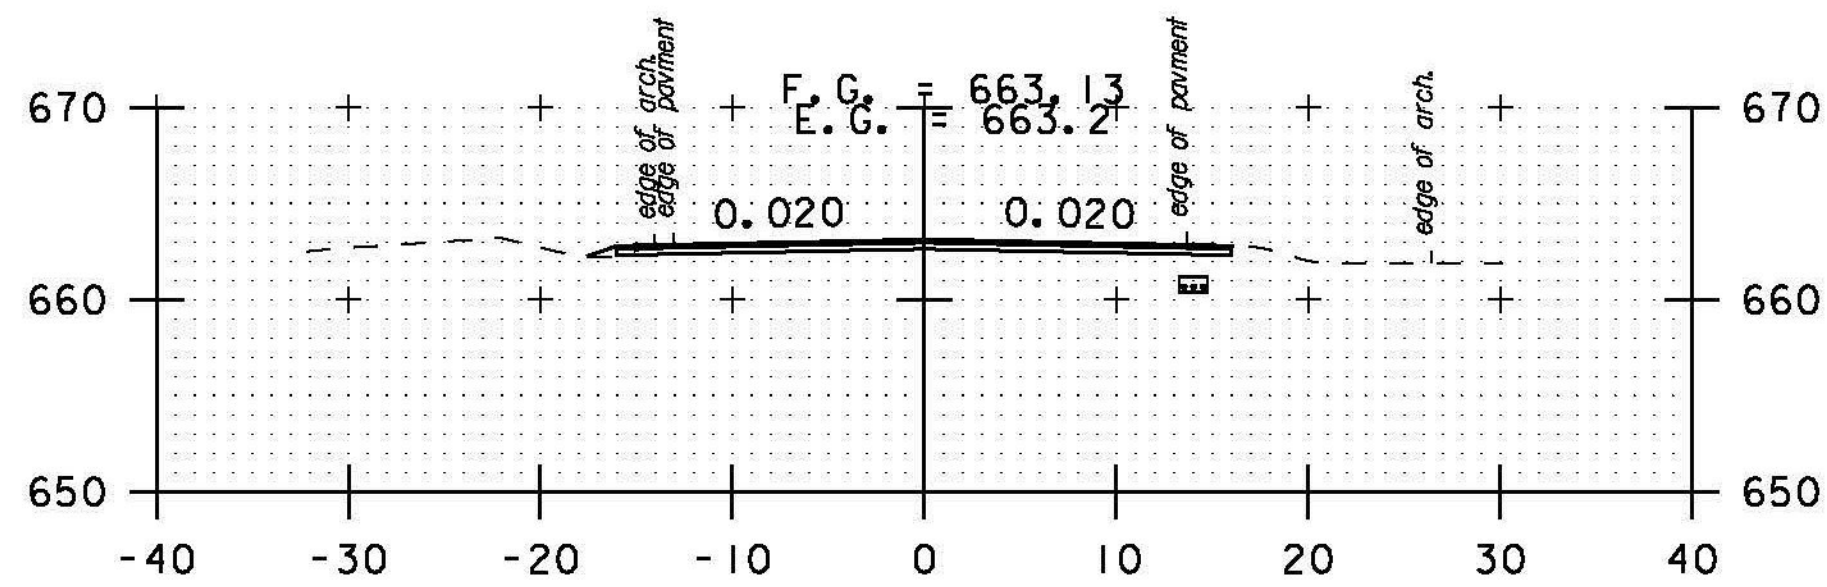


249+00

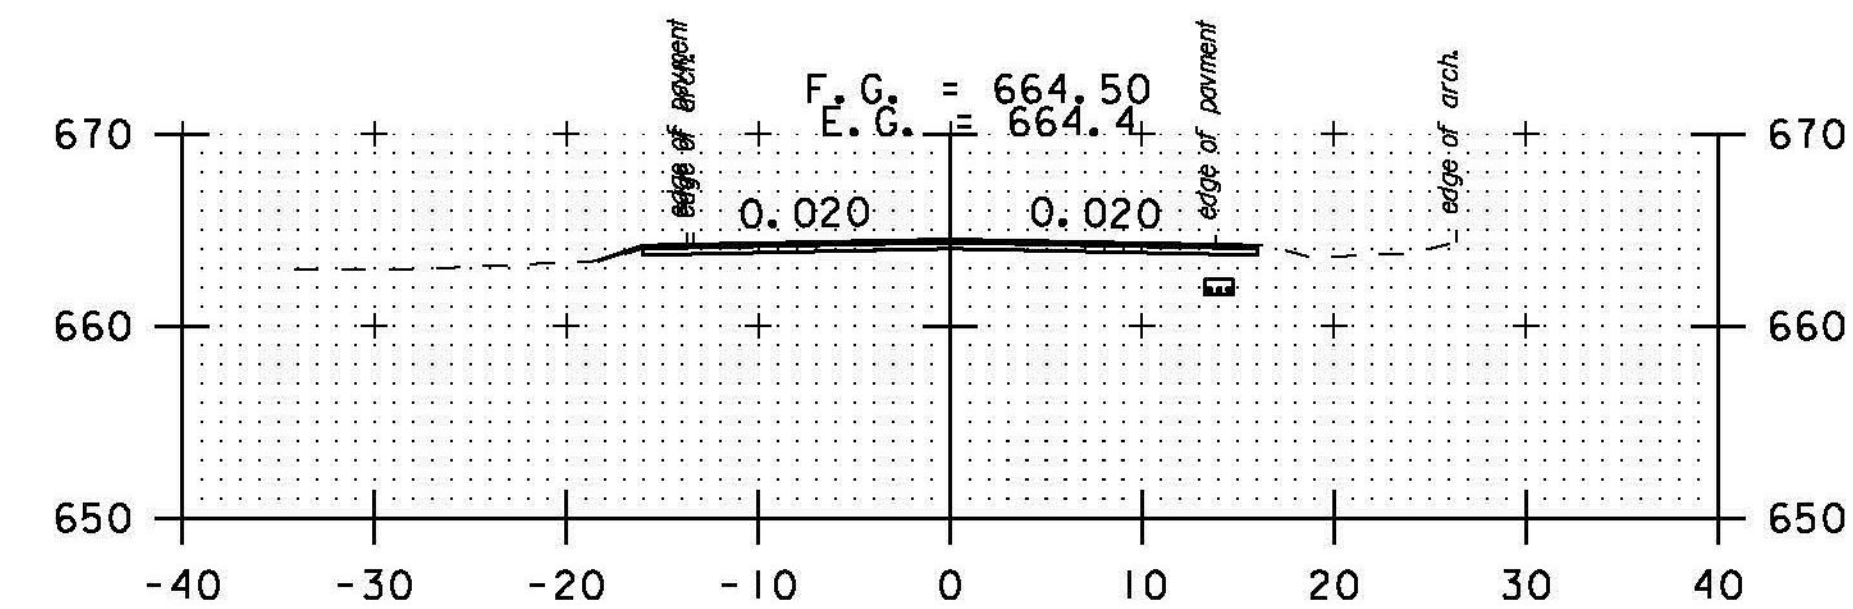


251+00

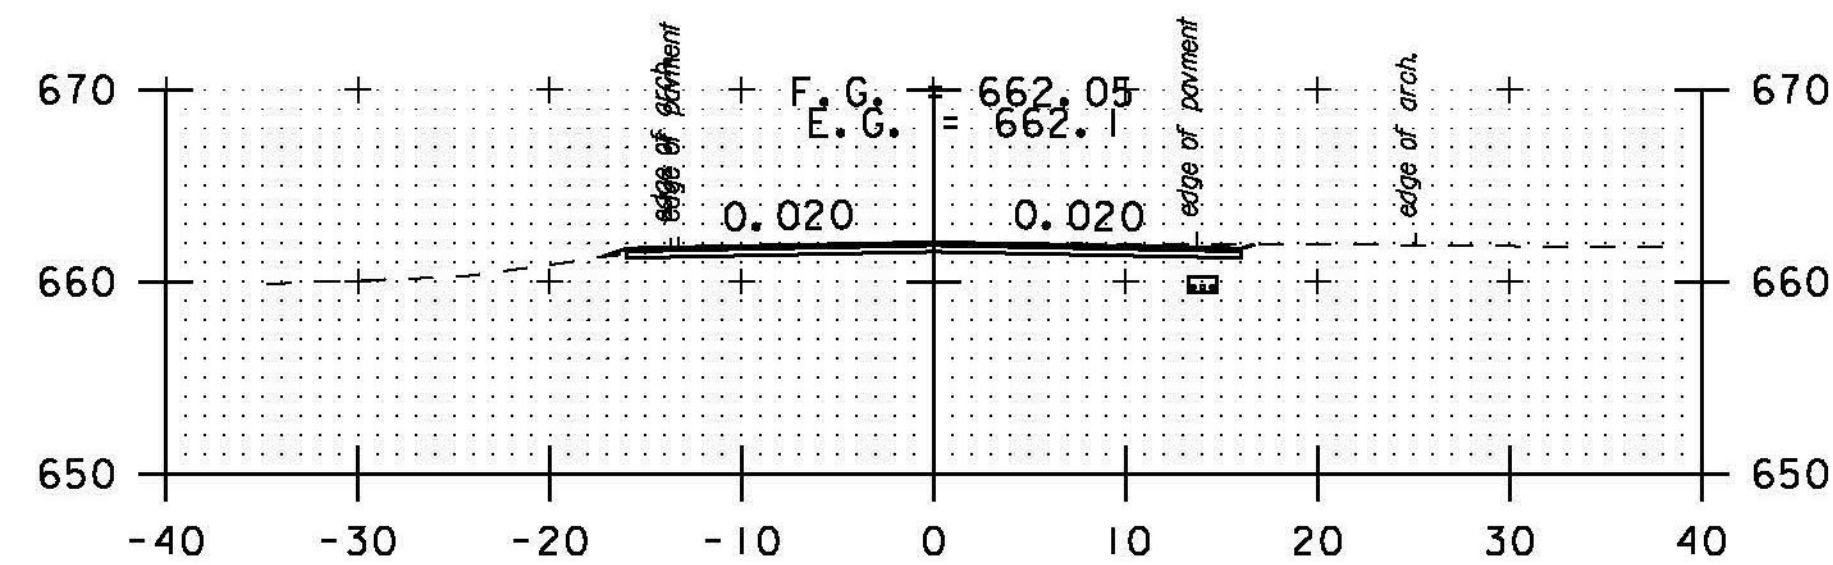


246+50

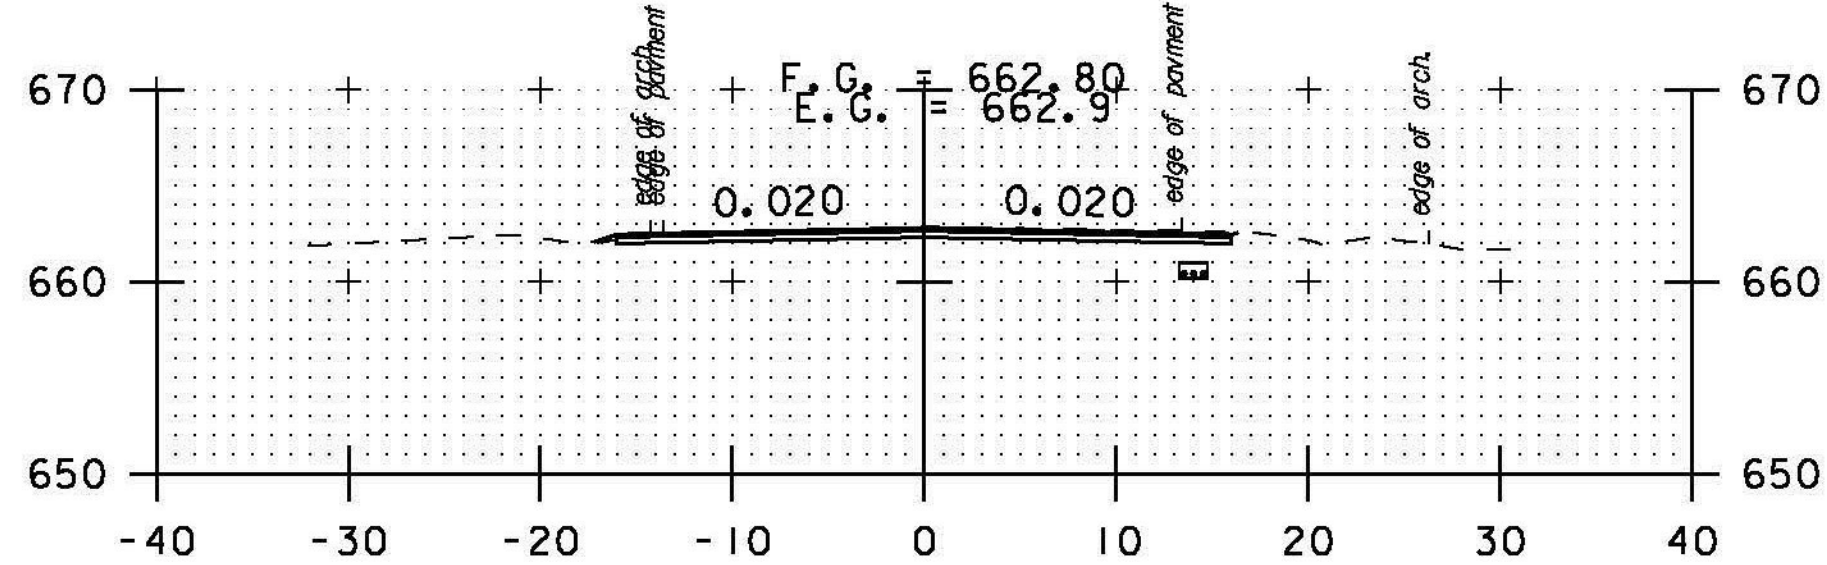


248+50

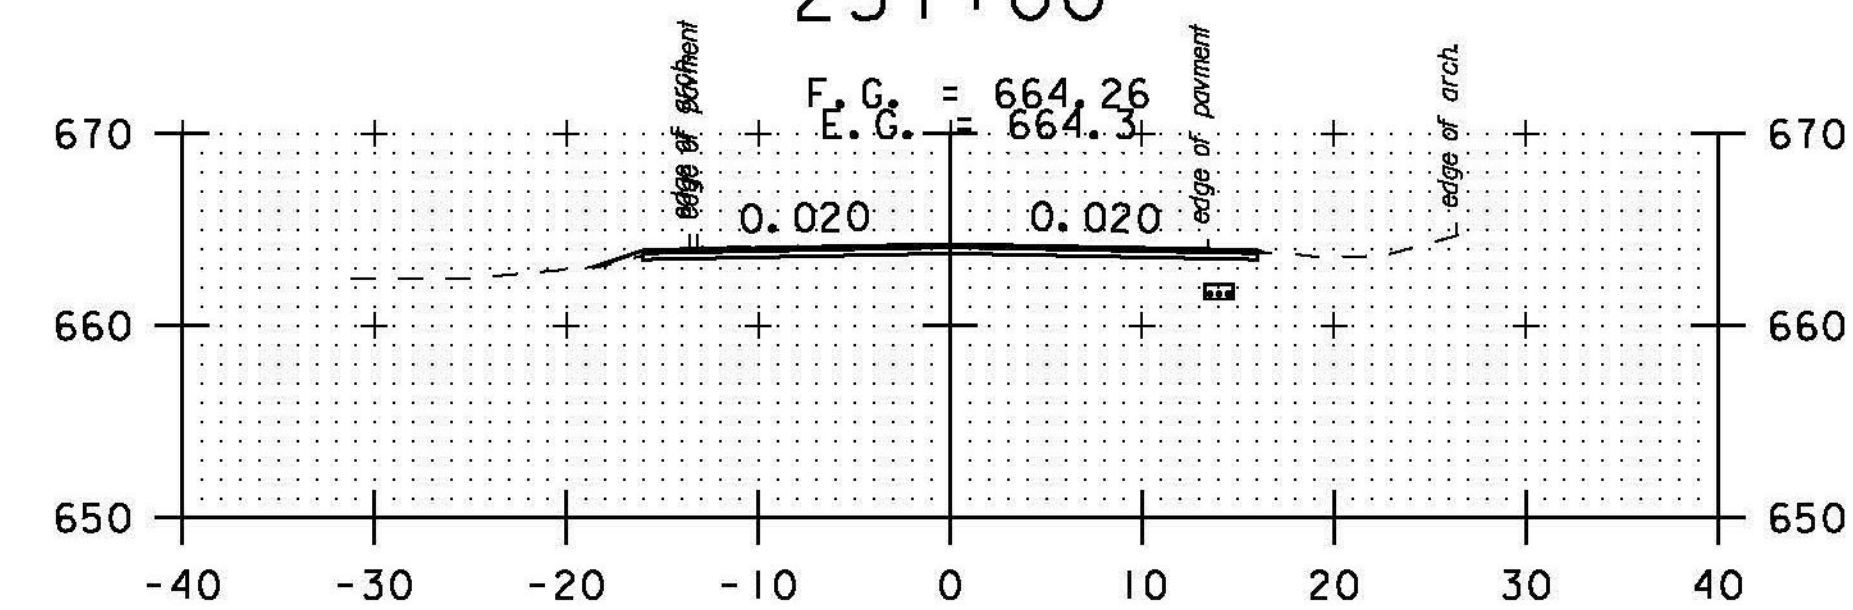


250+50

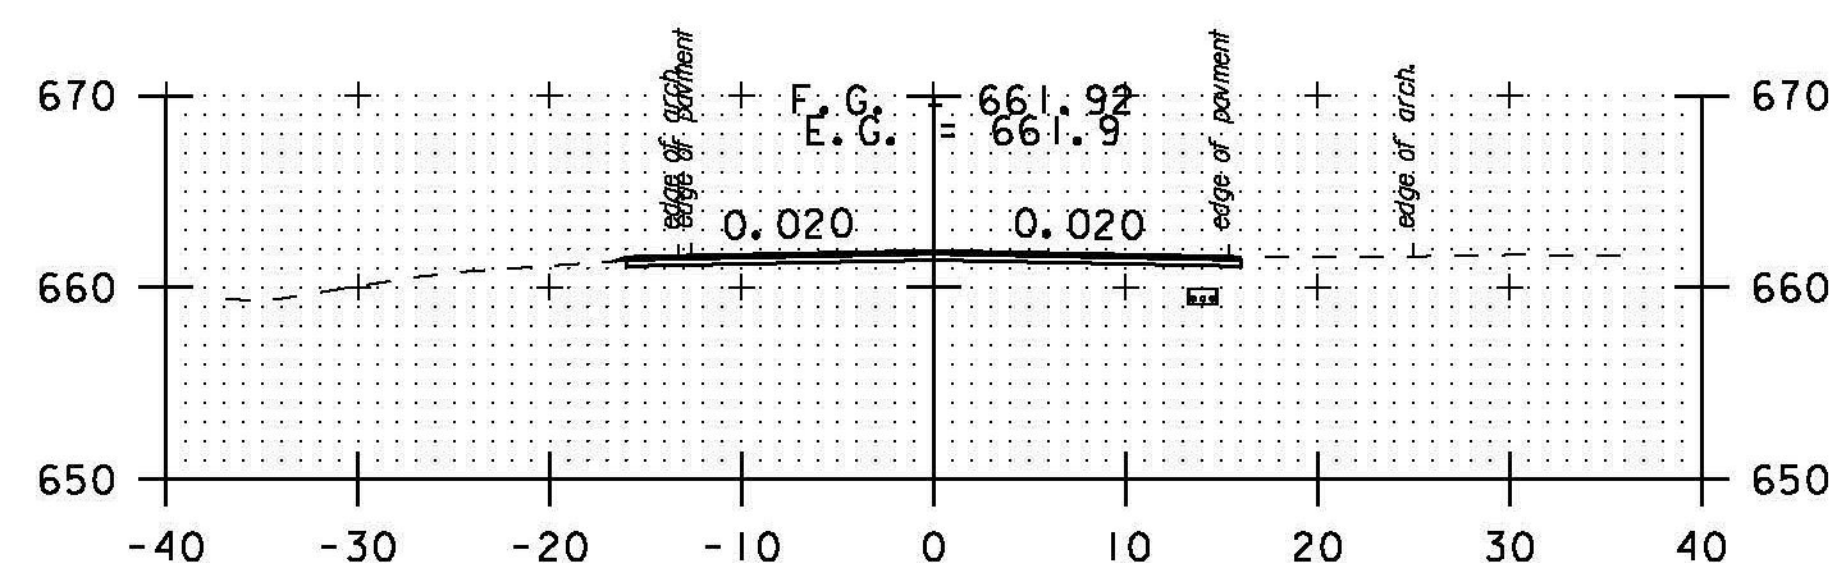


246+00

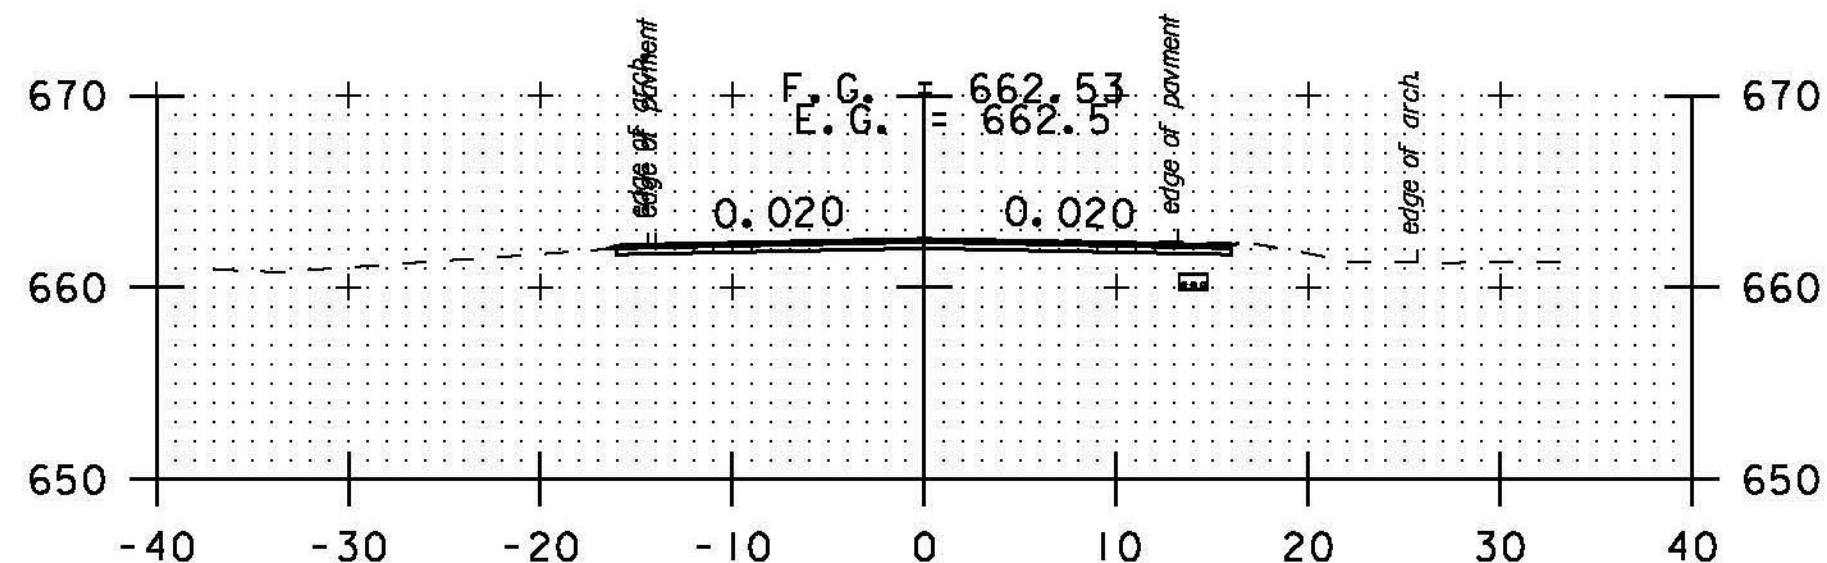


248+00

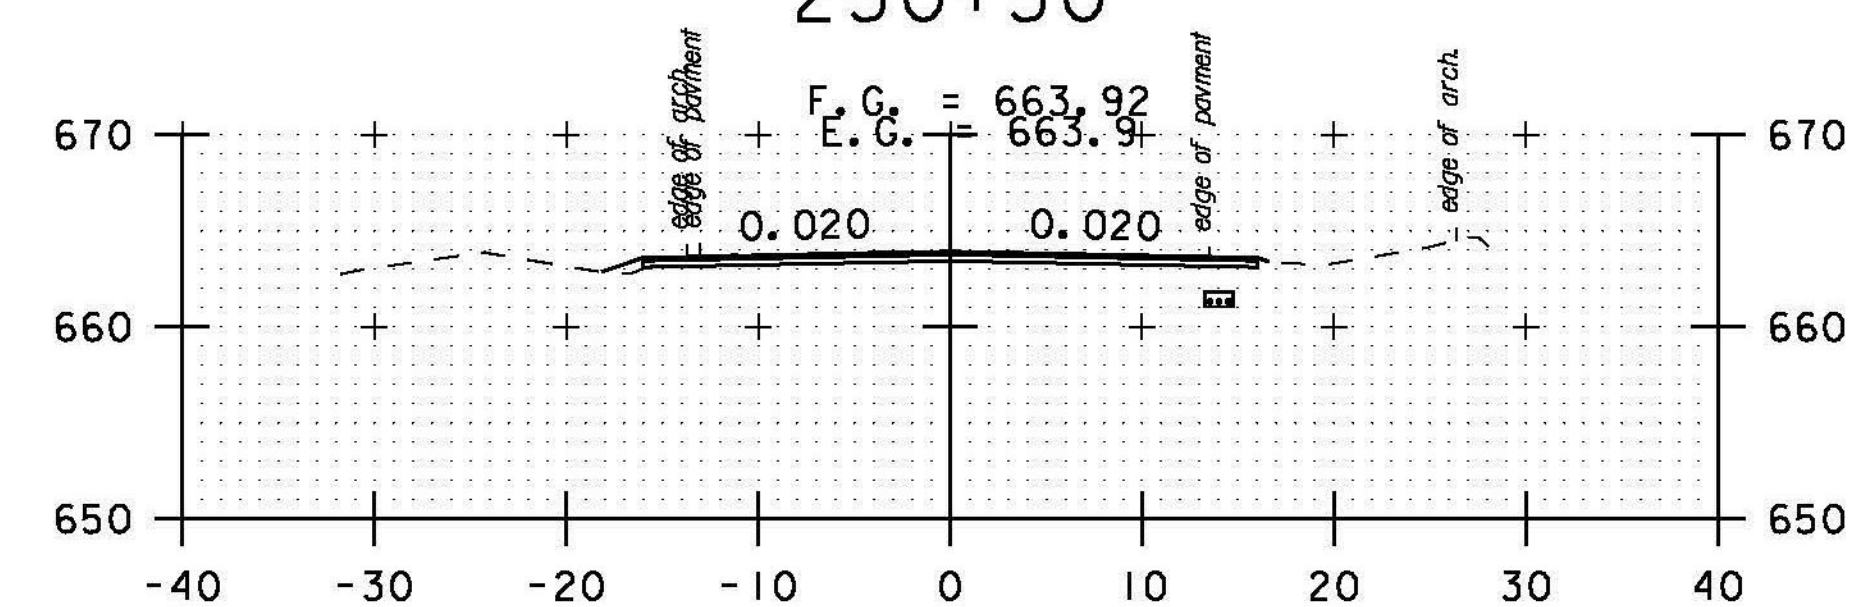


250+00

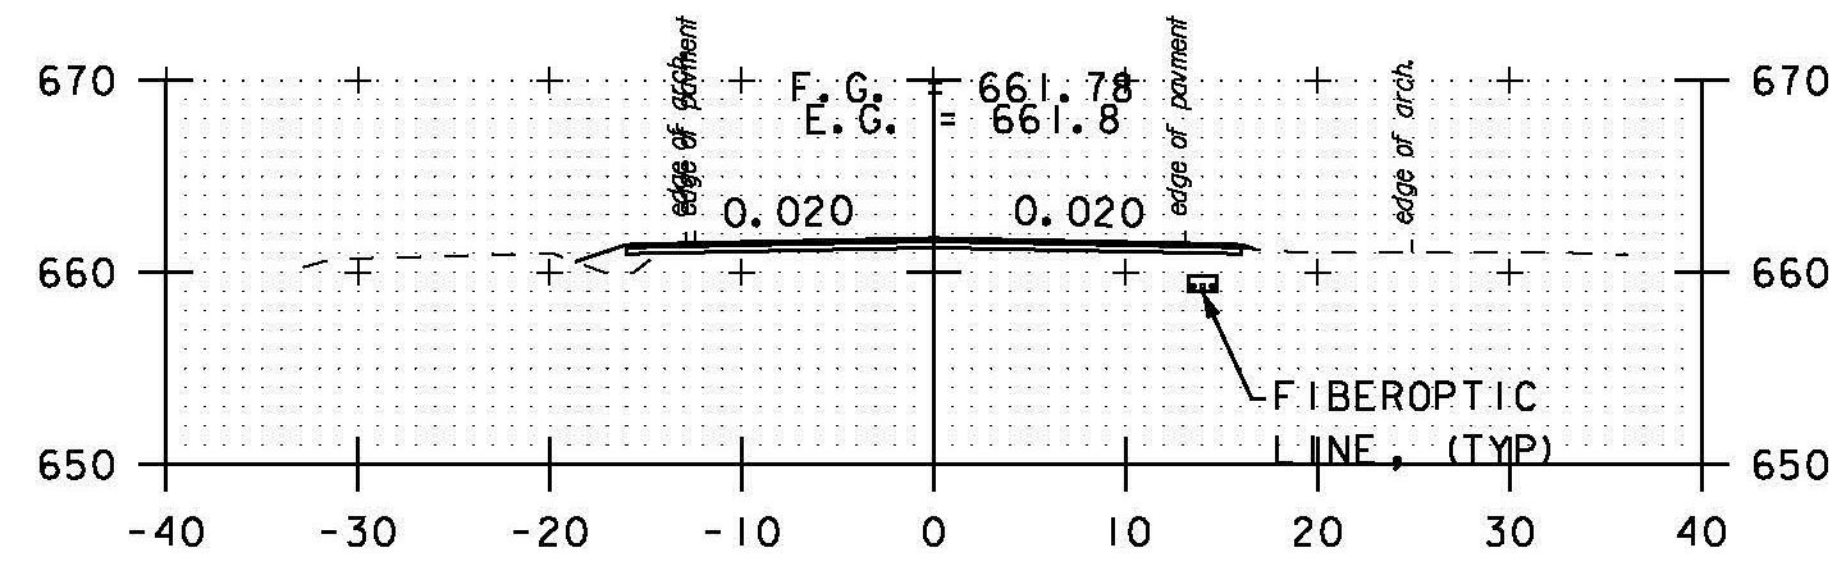


245+50

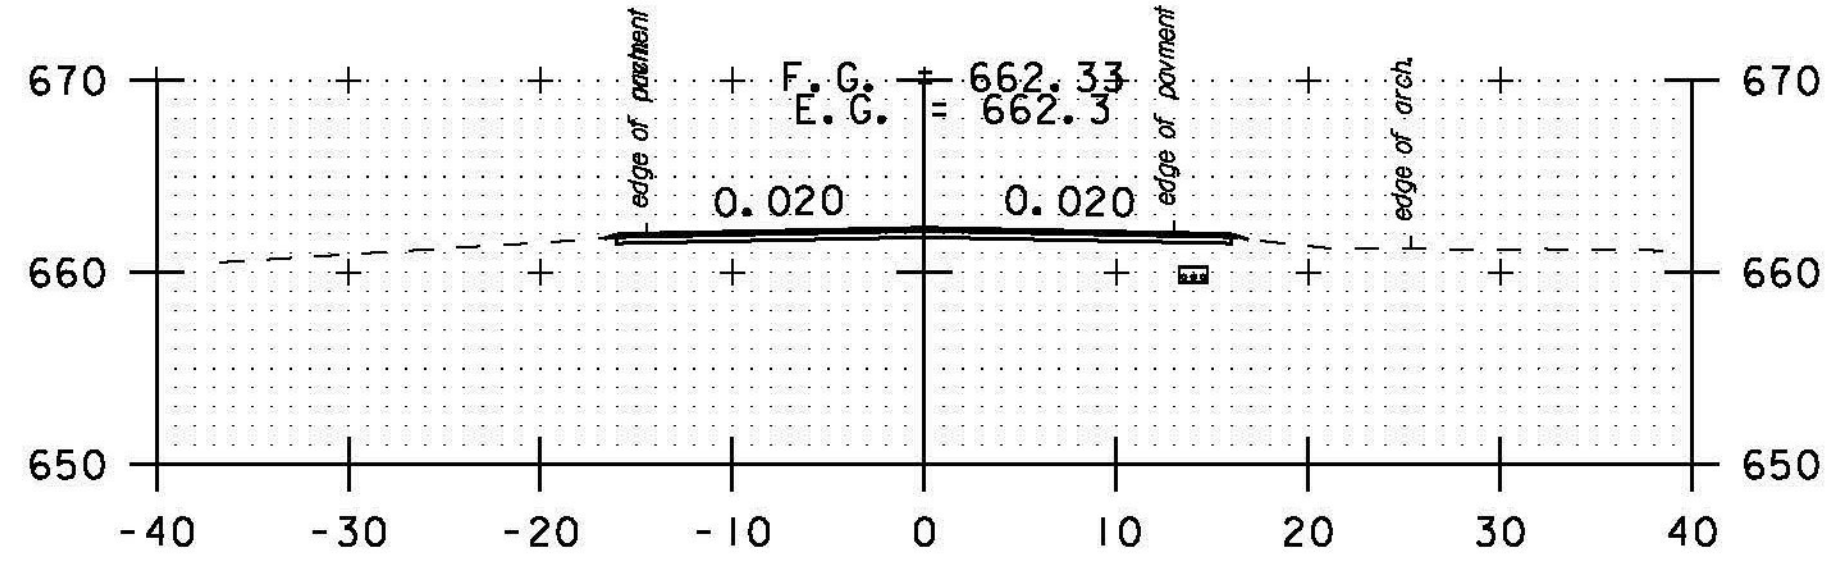

247+50

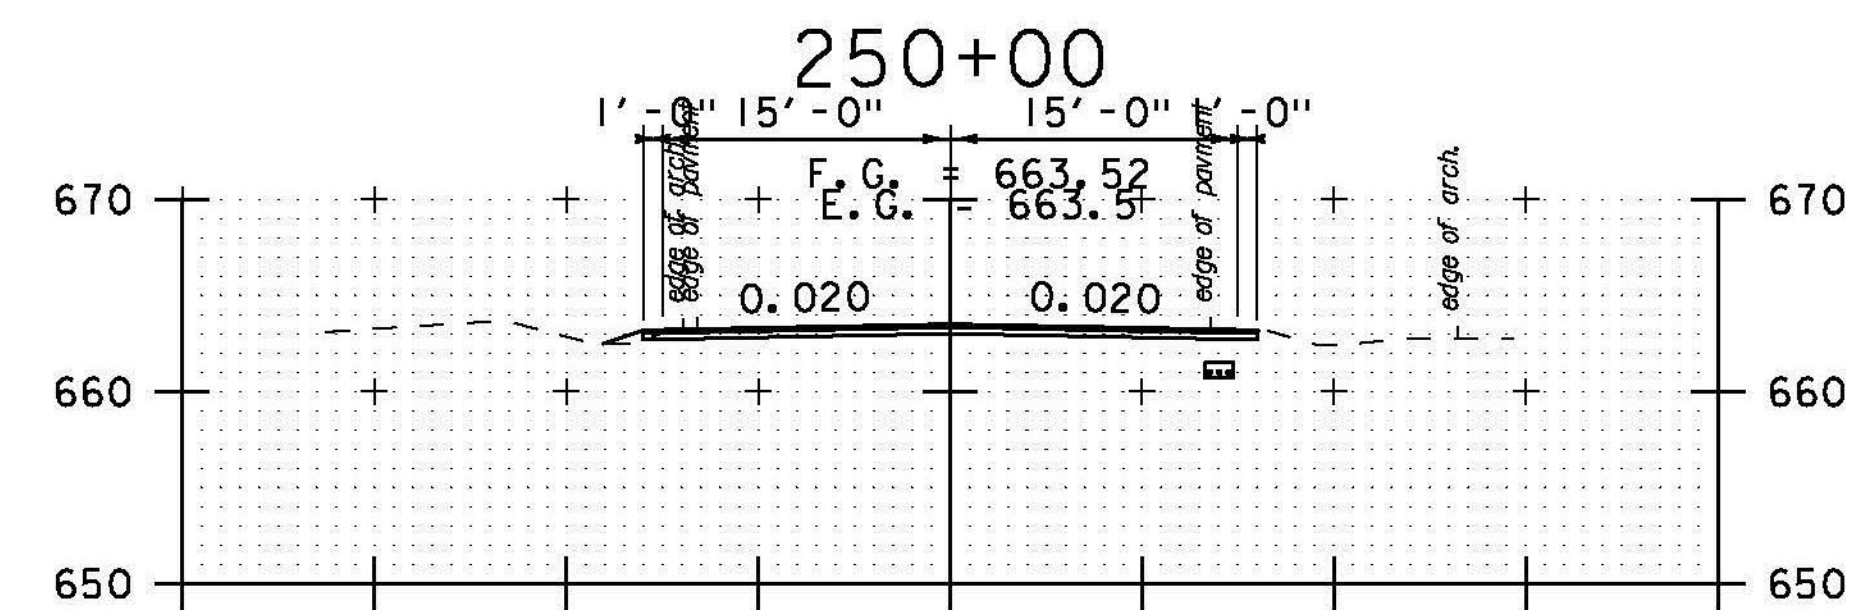

249+50

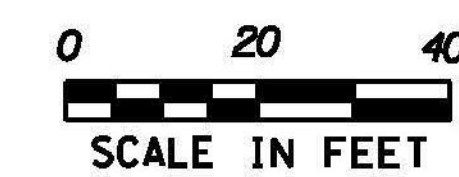

SCALE IN FEET

STA. 245+50 TO STA. 251+00

PROJECT NAME: BETHEL-RANDOLPH
PROJECT NUMBER: STP 292(K)

FILE NAME: piOC244.dgn
PROJECT LEADER: C. LATHROP
DESIGNED BY: S. LAMPHERE
CROSS SECTION SHEET 25

PLOT DATE: 4/23/2015
DRAWN BY: S. LAMPHERE
CHECKED BY: C. LATHROP
SHEET 159 OF 211