




253+00

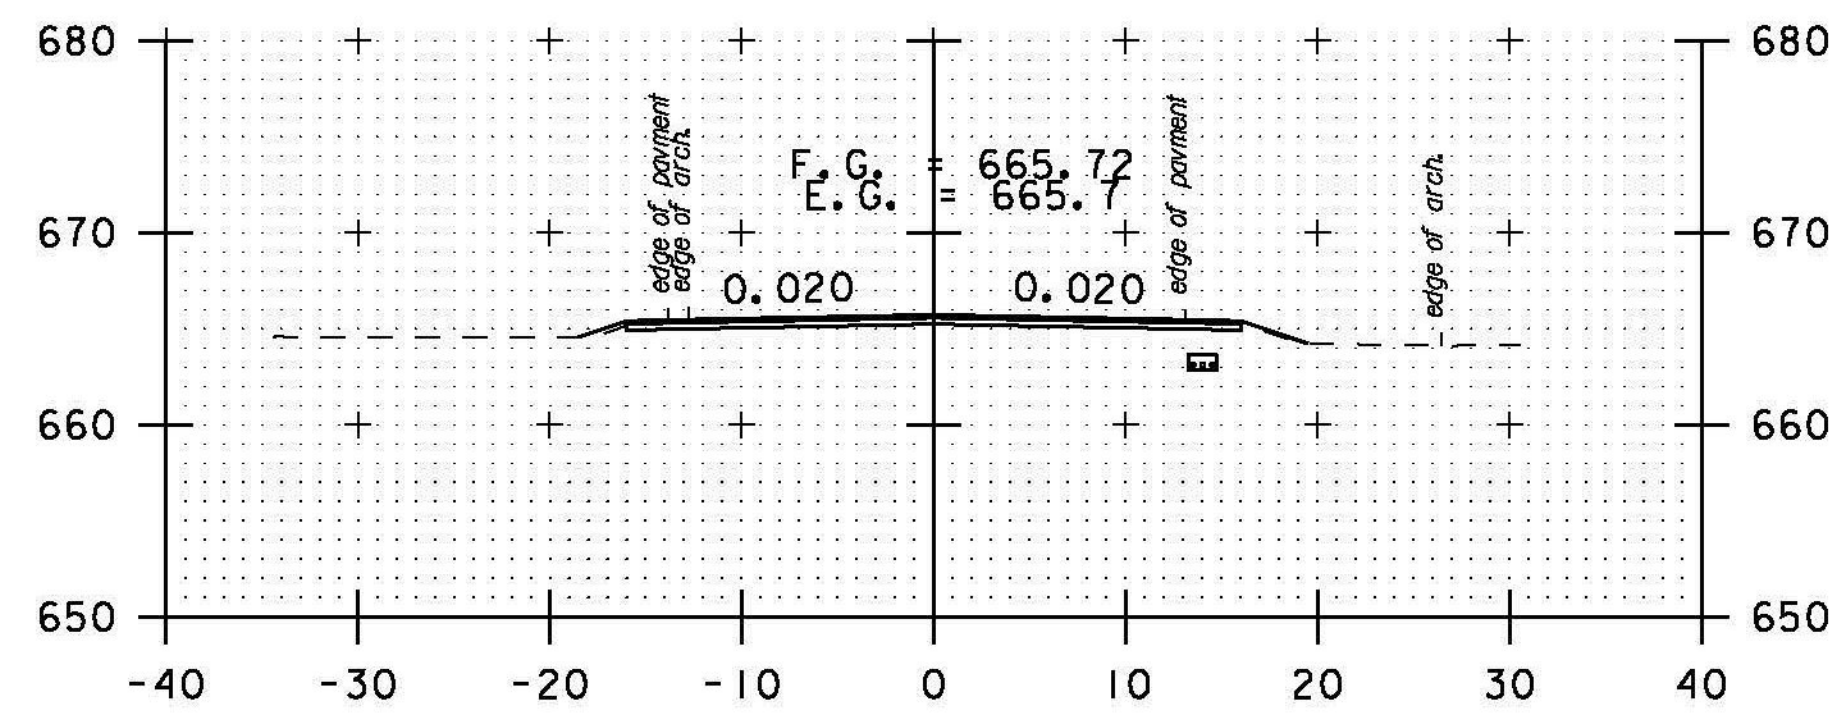


252+50

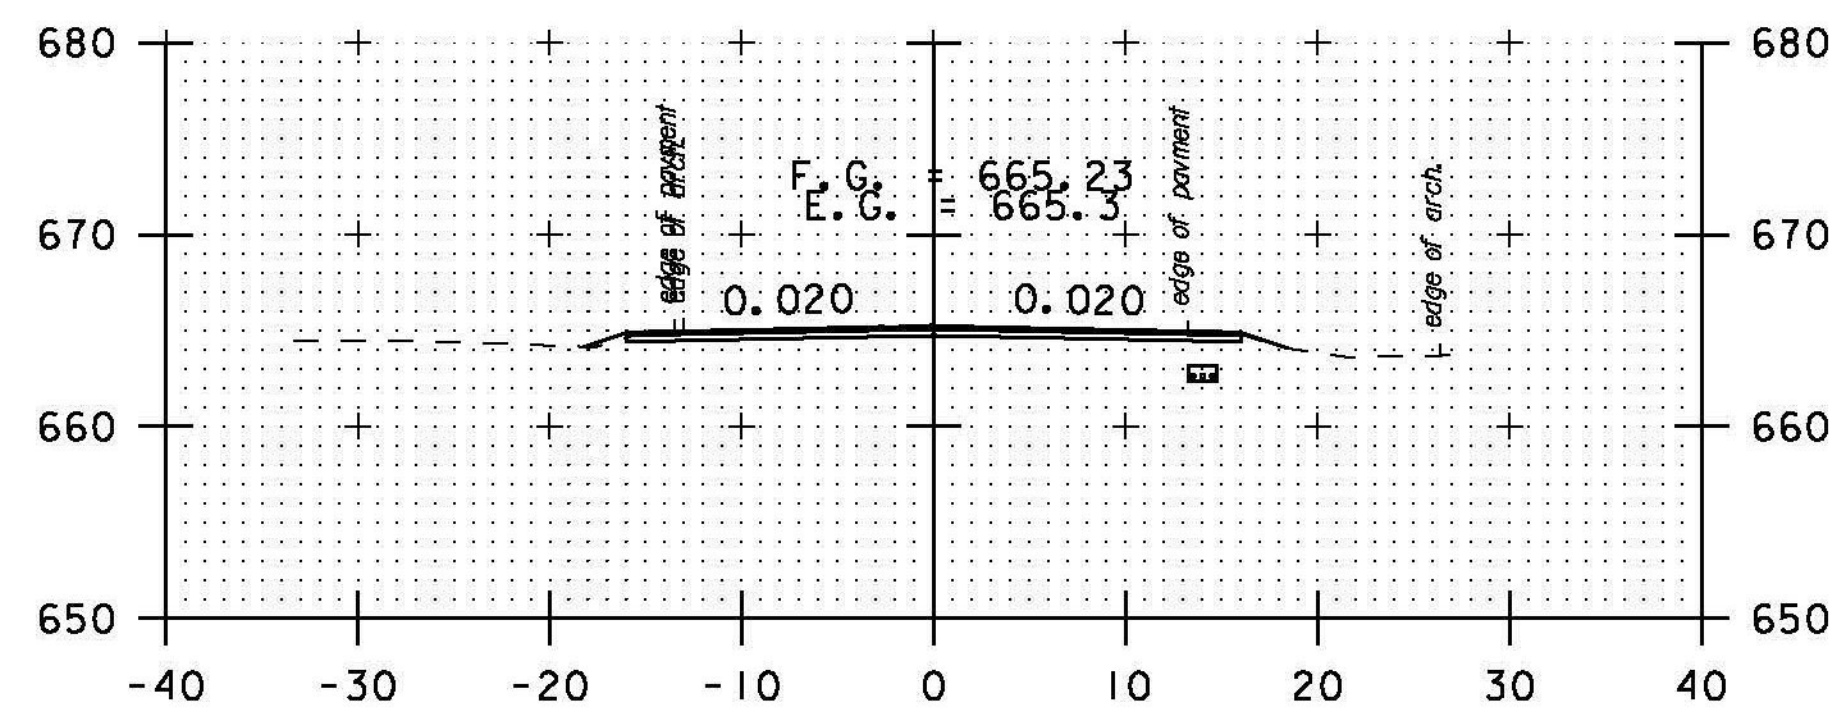


252+00

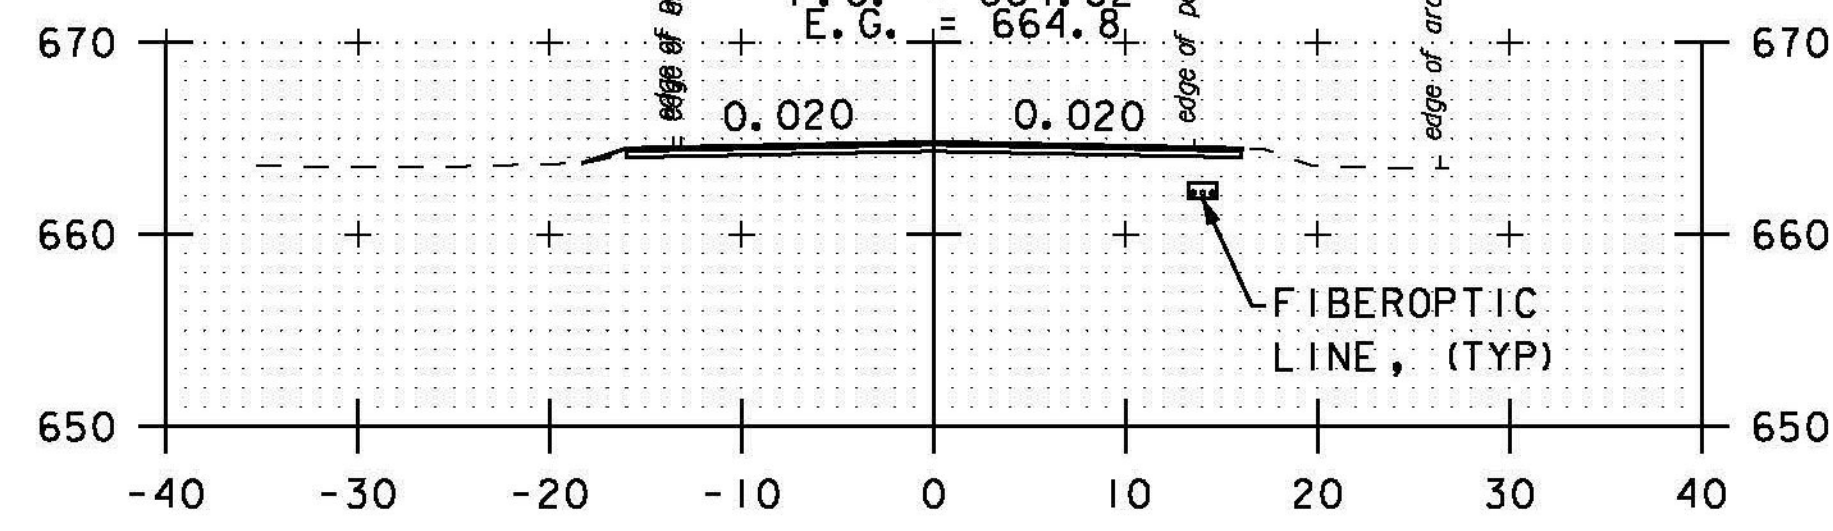


251+50

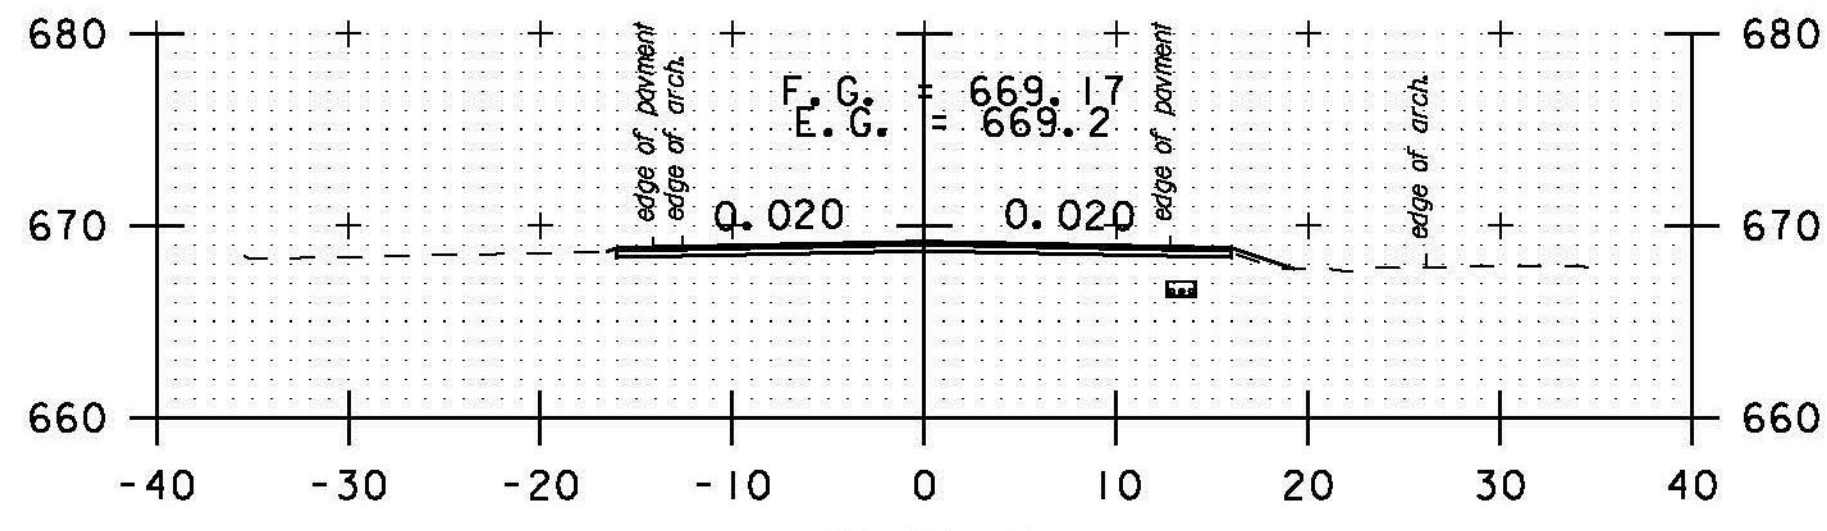


255+00

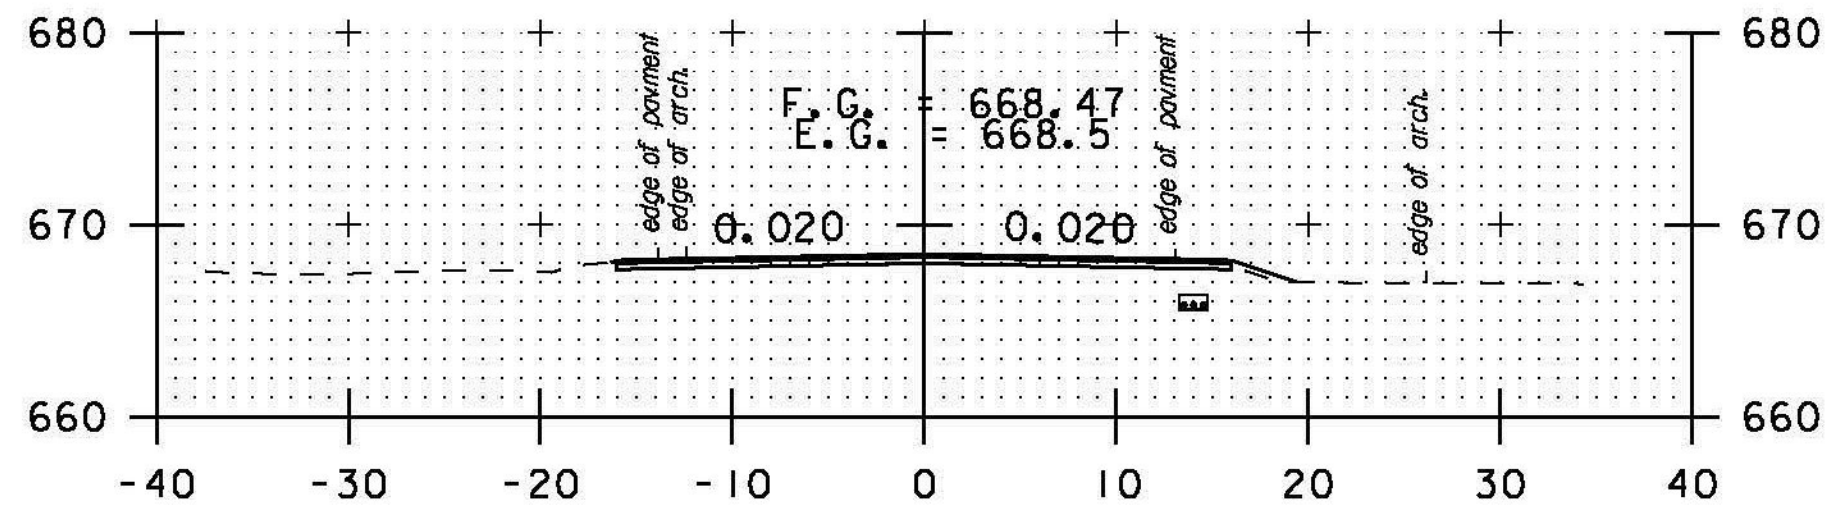


254+50

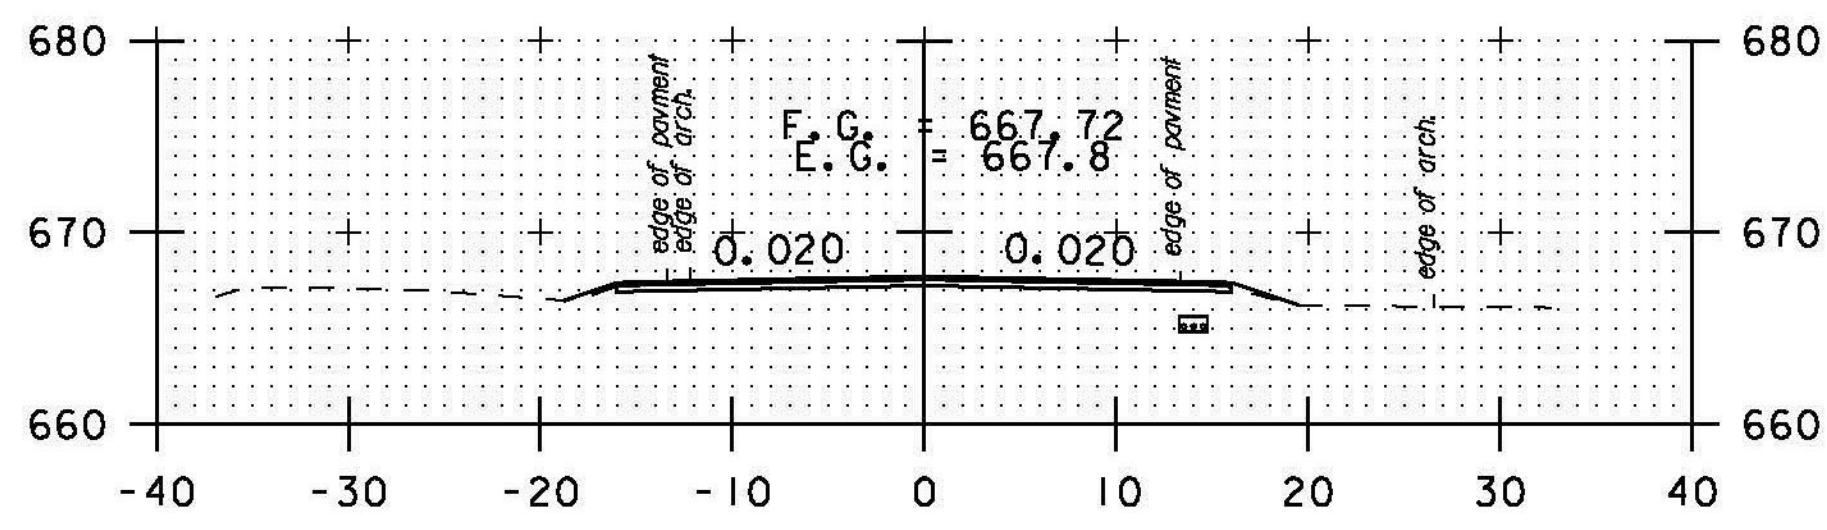


254+00

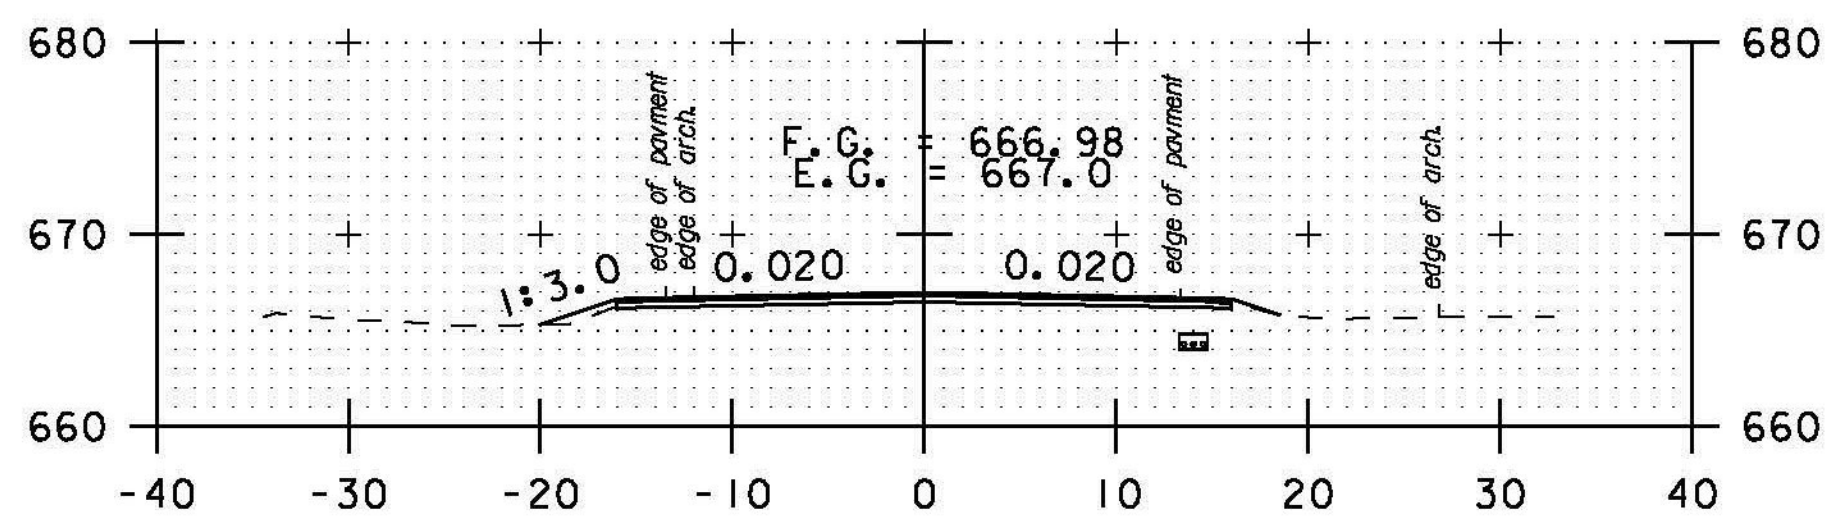


253+50

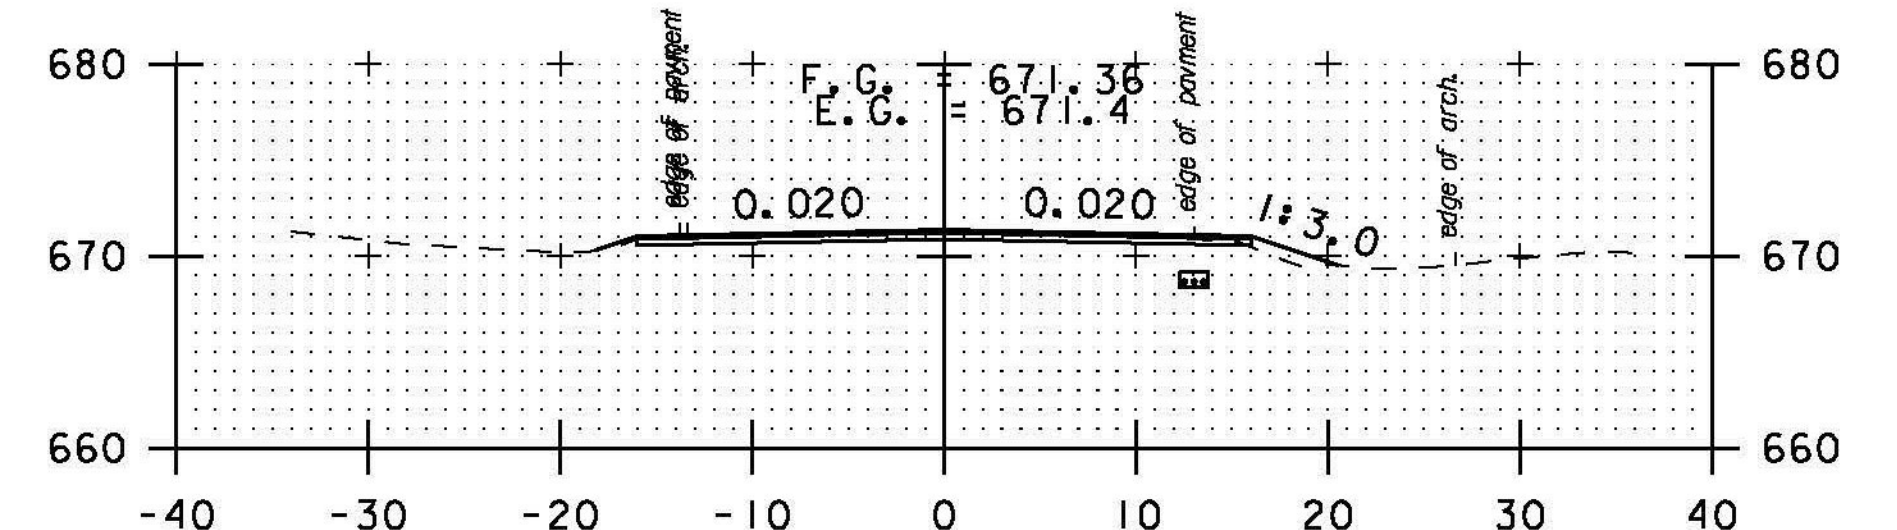


257+00

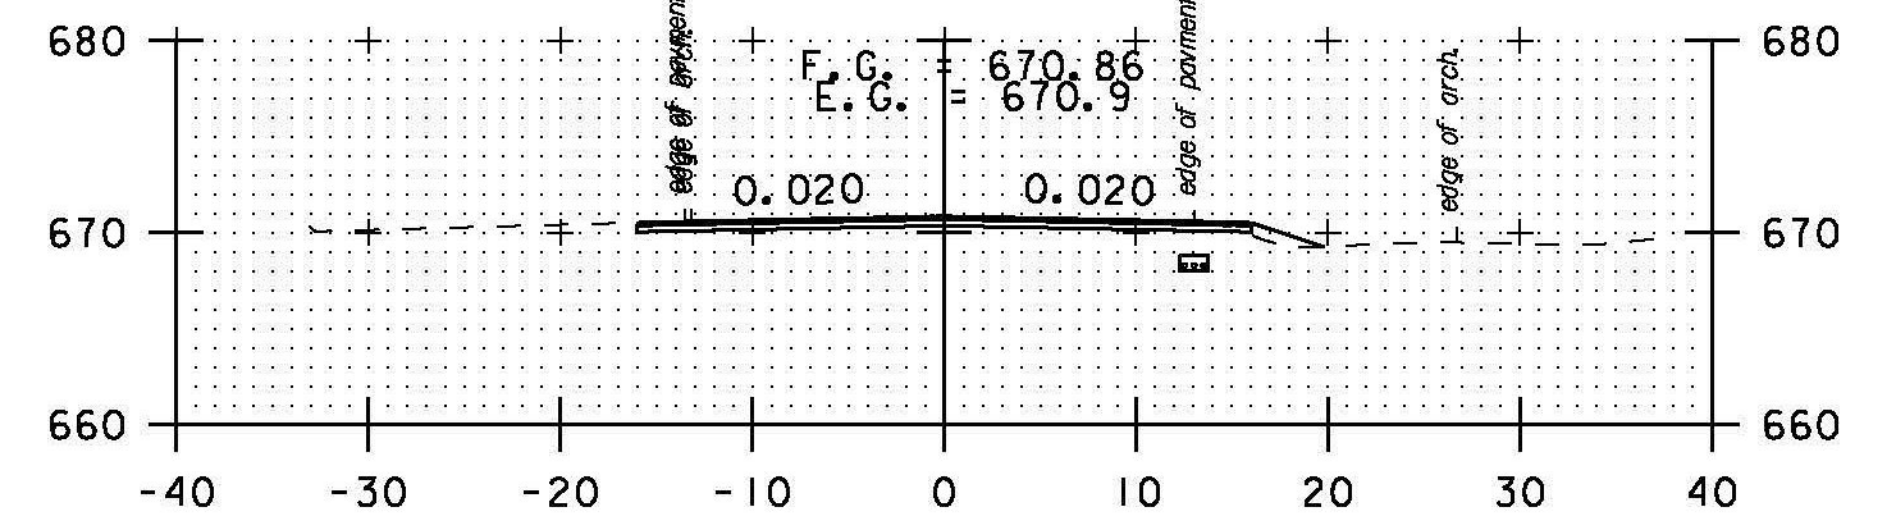

256+50

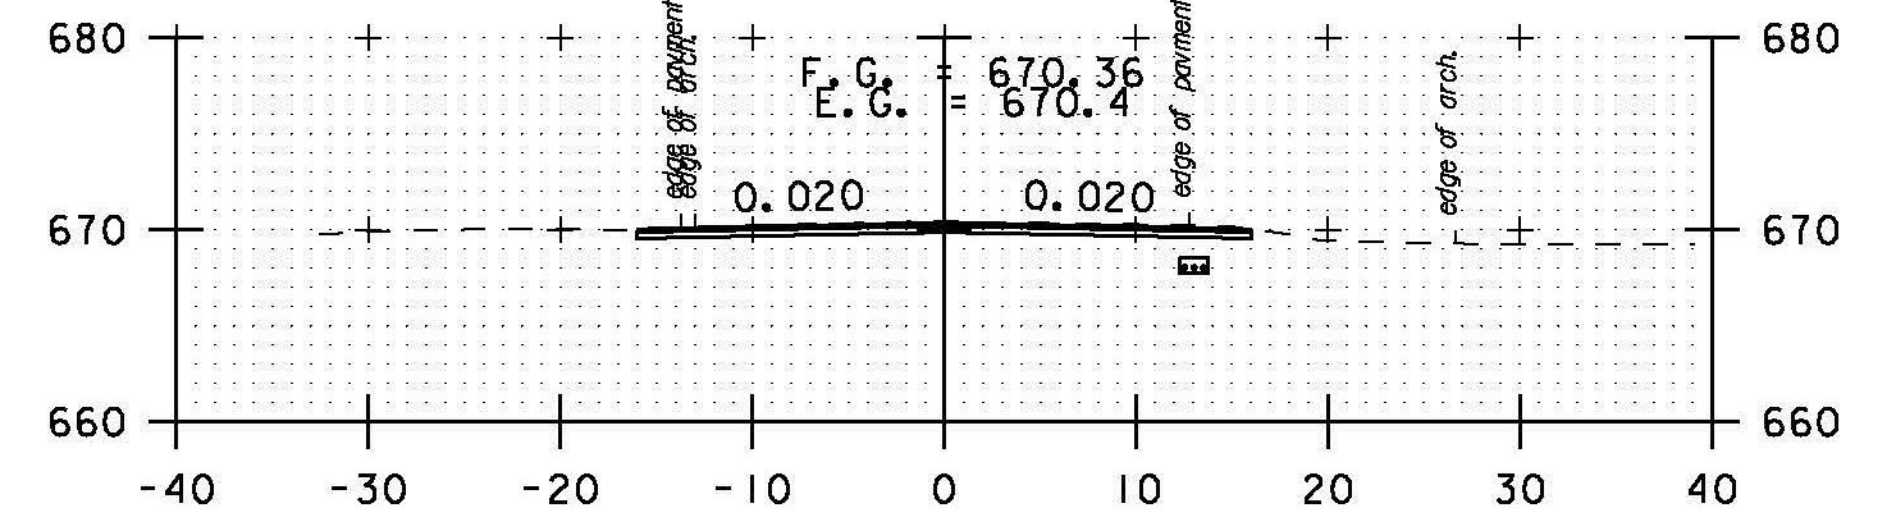


256+00

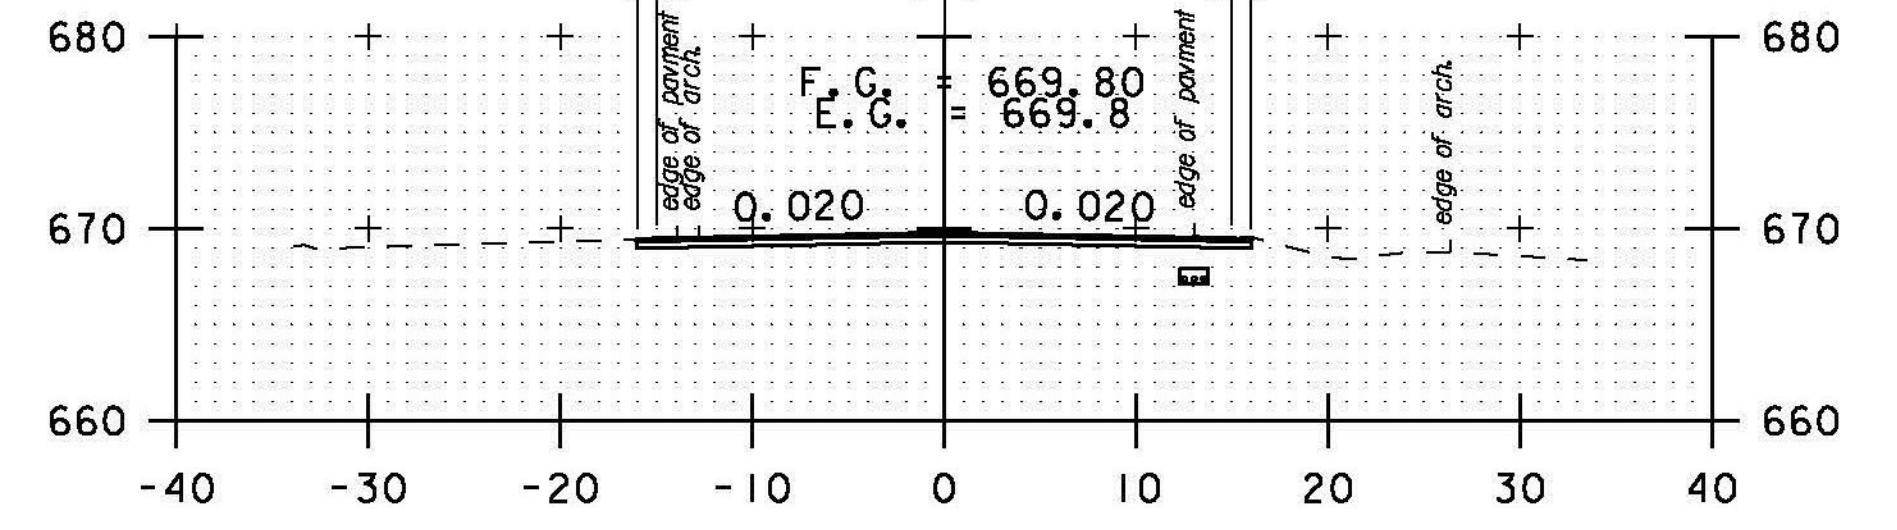

255+50

STA. 251+50 TO STA. 257+00

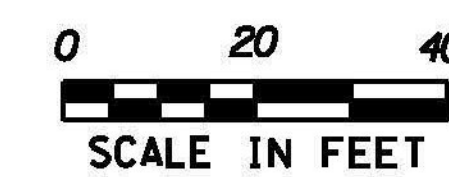

SCALE IN FEET

PROJECT NAME: BETHEL-RANDOLPH
PROJECT NUMBER: STP 292(K)

FILE NAME: piOC244.dgn
PROJECT LEADER: C. LATHROP
DESIGNED BY: S. LAMPHERE
CROSS SECTION SHEET 26

PLOT DATE: 4/23/2015
DRAWN BY: S. LAMPHERE
CHECKED BY: C. LATHROP
SHEET 160 OF 211