




259+00

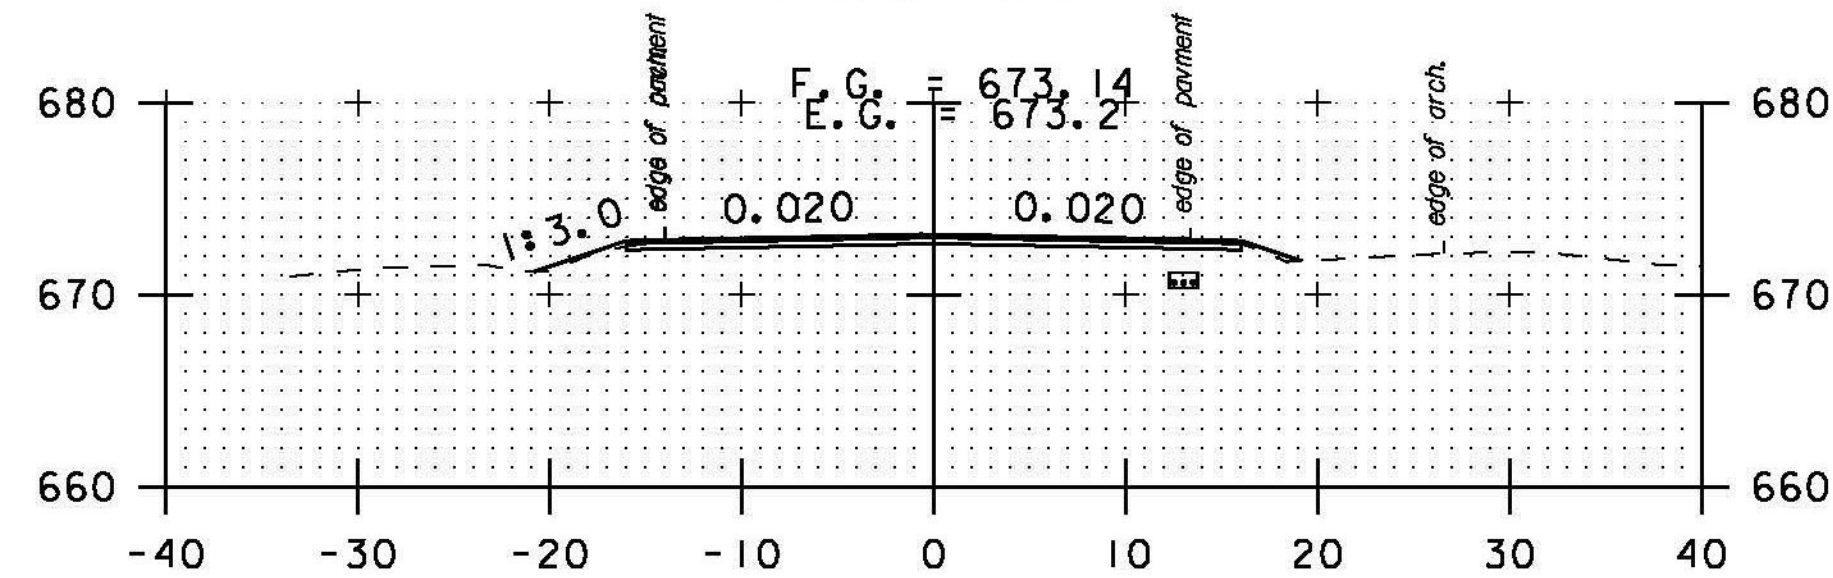


258+50

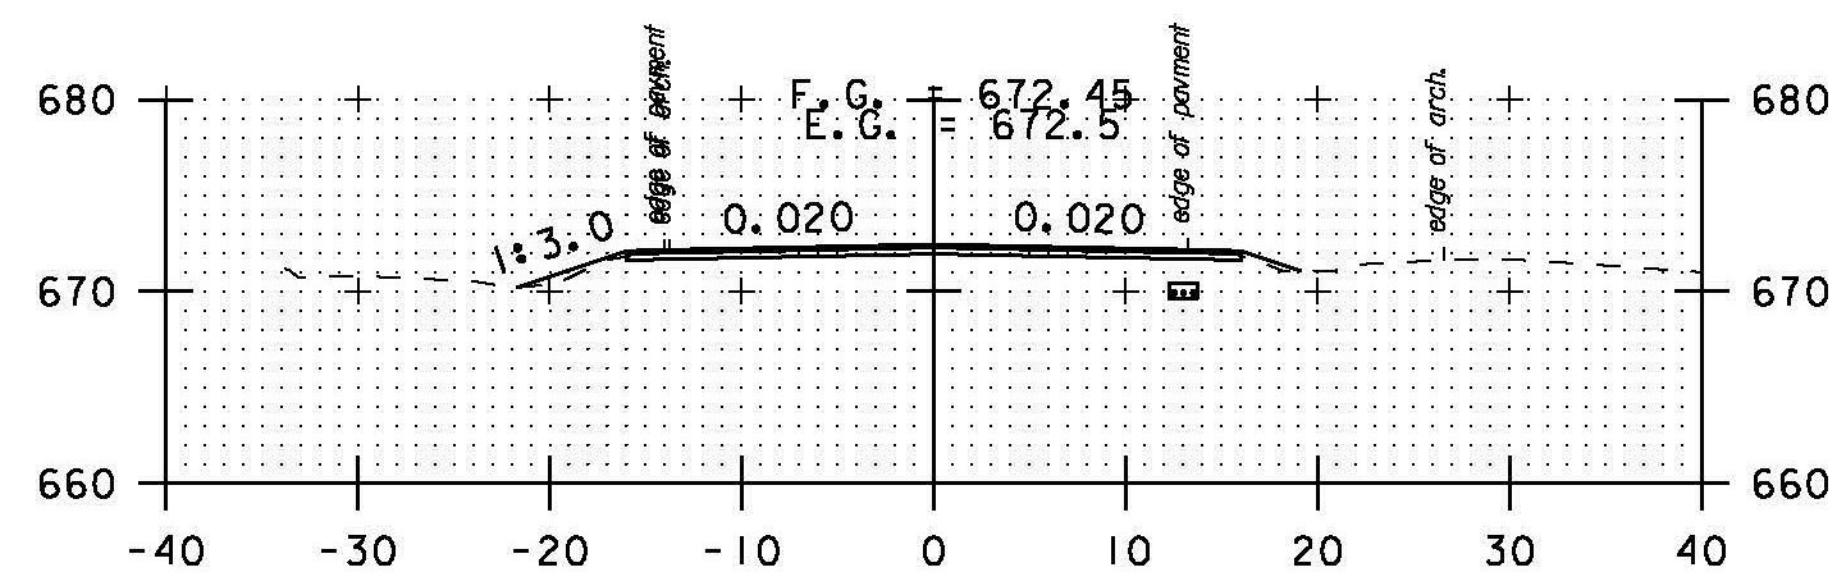


258+00

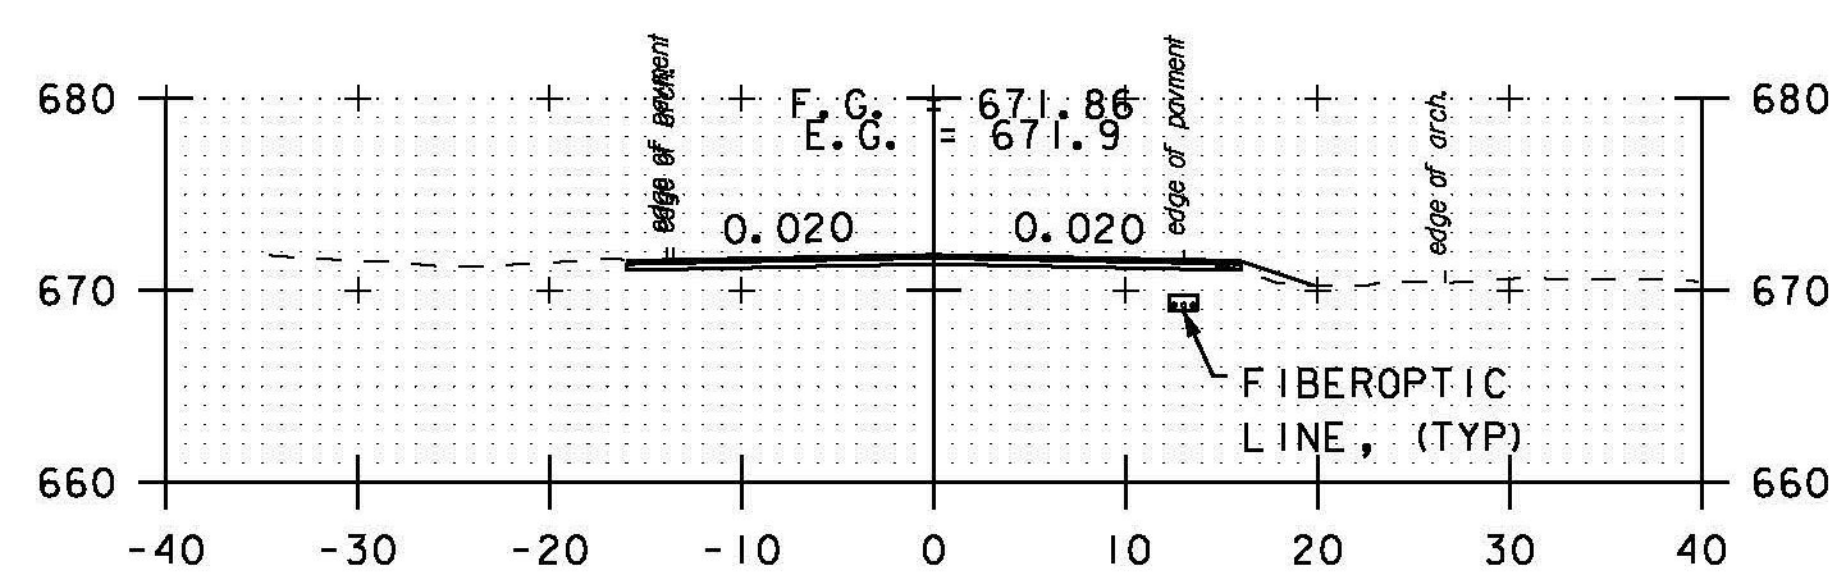


DRIVE LT  
257+50

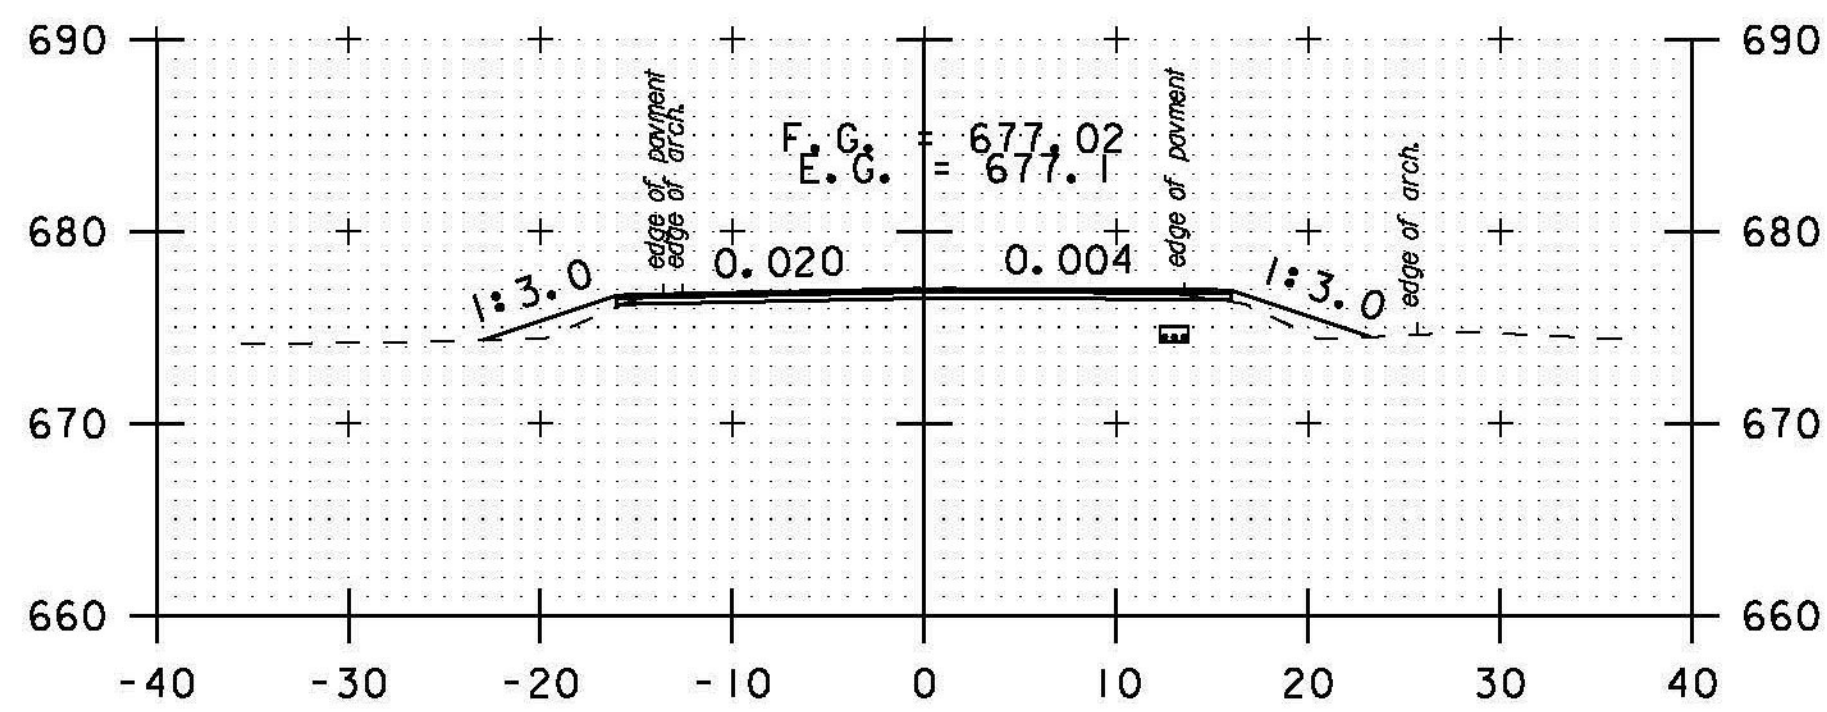


261+00

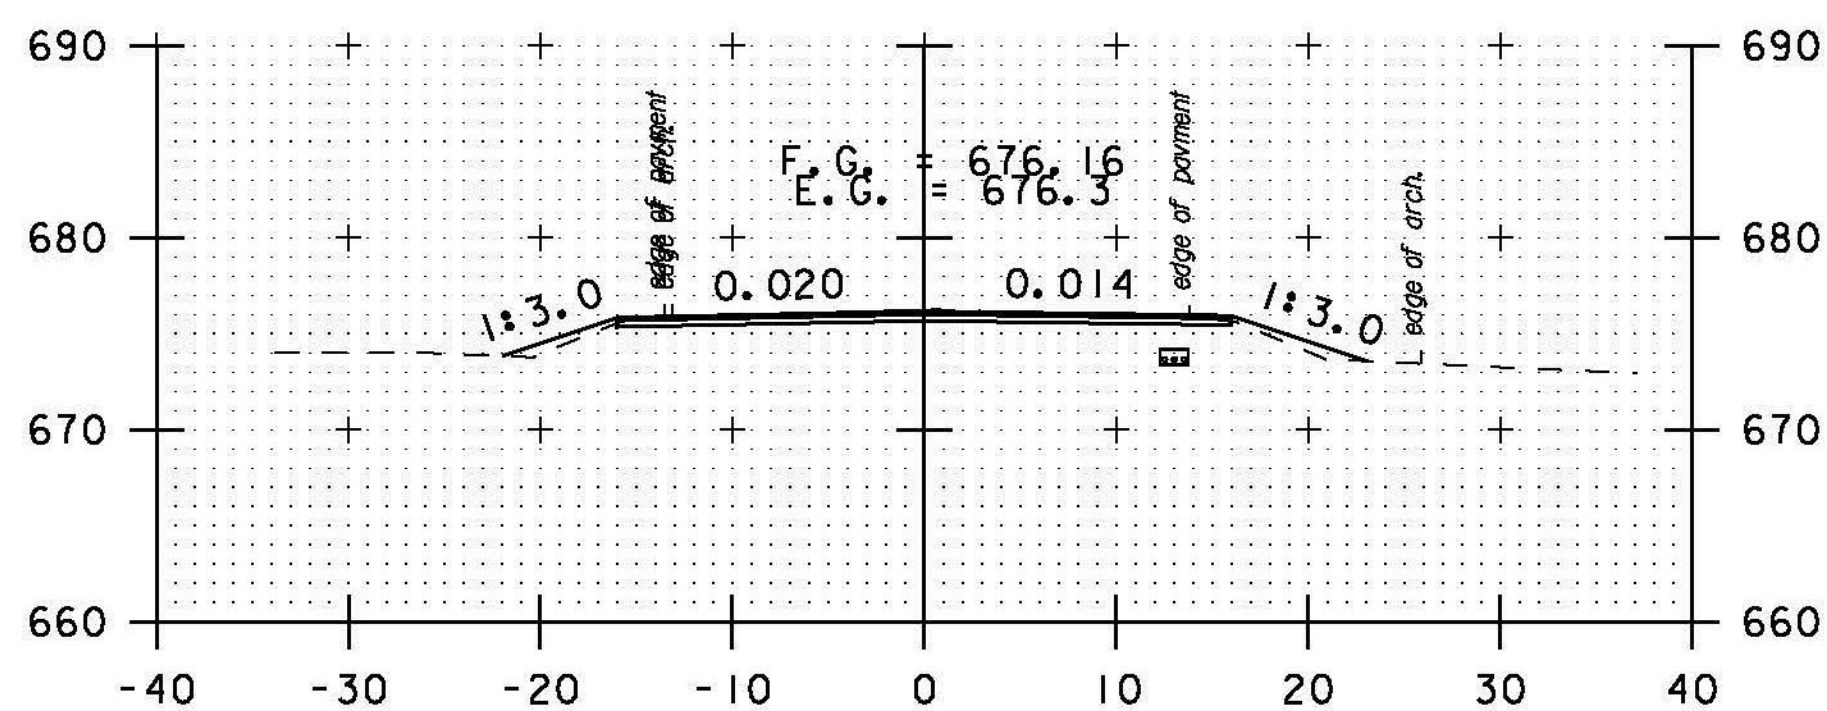


260+50

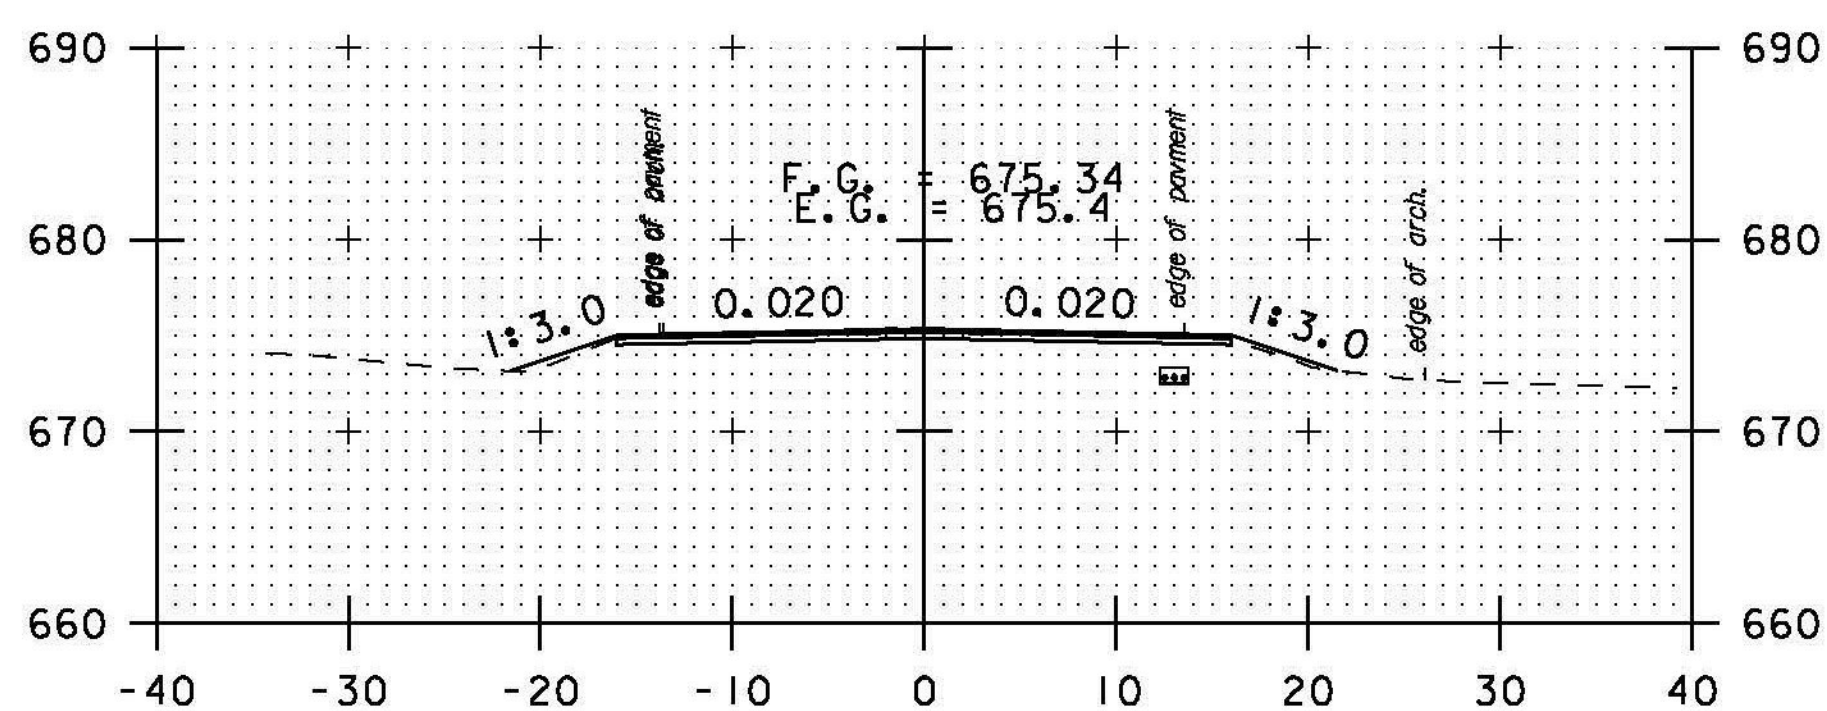


260+00

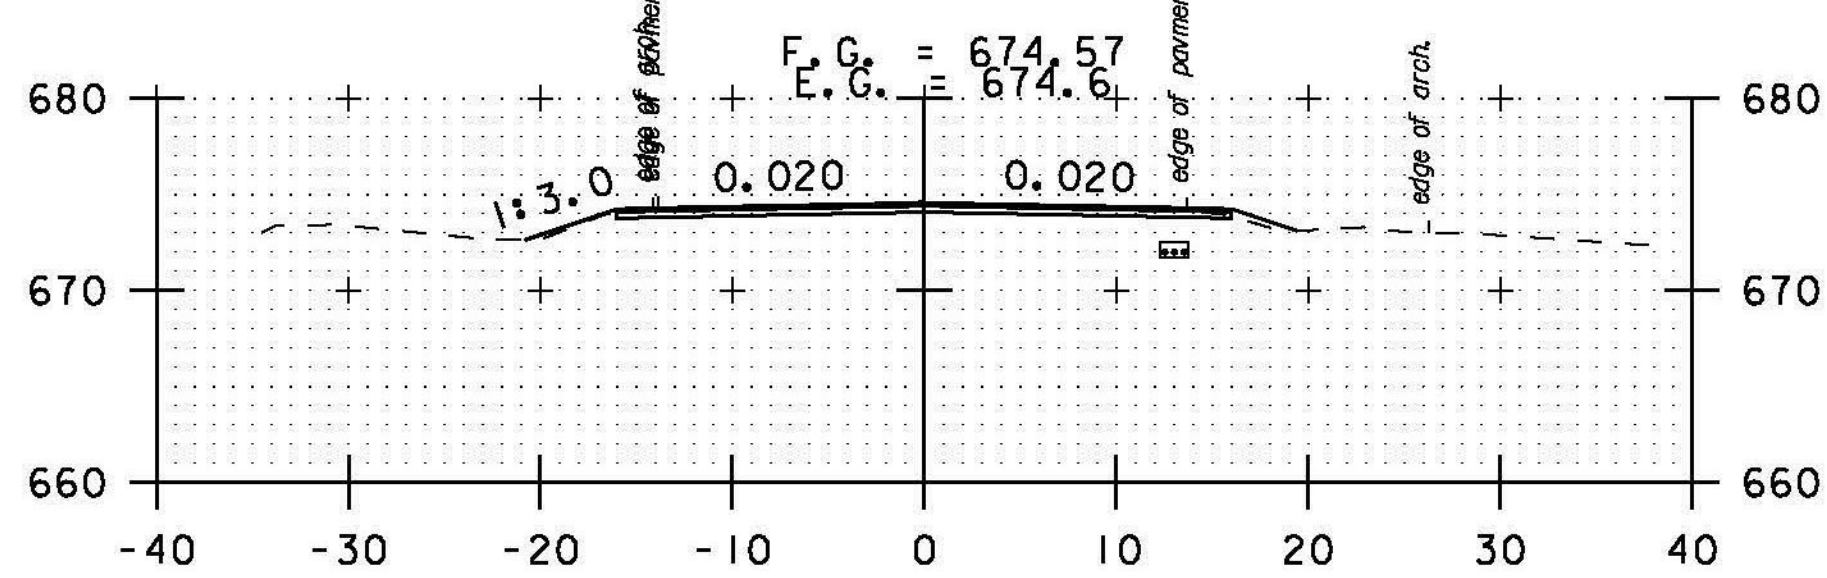


259+50

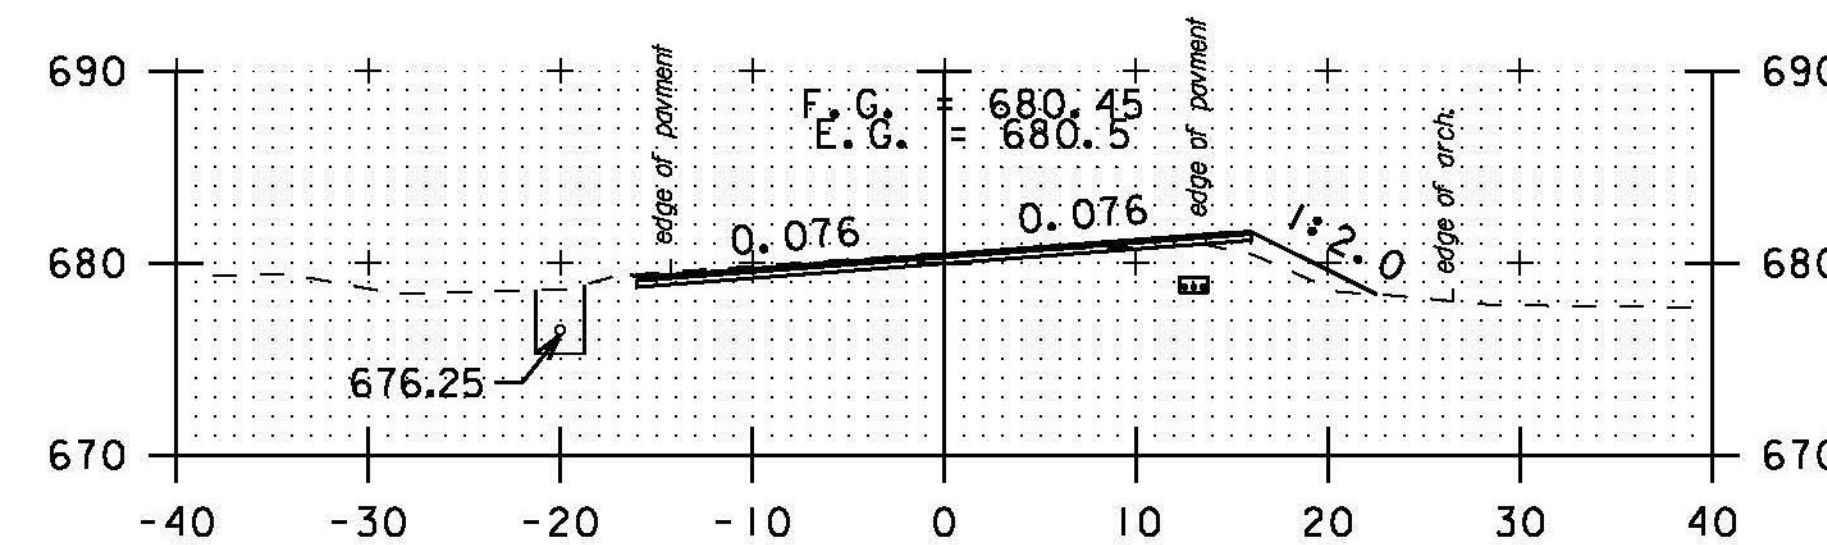


263+00

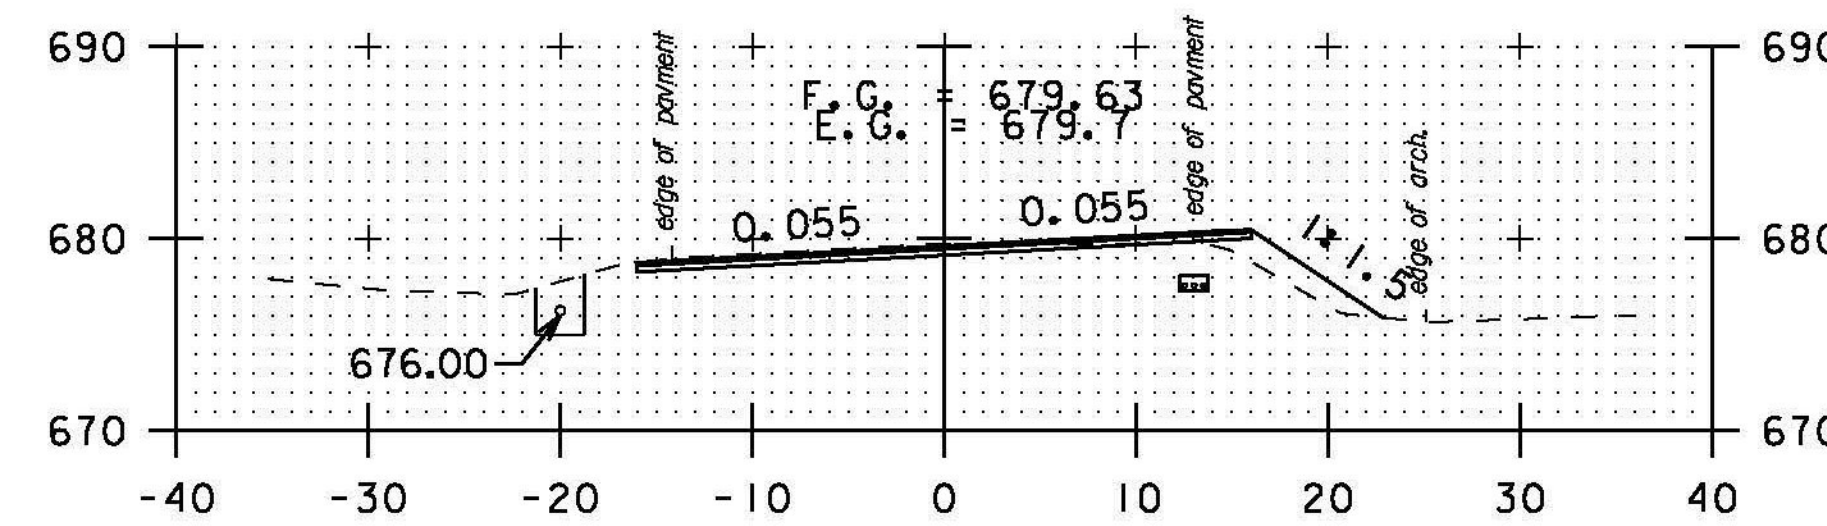

262+50

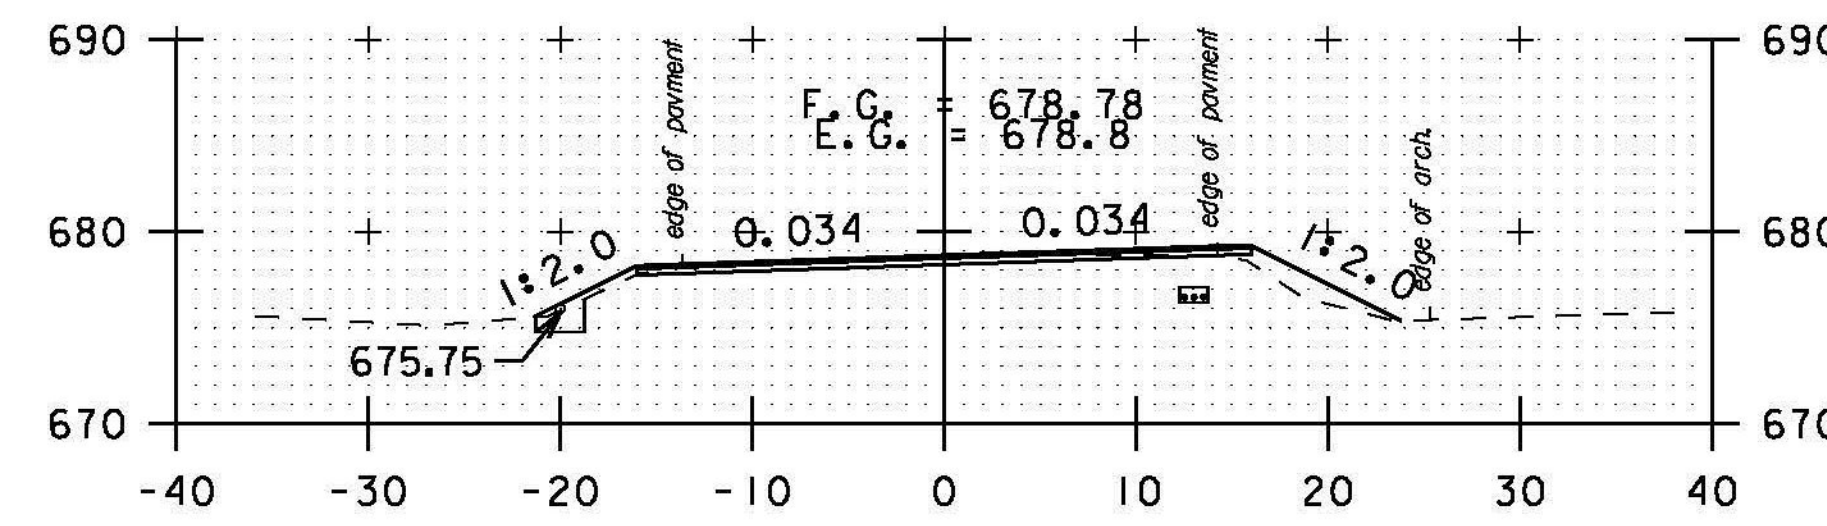


262+00

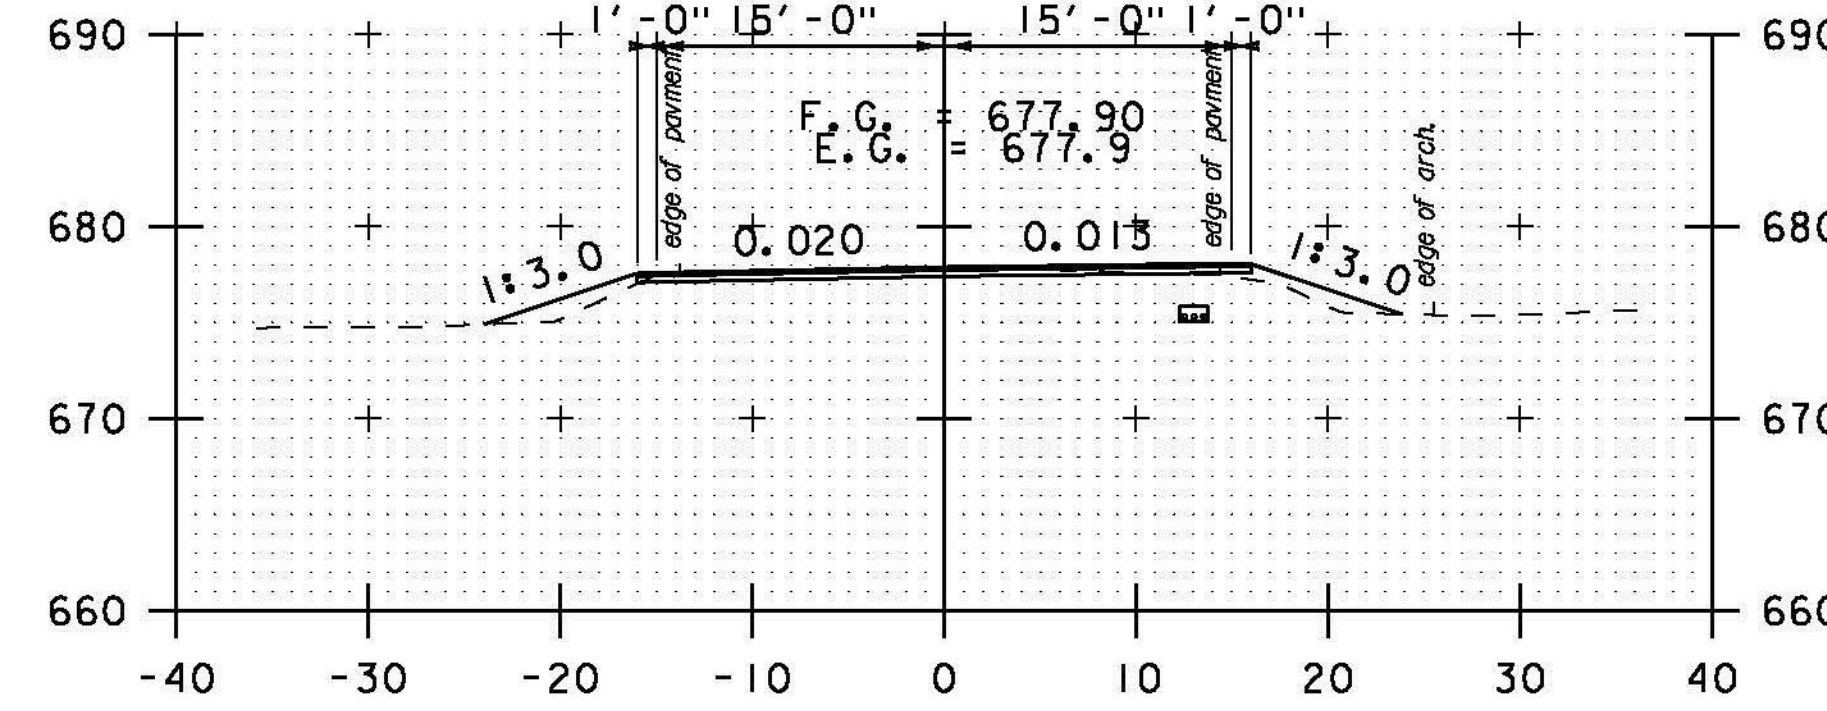

261+50

STA. 257+50 TO STA. 263+00

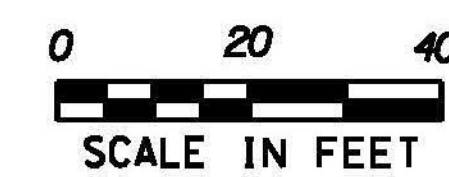

SCALE IN FEET

PROJECT NAME: BETHEL-RANDOLPH  
PROJECT NUMBER: STP 292(I)

FILE NAME: piOC244.dgn  
PROJECT LEADER: C. LATHROP  
DESIGNED BY: S. LAMPHERE  
CROSS SECTION SHEET 27

PLOT DATE: 4/23/2015  
DRAWN BY: S. LAMPHERE  
CHECKED BY: C. LATHROP  
SHEET 161 OF 211