




265+00

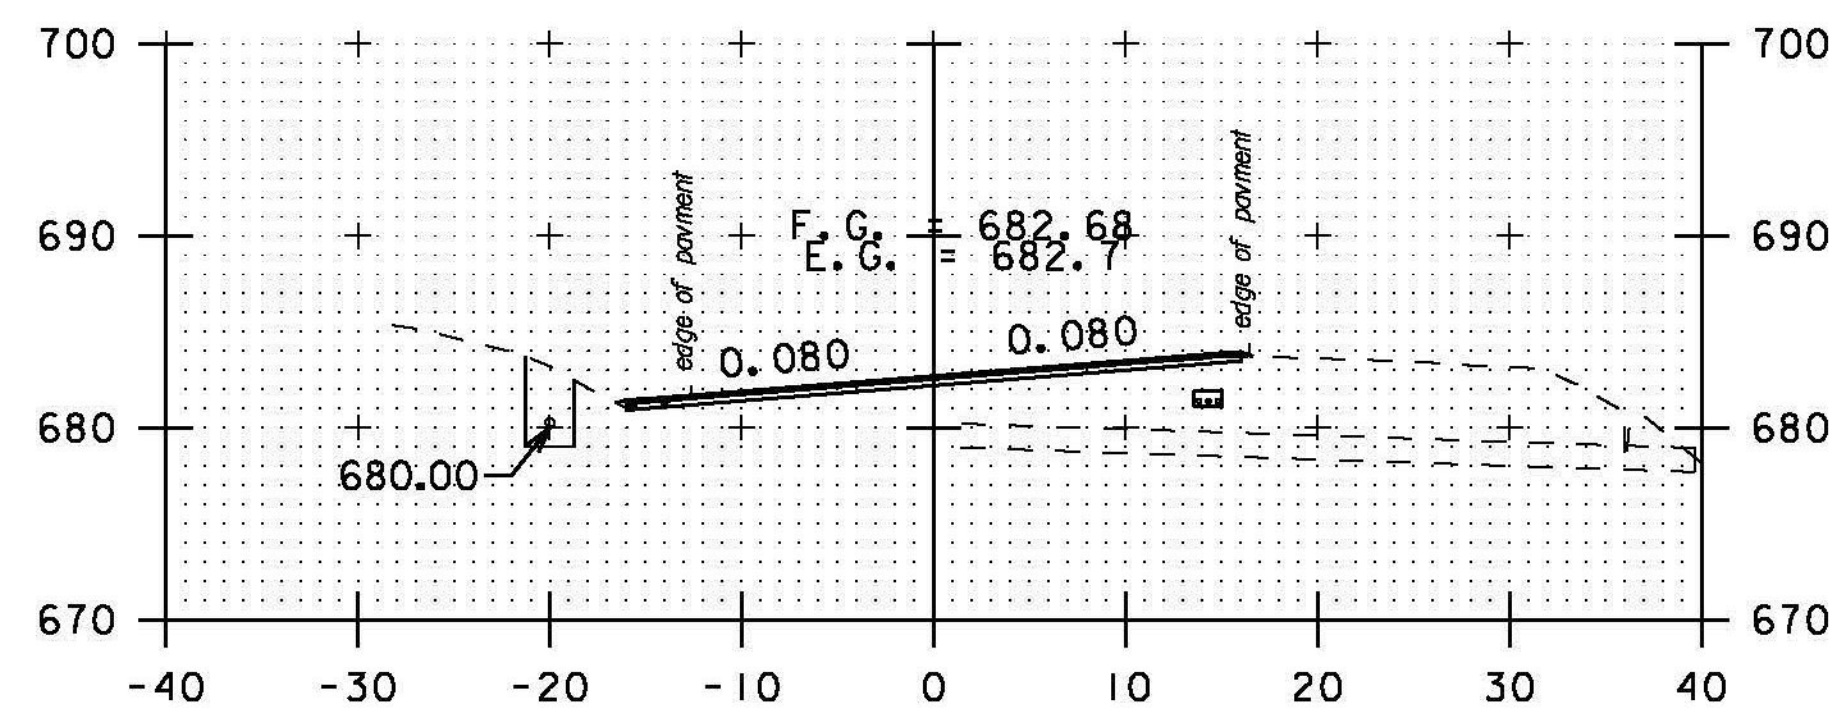


264+50

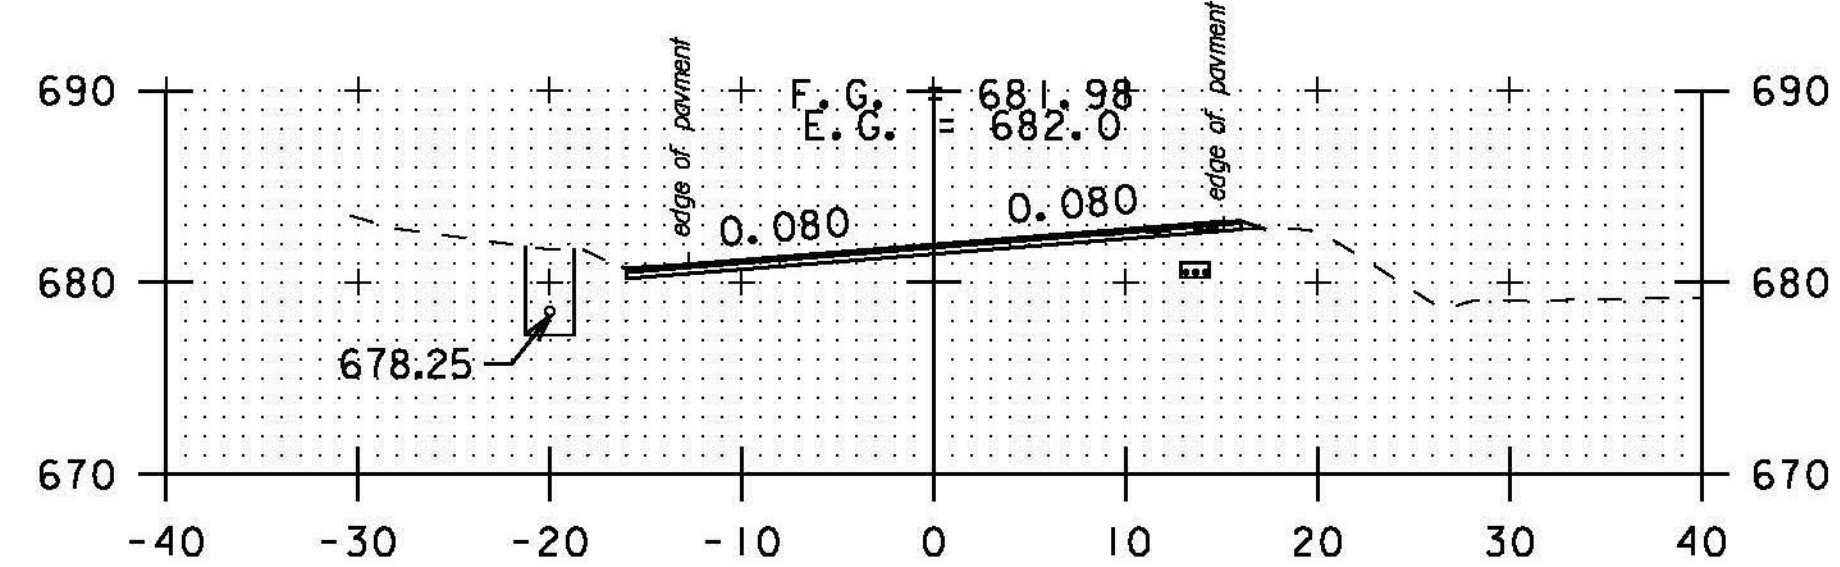


264+00

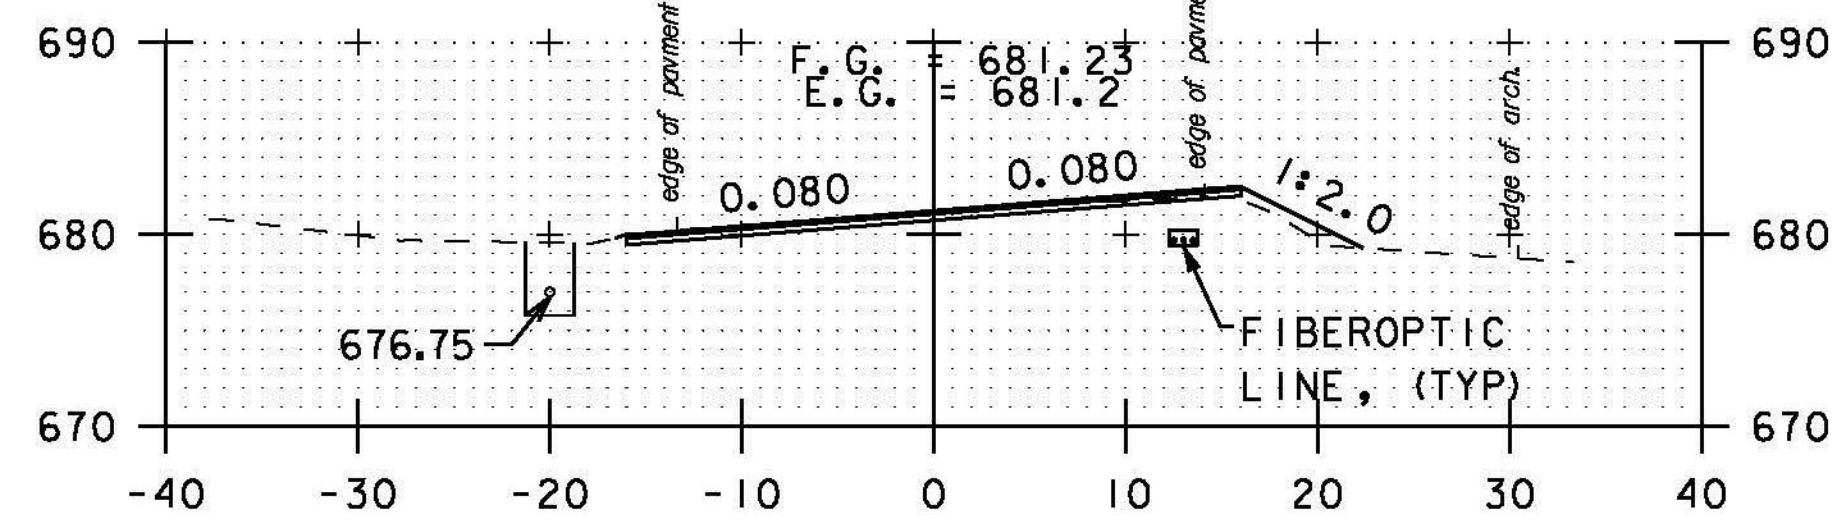


263+50

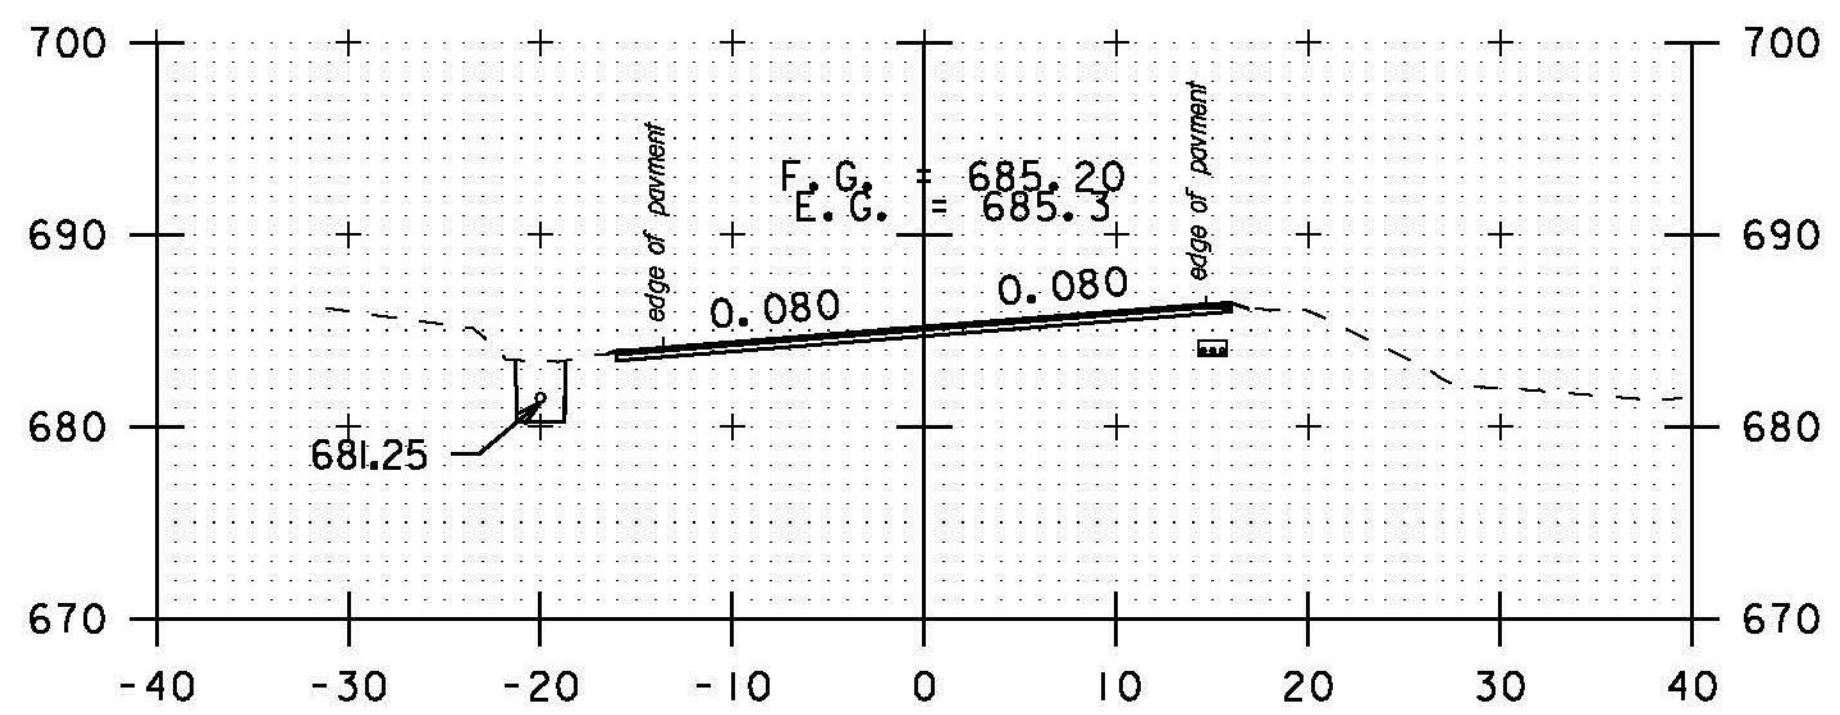


266+50

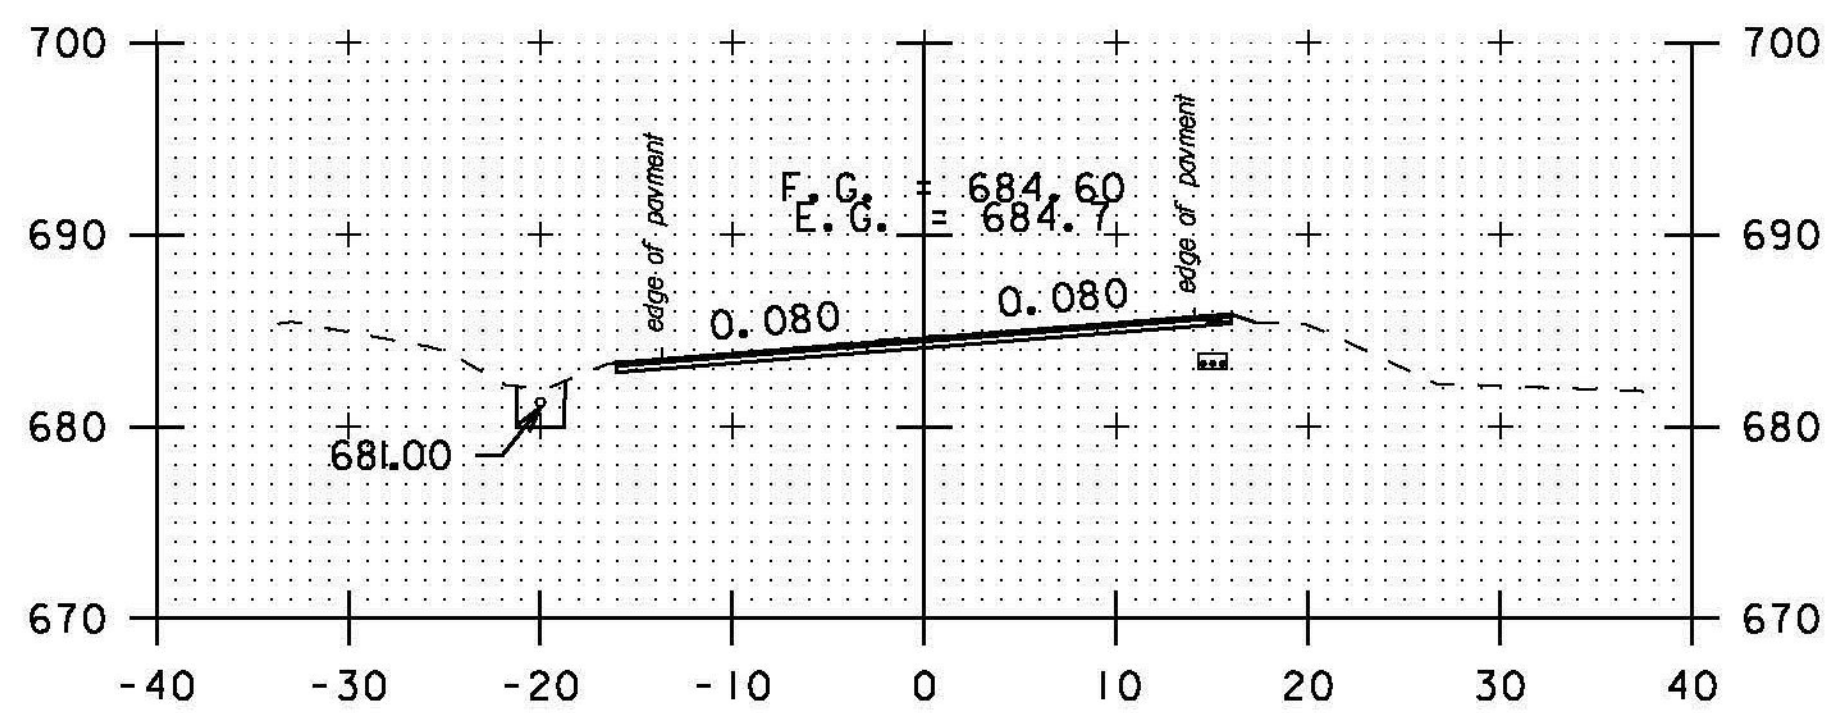


266+00

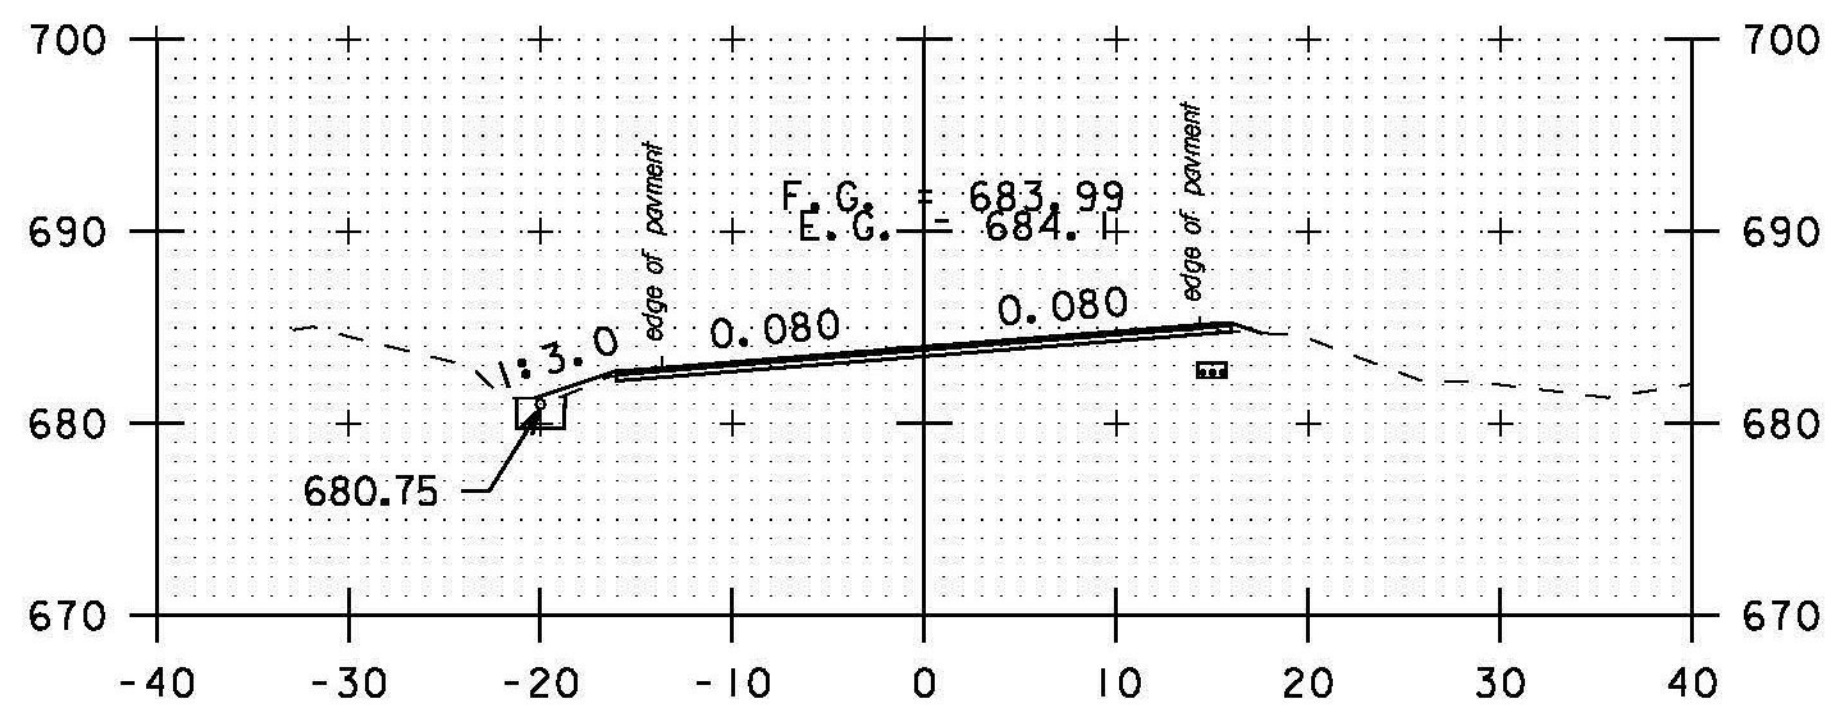


265+50

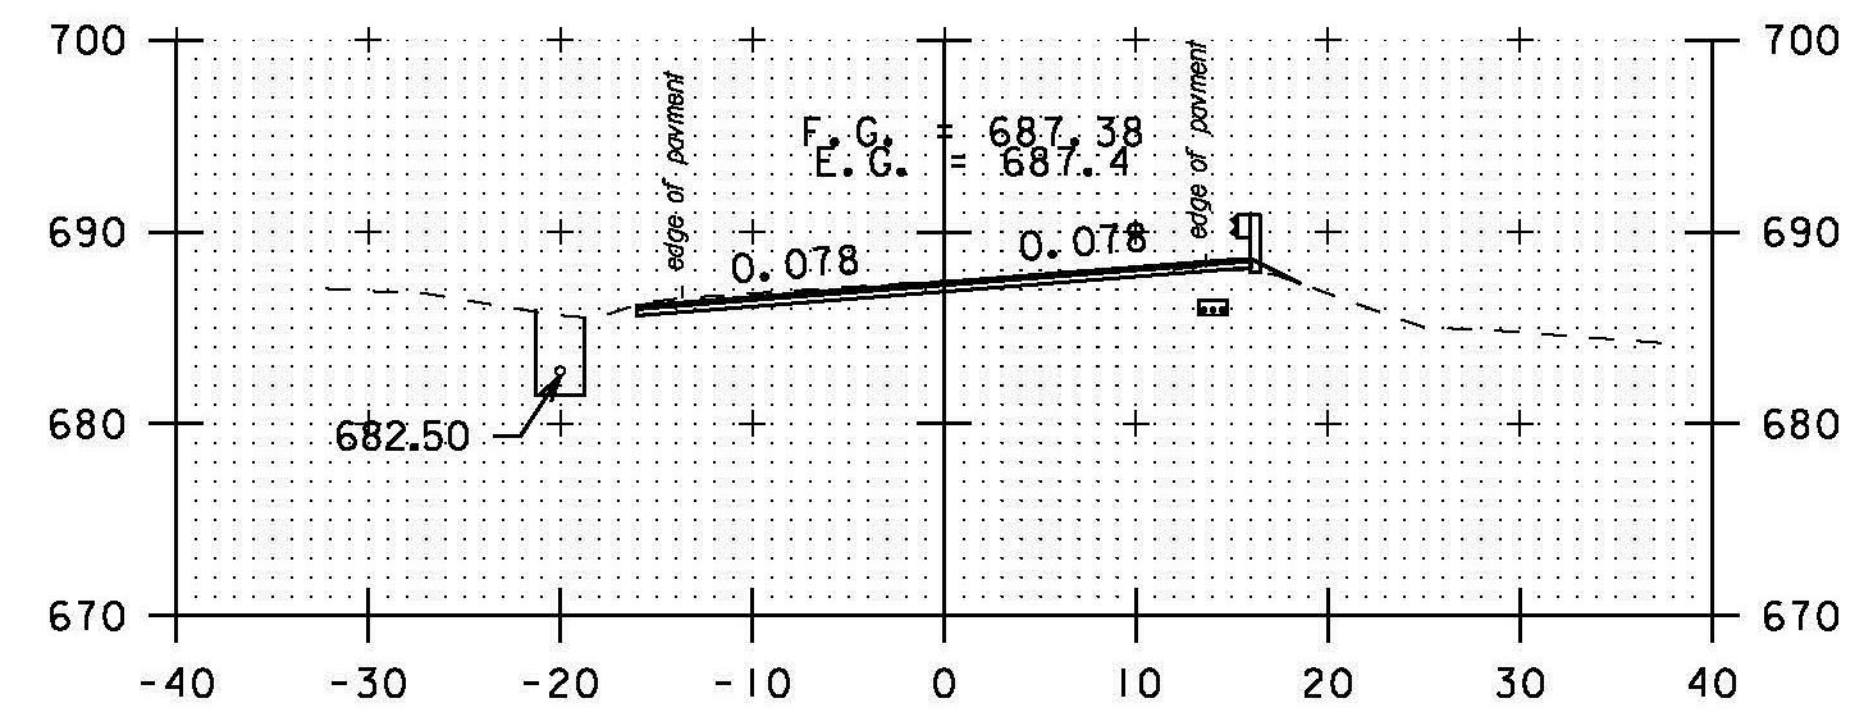


268+00

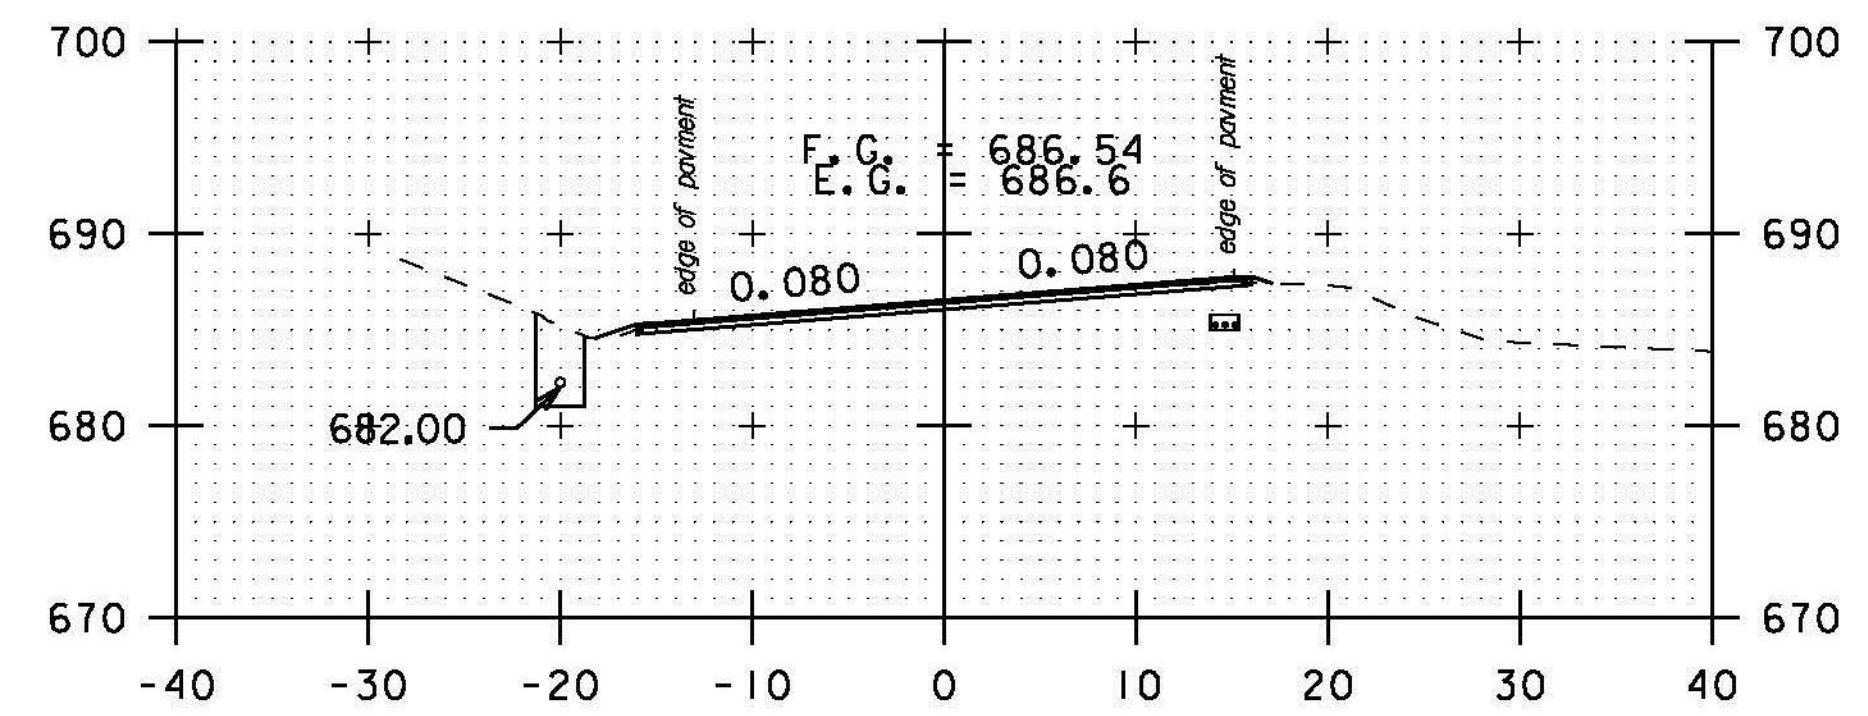

267+50

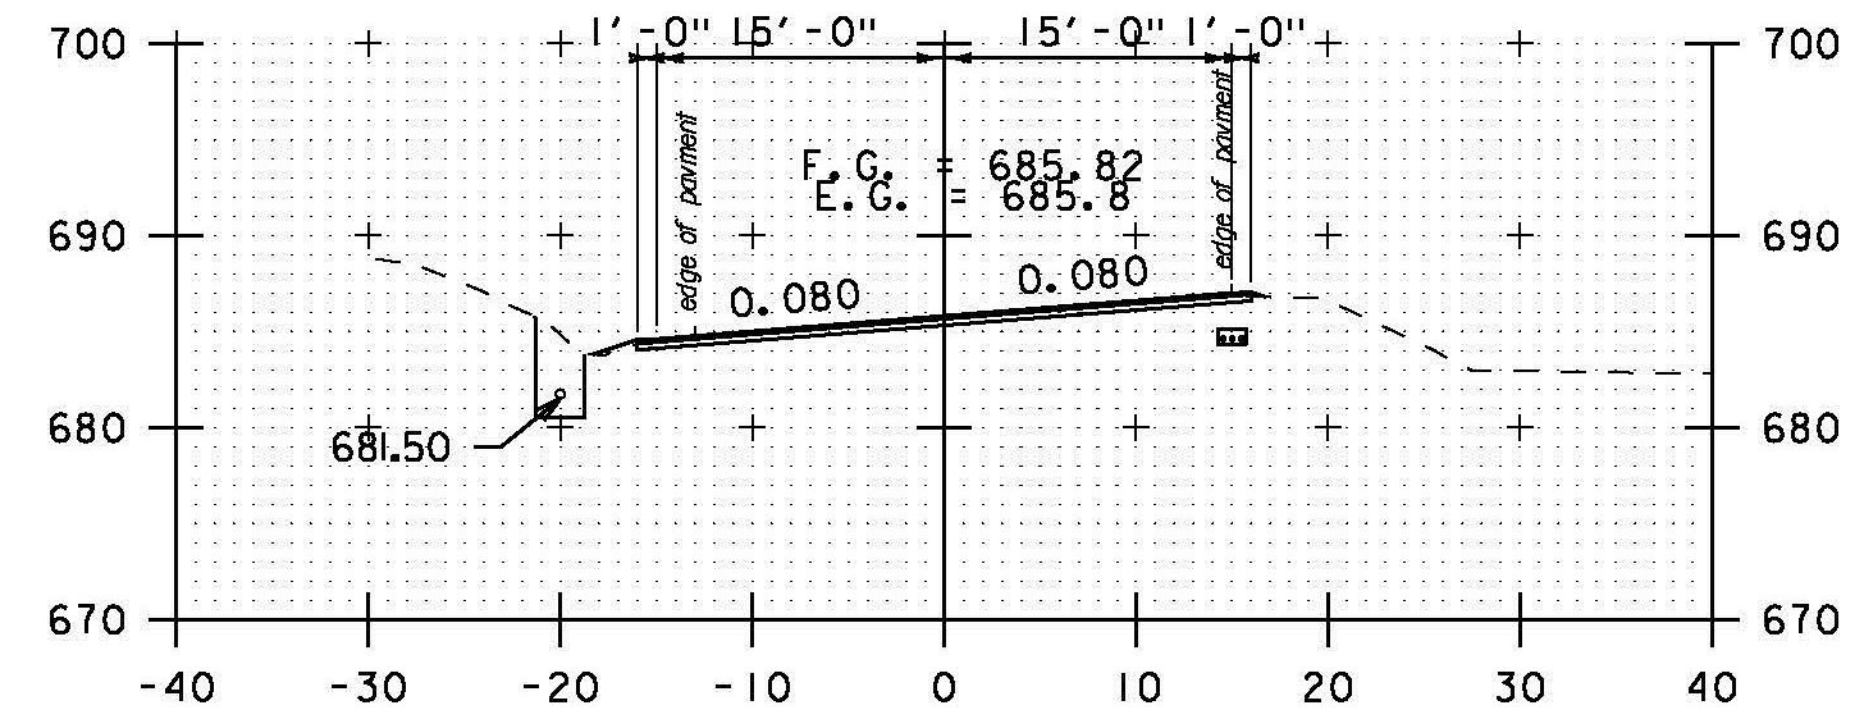

267+00

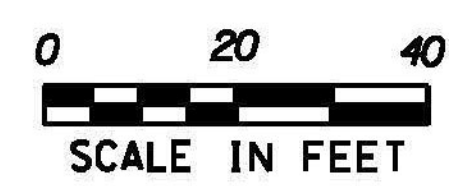

STA. 263+50 TO STA. 268+00

PROJECT NAME:	BETHEL-RANDOLPH	FILE NAME:	plOC244.dgn	PLOT DATE:	4/23/2015
PROJECT NUMBER:	STP 292(I)	PROJECT LEADER:	C. LATHROP	DRAWN BY:	S. LAMPHERE
		DESIGNED BY:	S. LAMPHERE	CHECKED BY:	C. LATHROP
		CROSS SECTION SHEET	28	SHEET	162 OF 211