




270+00

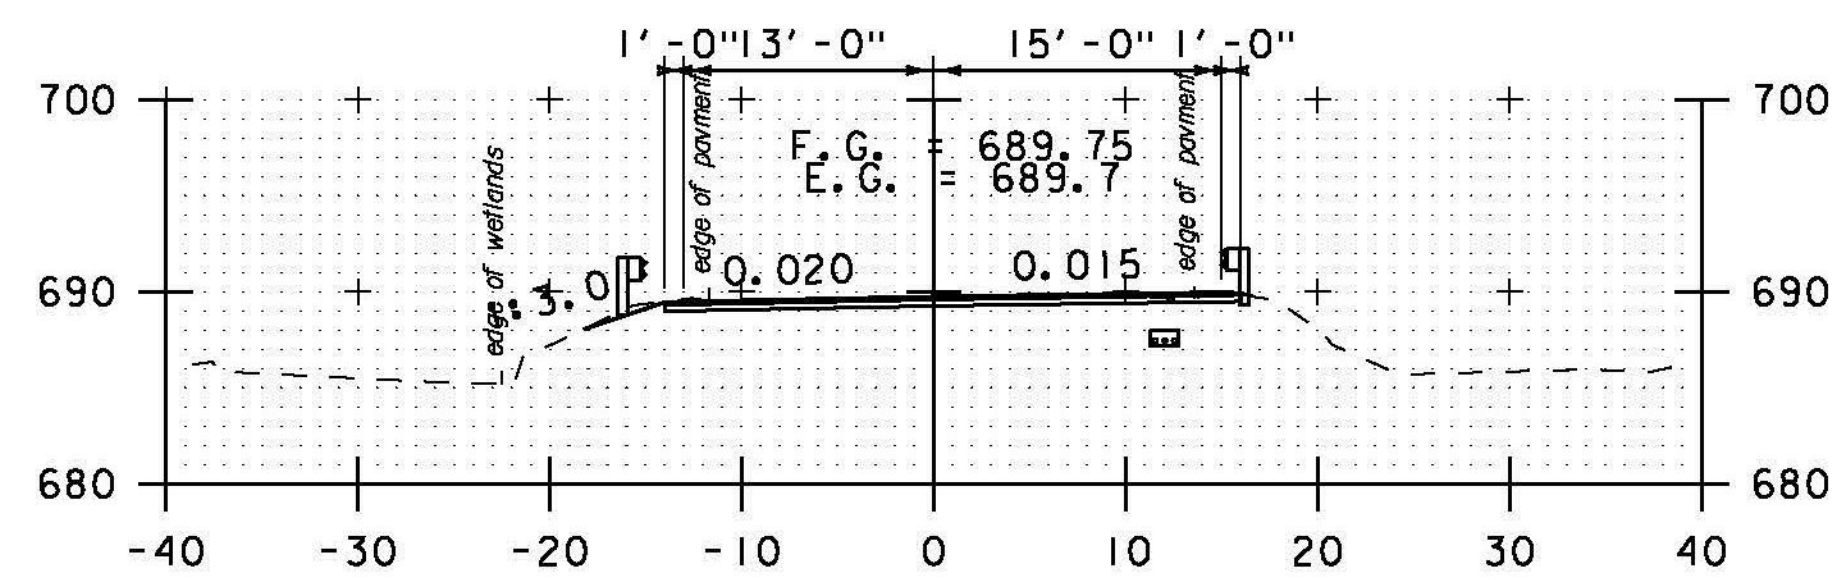


269+50

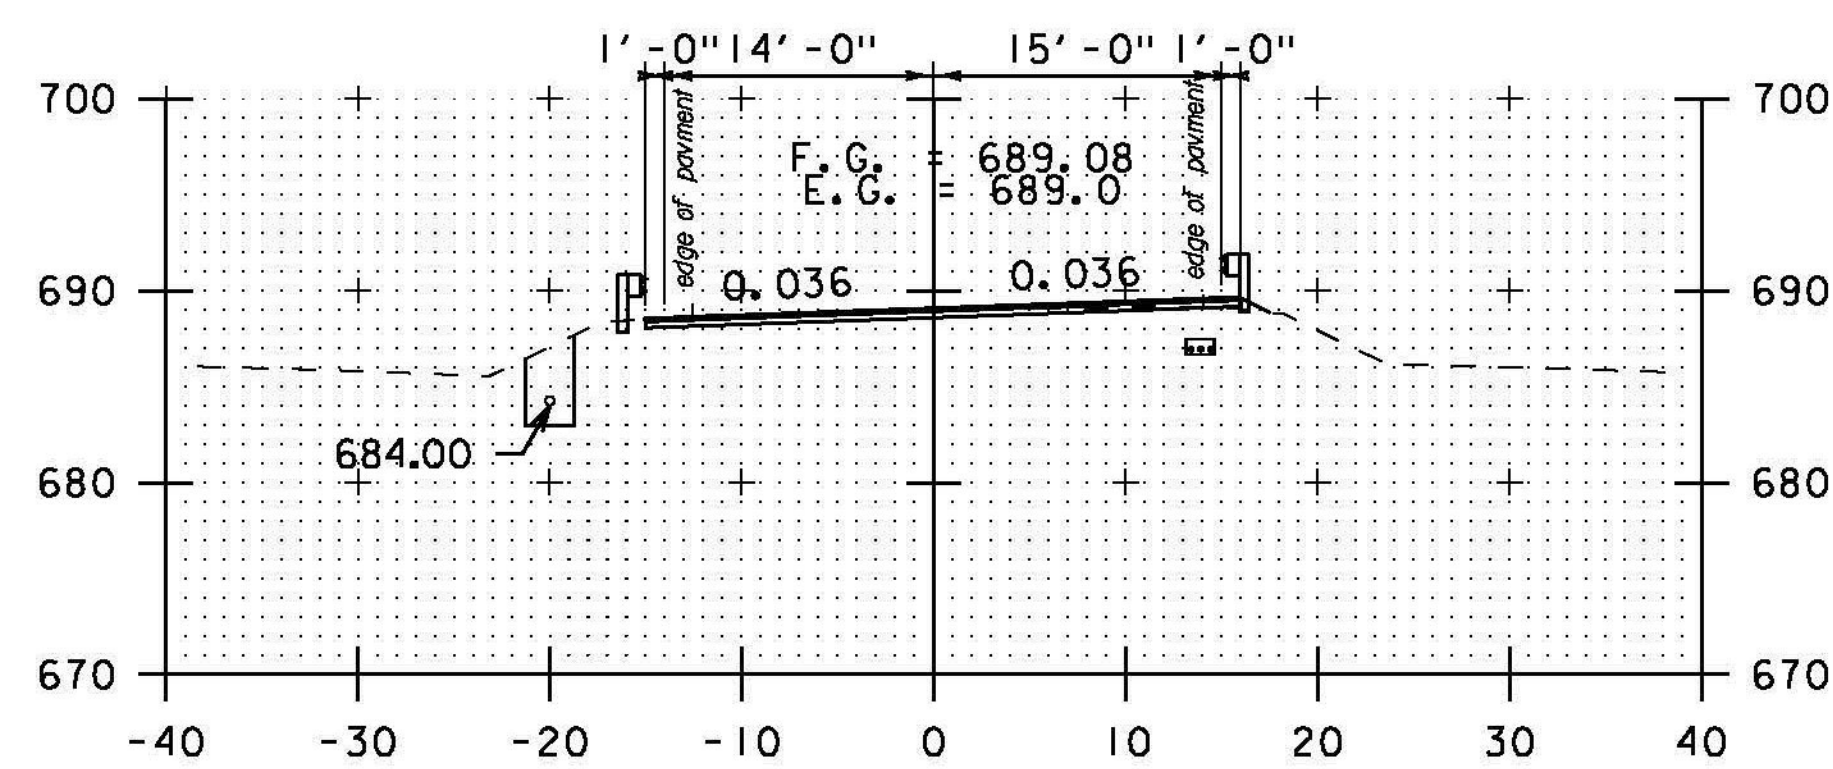


269+00

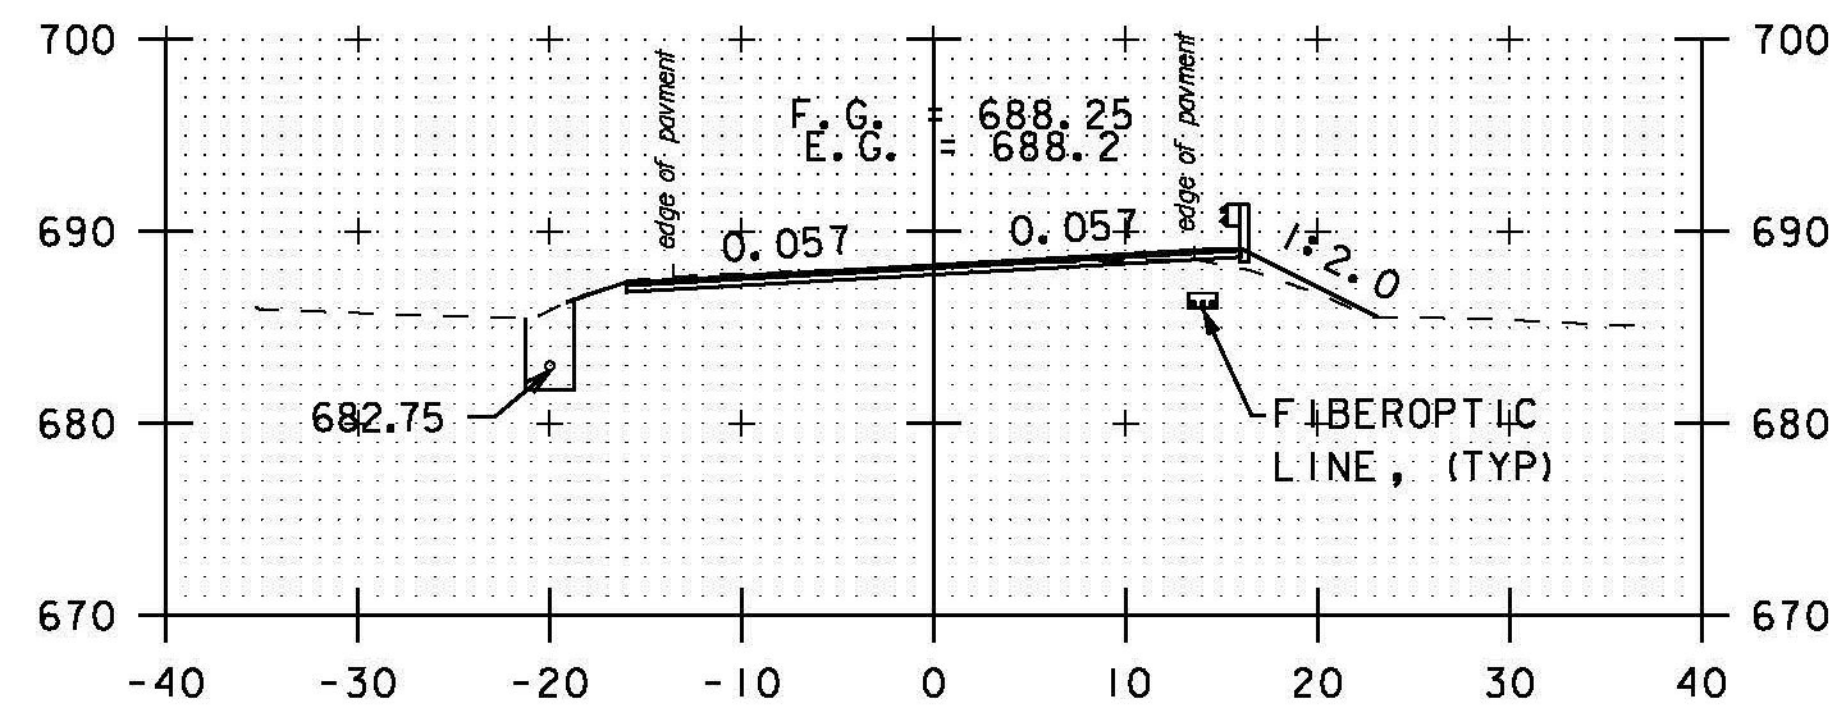


268+50

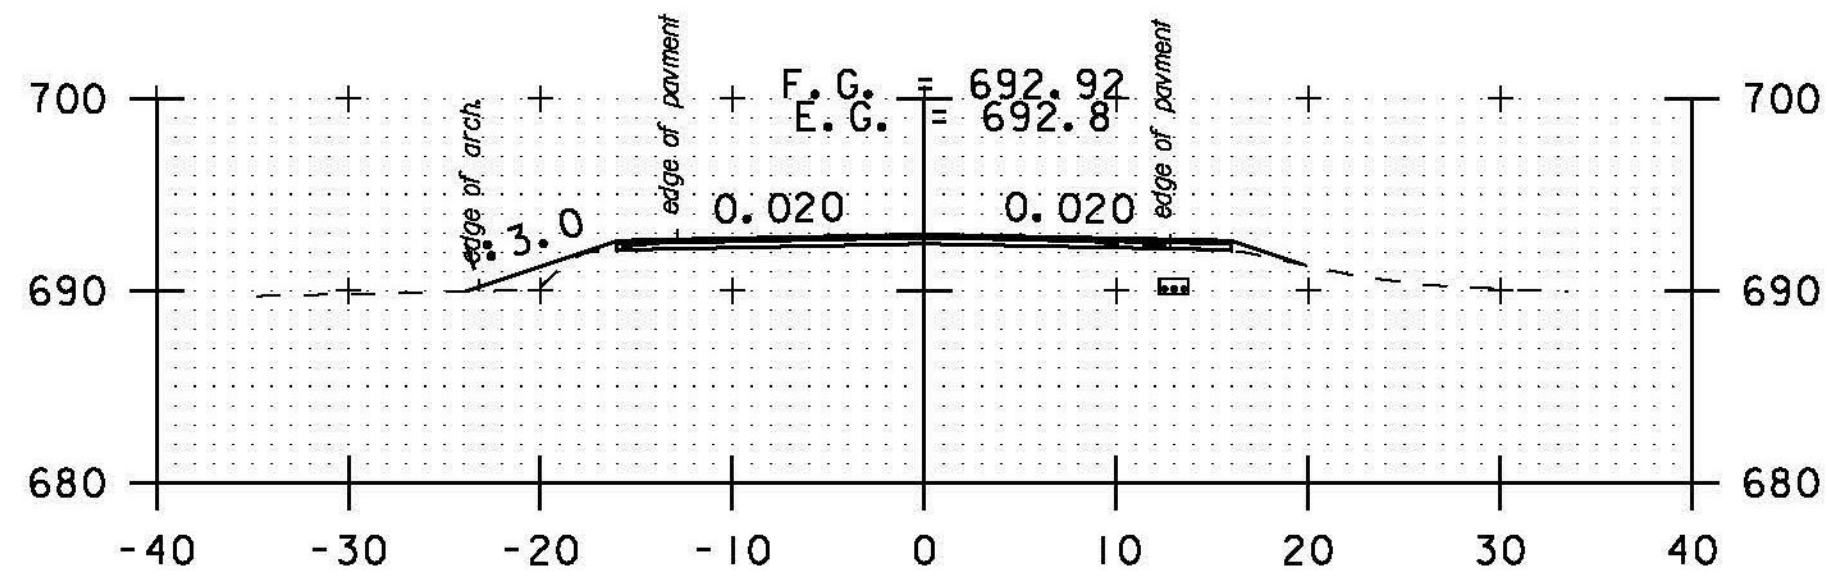


272+00

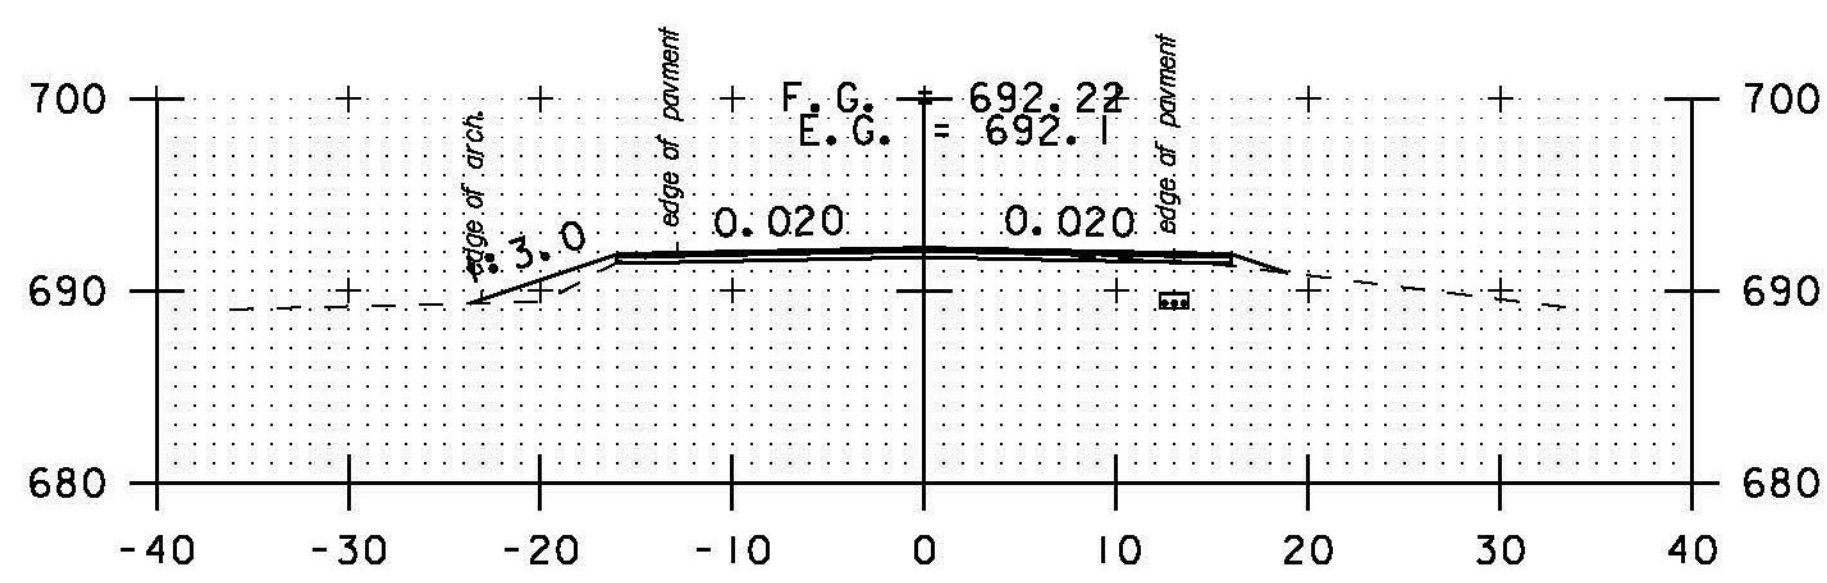


271+50

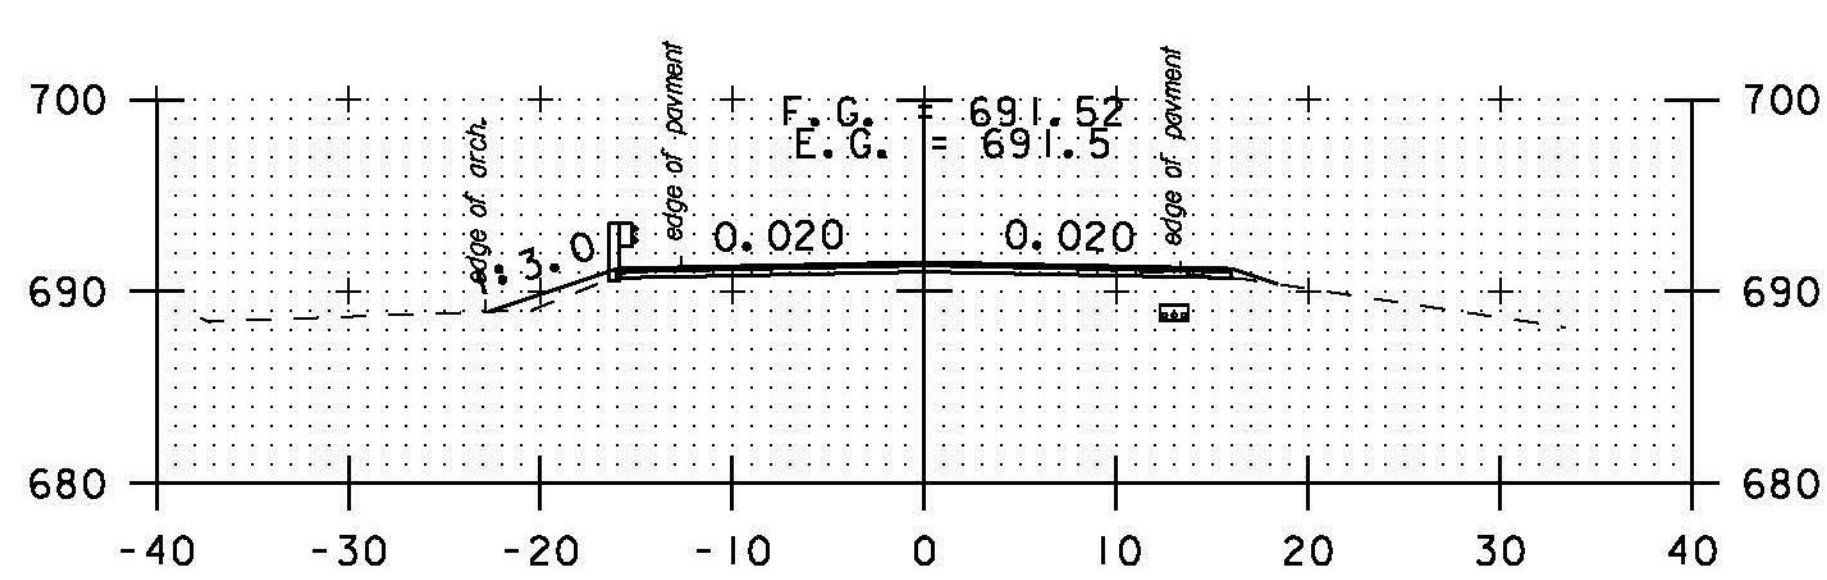


271+00

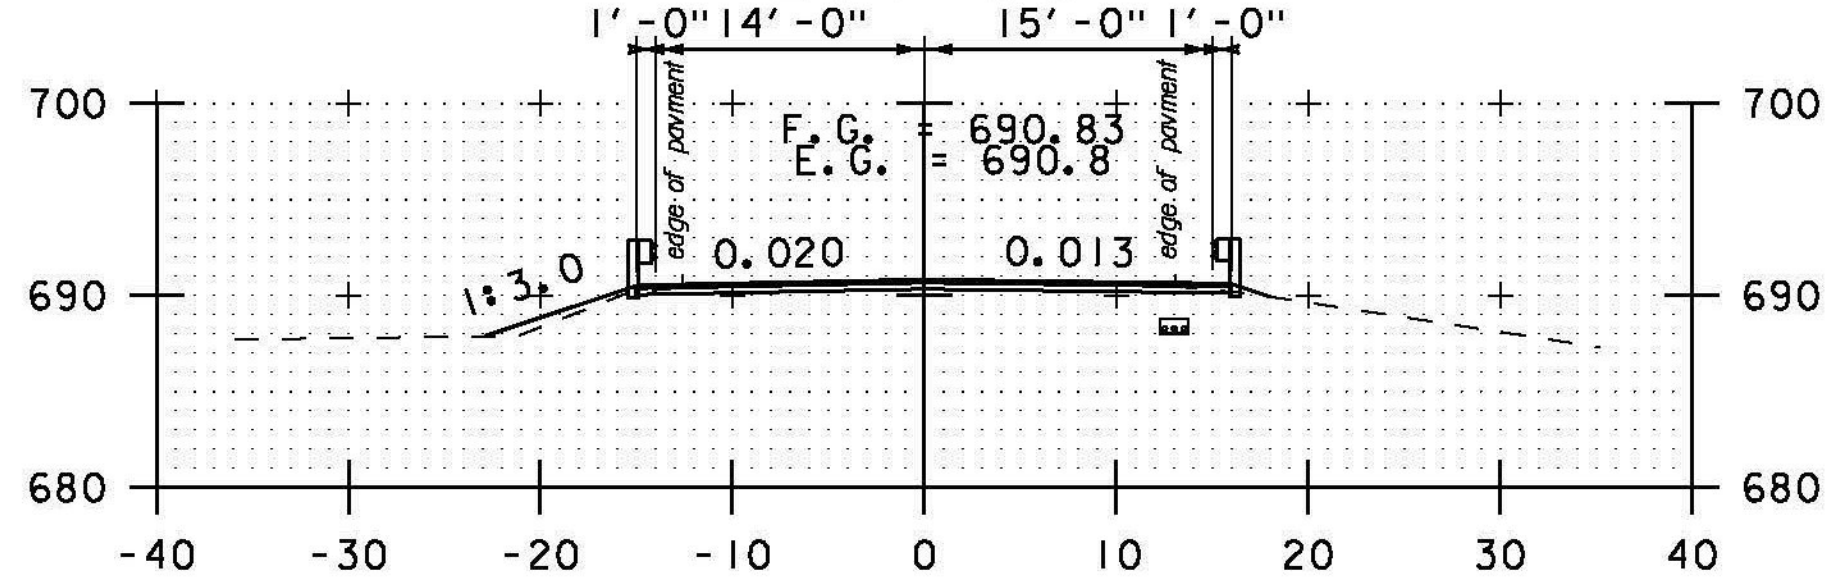


270+50

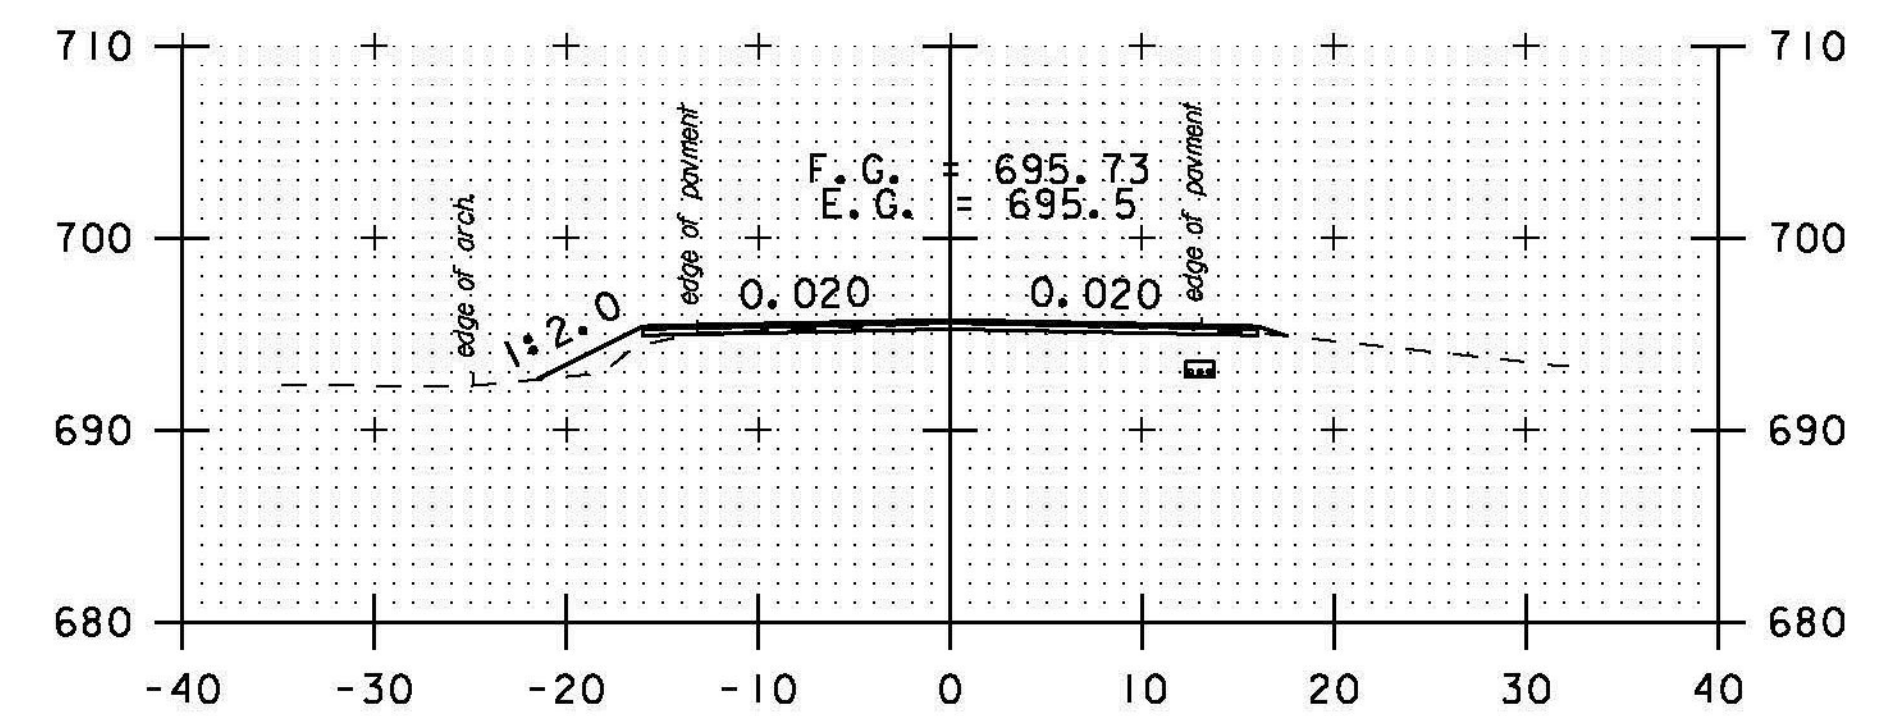


274+00

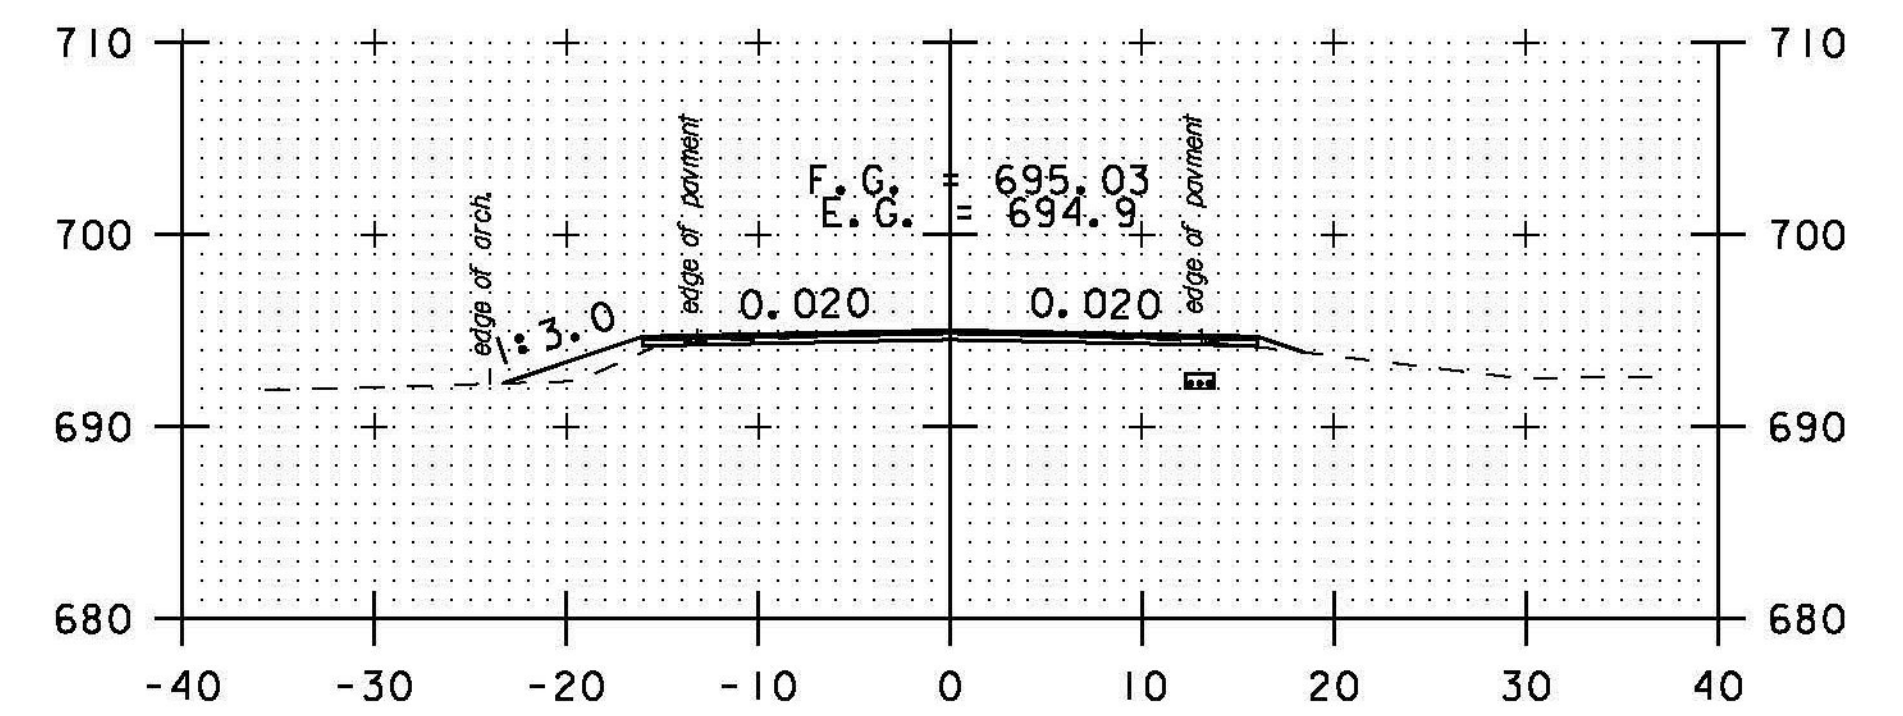


273+50

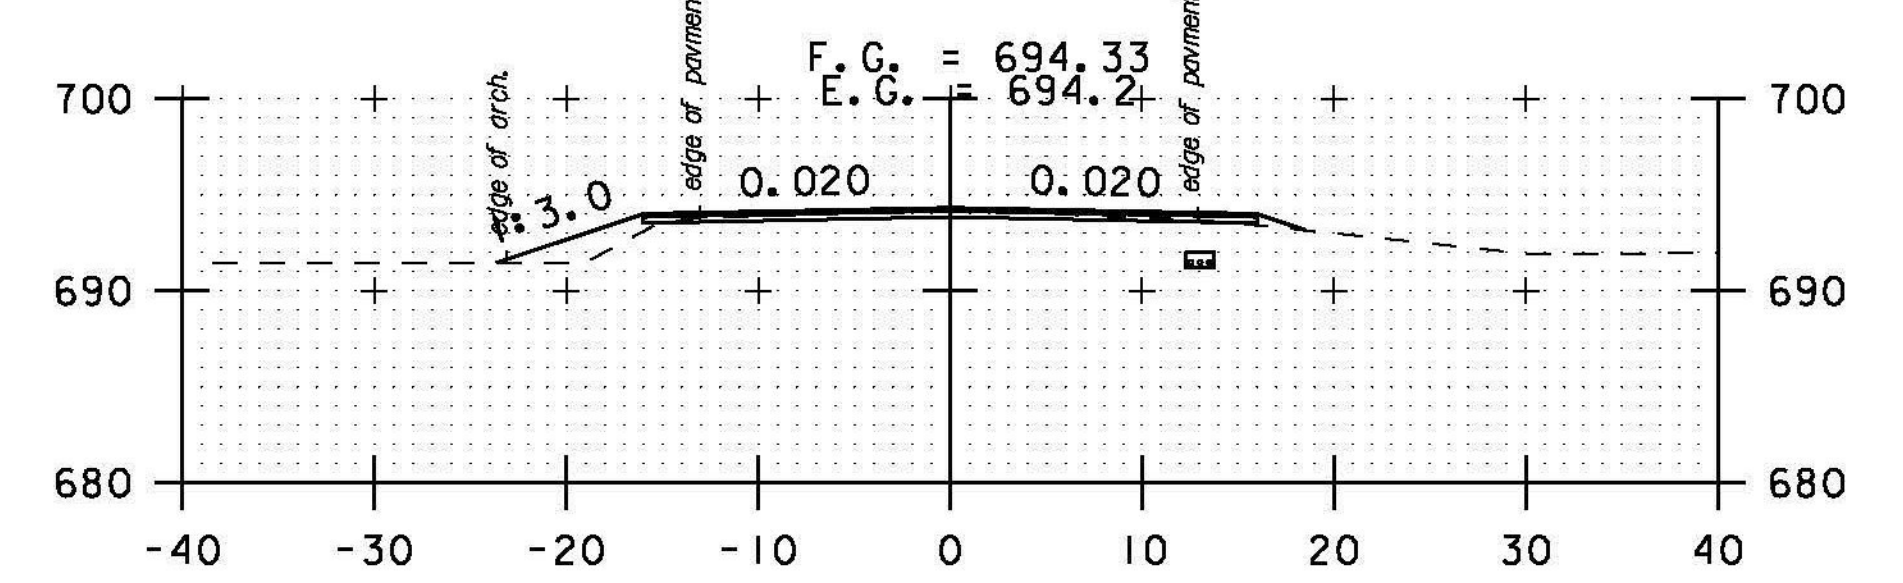

273+00

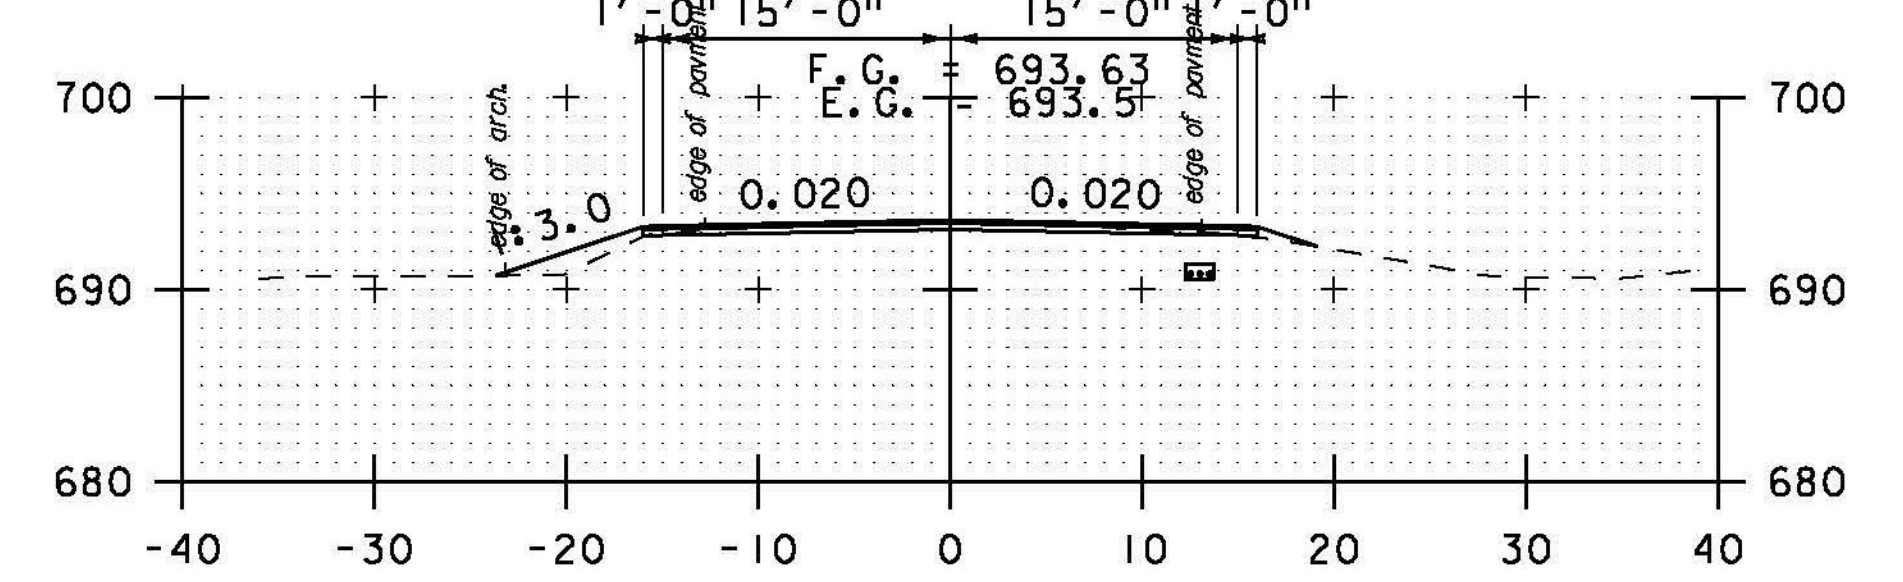

272+50

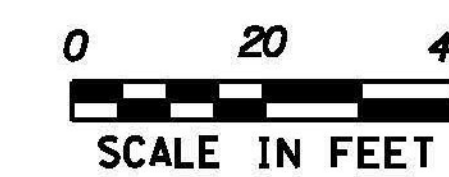

SCALE IN FEET

STA. 268+50 TO STA. 274+00

PROJECT NAME: BETHEL-RANDOLPH  
PROJECT NUMBER: STP 292(I)

FILE NAME: piOC244.dgn  
PROJECT LEADER: C. LATHROP  
DESIGNED BY: S. LAMPHERE  
CROSS SECTION SHEET 29

PLOT DATE: 4/23/2015  
DRAWN BY: S. LAMPHERE  
CHECKED BY: C. LATHROP  
SHEET 163 OF 211