




DRIVE RT
275+50

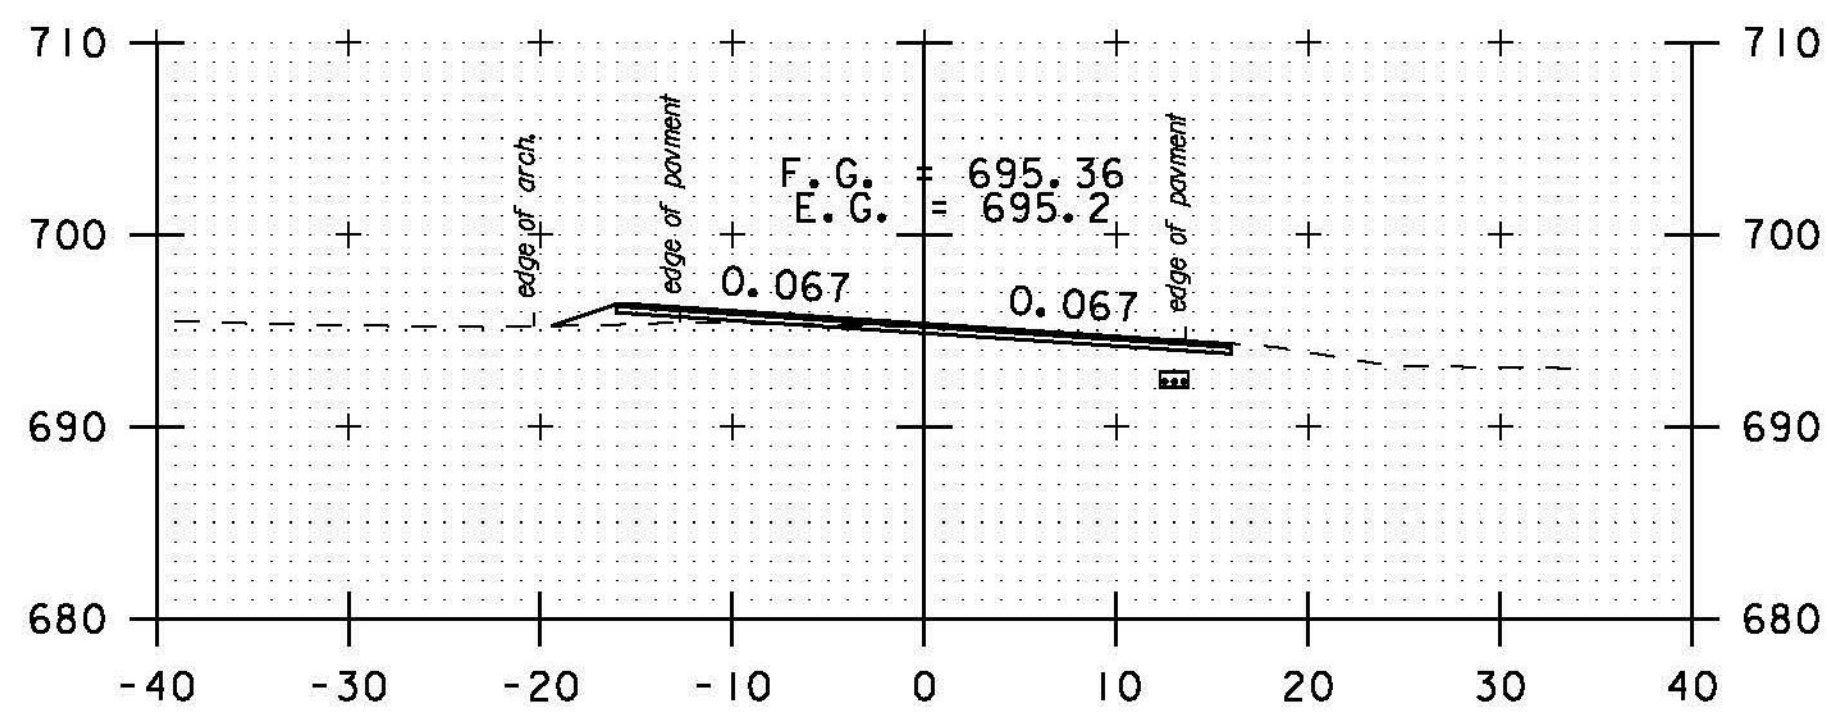


277+00

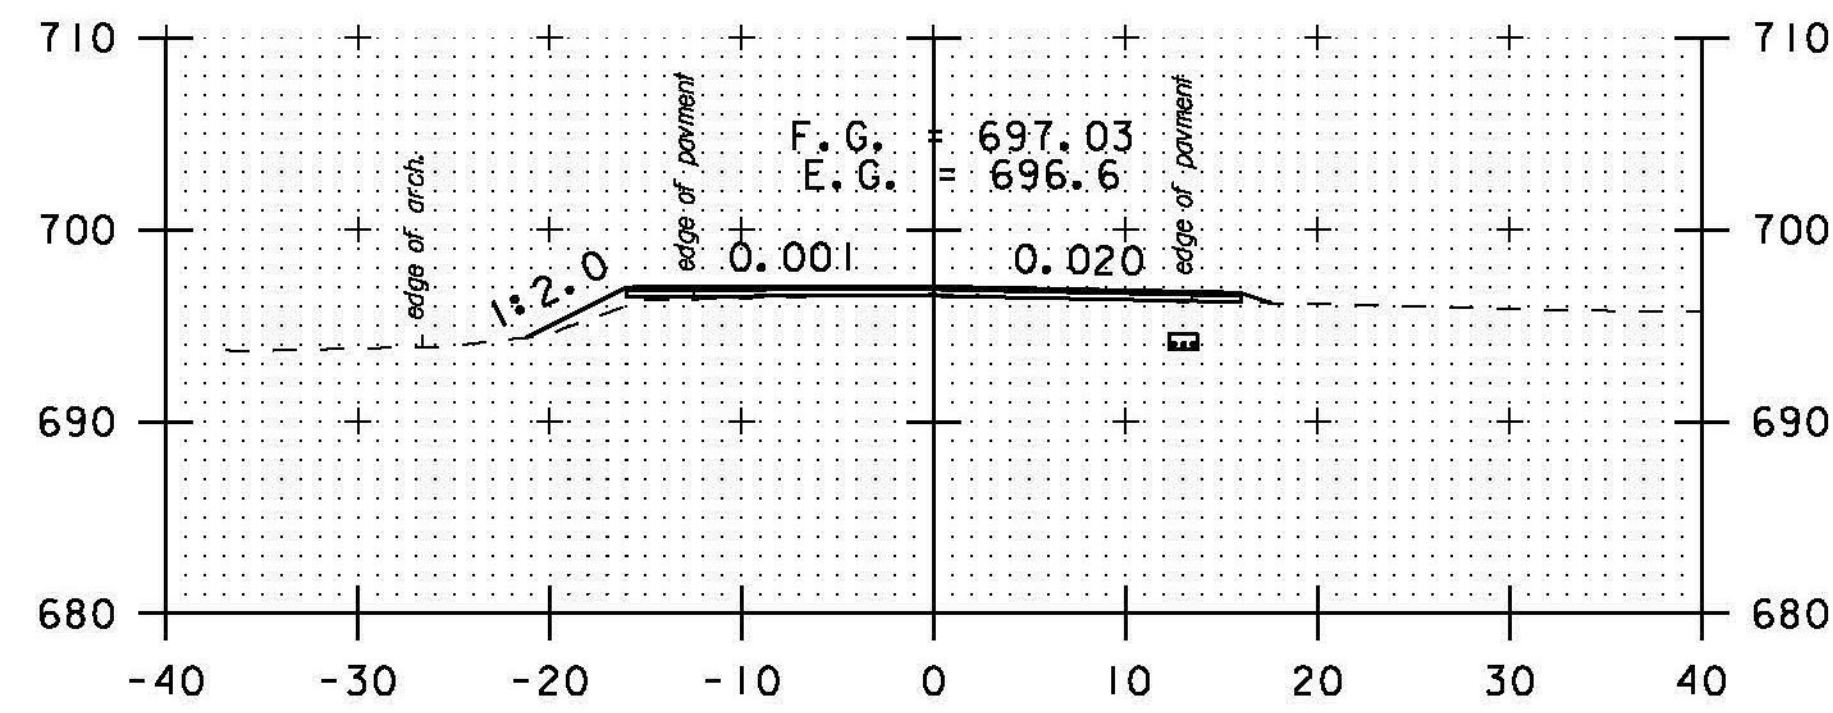


DRIVE RT
275+00

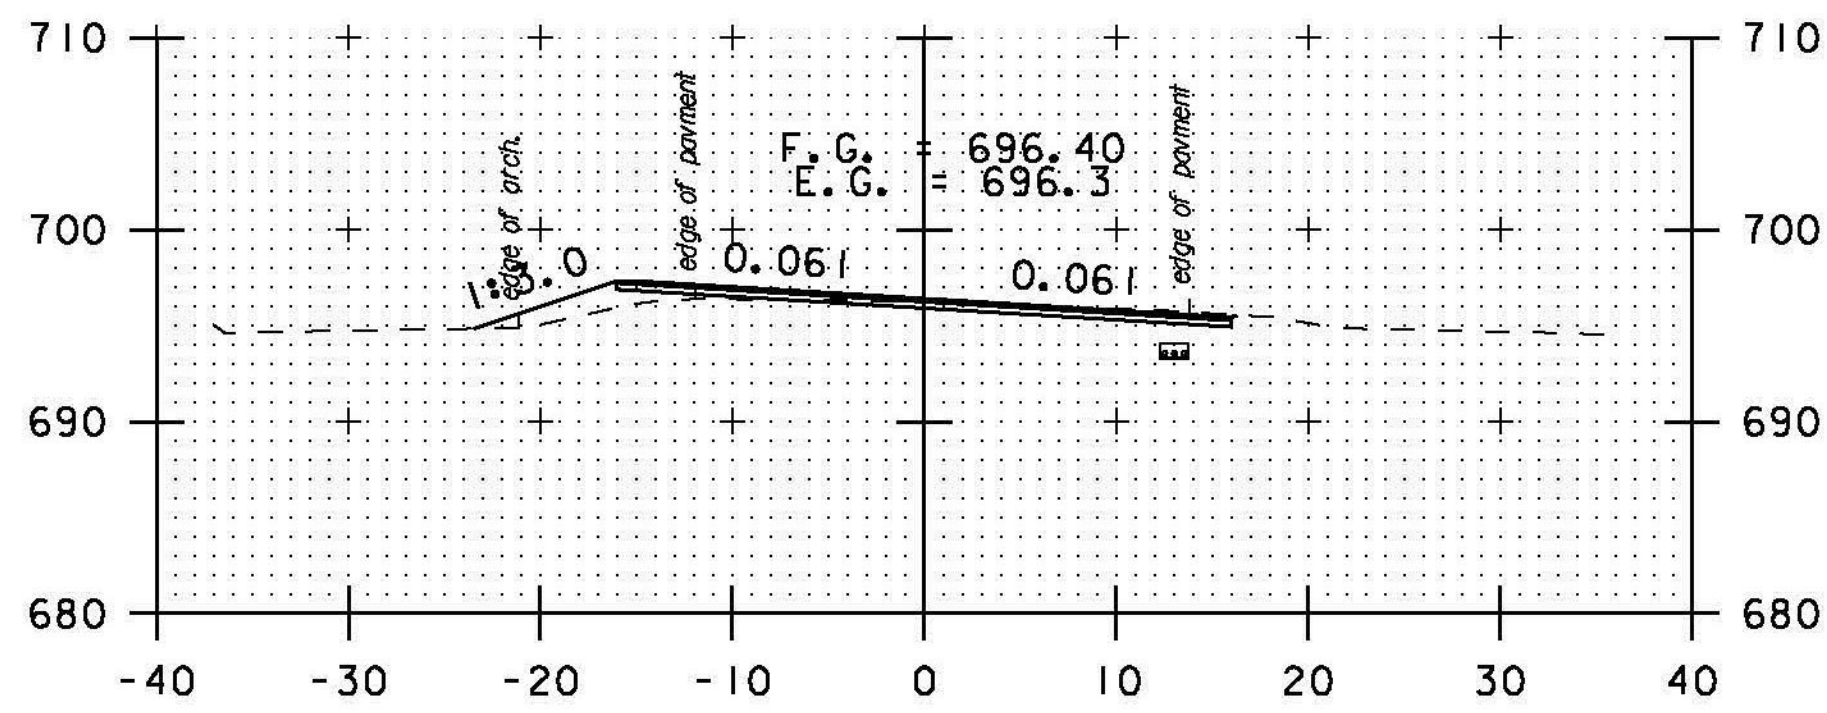


276+50

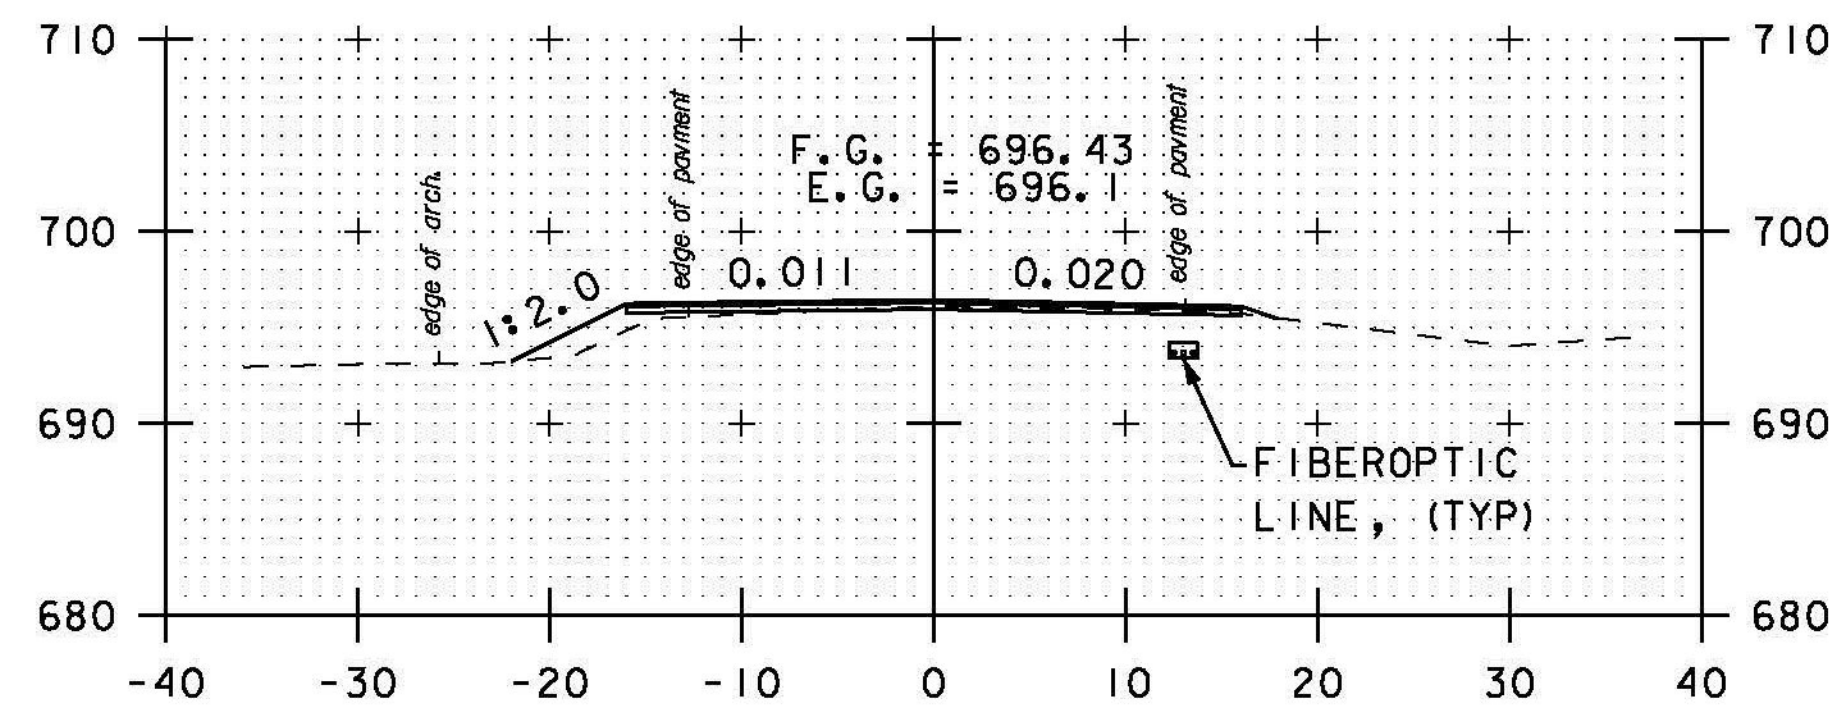


274+50

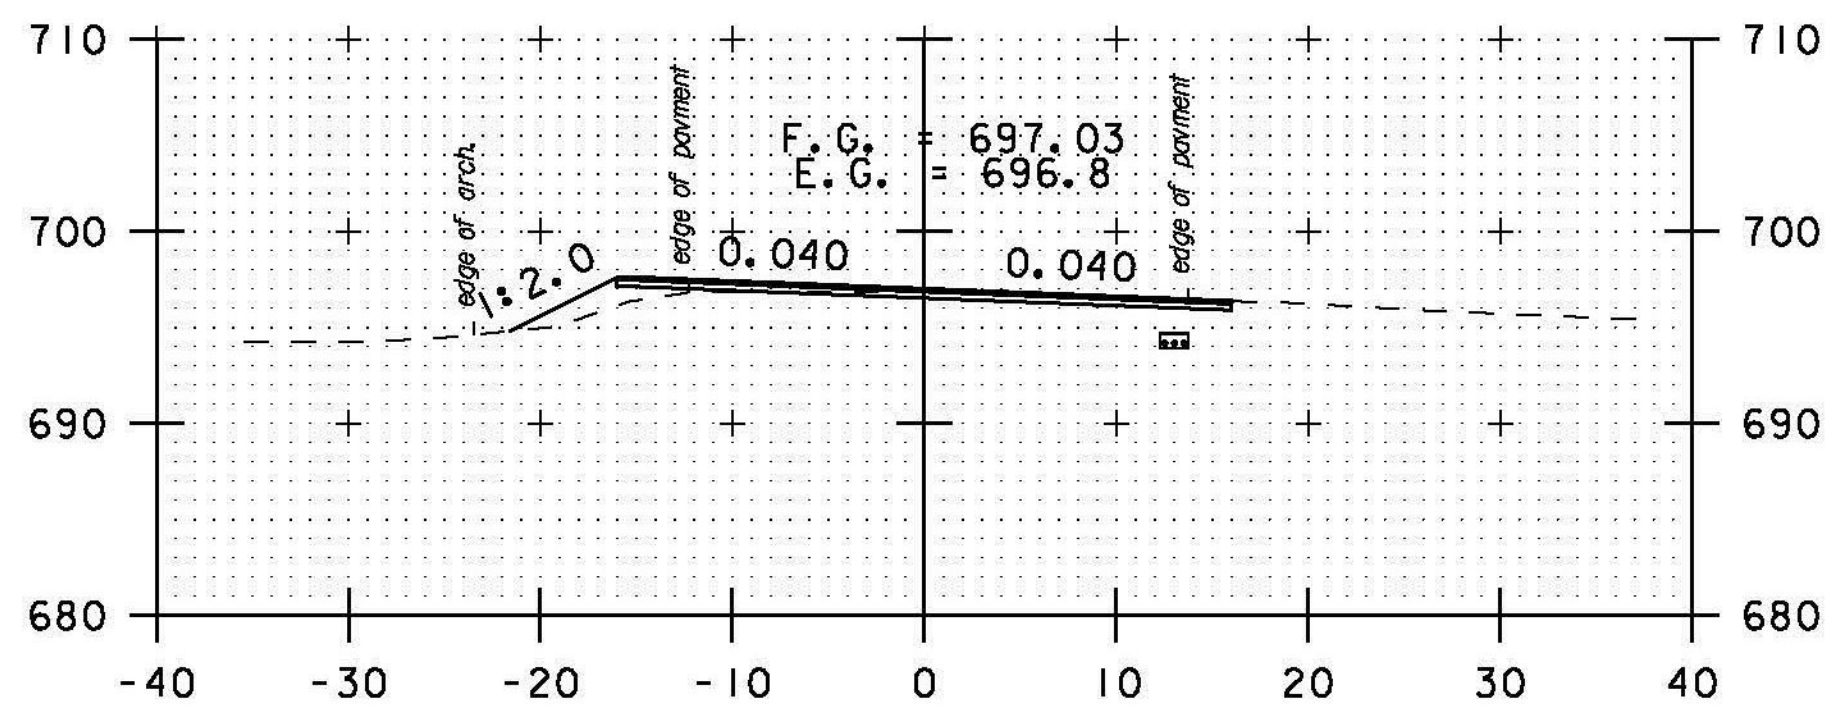


276+00

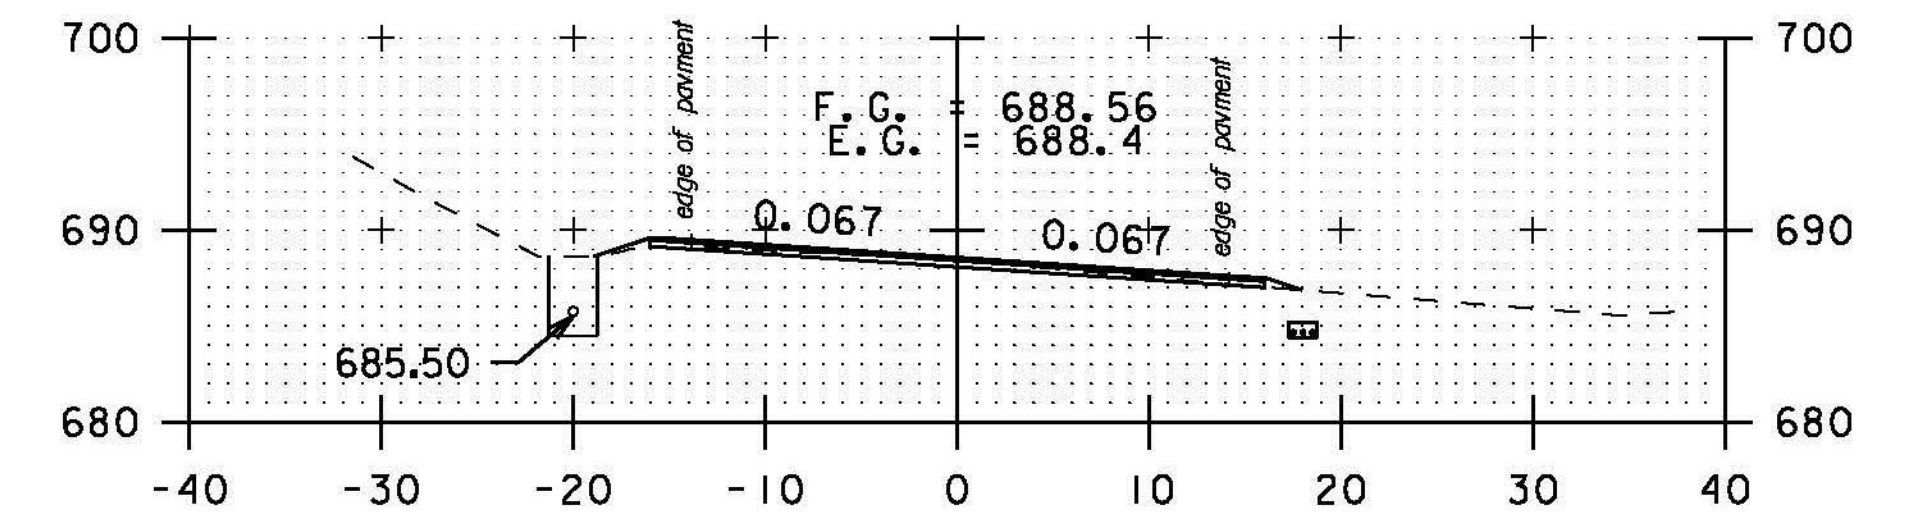


PULL OFF RT
279+00

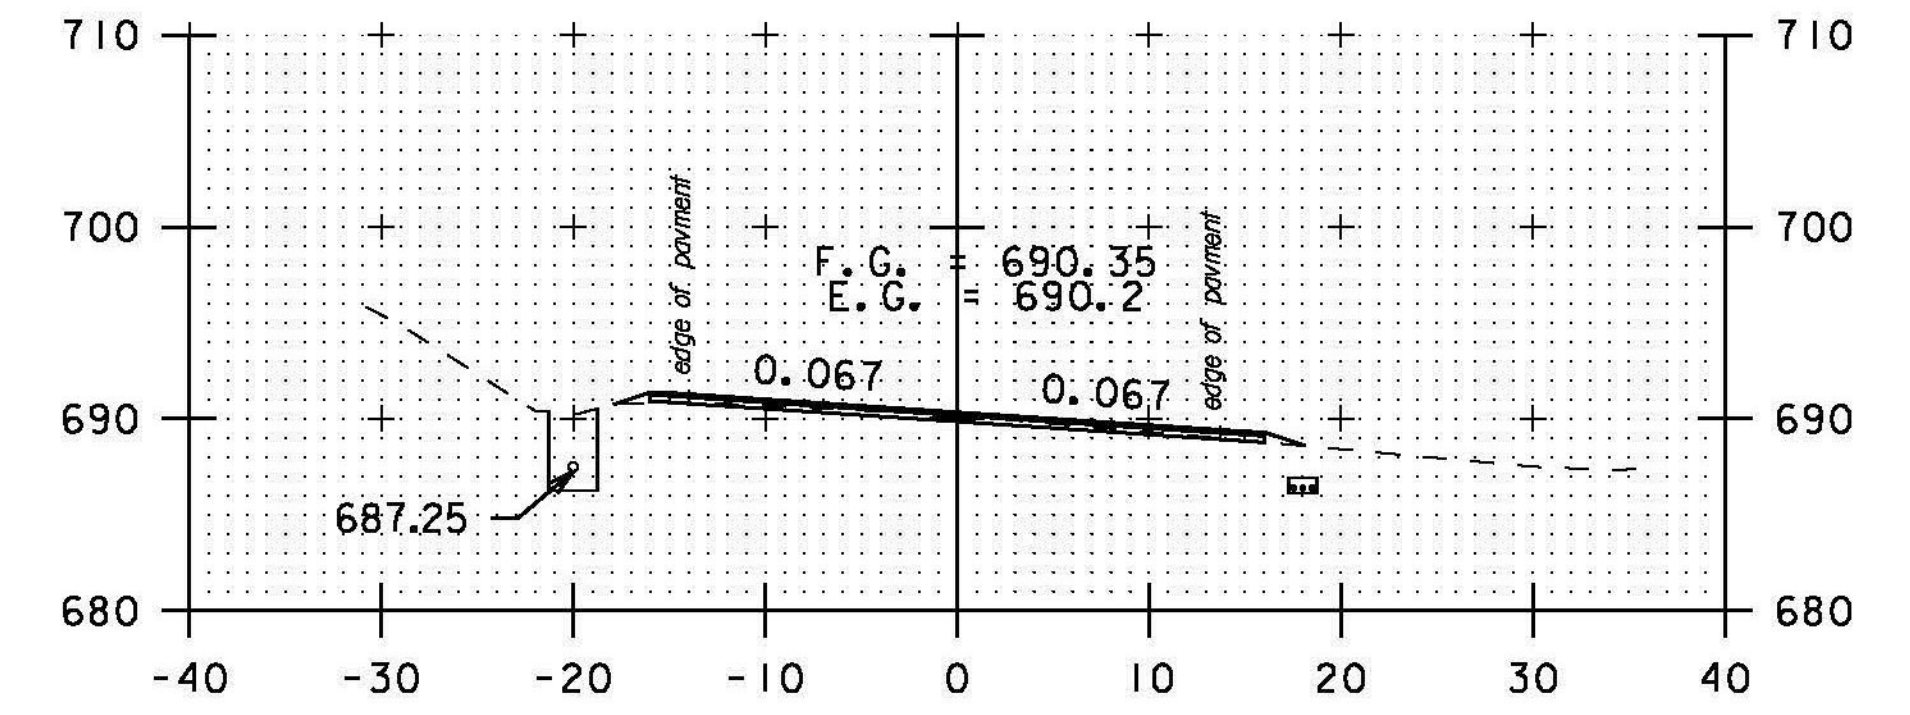


PULL OFF RT
278+50

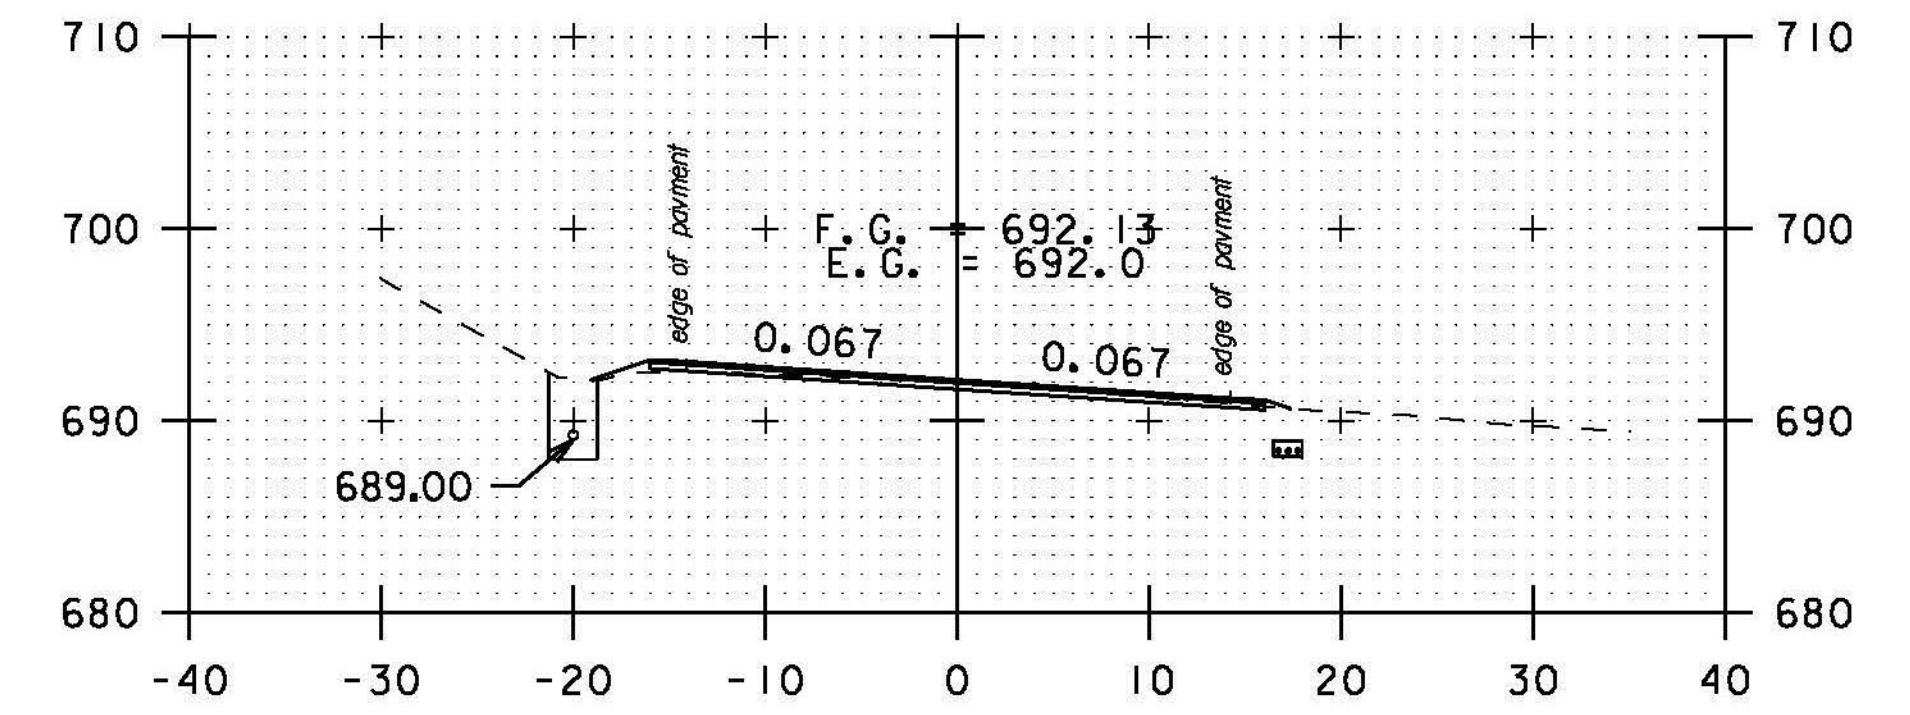

PULL OFF RT
278+00

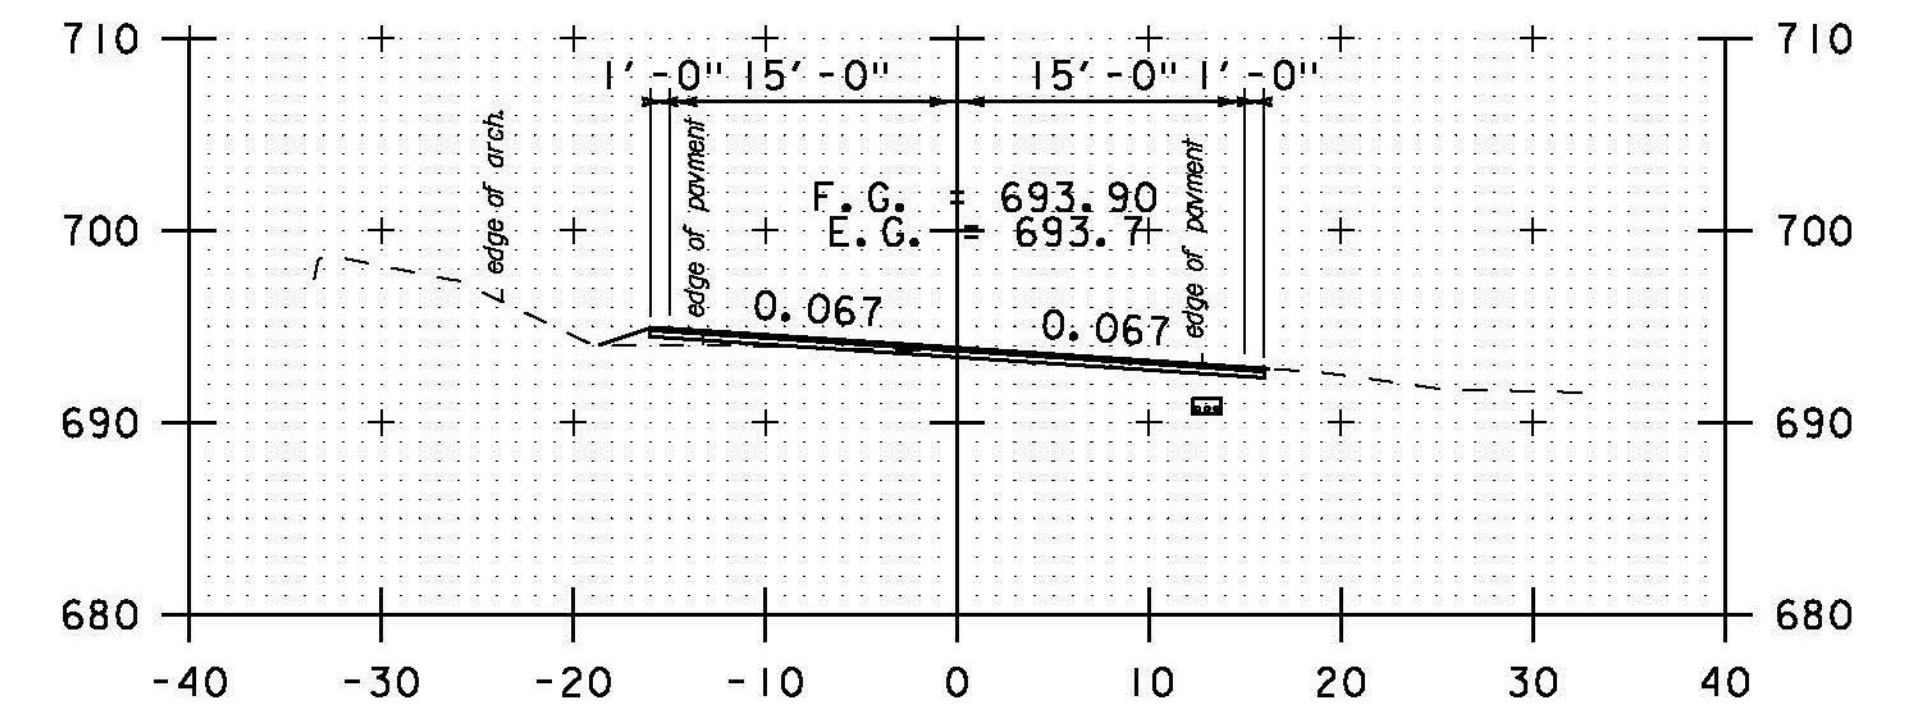

277+50

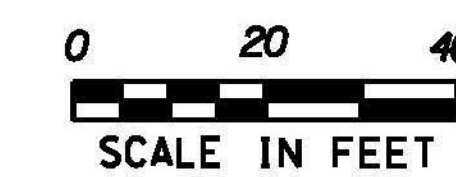

STA. 274+50 TO STA. 279+00

PROJECT NAME: BETHEL-RANDOLPH
PROJECT NUMBER: STP 292(I)

FILE NAME: piOC244.dgn
PROJECT LEADER: C. LATHROP
DESIGNED BY: S. LAMPHERE
CROSS SECTION SHEET 30

PLOT DATE: 4/23/2015
DRAWN BY: S. LAMPHERE
CHECKED BY: C. LATHROP
SHEET 164 OF 211