




PULL OFF RT
280+50

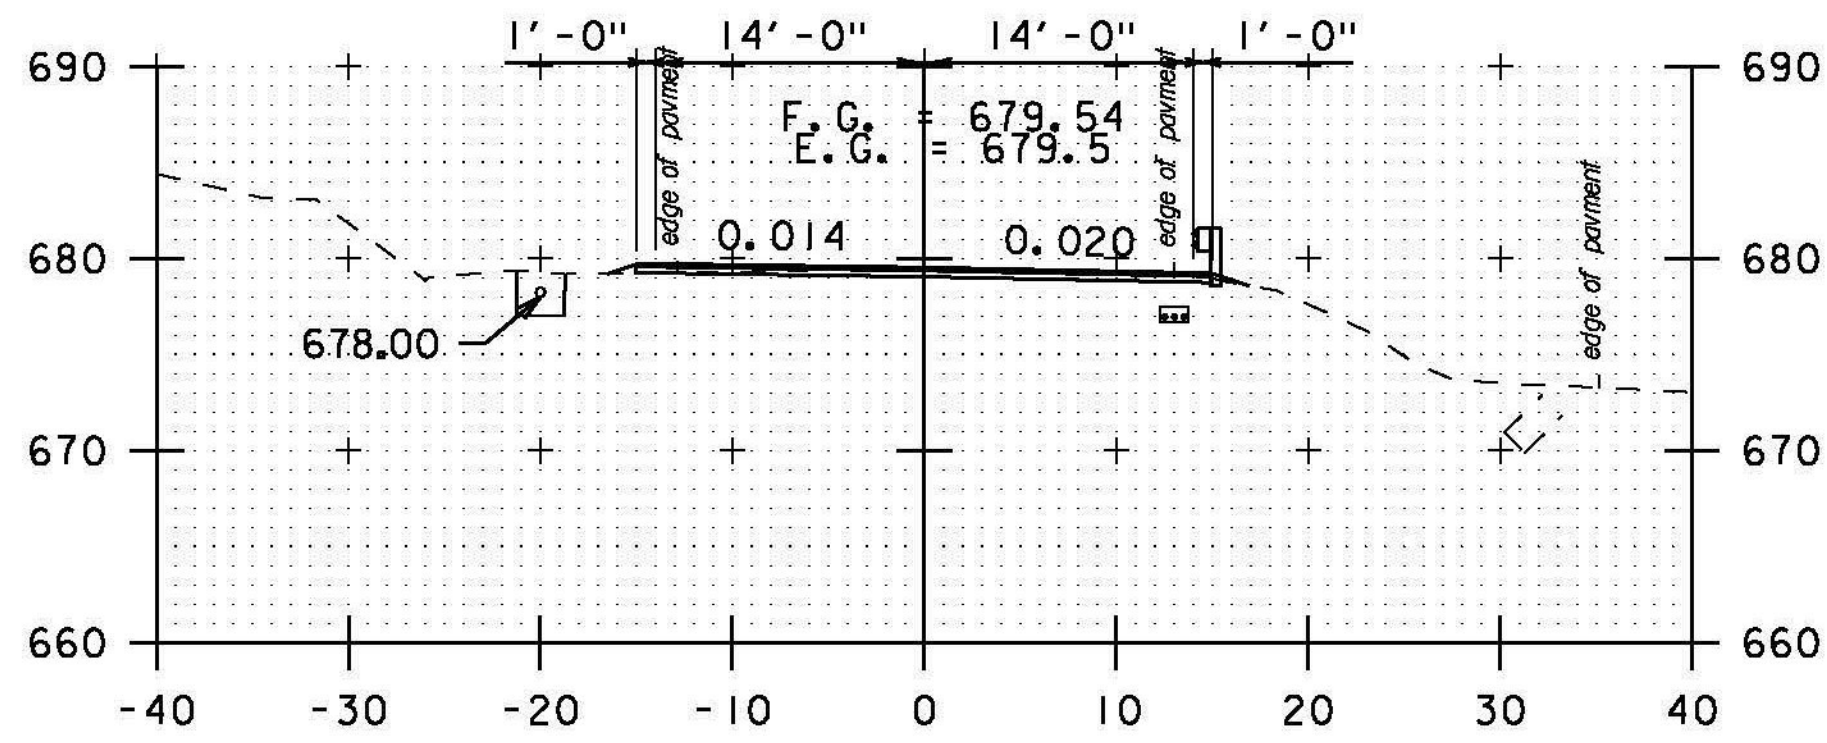


282+50

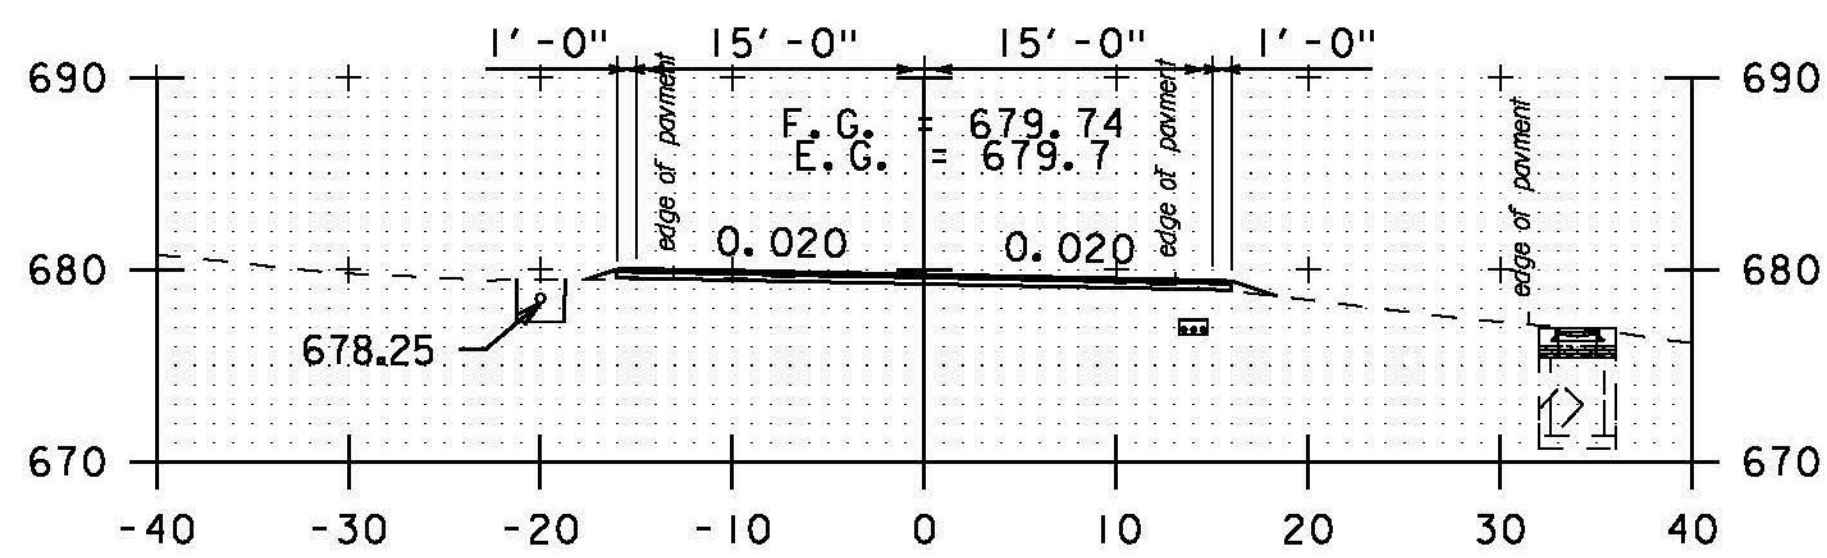


DRIVE LT & RT
282+00

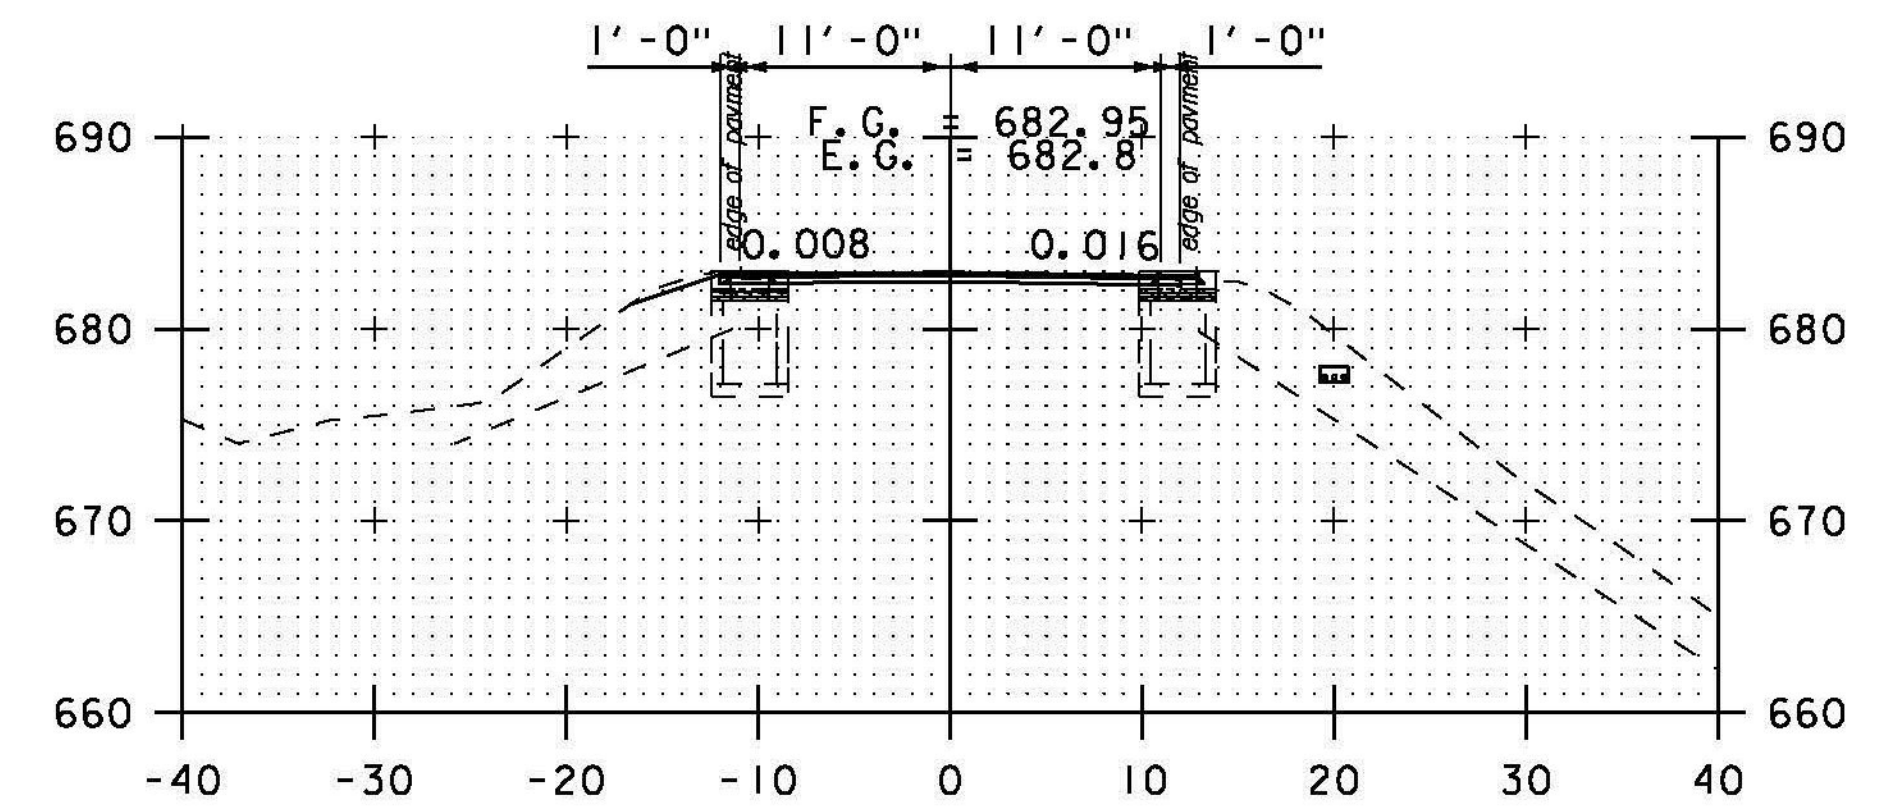


284+00

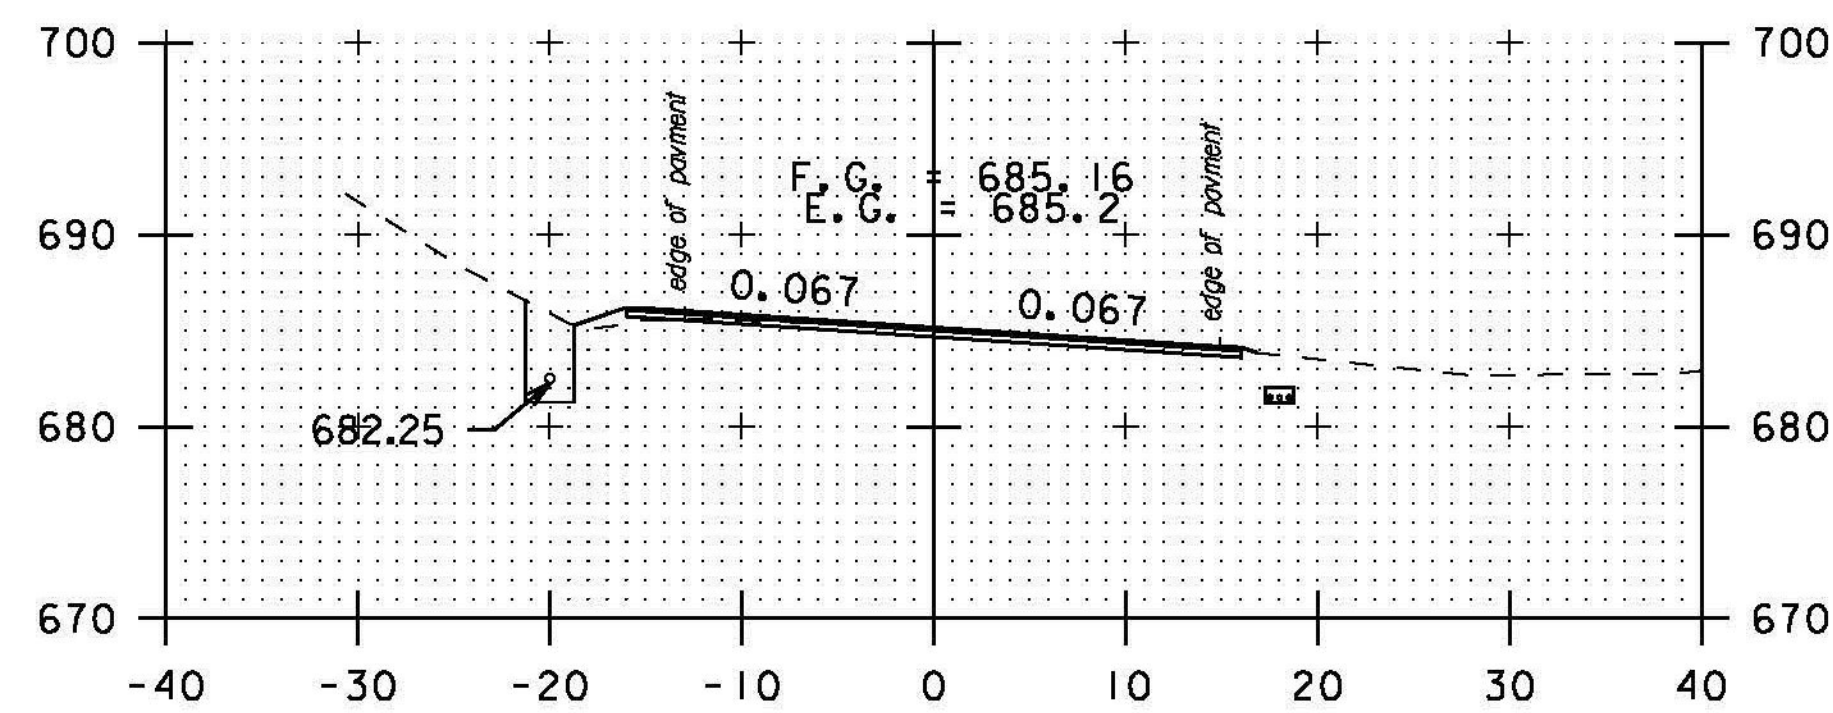


PULL OFF RT
280+00

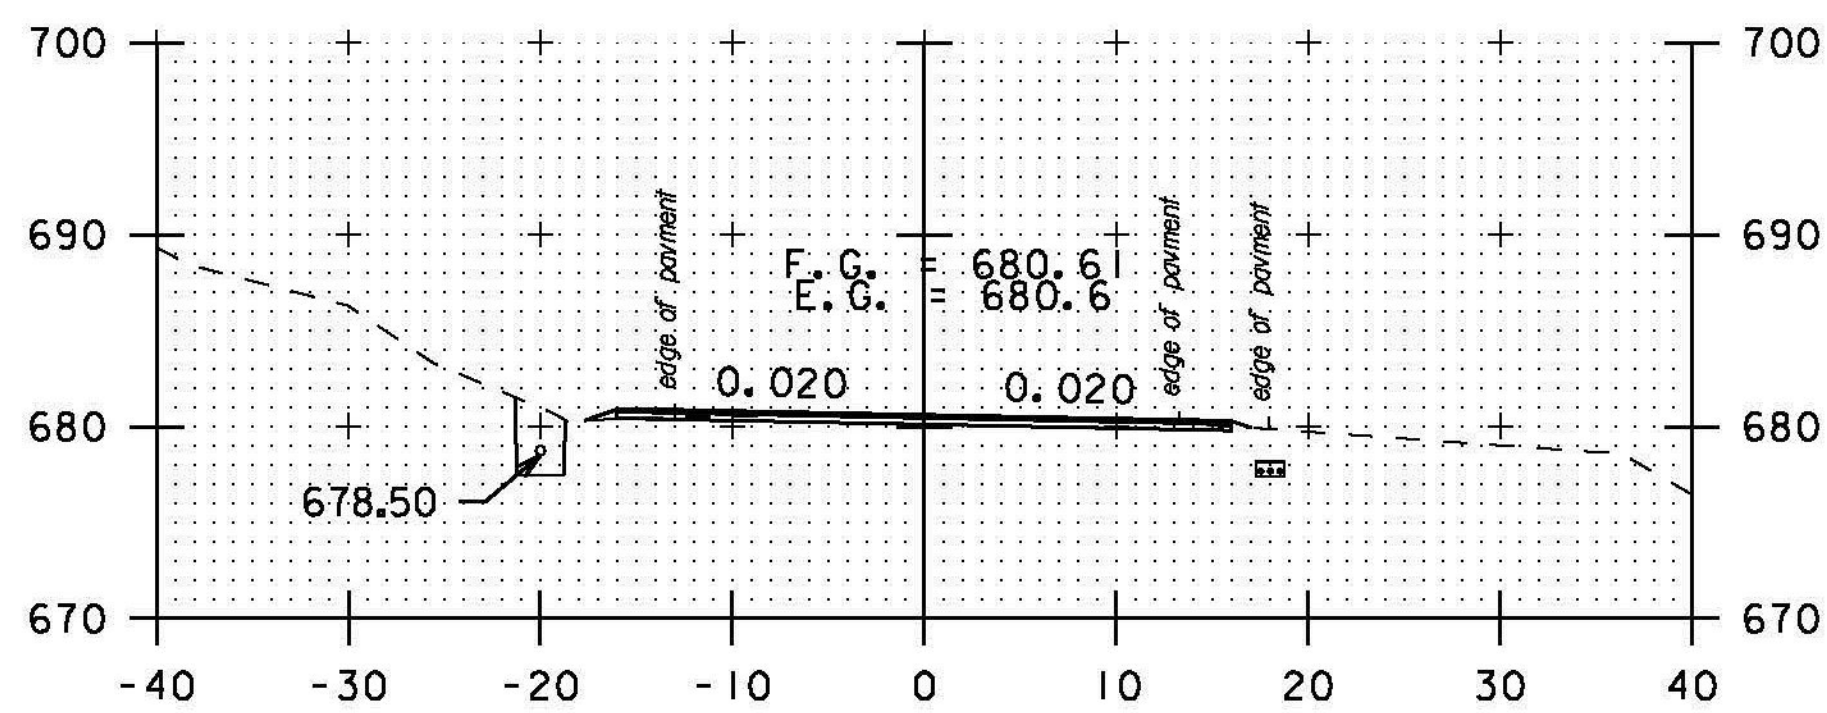


PULL OFF RT
281+50

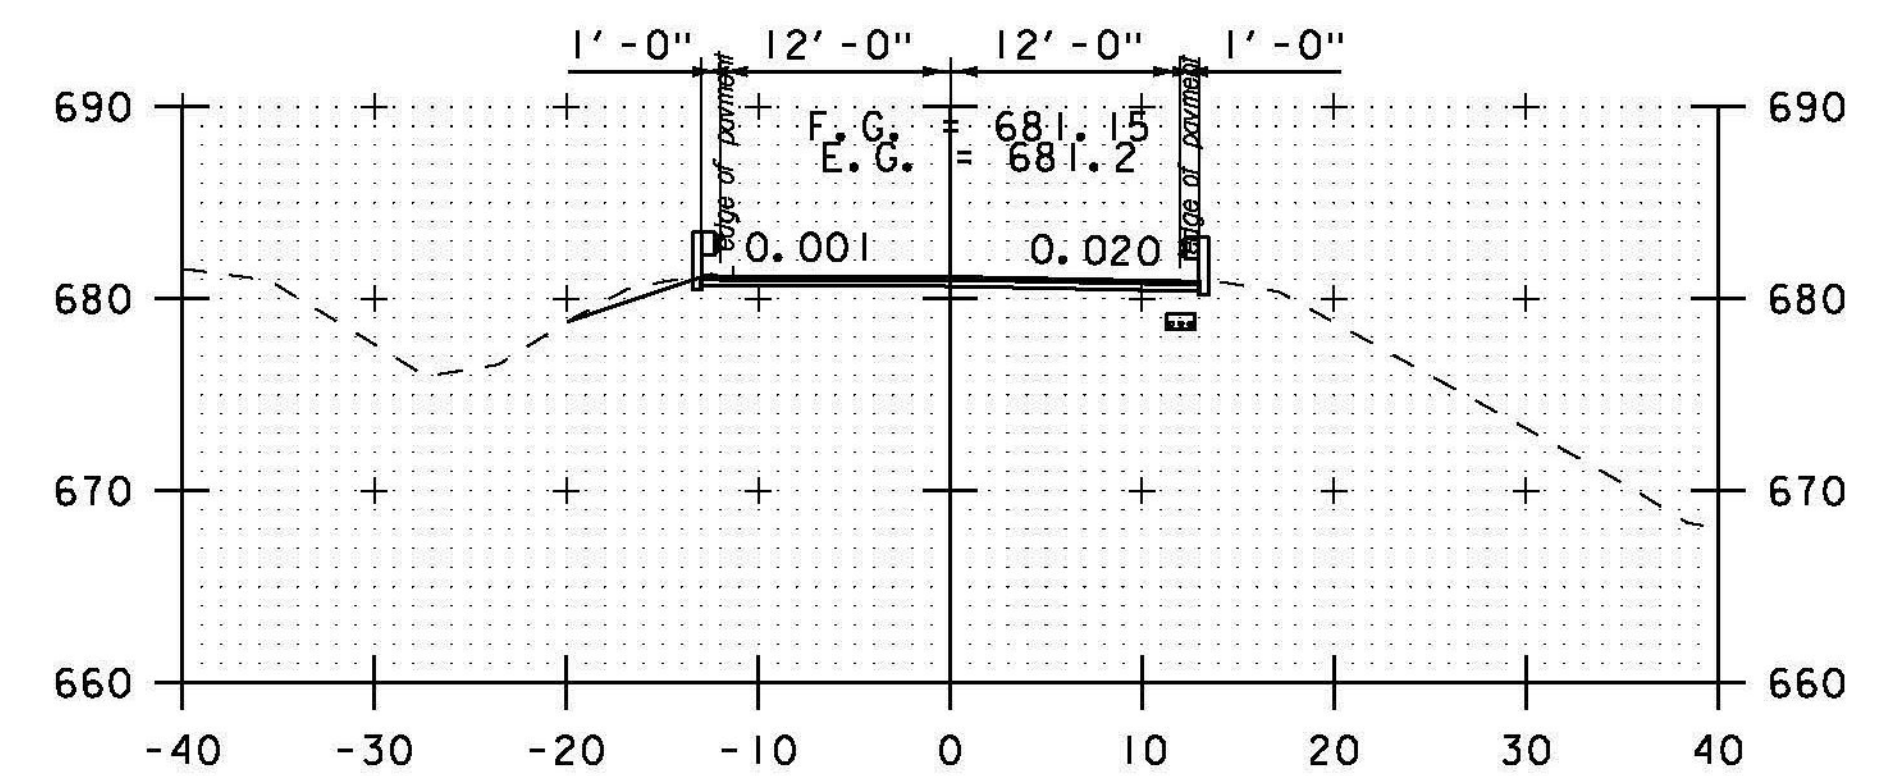


283+50

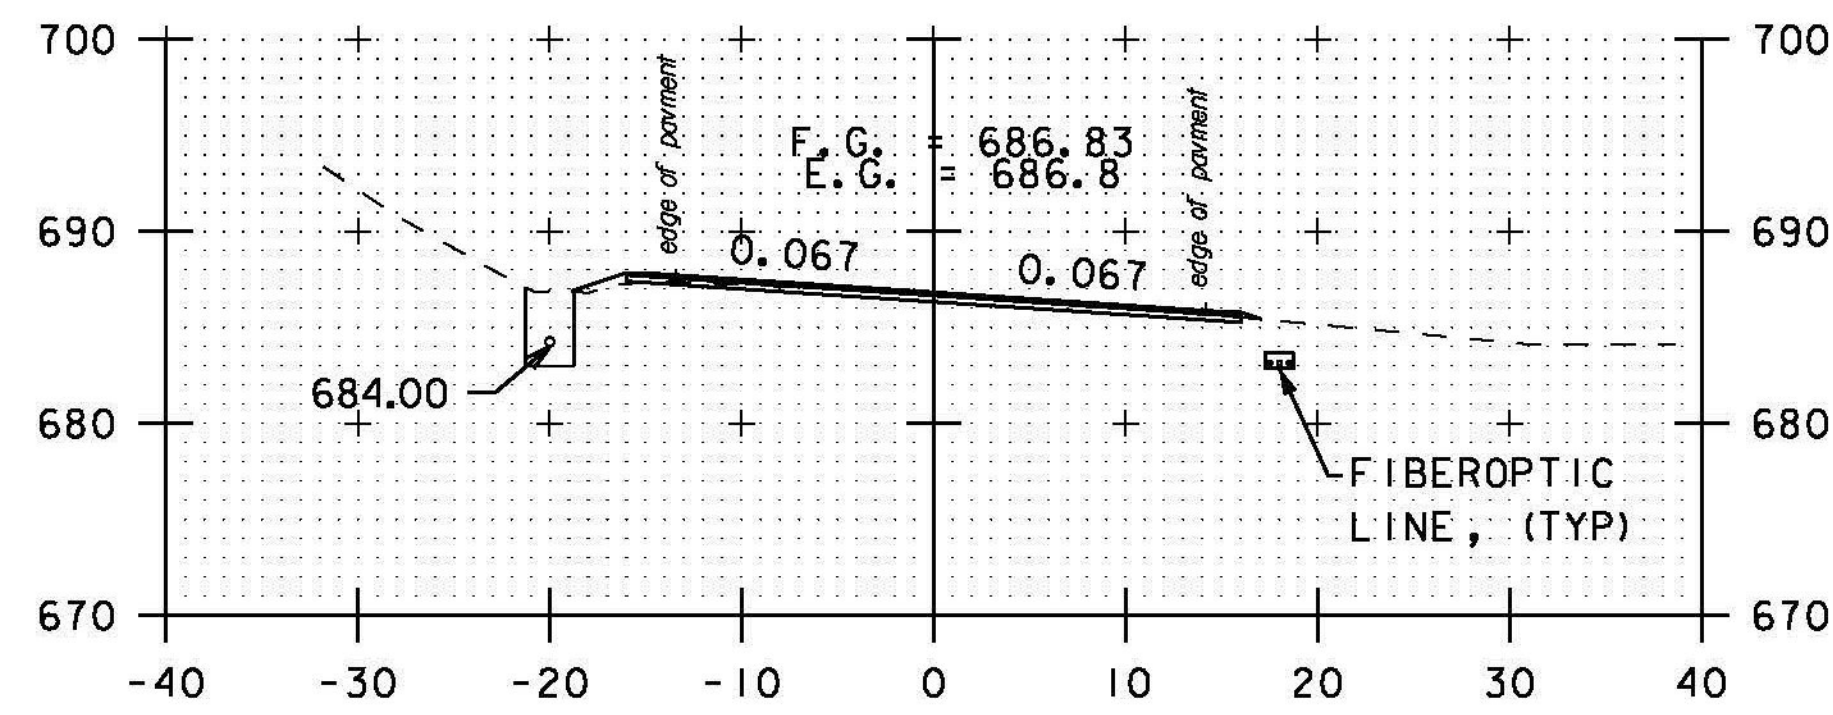

PULL OFF RT
279+50

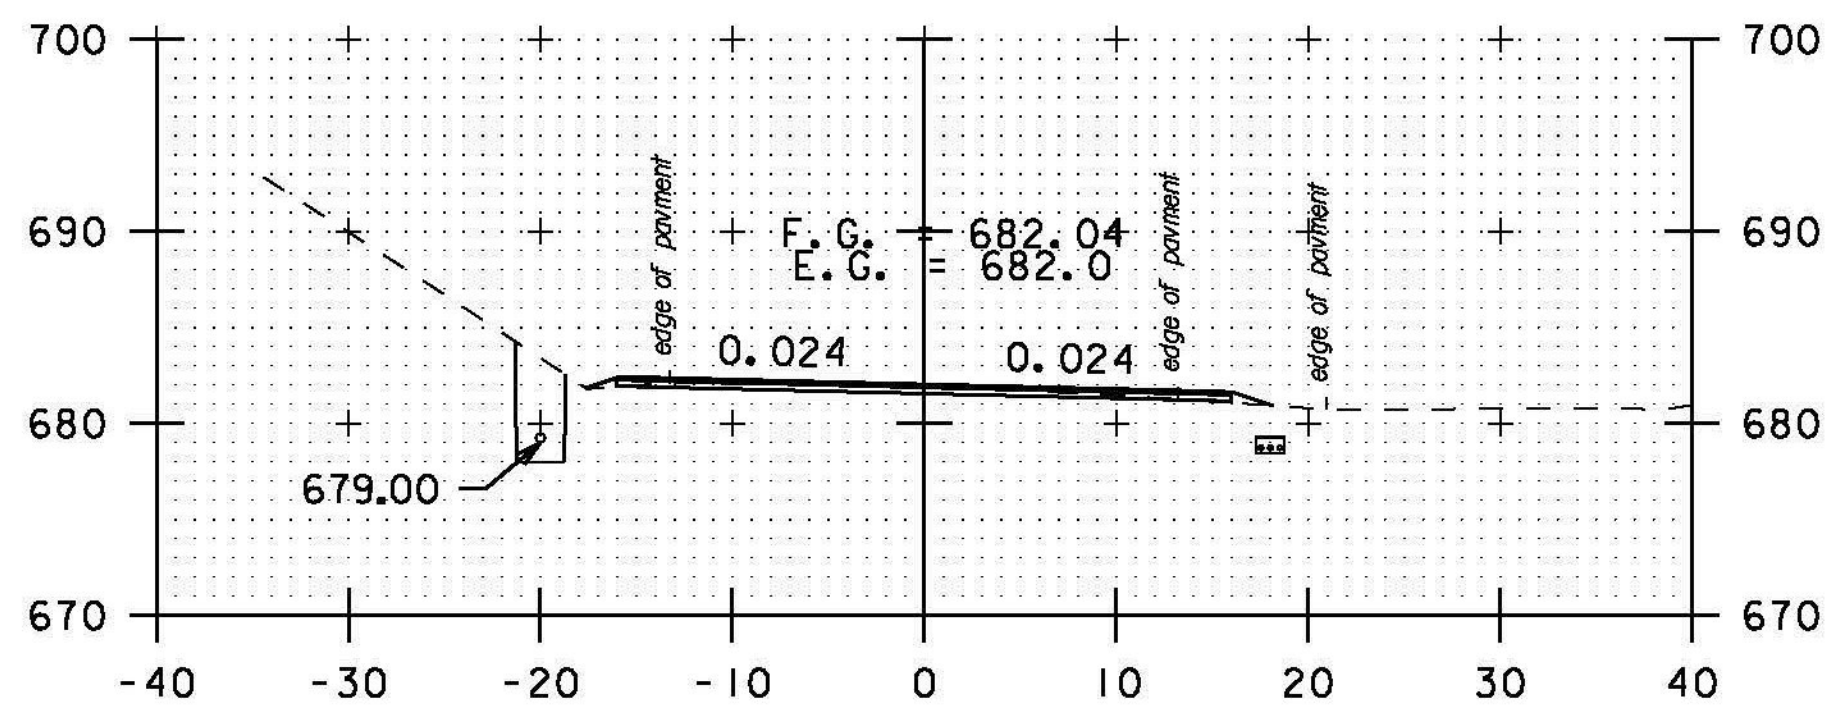


PULL OFF RT
281+00

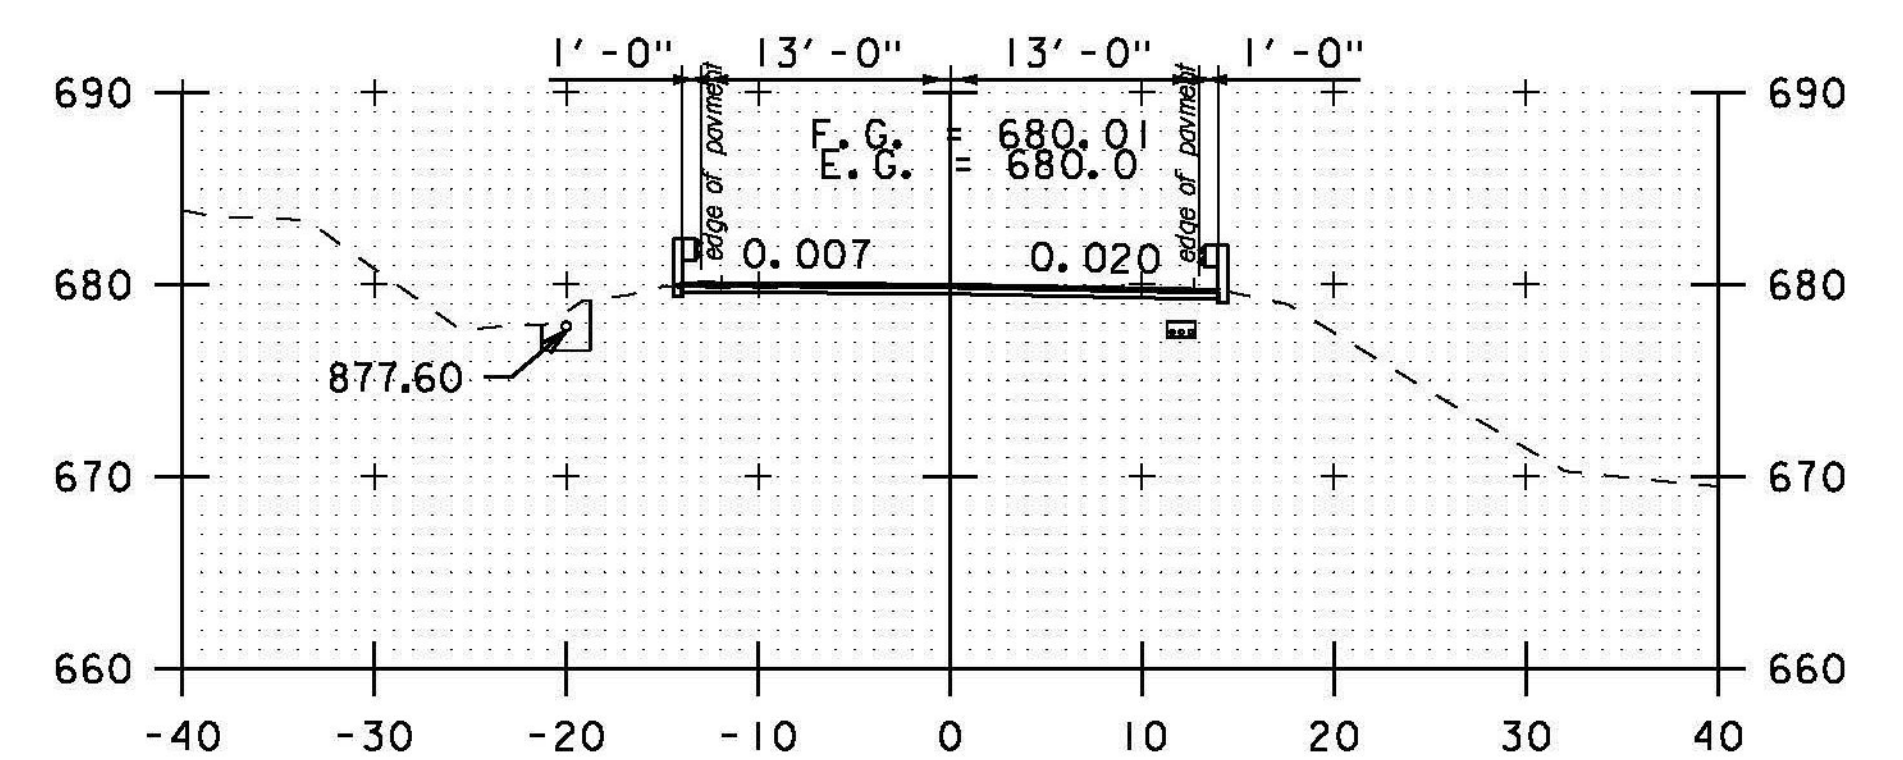

283+00

STA. 279+50 TO STA. 284+00

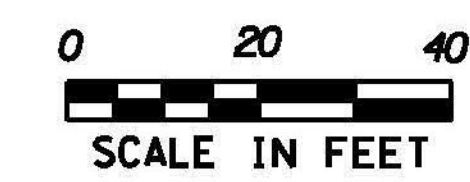

SCALE IN FEET

PROJECT NAME: BETHEL-RANDOLPH
PROJECT NUMBER: STP 292(I)

FILE NAME: piOC244.dgn
PROJECT LEADER: C. LATHROP
DESIGNED BY: S. LAMPHERE
CROSS SECTION SHEET 31

PLOT DATE: 4/23/2015
DRAWN BY: S. LAMPHERE
CHECKED BY: C. LATHROP
SHEET 165 OF 211