




BRIDGE SECTION  
285+00

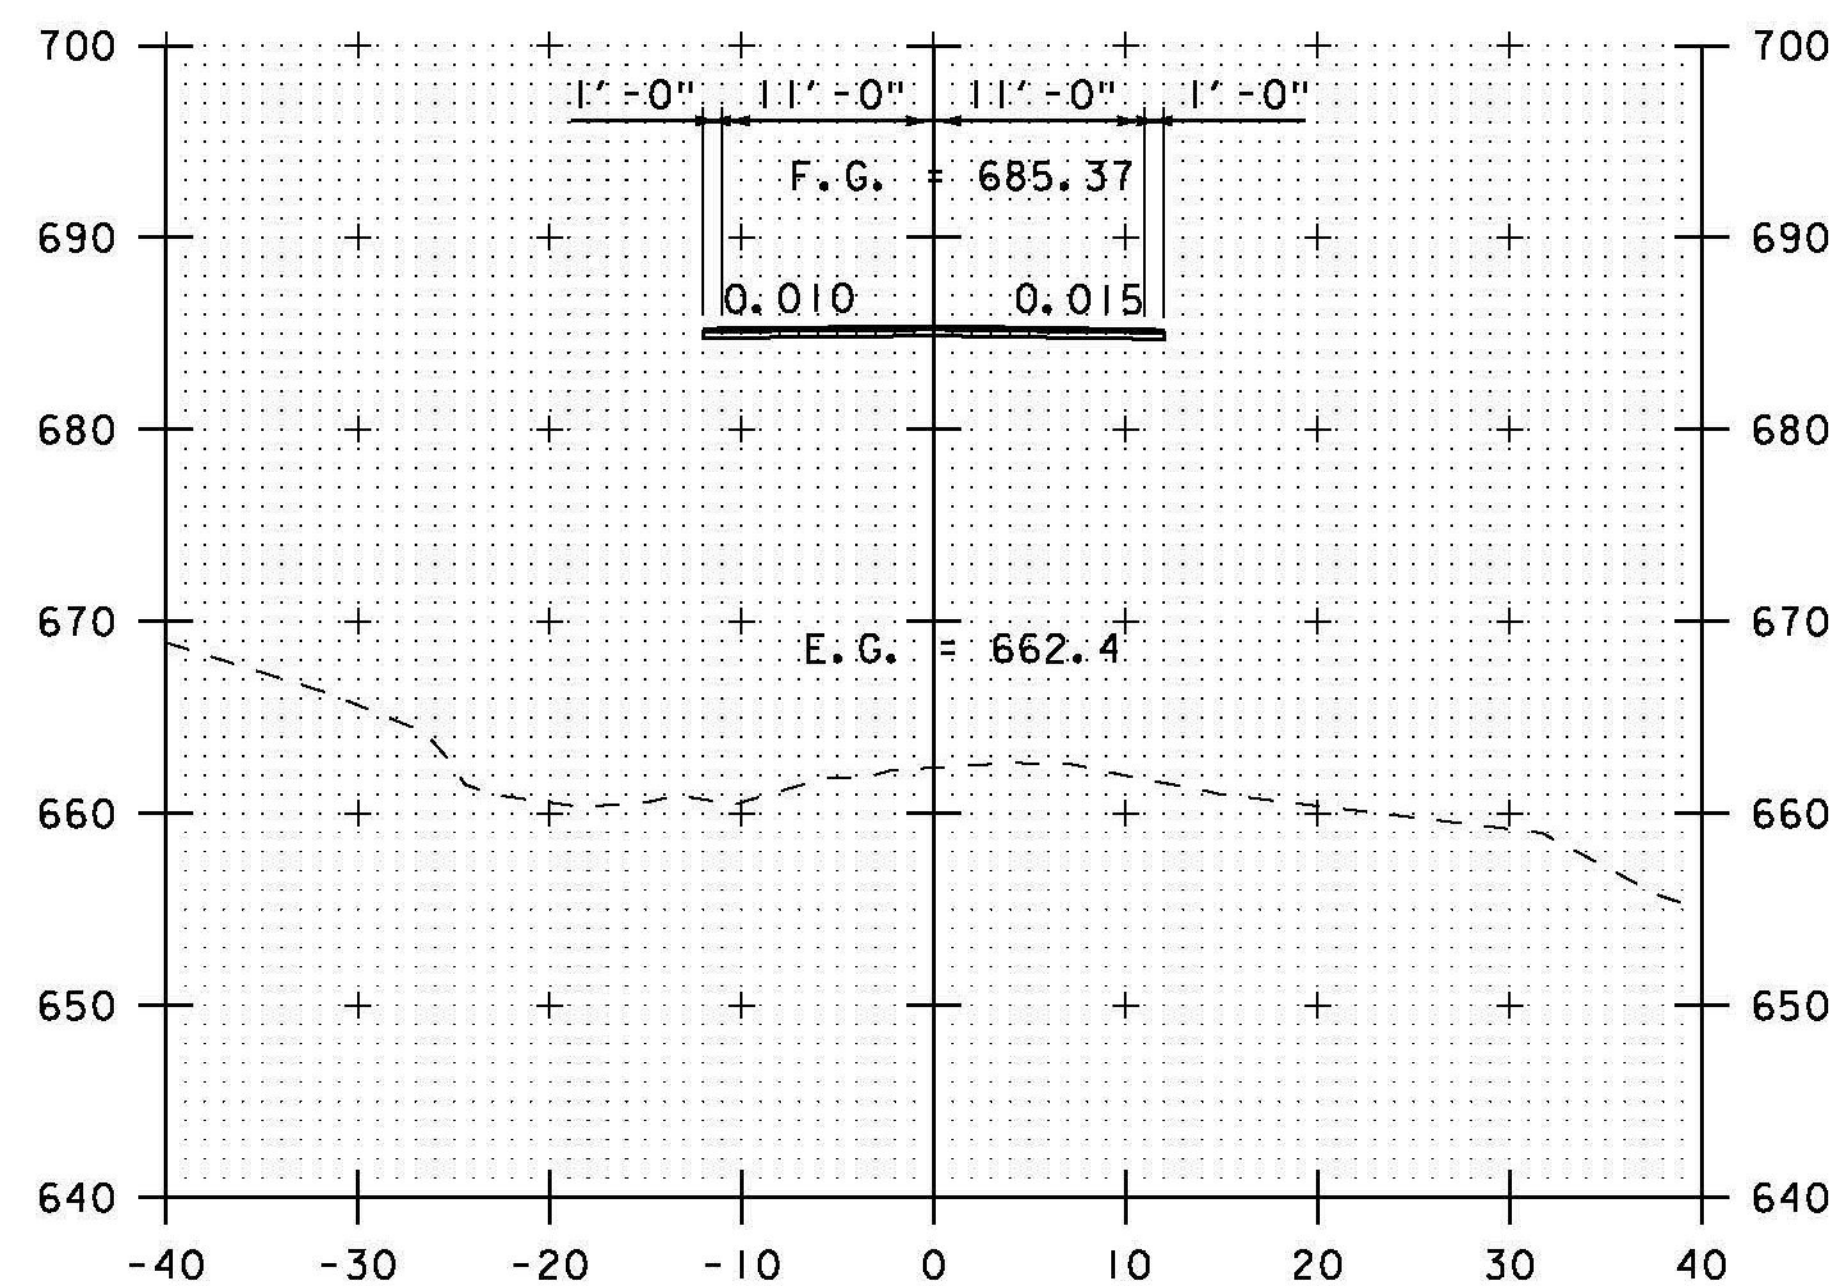


BRIDGE SECTION  
284+50

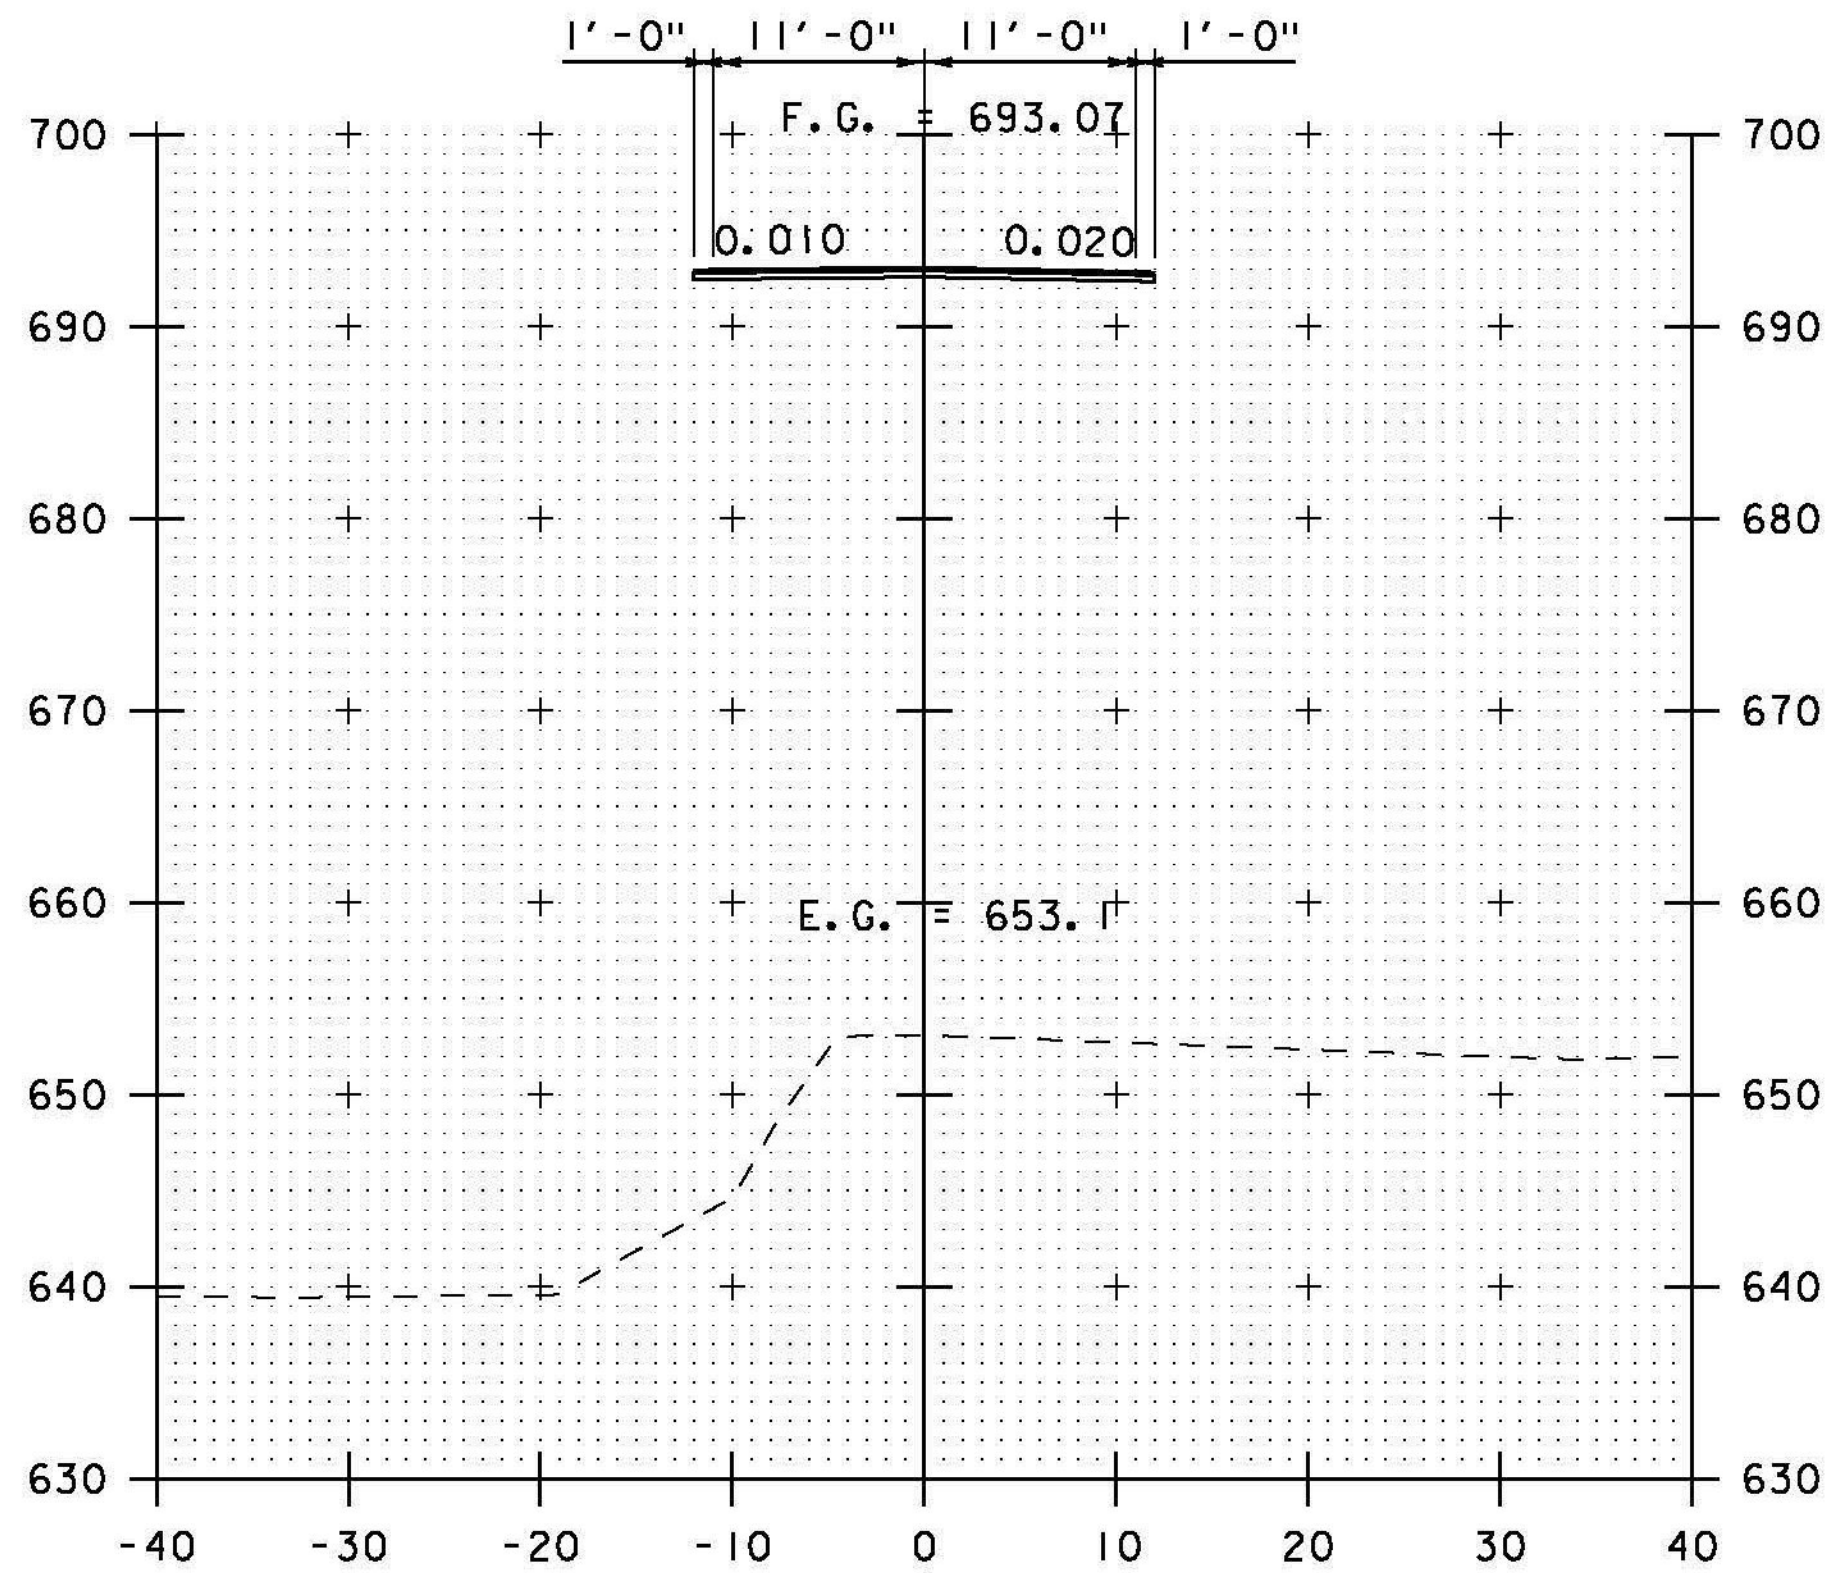


BRIDGE SECTION  
286+00

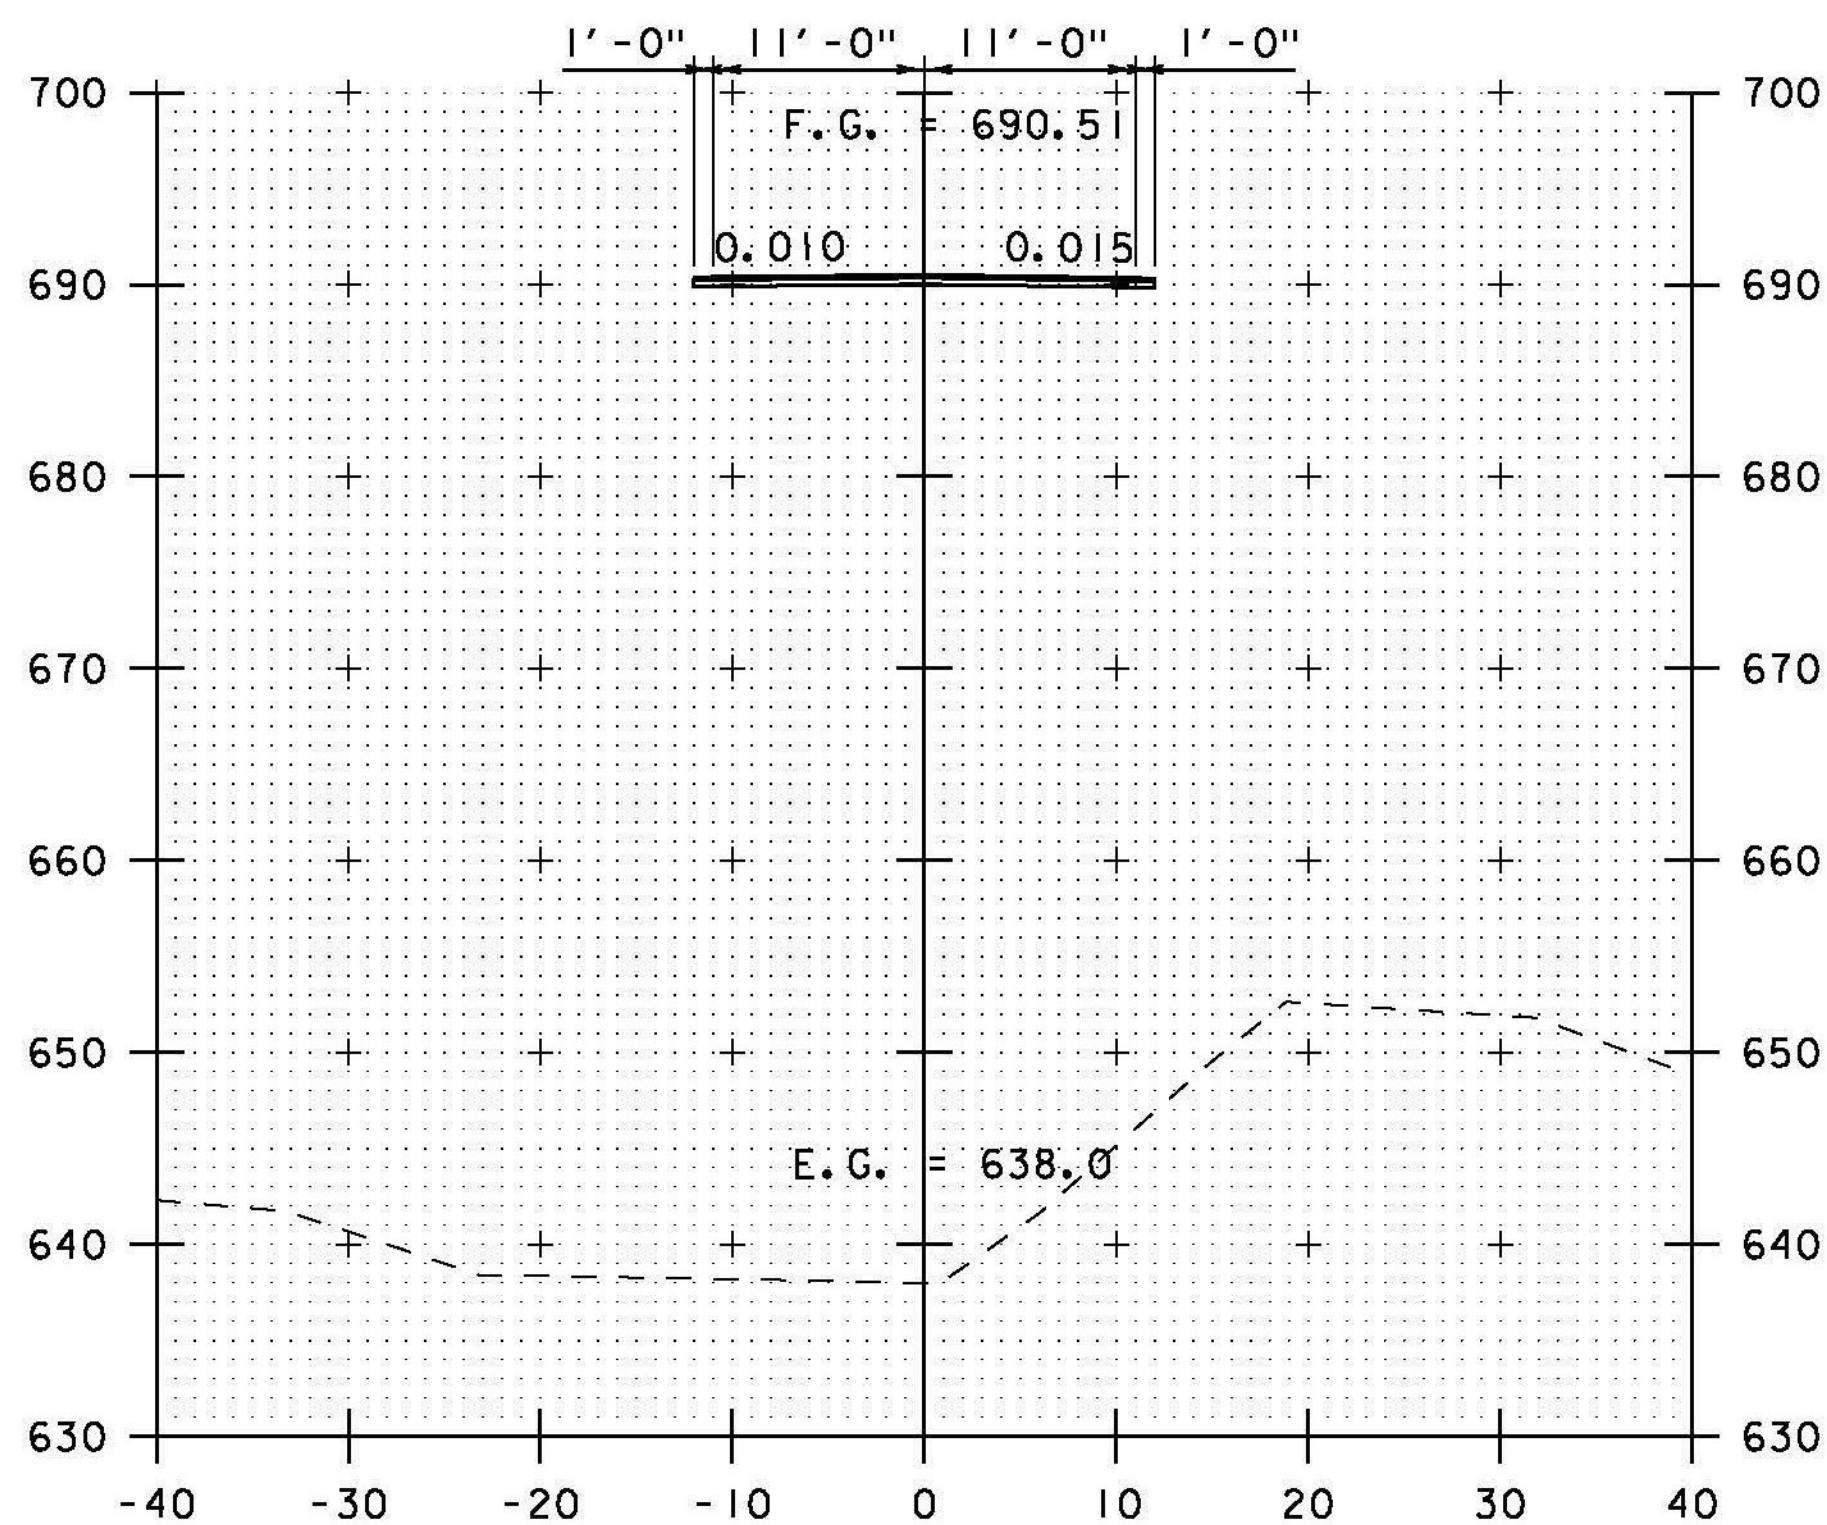

BRIDGE SECTION  
285+50

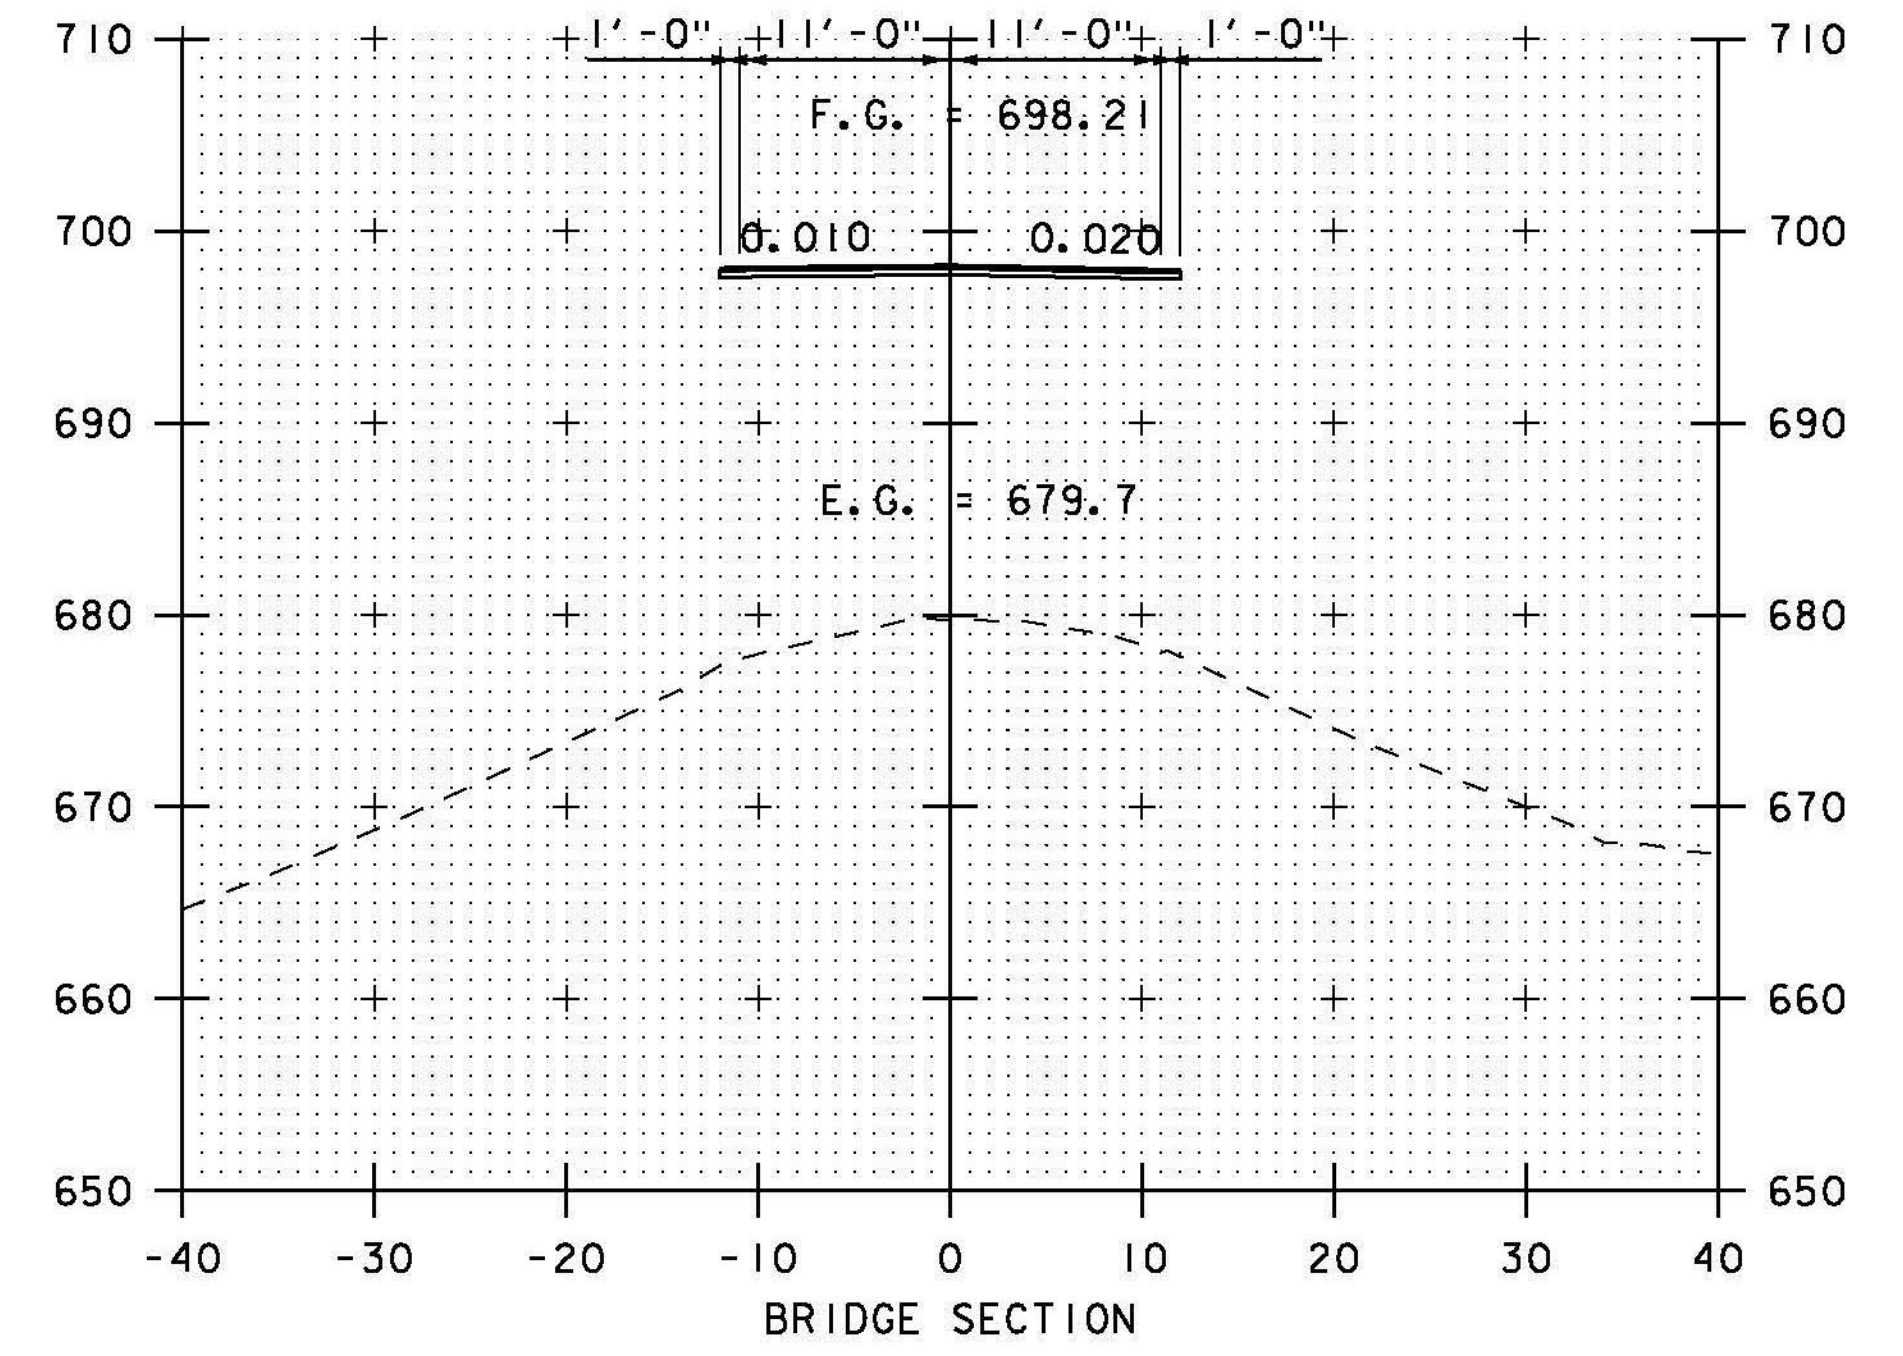


BRIDGE SECTION  
287+00

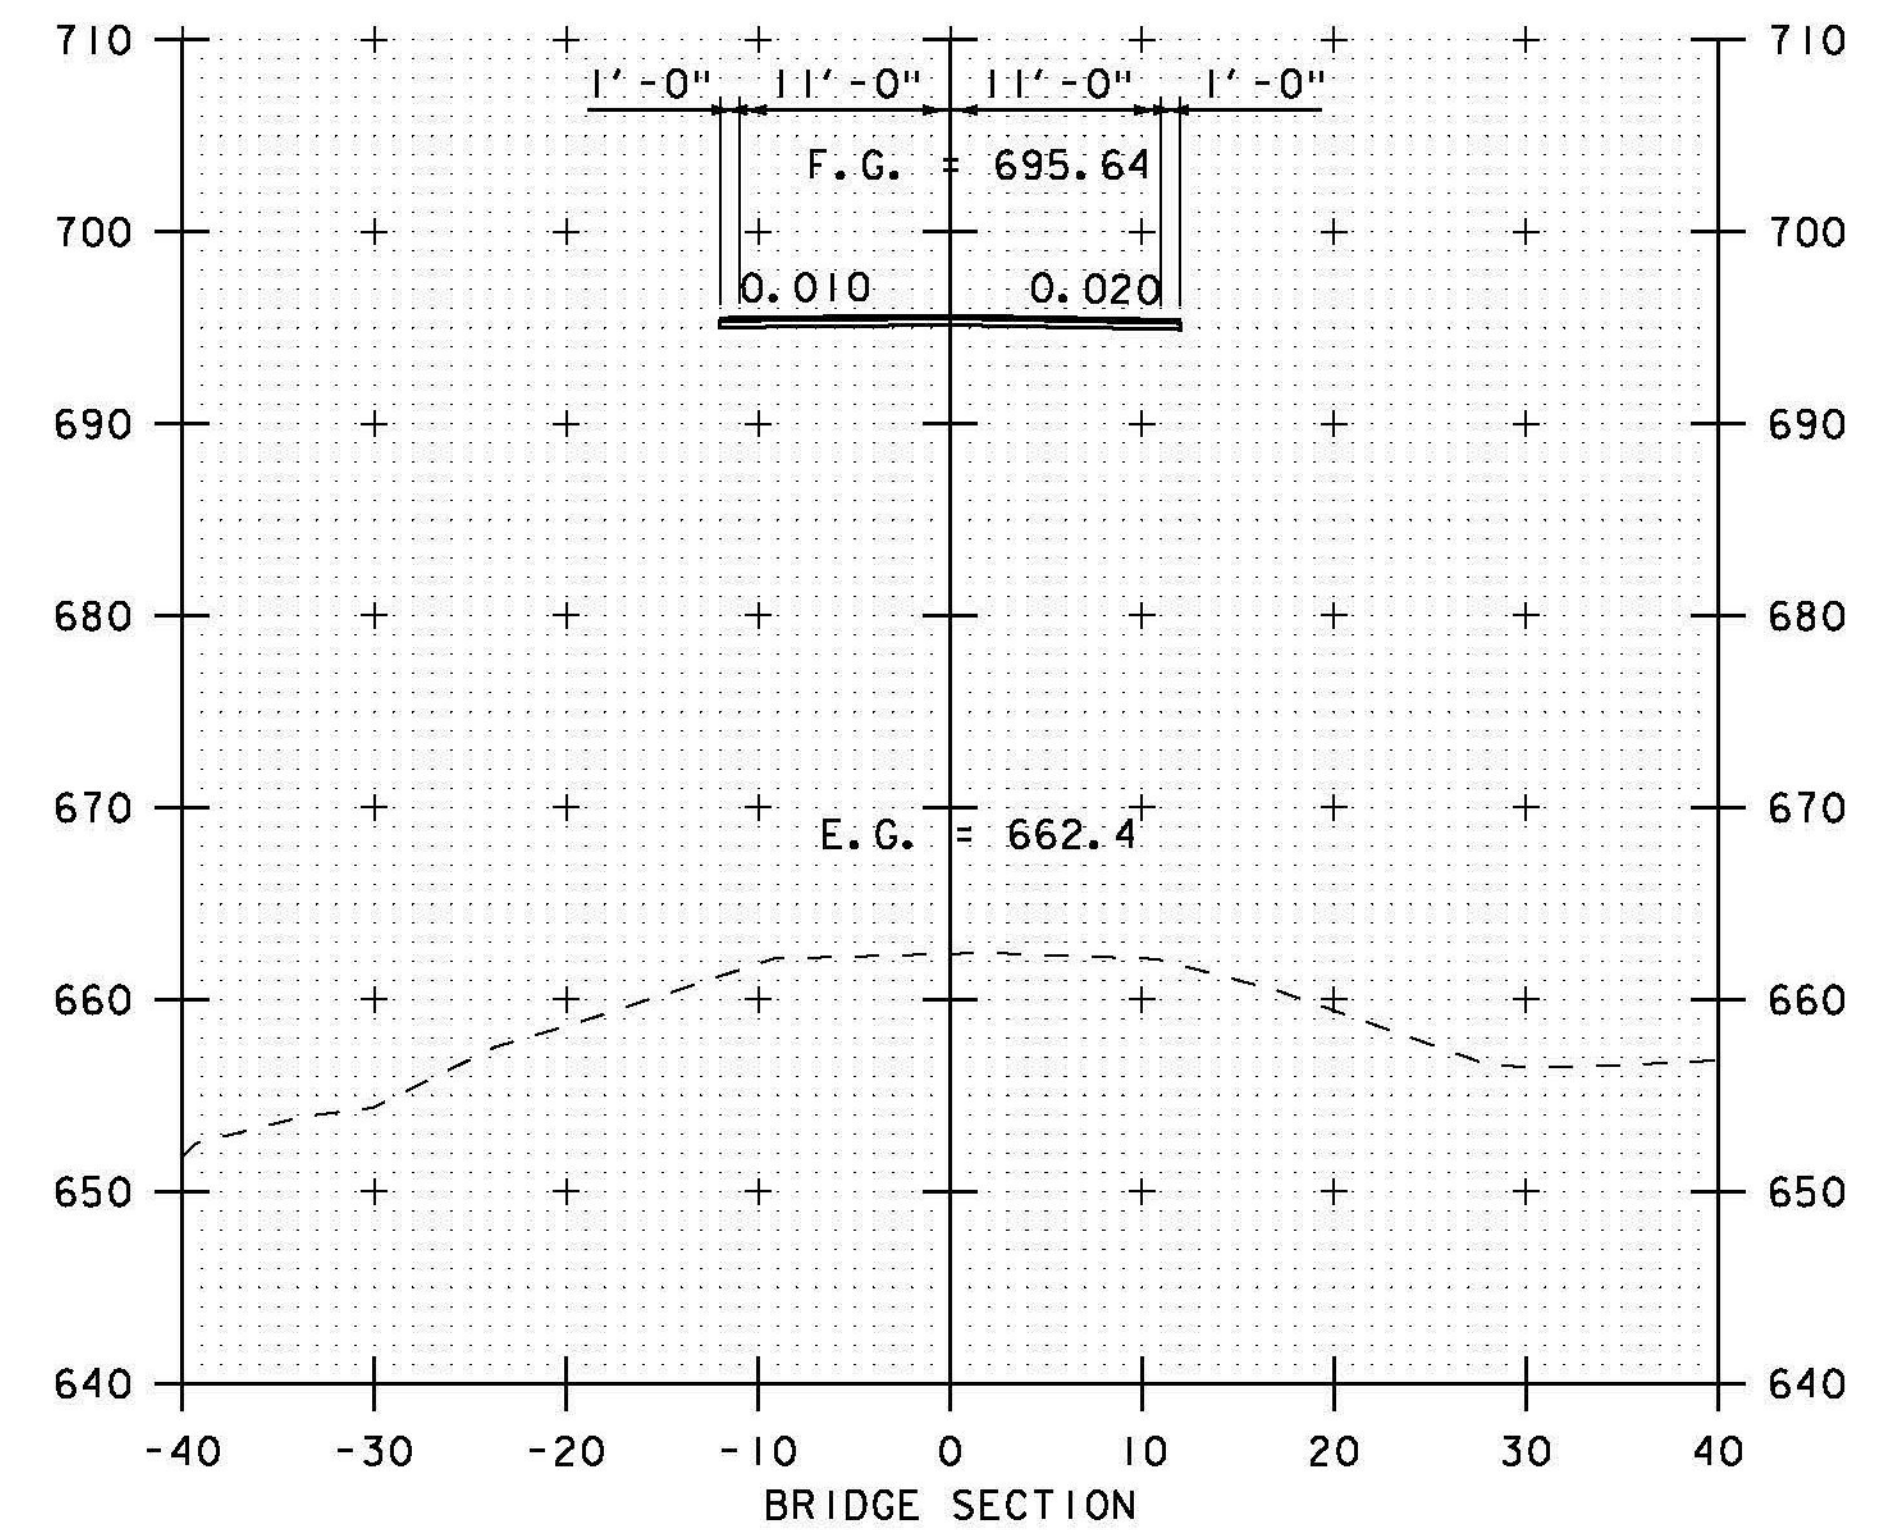

BRIDGE SECTION  
286+50

STA. 284+50 TO STA. 287+00

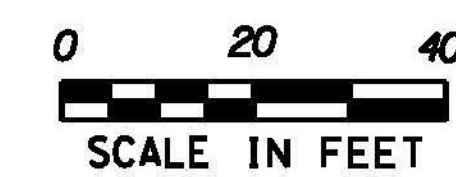

PROJECT NAME: BETHEL-RANDOLPH  
PROJECT NUMBER: STP 292(I)

FILE NAME: piOC244.dgn  
PROJECT LEADER: C. LATHROP  
DESIGNED BY: S. LAMPHERE  
CROSS SECTION SHEET 32

PLOT DATE: 4/23/2015  
DRAWN BY: S. LAMPHERE  
CHECKED BY: C. LATHROP  
SHEET 166 OF 211