


12" STONE FILL, TYPE I (TYP.)
 6" GRUBBING MATERIAL (TYP.)
 GEOTEXTILE UNDER STONE FILL (TYP.)

STA. 287+50 TO STA. 292+00

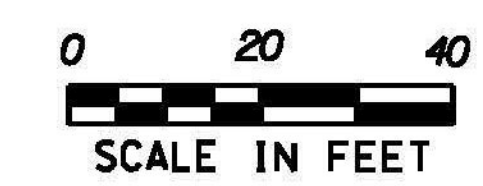

PROJECT NAME: BETHEL-RANDOLPH	
PROJECT NUMBER: STP 292(K)	
FILE NAME: piOC244.dgn	PLOT DATE: 4/23/2015
PROJECT LEADER: C. LATHROP	DRAWN BY: S. LAMPHERE
DESIGNED BY: S. LAMPHERE	CHECKED BY: C. LATHROP
CROSS SECTION SHEET 33	SHEET 167 OF 211