


DRIVE RT

STA. 307+50 TO STA. 312+00

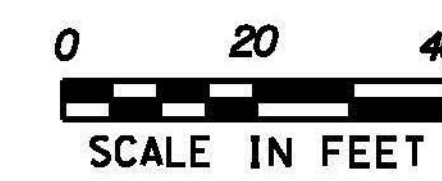

PROJECT NAME: BETHEL-RANDOLPH
PROJECT NUMBER: STP 292(K)

FILE NAME: piOC244.dgn
PROJECT LEADER: C. LATHROP
DESIGNED BY: S. LAMPHERE
CROSS SECTION SHEET 37

PLOT DATE: 4/23/2015
DRAWN BY: S. LAMPHERE
CHECKED BY: C. LATHROP
SHEET 171 OF 211