




313+50

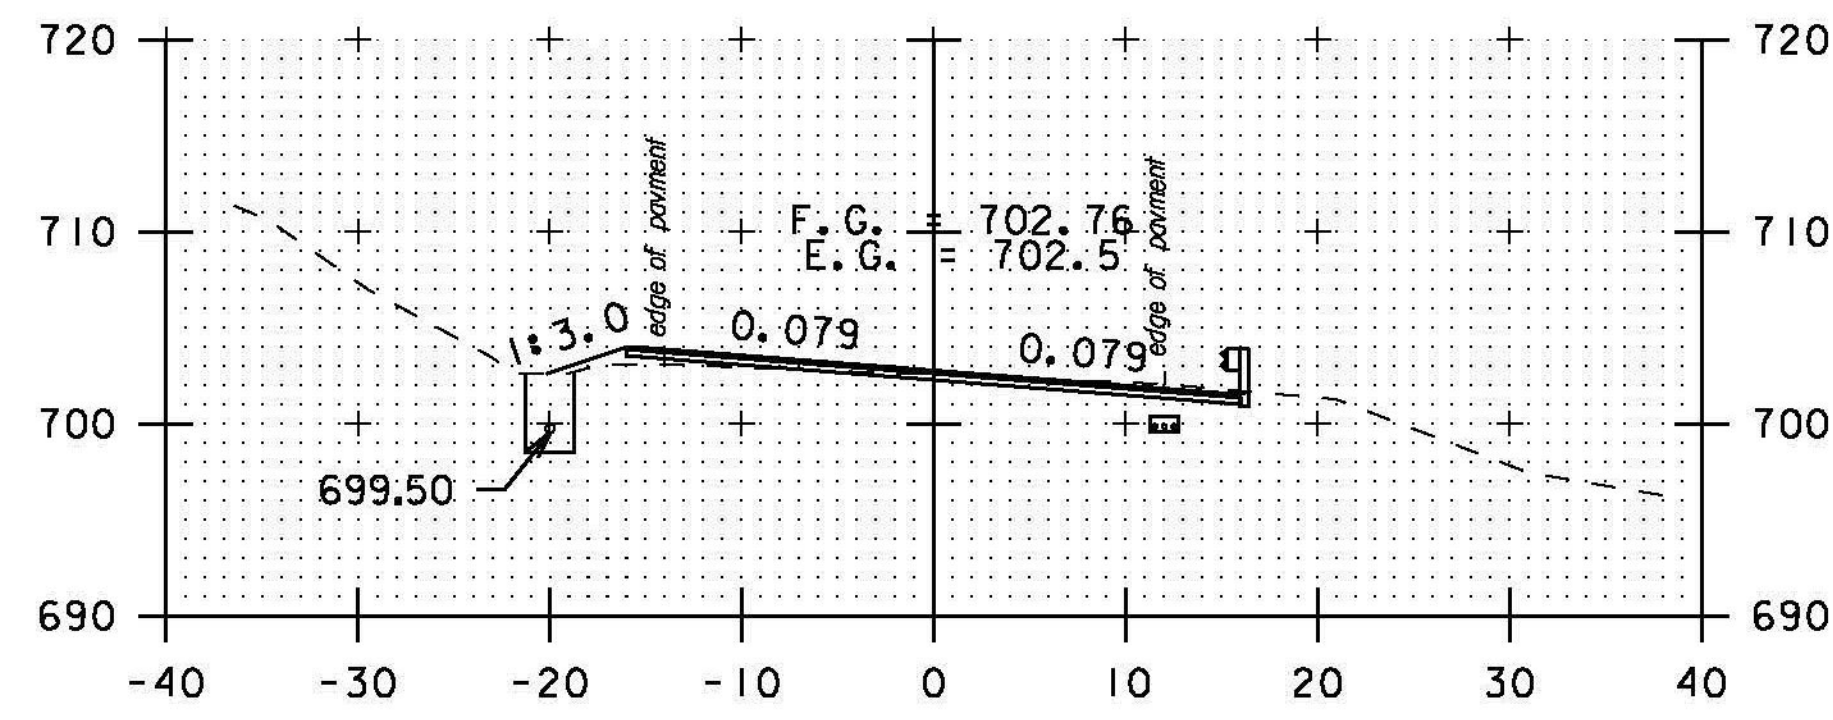


313+00

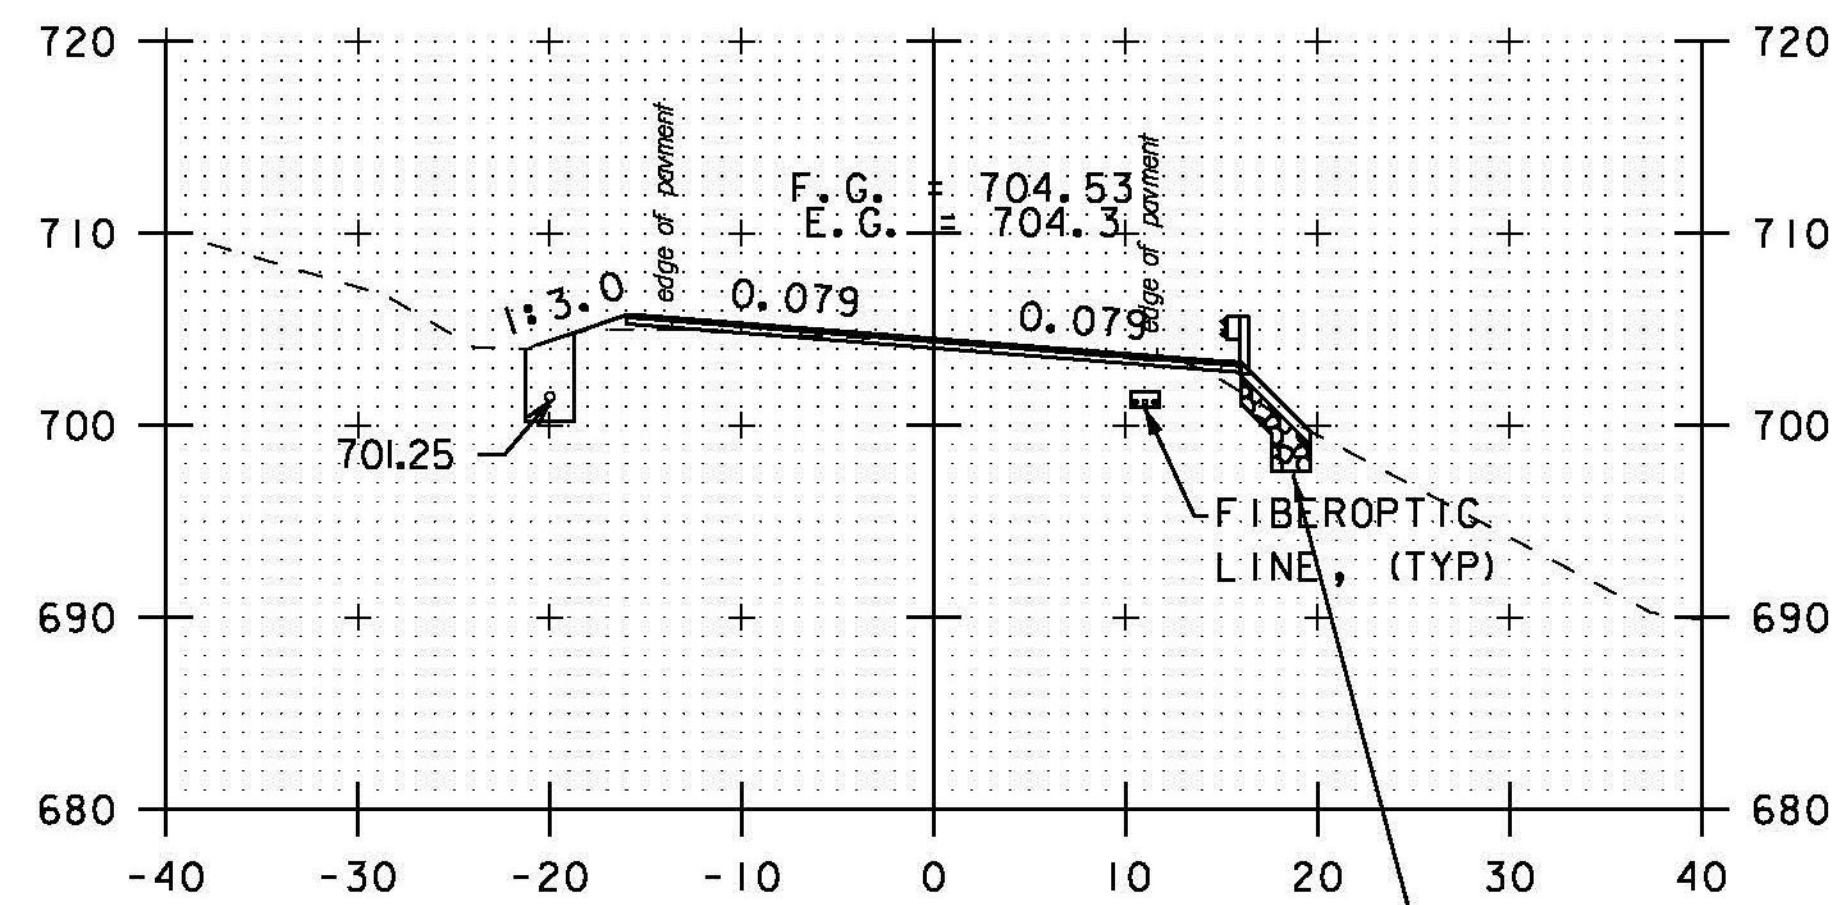


312+50

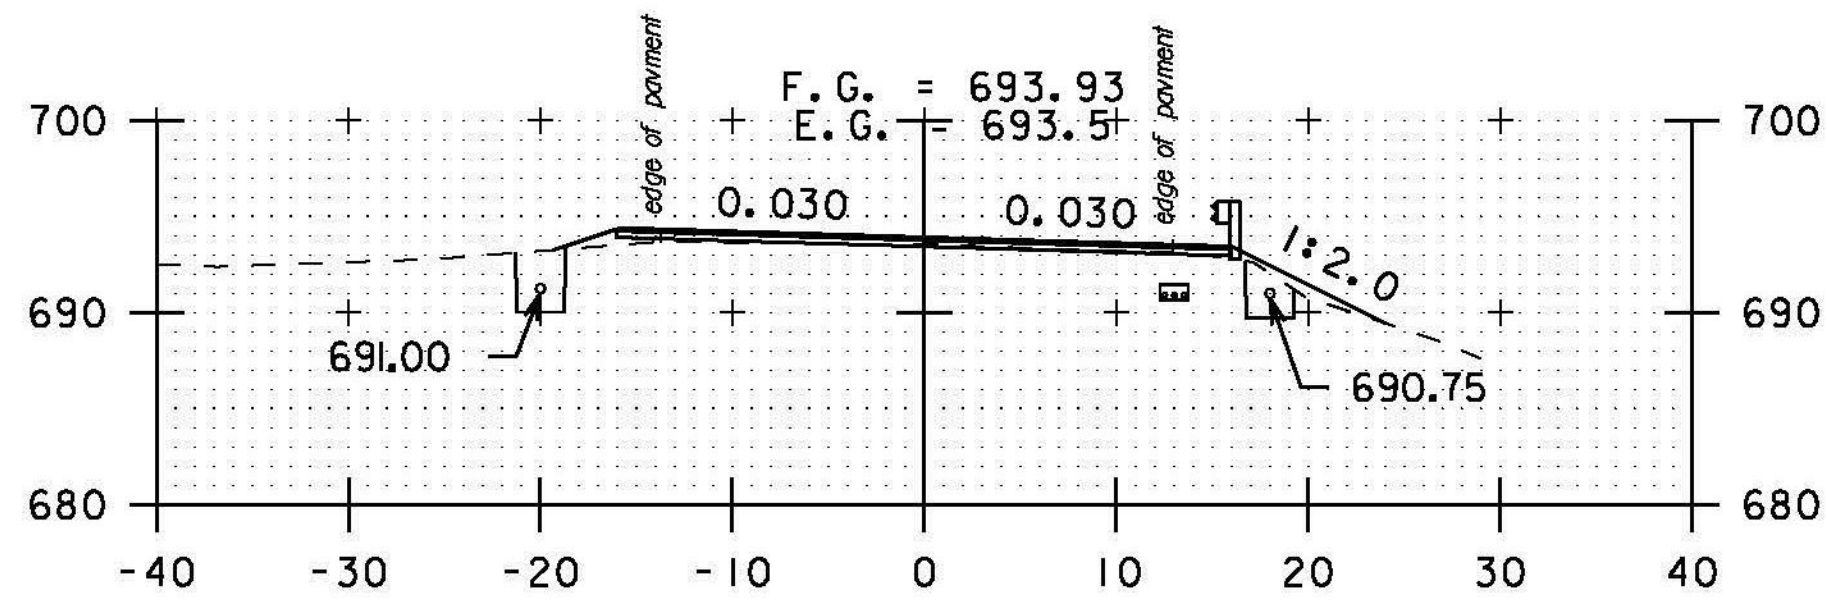


315+50

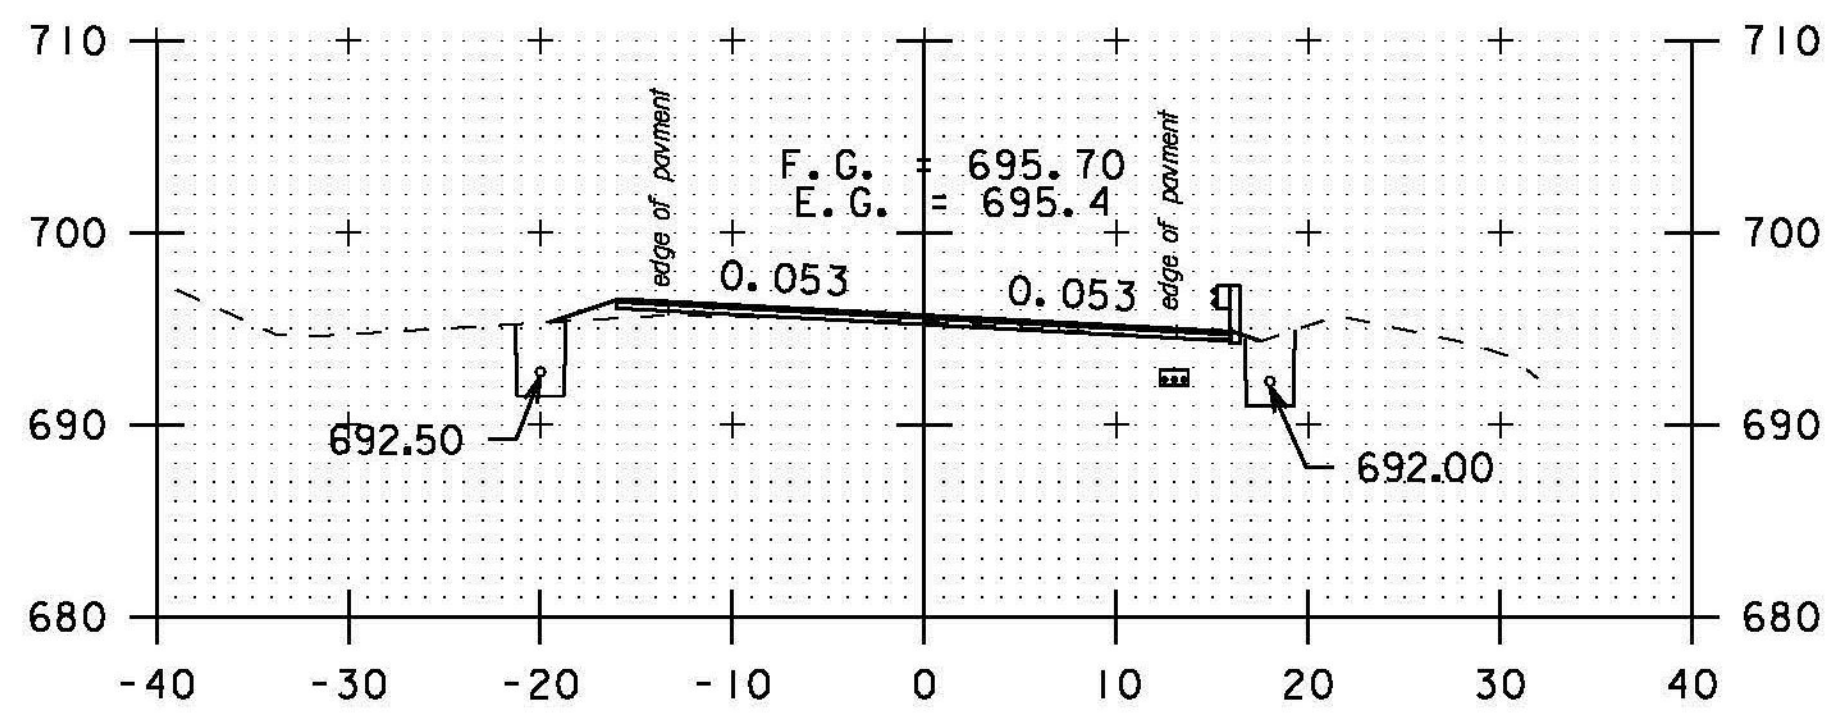


315+00

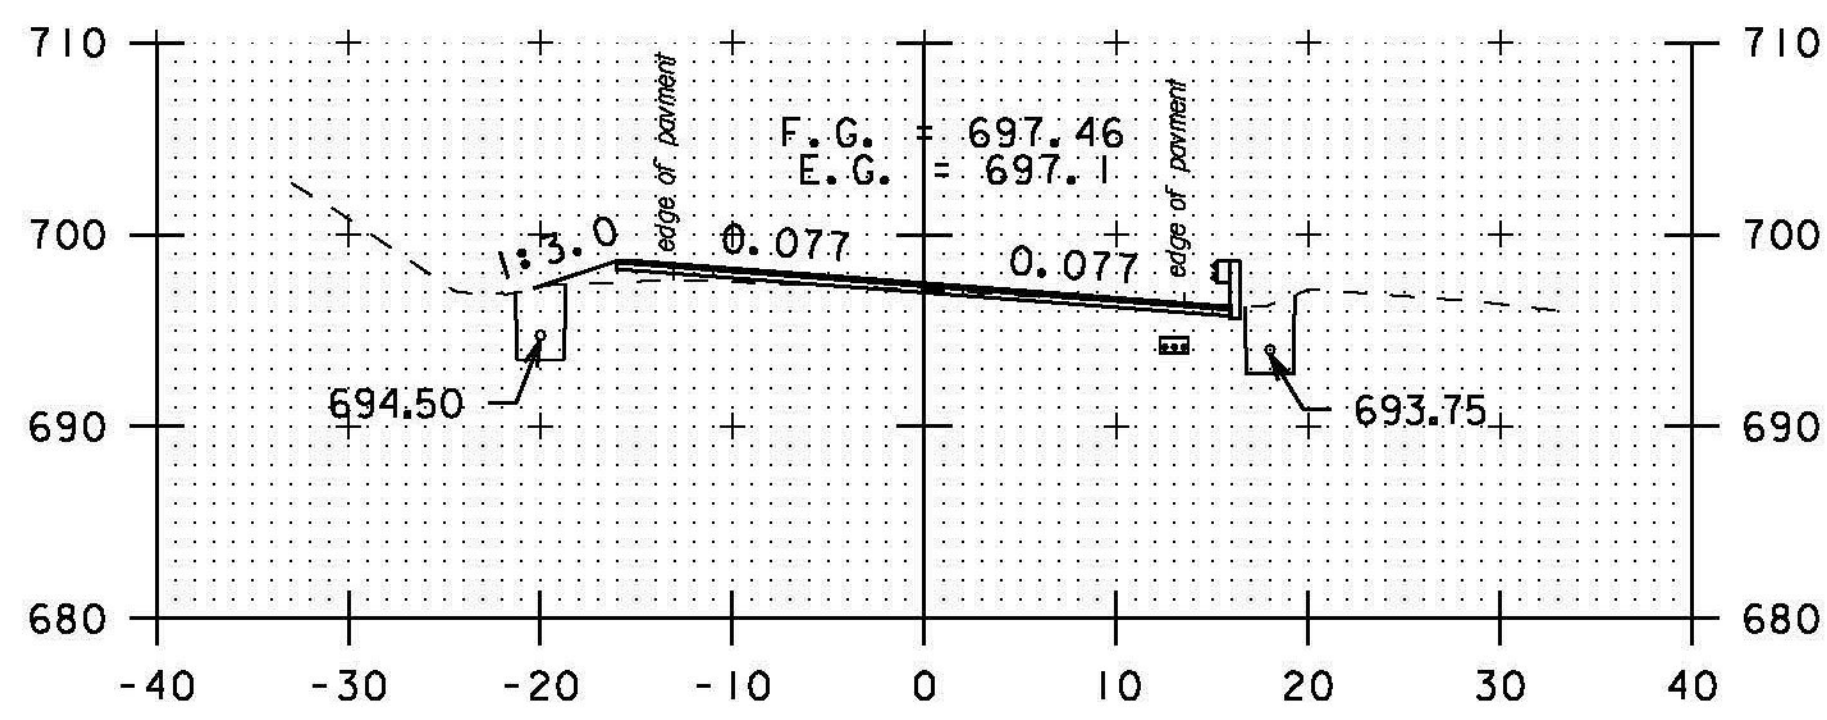


314+50

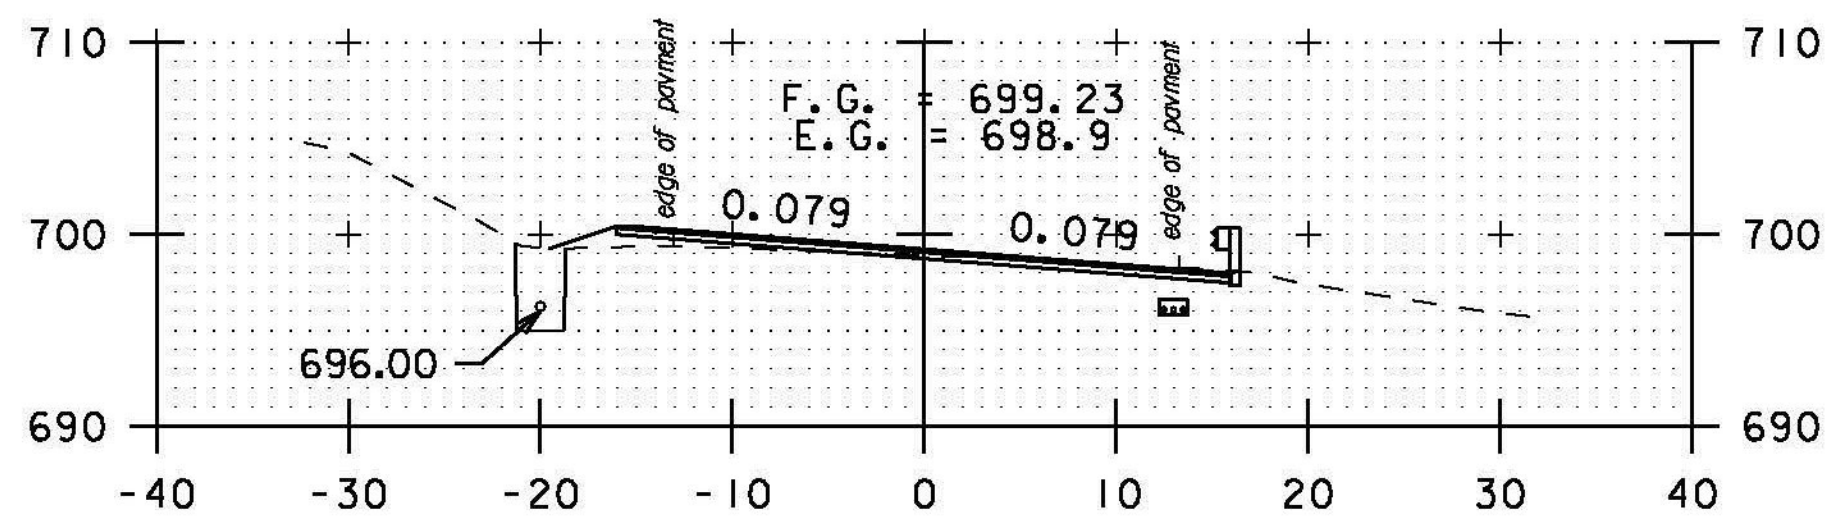


314+00

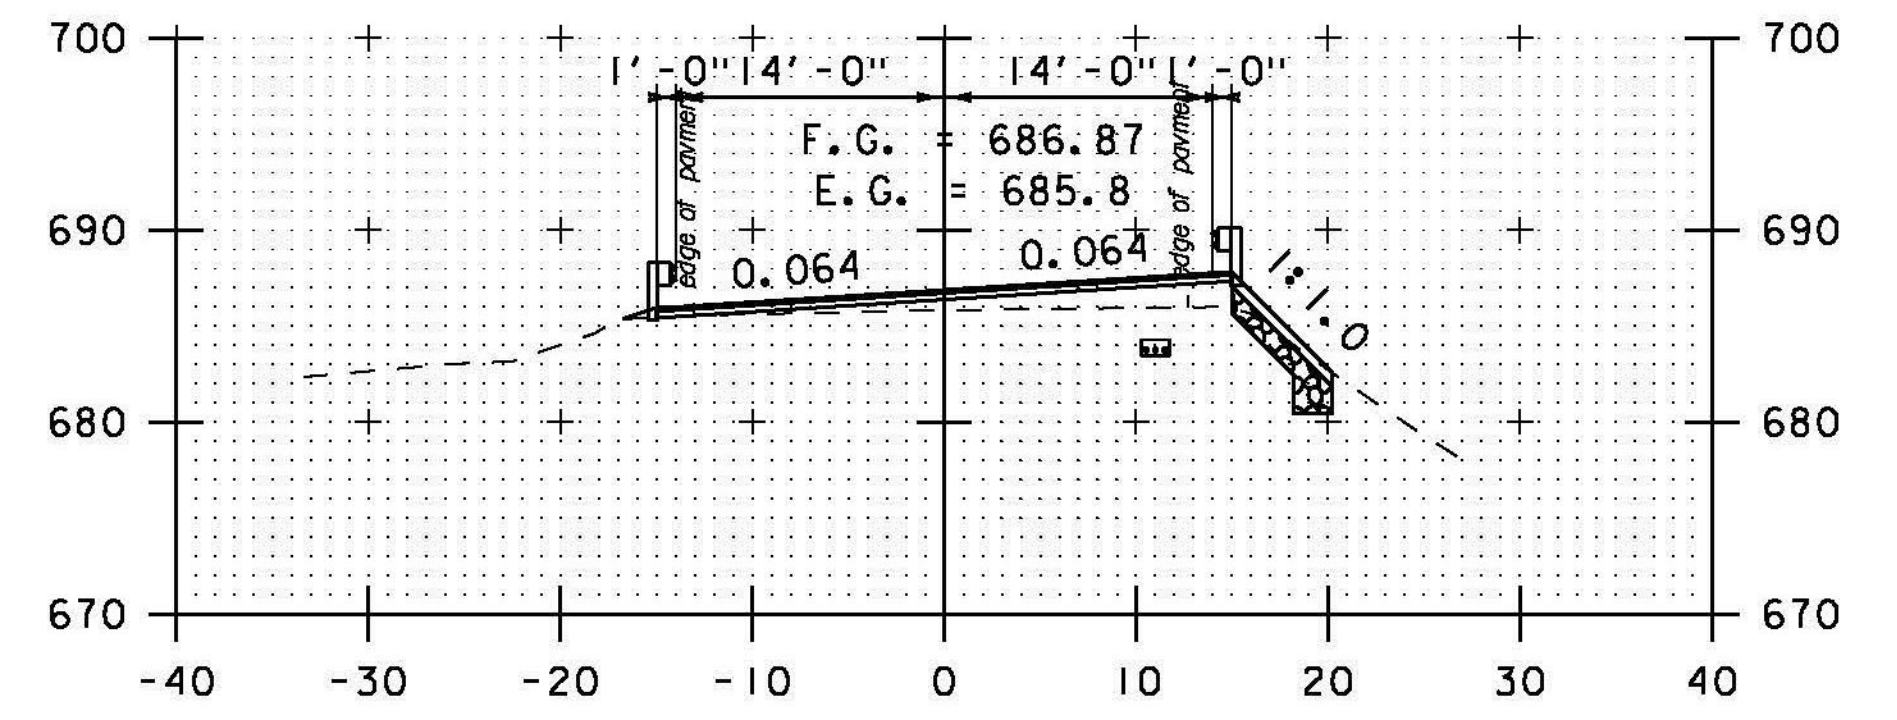


317+50

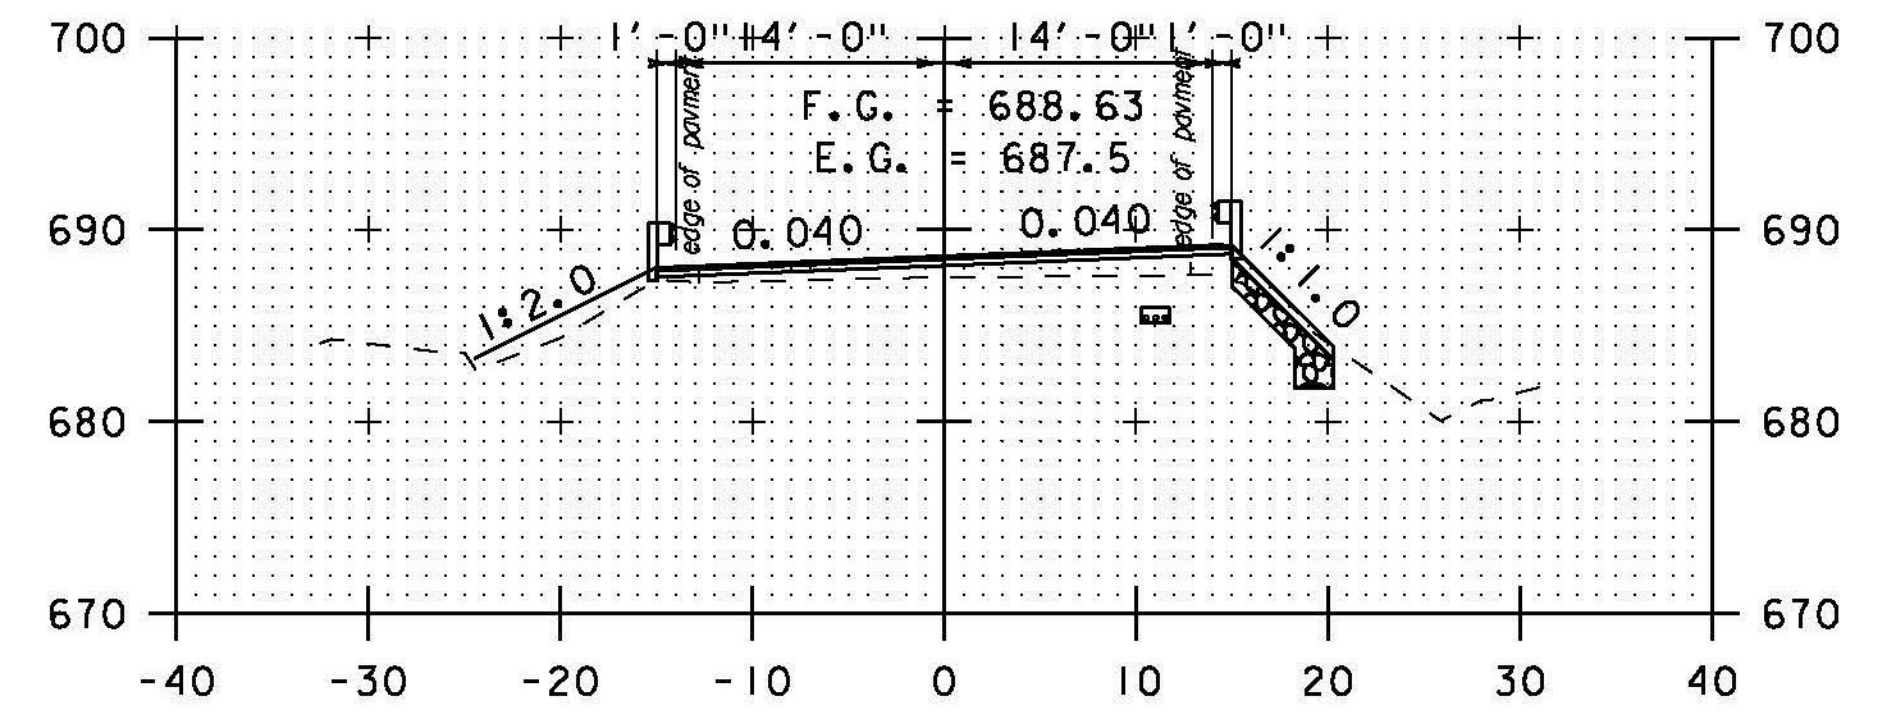

317+00

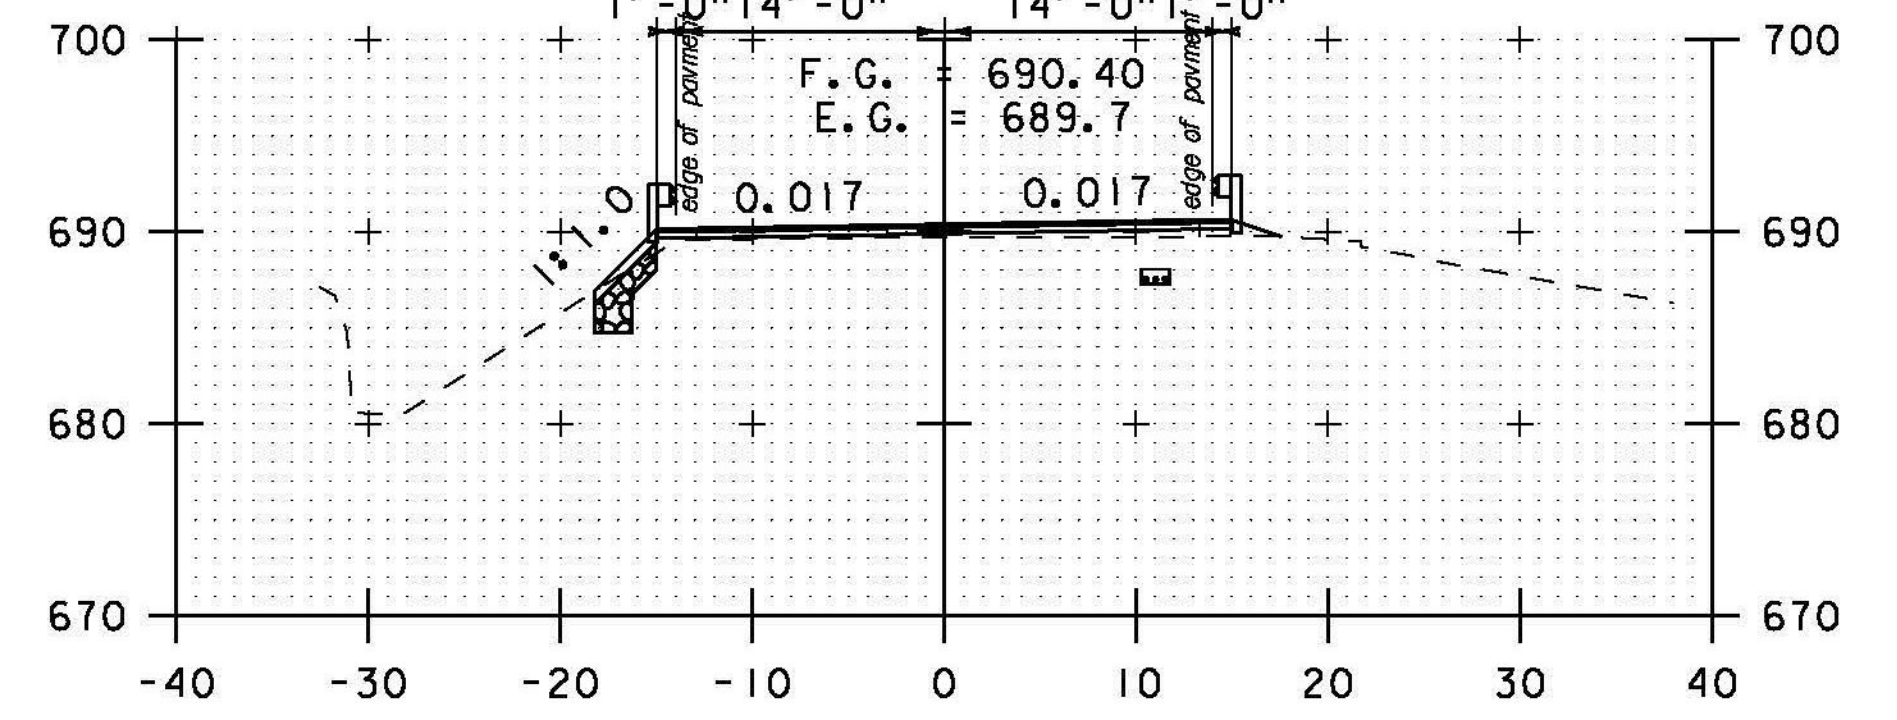


316+50

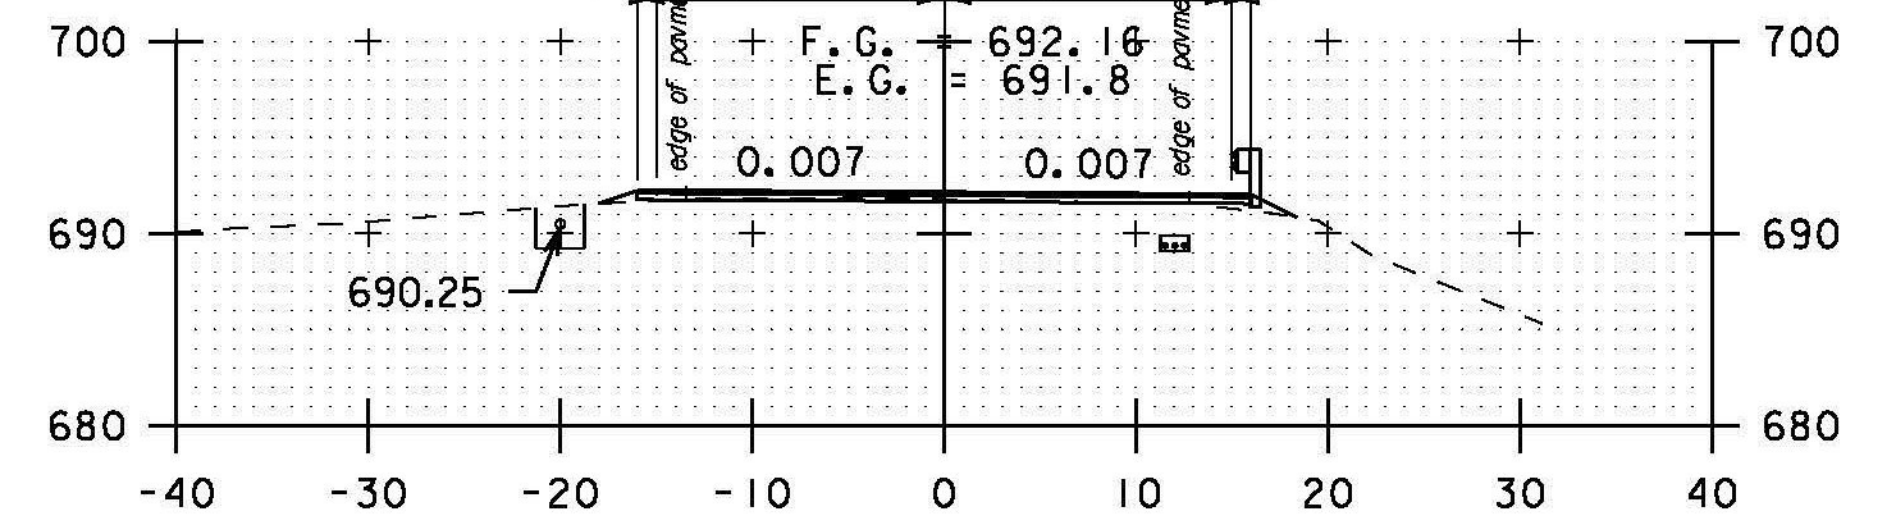

316+00

12" STONE FILL, TYPE I (TYP.)
6" GRUBBING MATERIAL (TYP.)
GEOTEXTILE UNDER STONE FILL (TYP.)

STA. 312+50 TO STA. 317+50

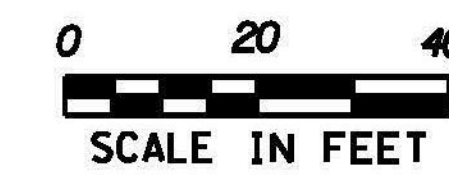

SCALE IN FEET

PROJECT NAME:	BETHEL-RANDOLPH	FILE NAME:	plOC244.dgn	PLOT DATE:	4/23/2015
PROJECT NUMBER:	STP 292(K)	PROJECT LEADER:	C. LATHROP	DRAWN BY:	S. LAMPHERE
		DESIGNED BY:	S. LAMPHERE	CHECKED BY:	C. LATHROP
		CROSS SECTION SHEET	38	SHEET	172 OF 211