




319+00

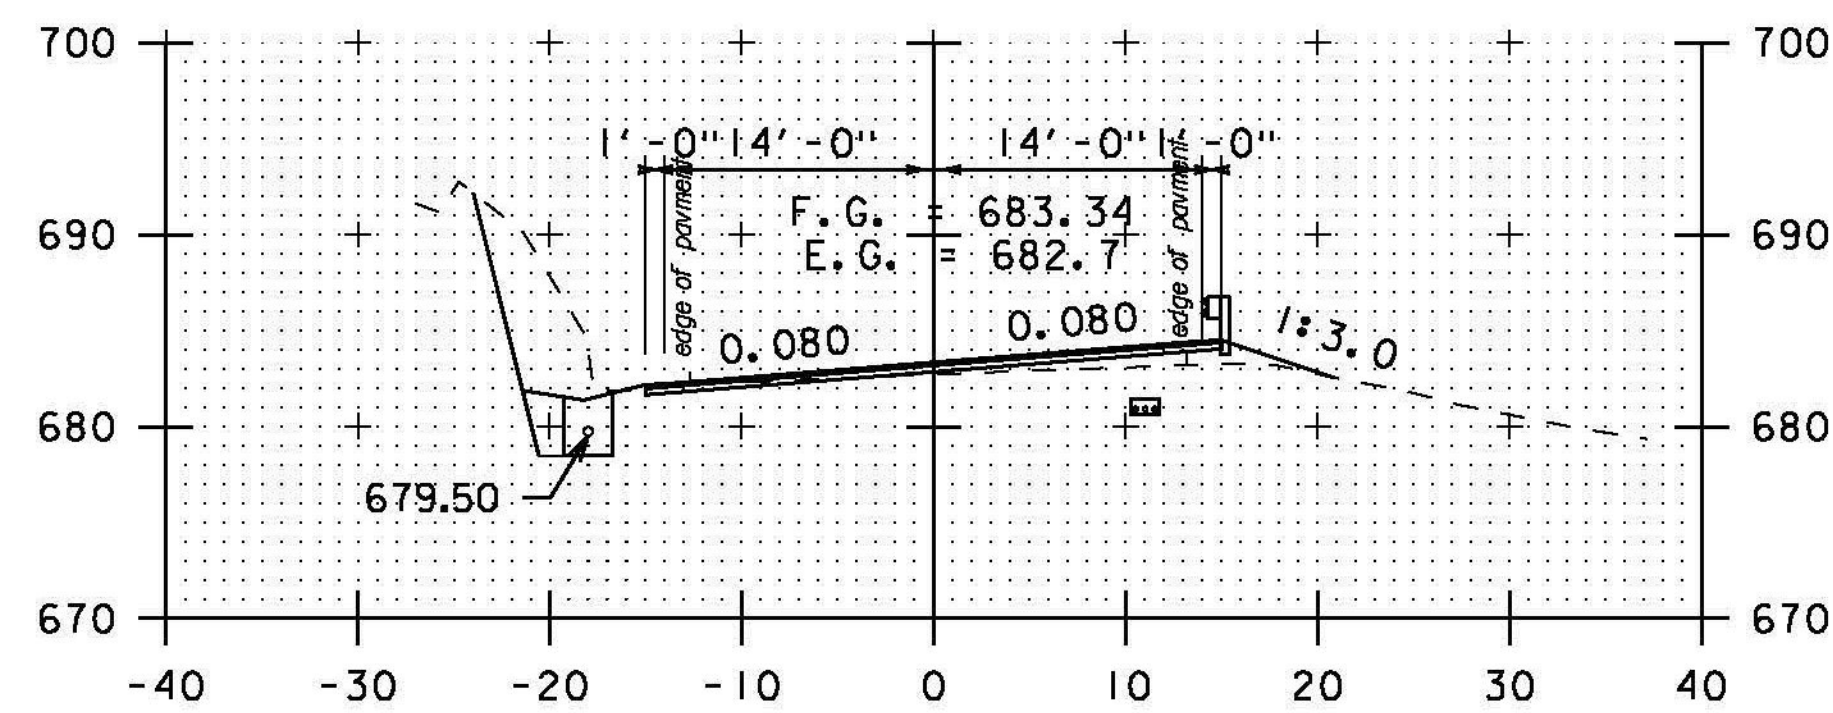


318+50

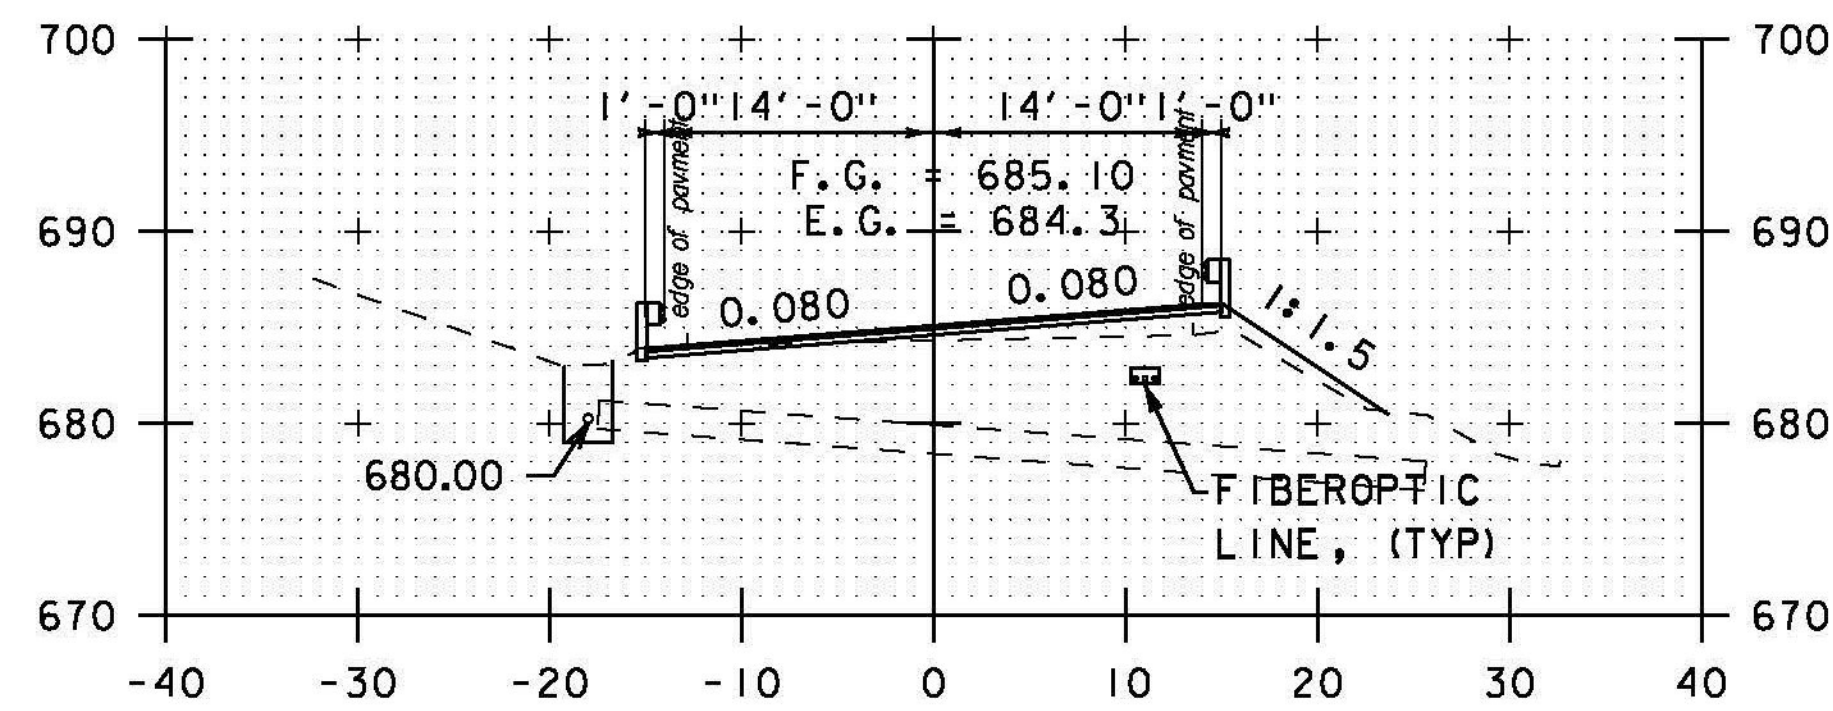


318+00

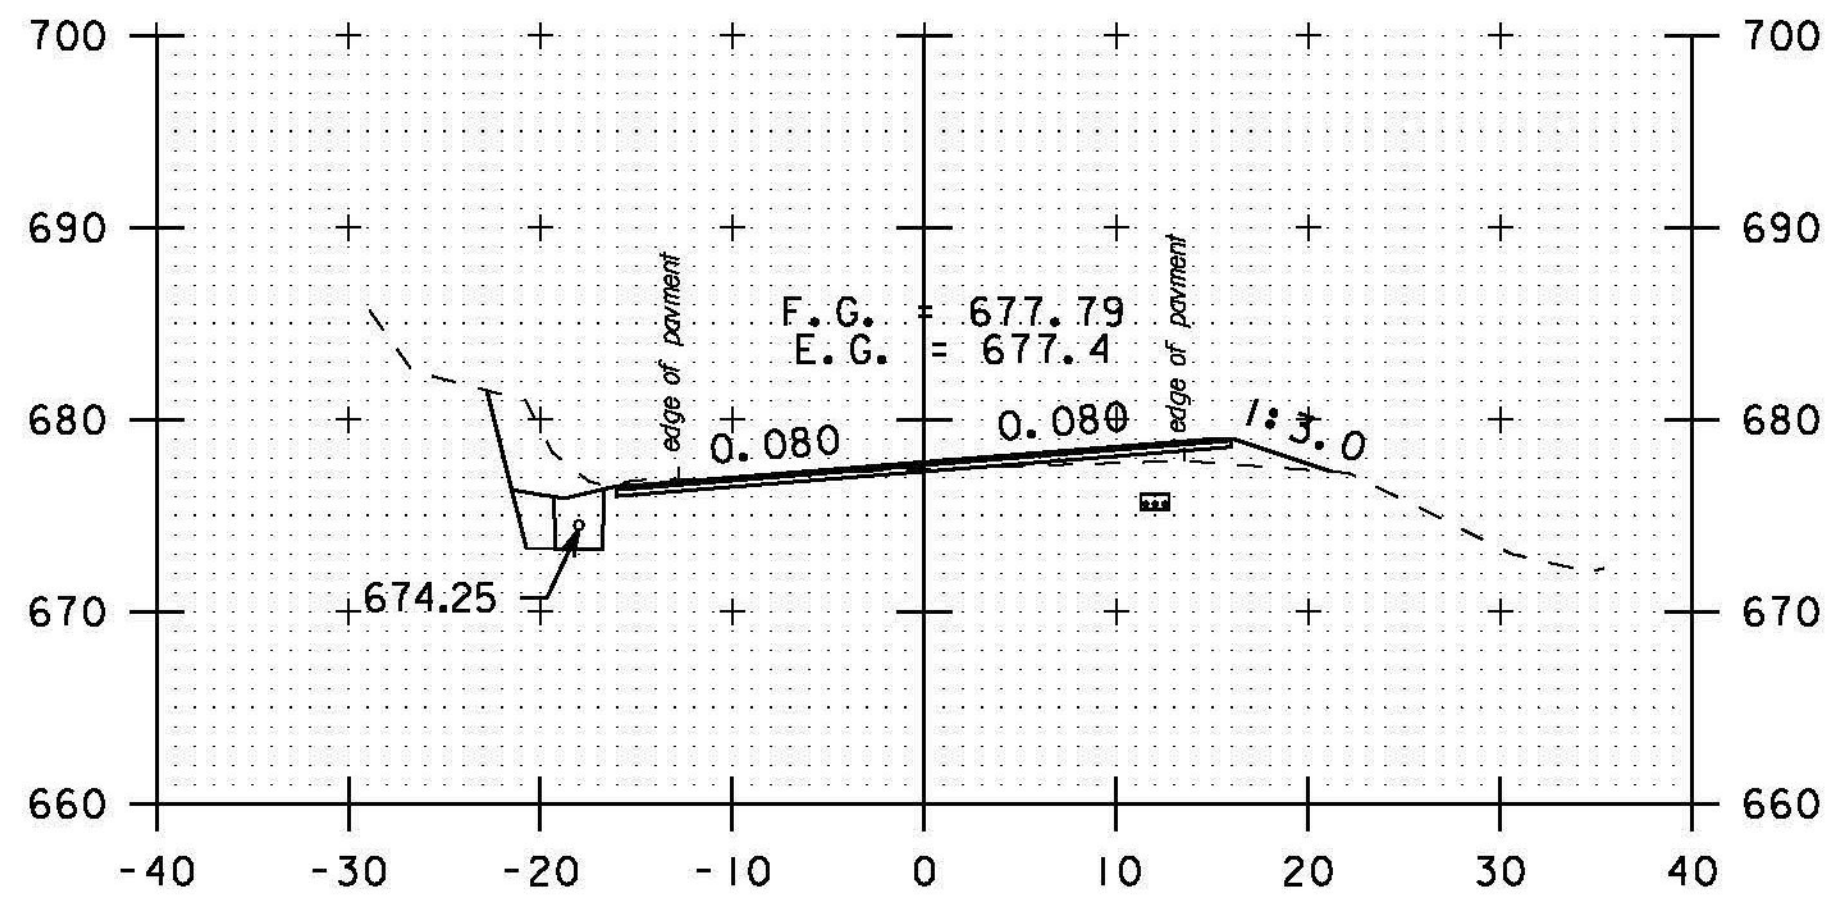


320+50

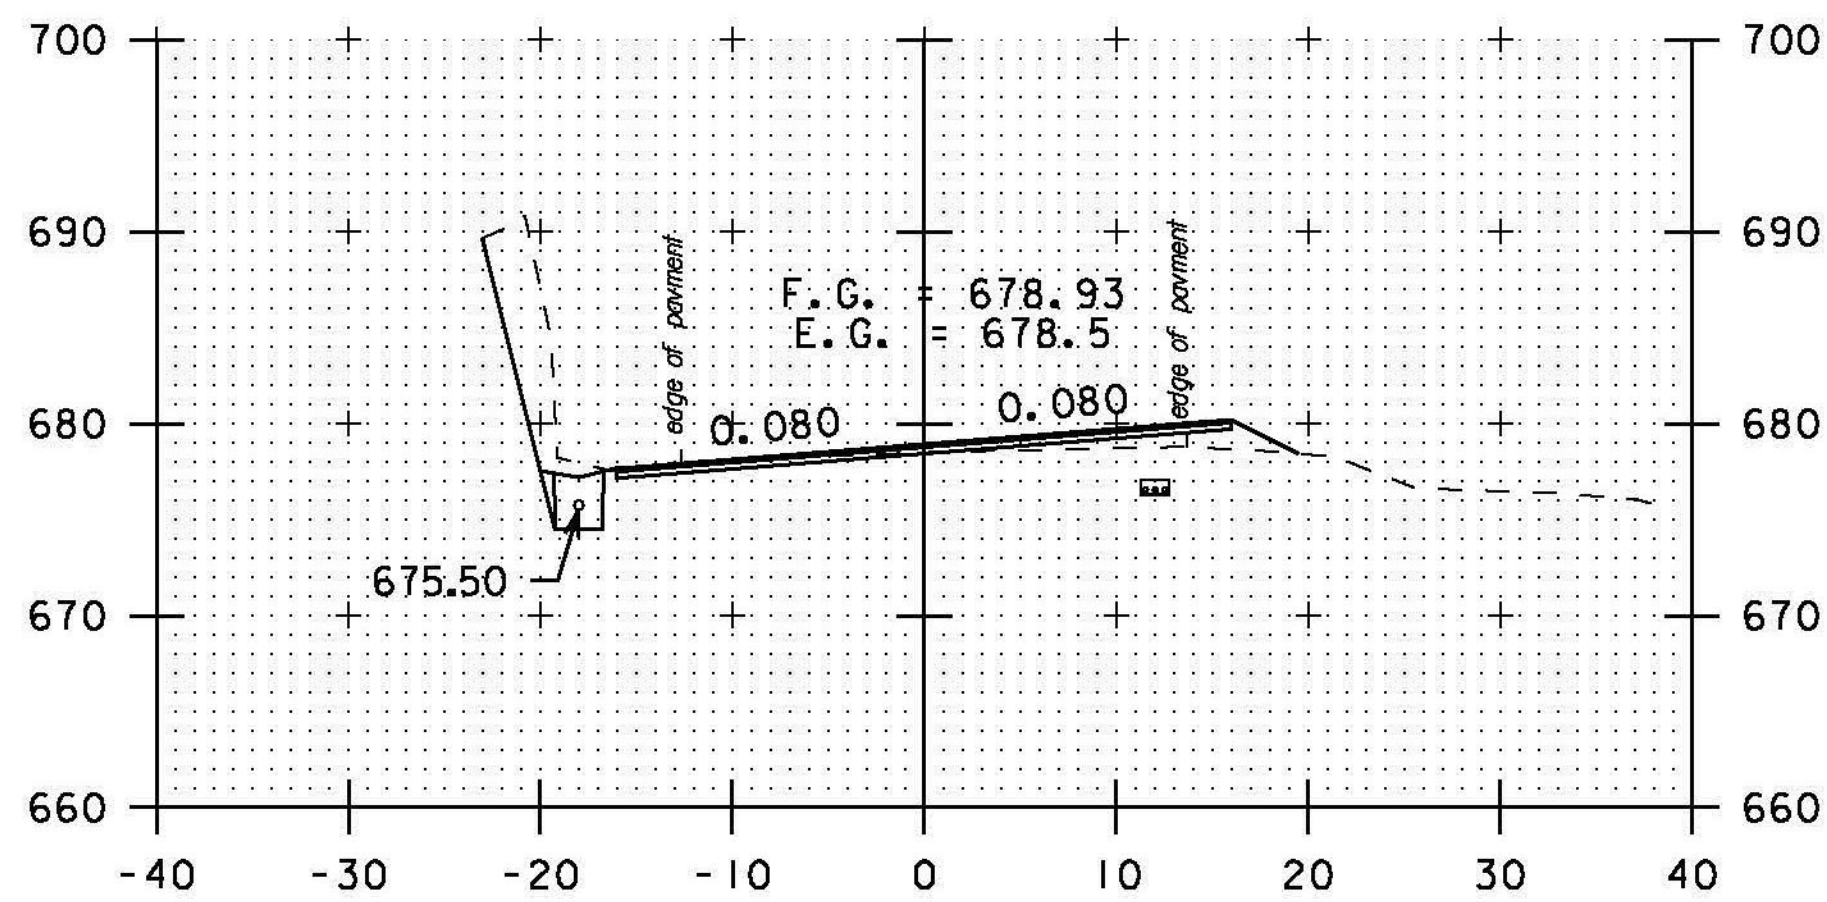


320+00

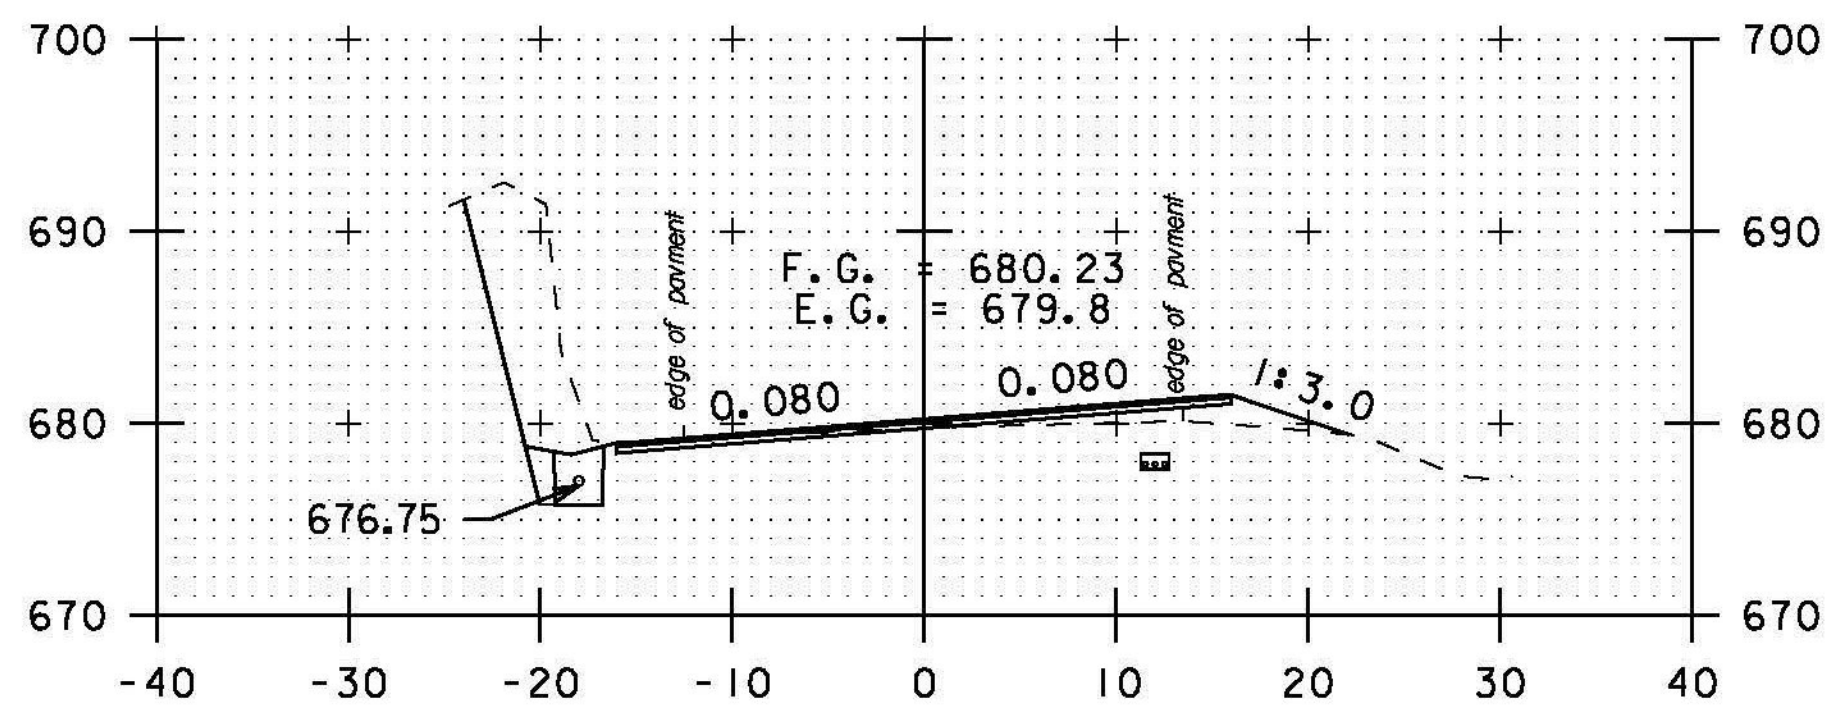


319+50

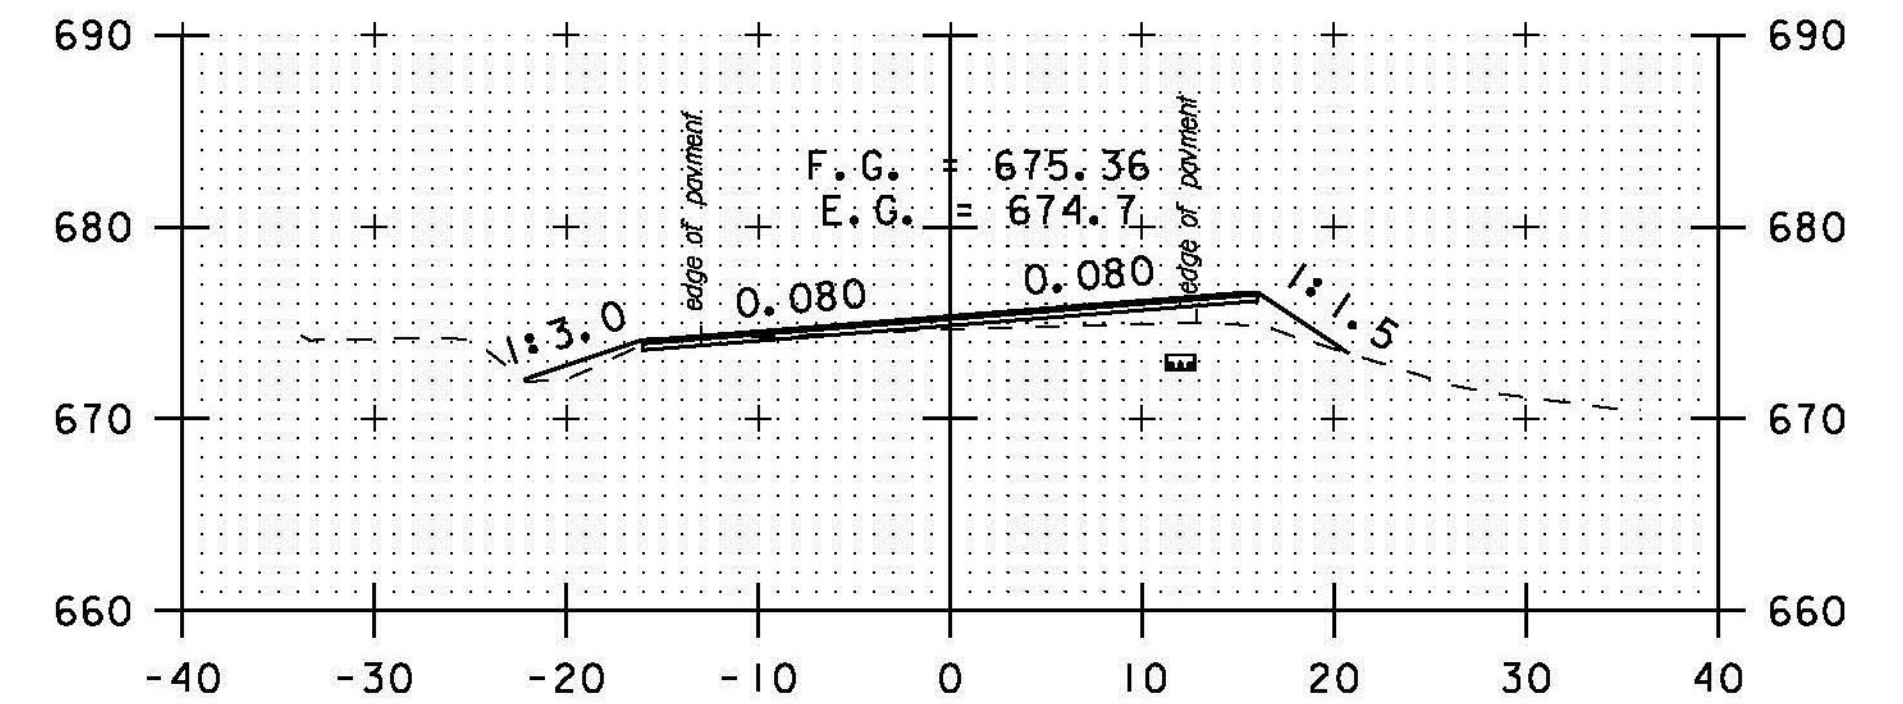

322+00

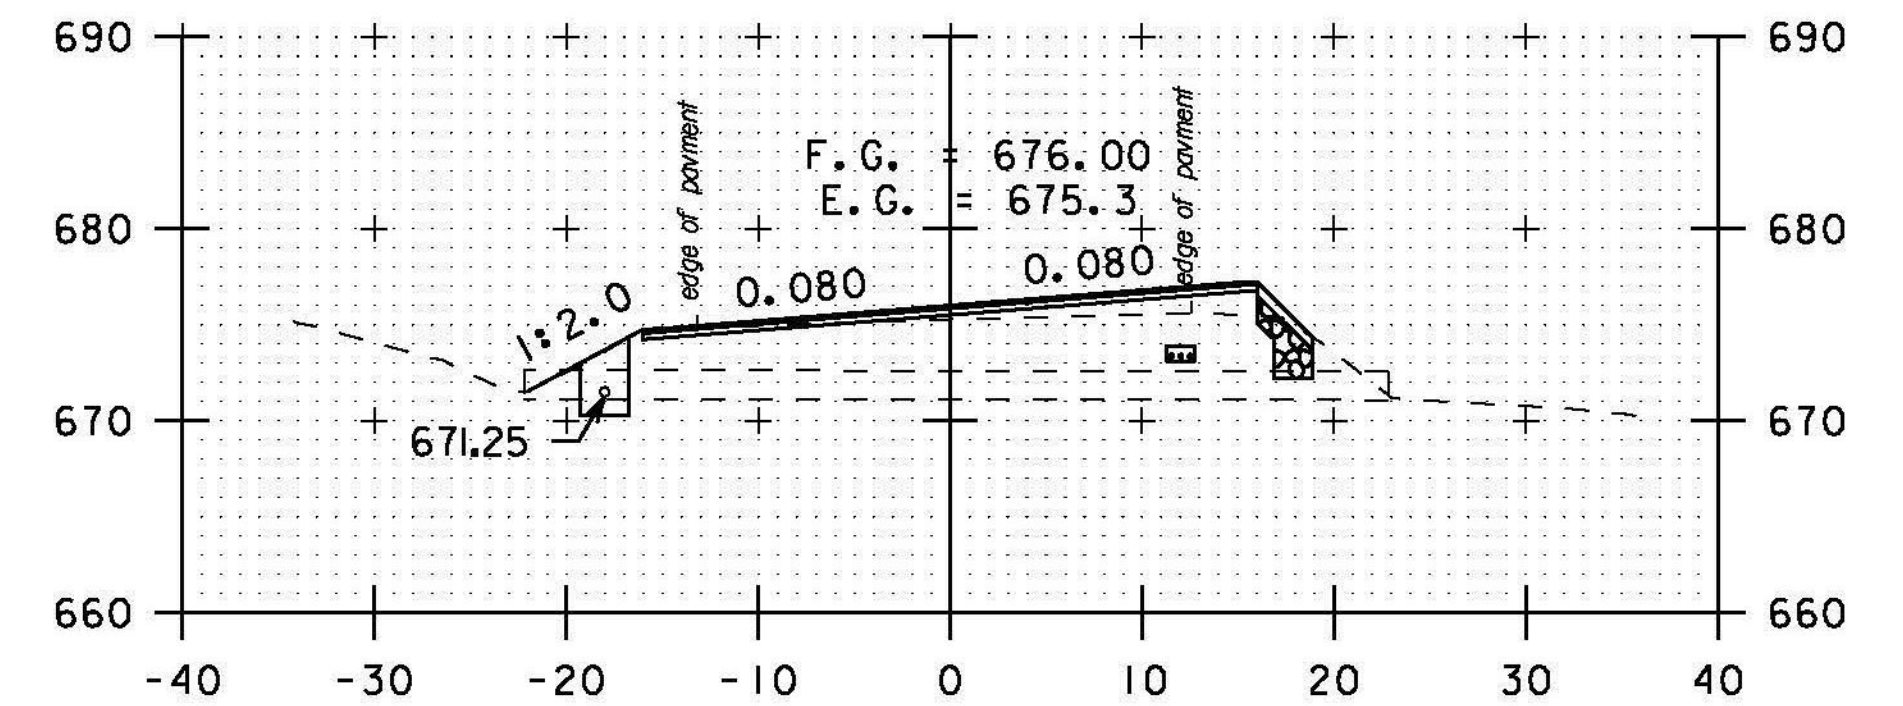


321+50

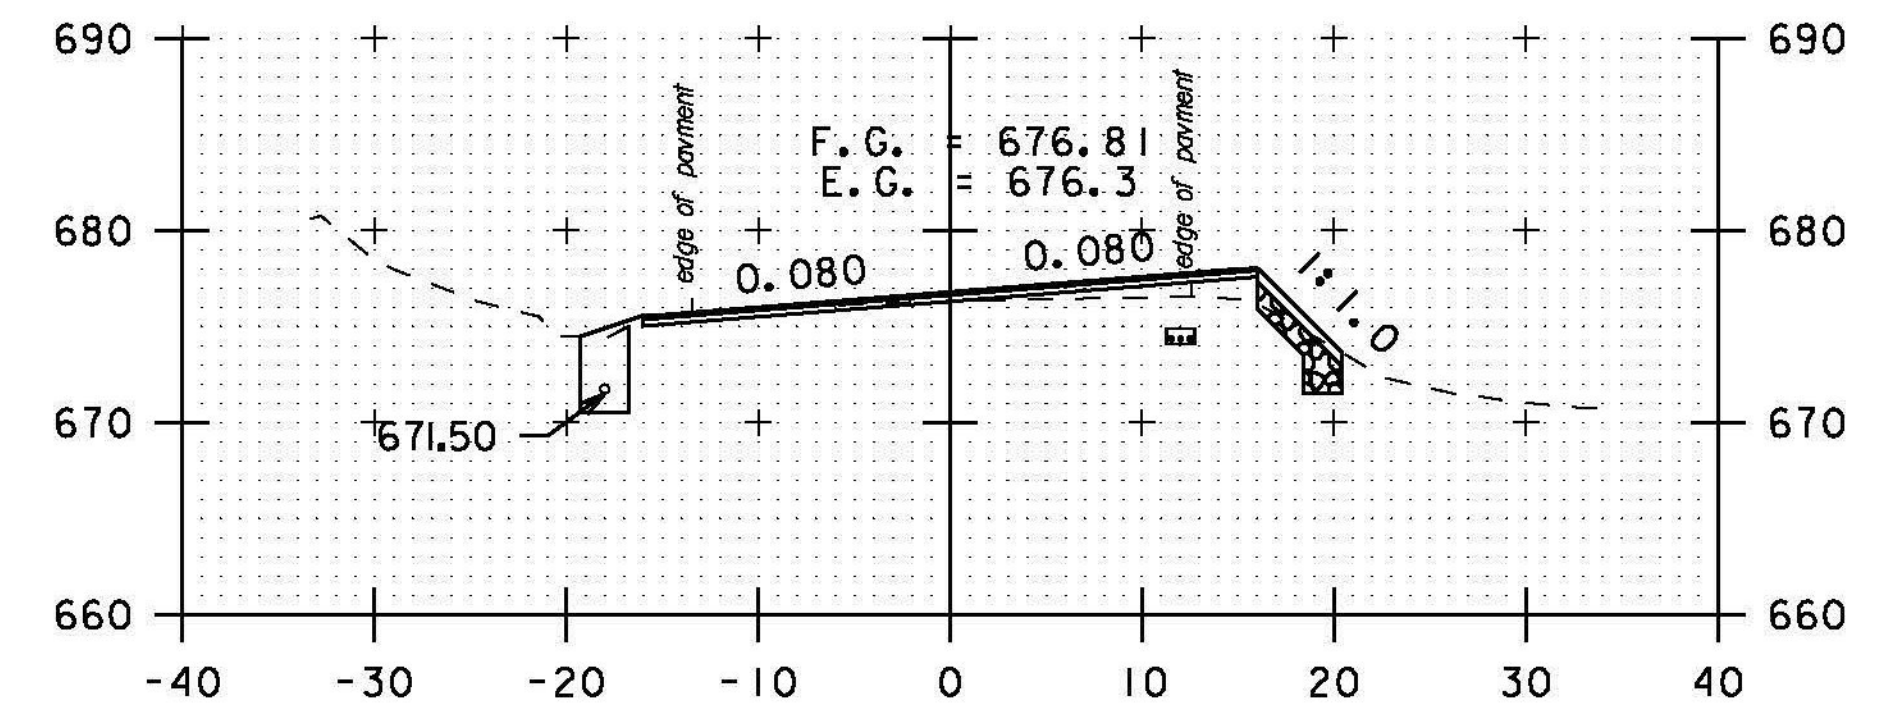

321+00

STA. 318+00 TO STA. 322+00

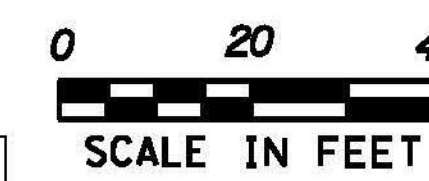

PROJECT NAME: BETHEL-RANDOLPH
PROJECT NUMBER: STP 292(I)

FILE NAME: piOC244.dgn
PROJECT LEADER: C. LATHROP
DESIGNED BY: S. LAMPHERE
CROSS SECTION SHEET 39

PLOT DATE: 4/23/2015
DRAWN BY: S. LAMPHERE
CHECKED BY: C. LATHROP
SHEET 173 OF 211