




323+50

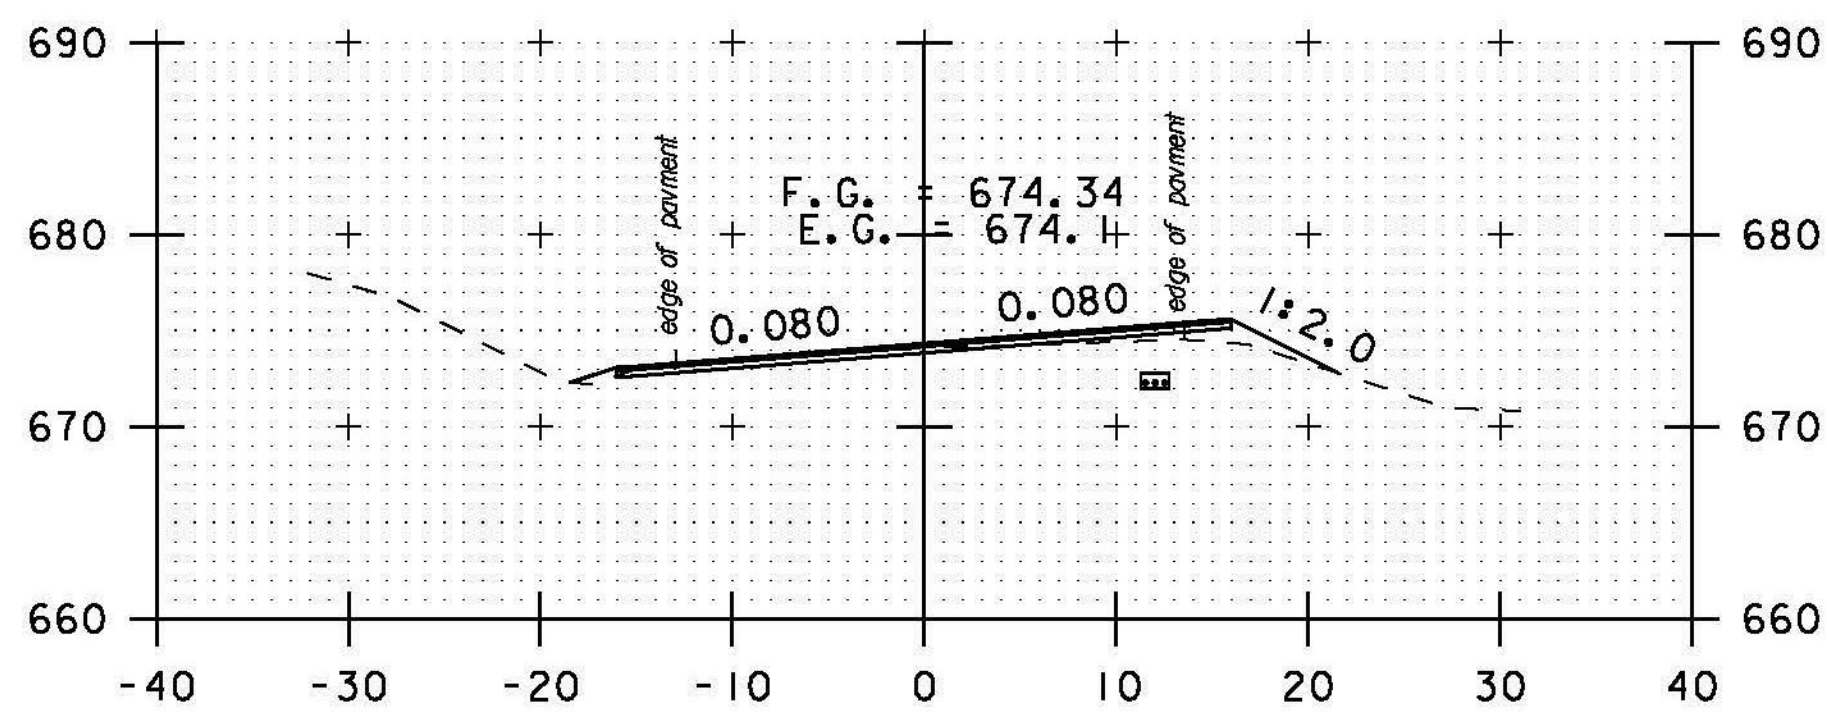


325+00

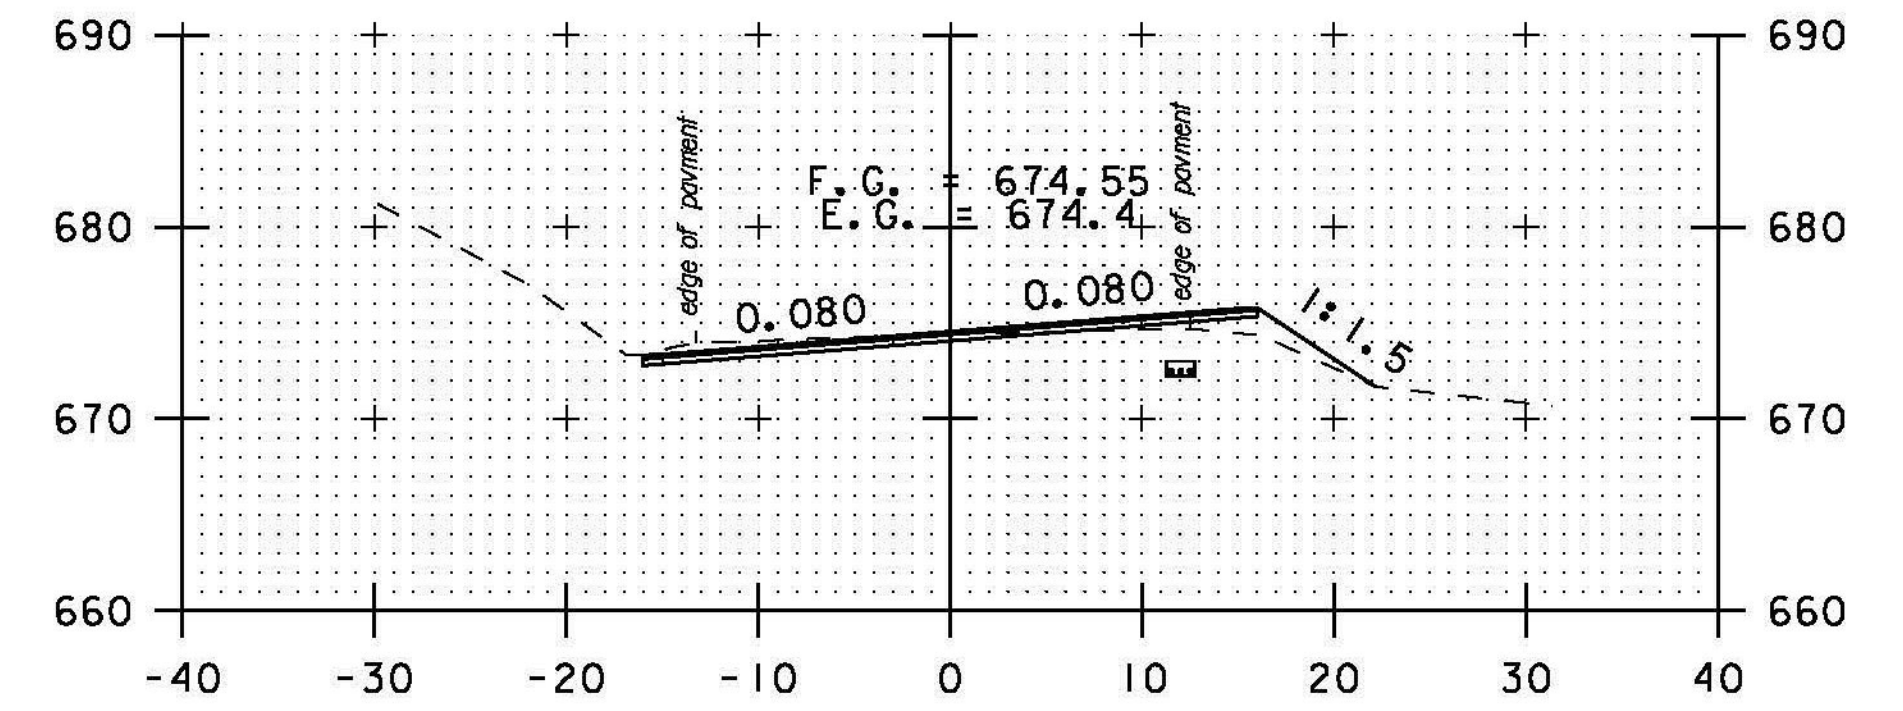


326+50

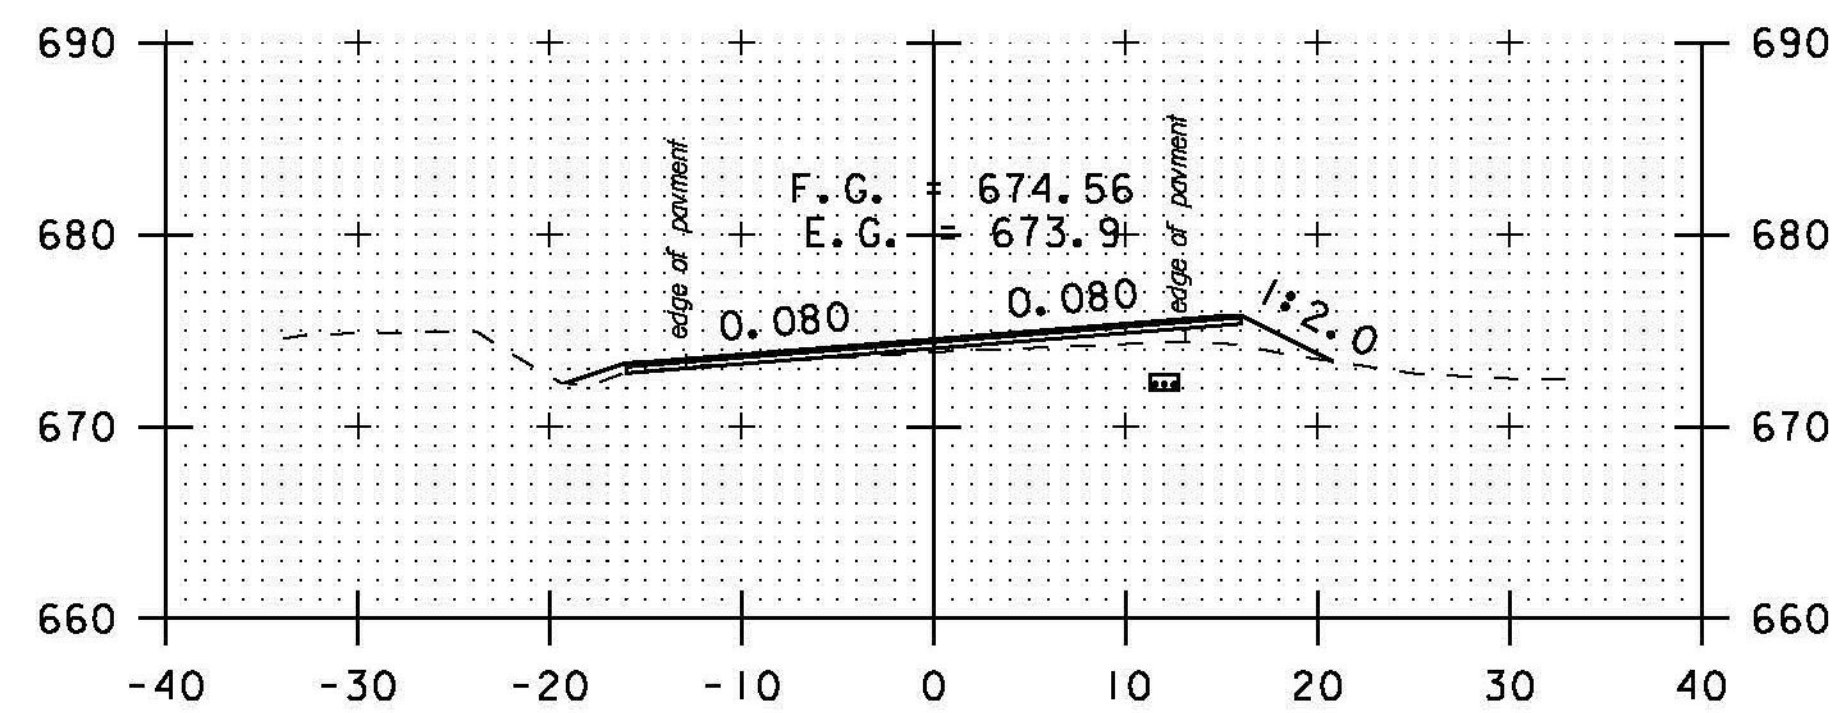


323+00

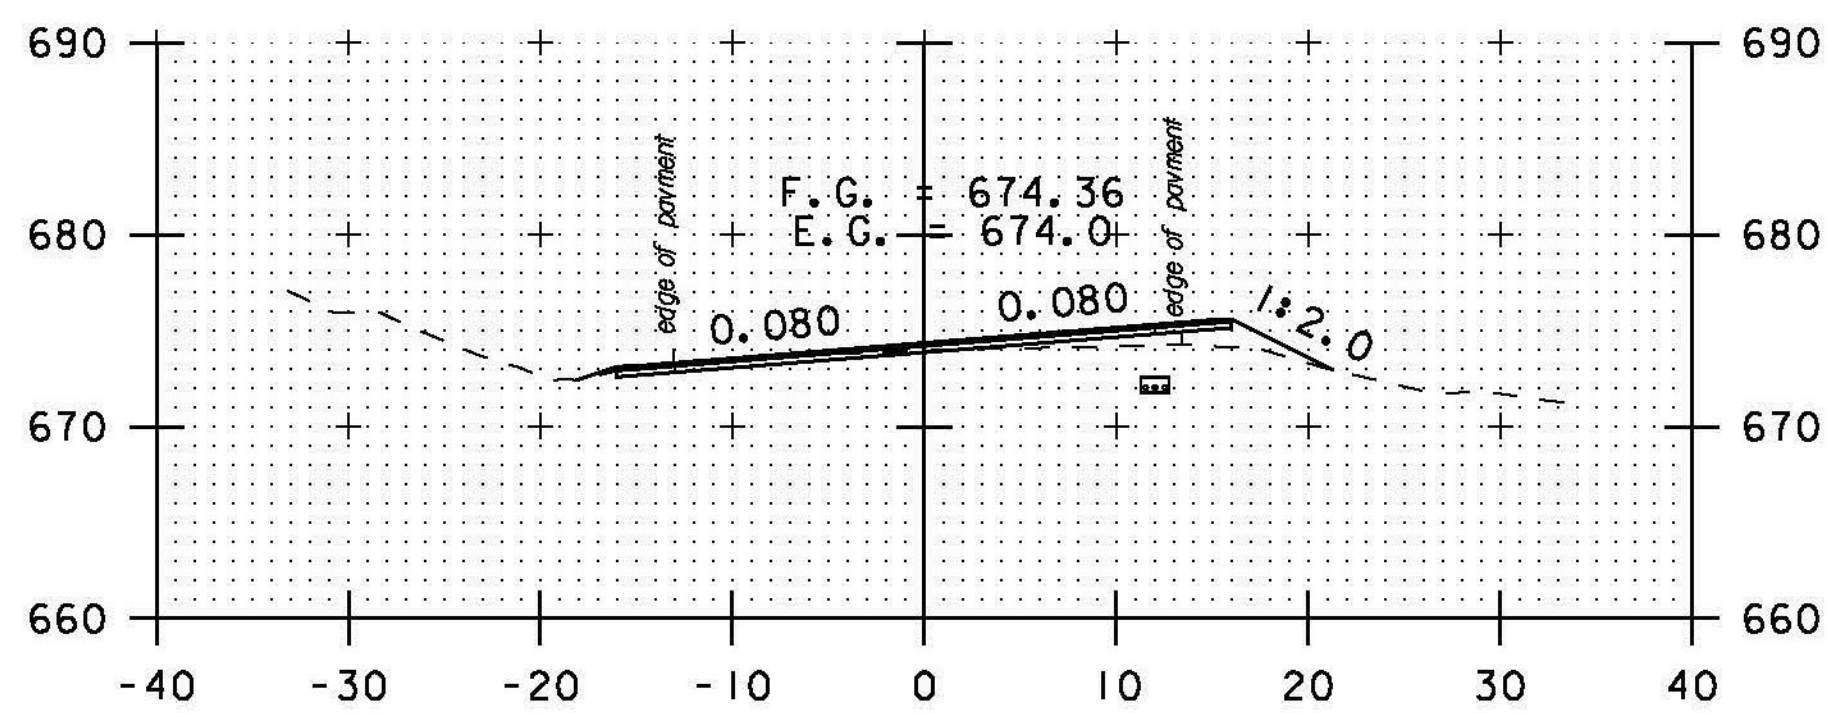


324+50

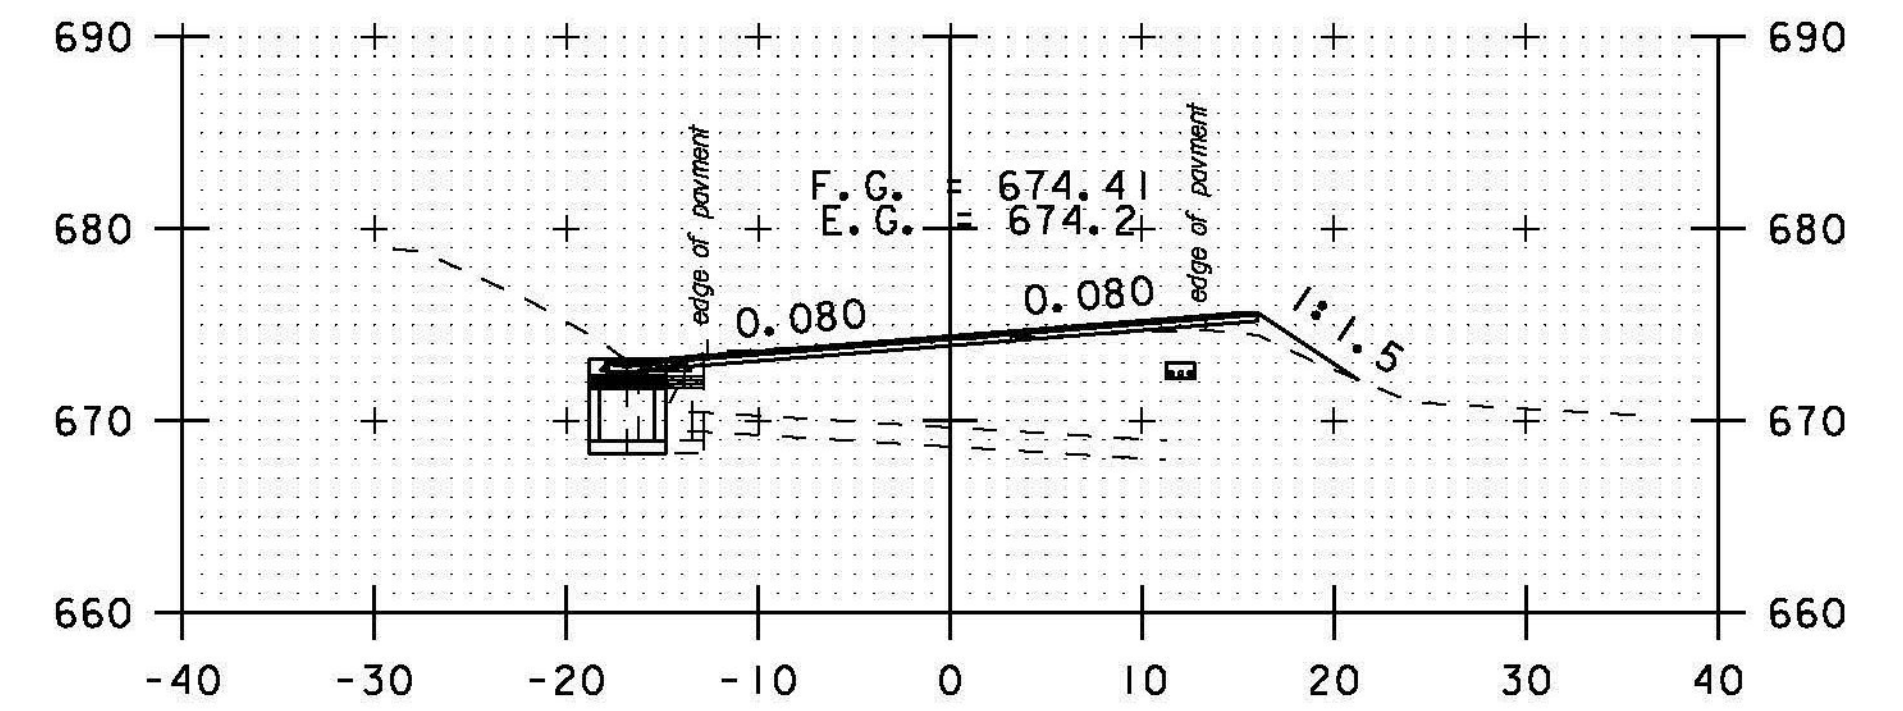


326+00

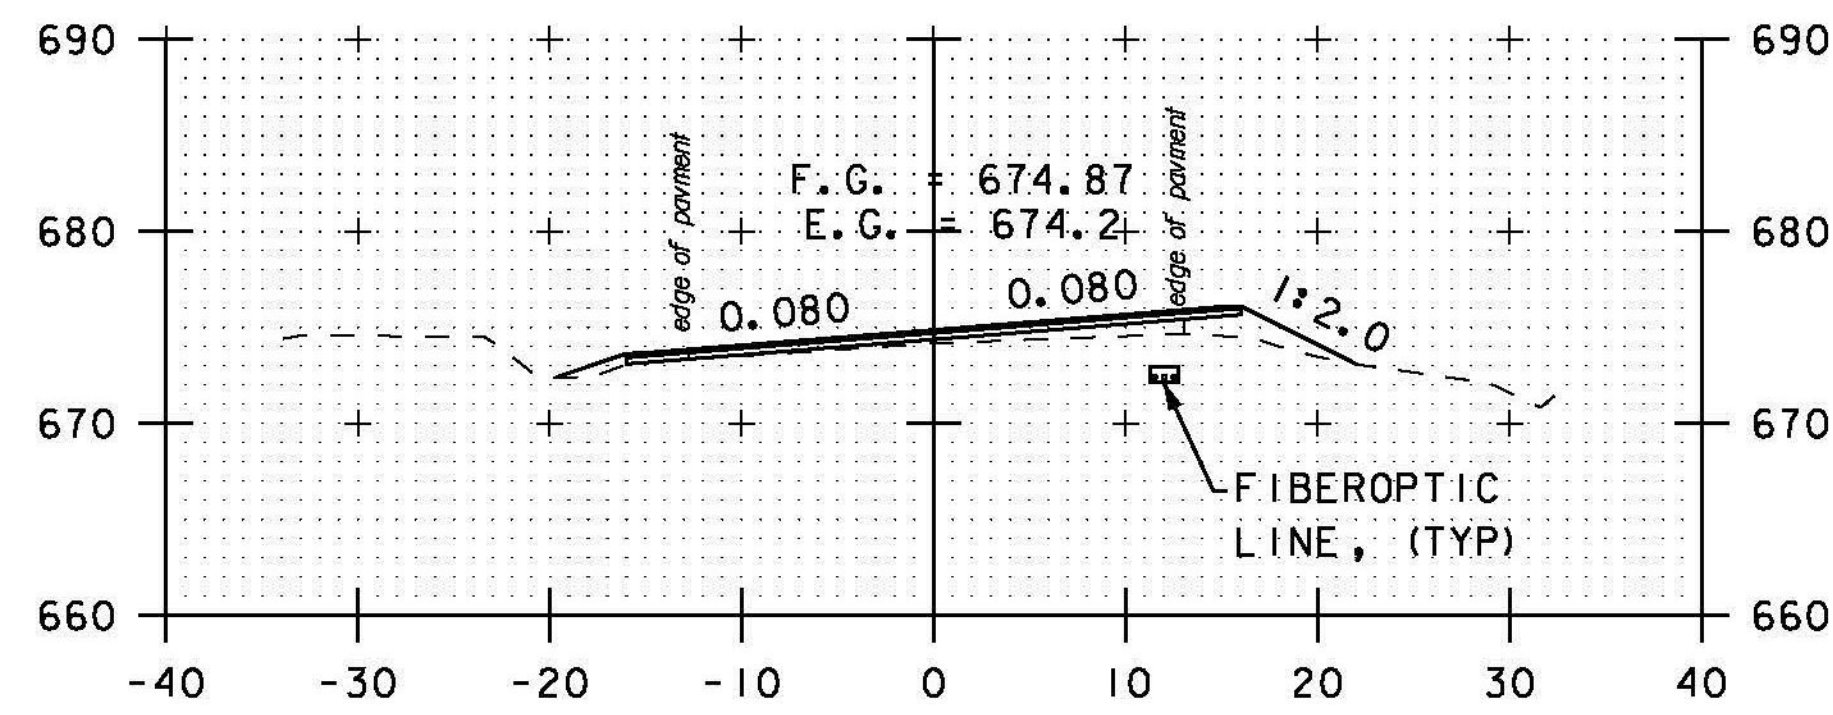

322+50

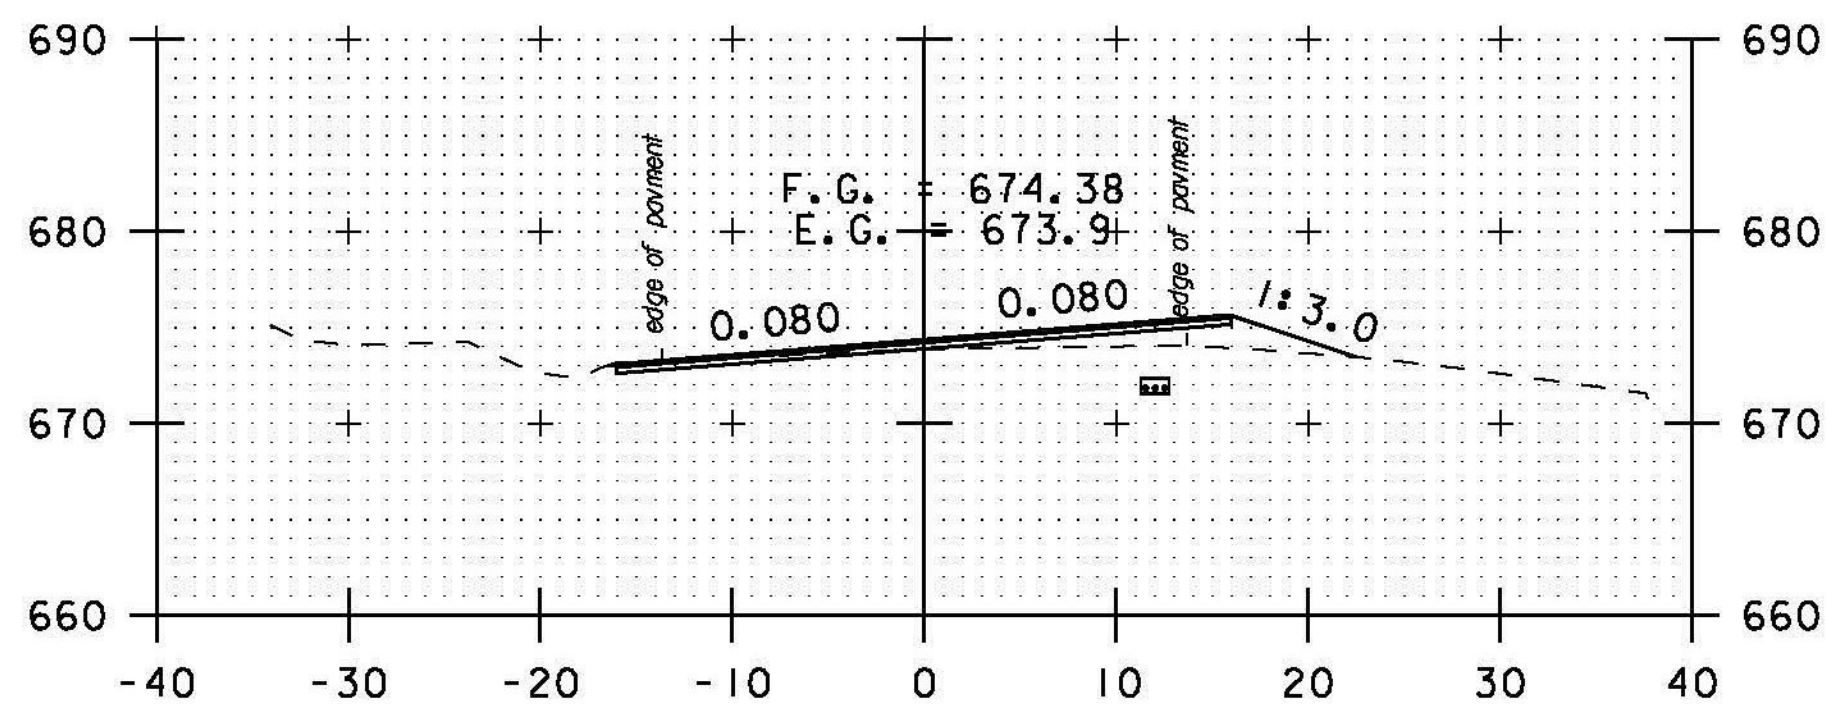


324+00

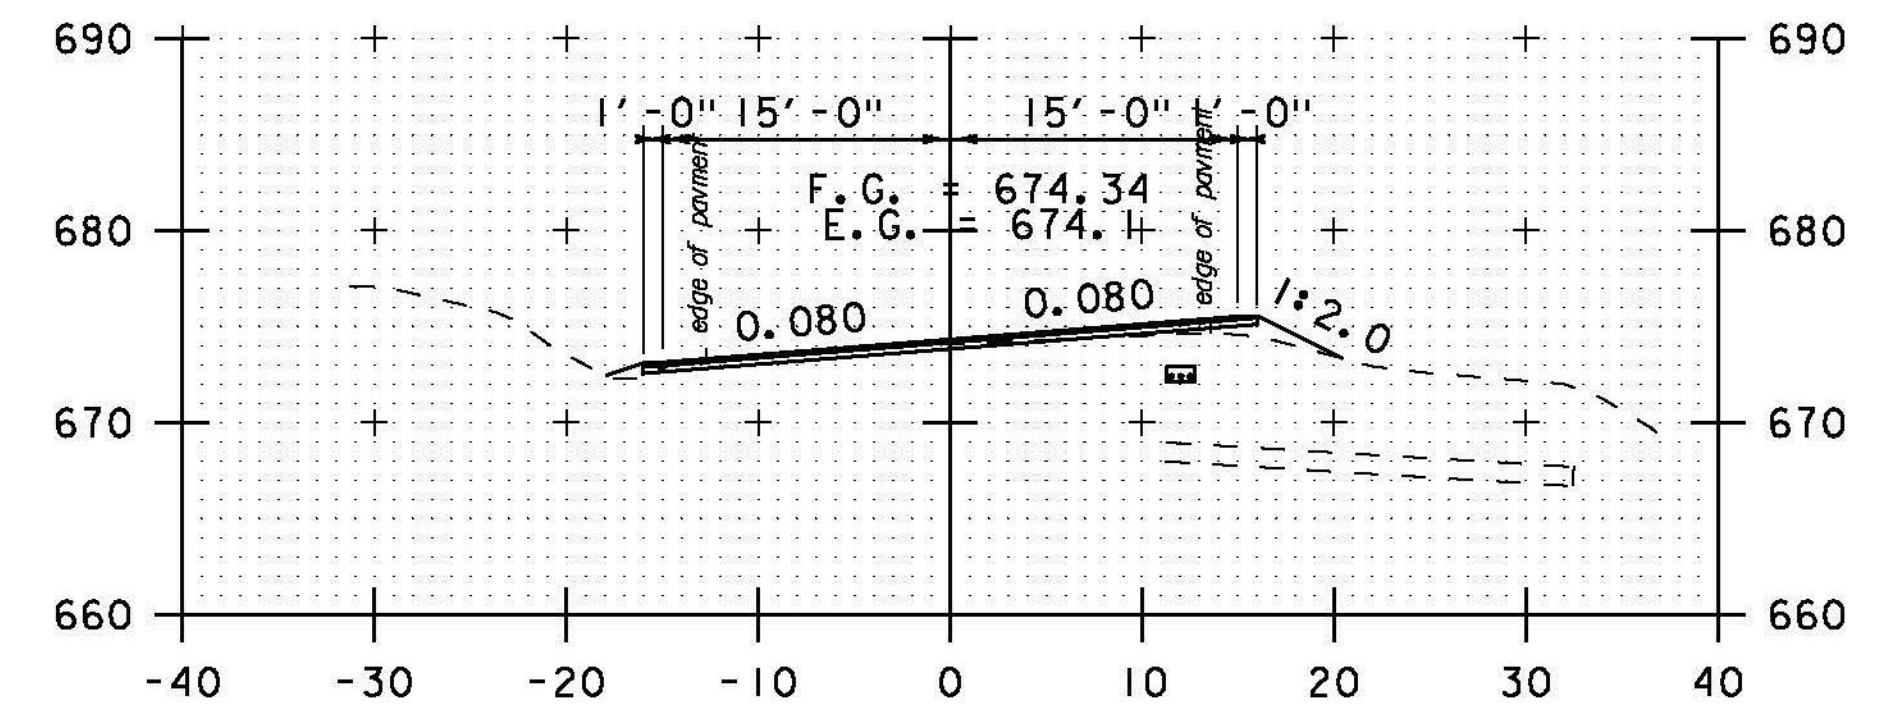

325+50

DRIVE RT

STA. 322+50 TO STA. 326+50

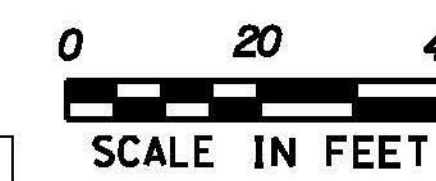

PROJECT NAME: BETHEL-RANDOLPH
PROJECT NUMBER: STP 292(I)

FILE NAME: piOC244.dgn
PROJECT LEADER: C. LATHROP
DESIGNED BY: S. LAMPHERE
CROSS SECTION SHEET 40

PLOT DATE: 4/23/2015
DRAWN BY: S. LAMPHERE
CHECKED BY: C. LATHROP
SHEET 174 OF 211