


DRIVE RT

12" STONE FILL, TYPE I (TYP.)
6" GRUBBING MATERIAL (TYP.)
GEOTEXTILE UNDER STONE FILL (TYP.)

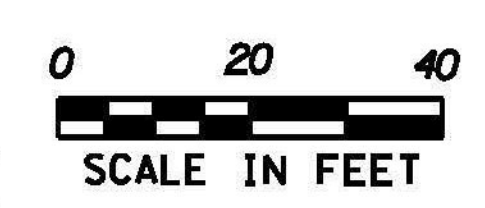

STA. 327+00 TO STA. 331+00

PROJECT NAME:	BETHEL-RANDOLPH
PROJECT NUMBER:	STP 292(I)
FILE NAME:	piOC244.dgn
PROJECT LEADER:	C. LATHROP
DESIGNED BY:	S. LAMPHERE
CROSS SECTION SHEET:	41
PLOT DATE:	4/23/2015
DRAWN BY:	S. LAMPHERE
CHECKED BY:	C. LATHROP
SHEET:	175 OF 211