




346+00

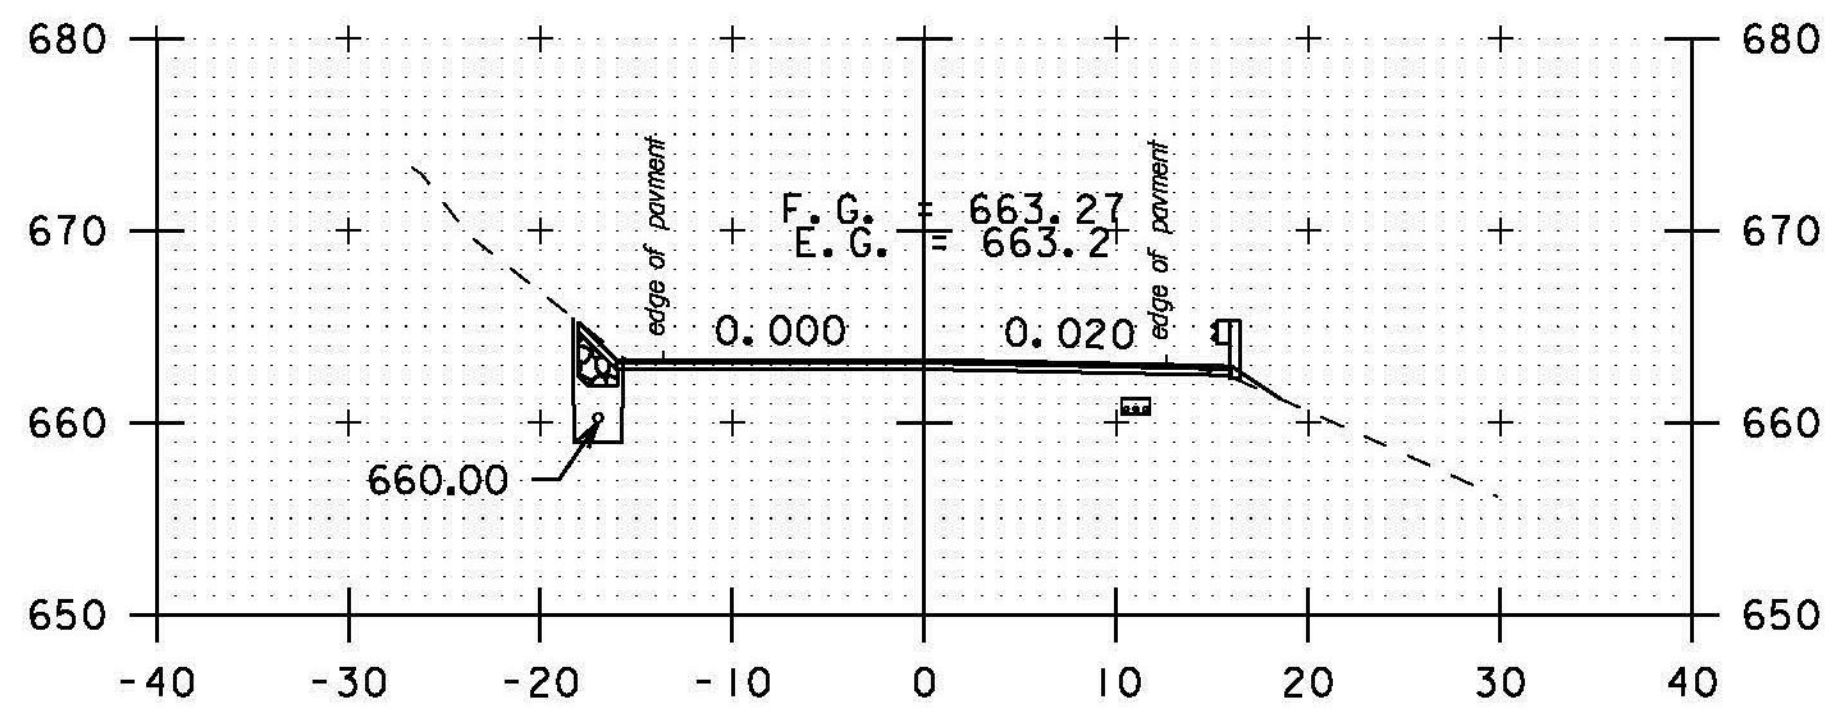


347+50

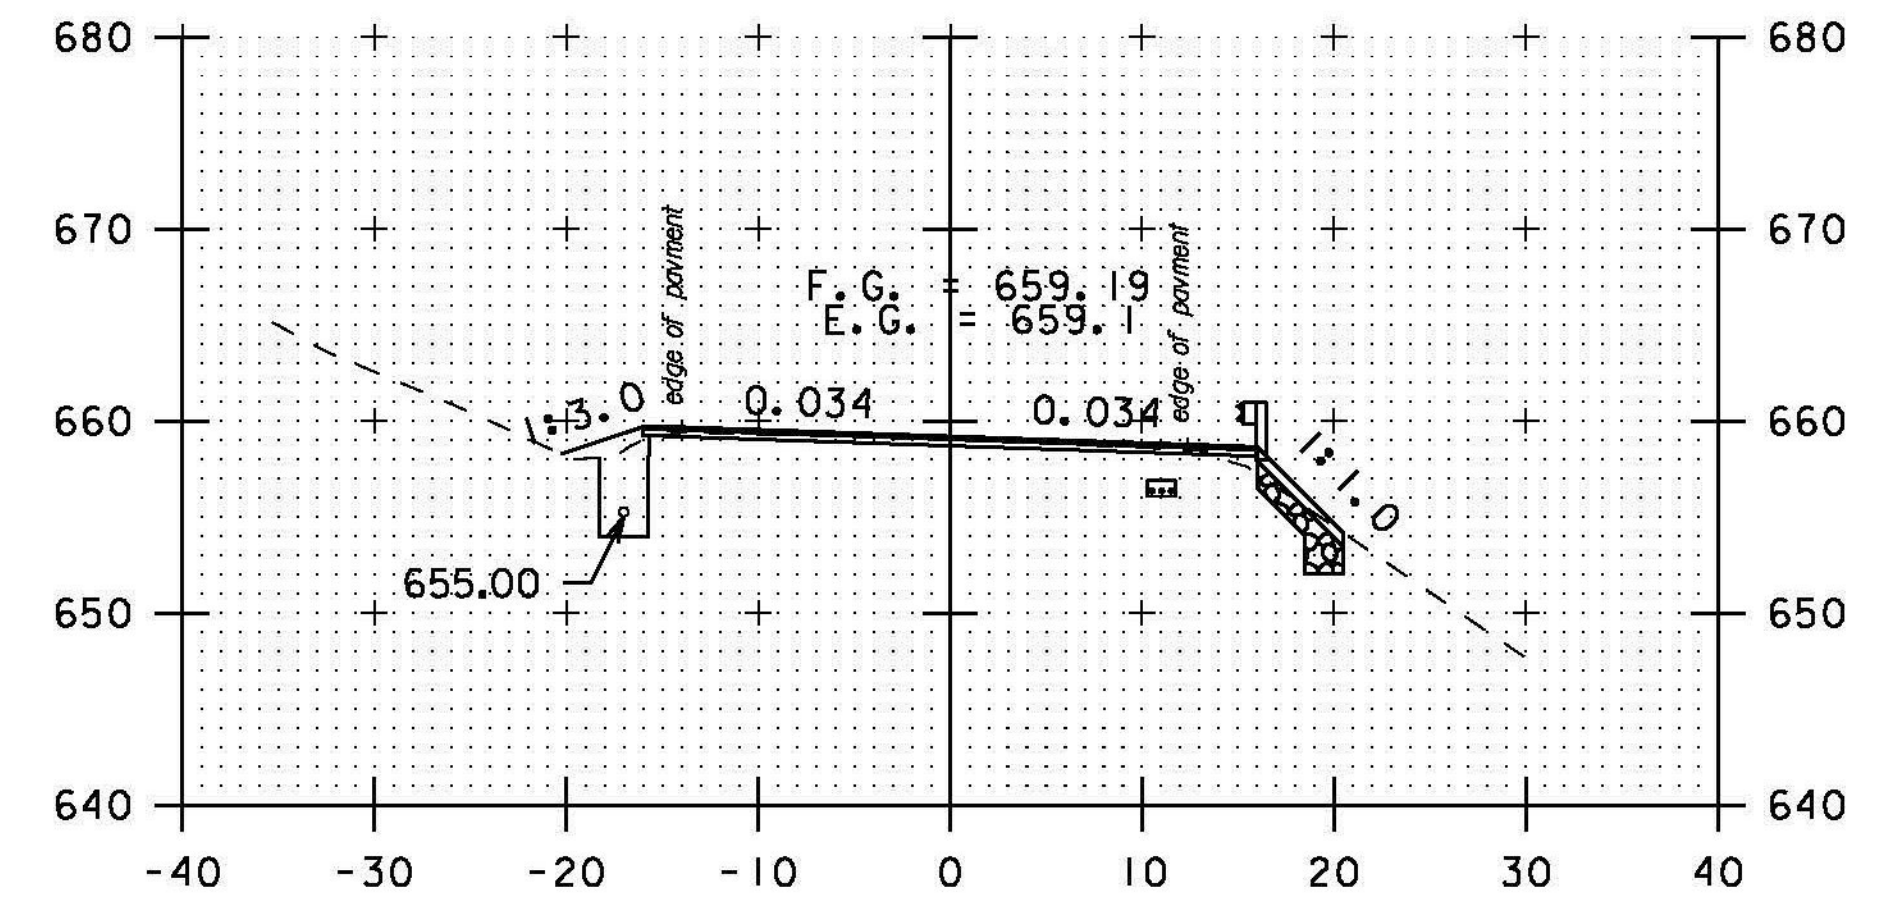


349+00

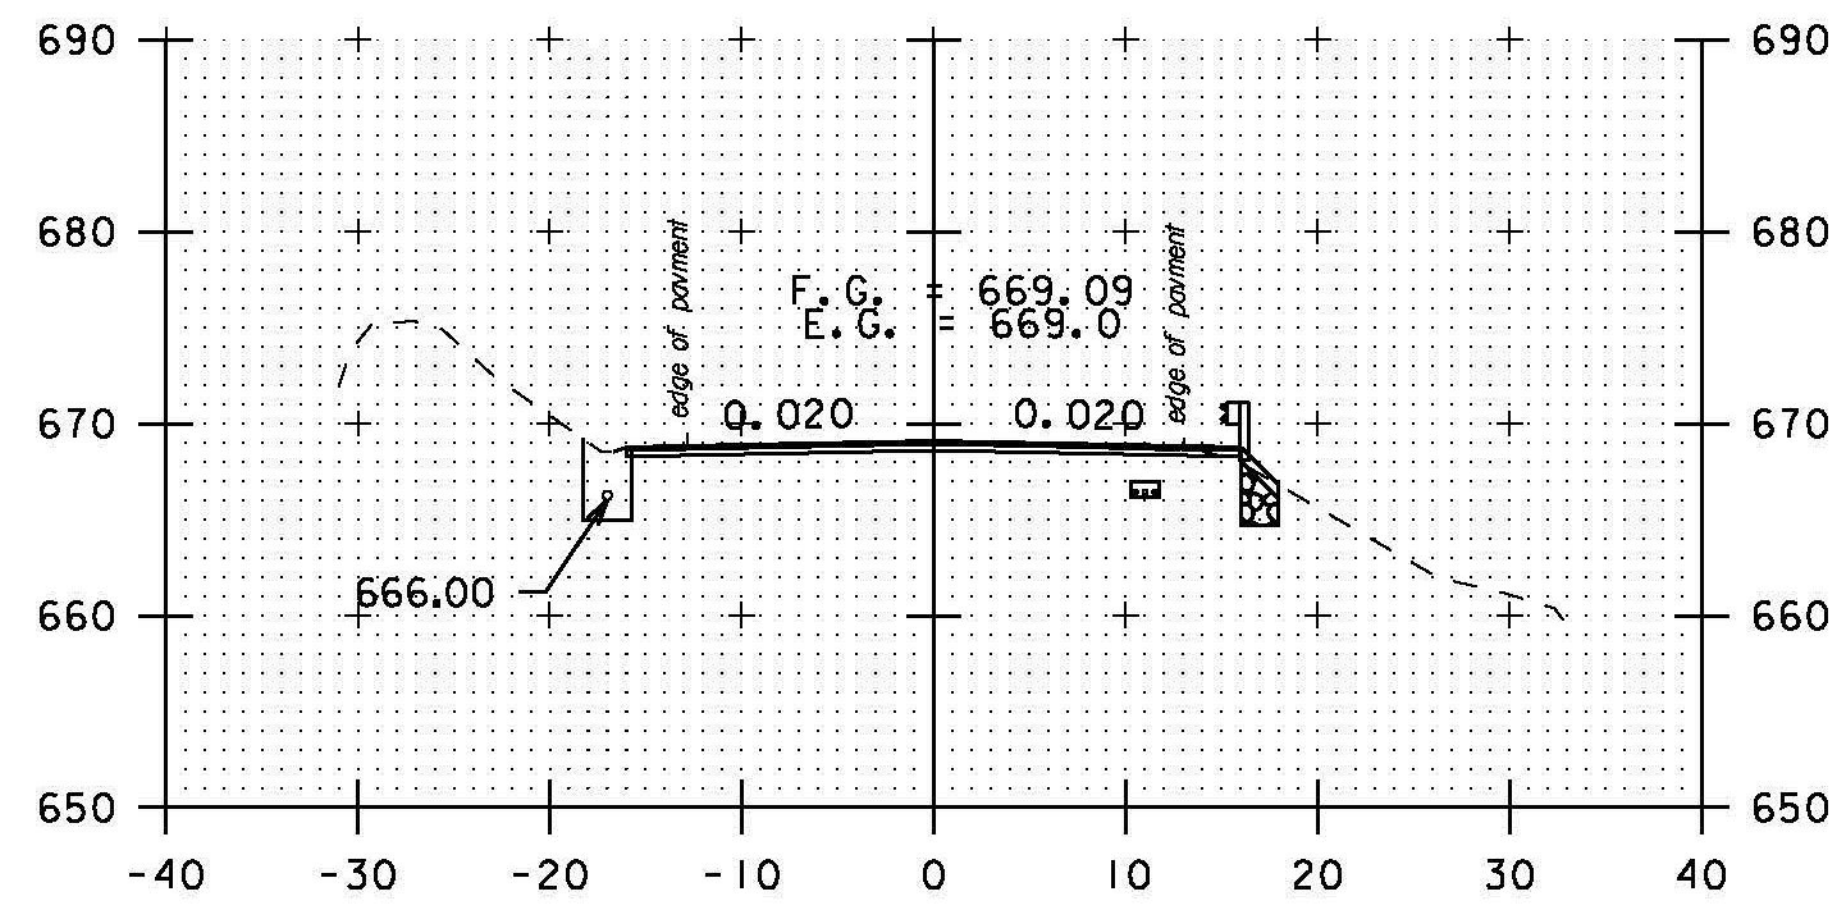


345+50

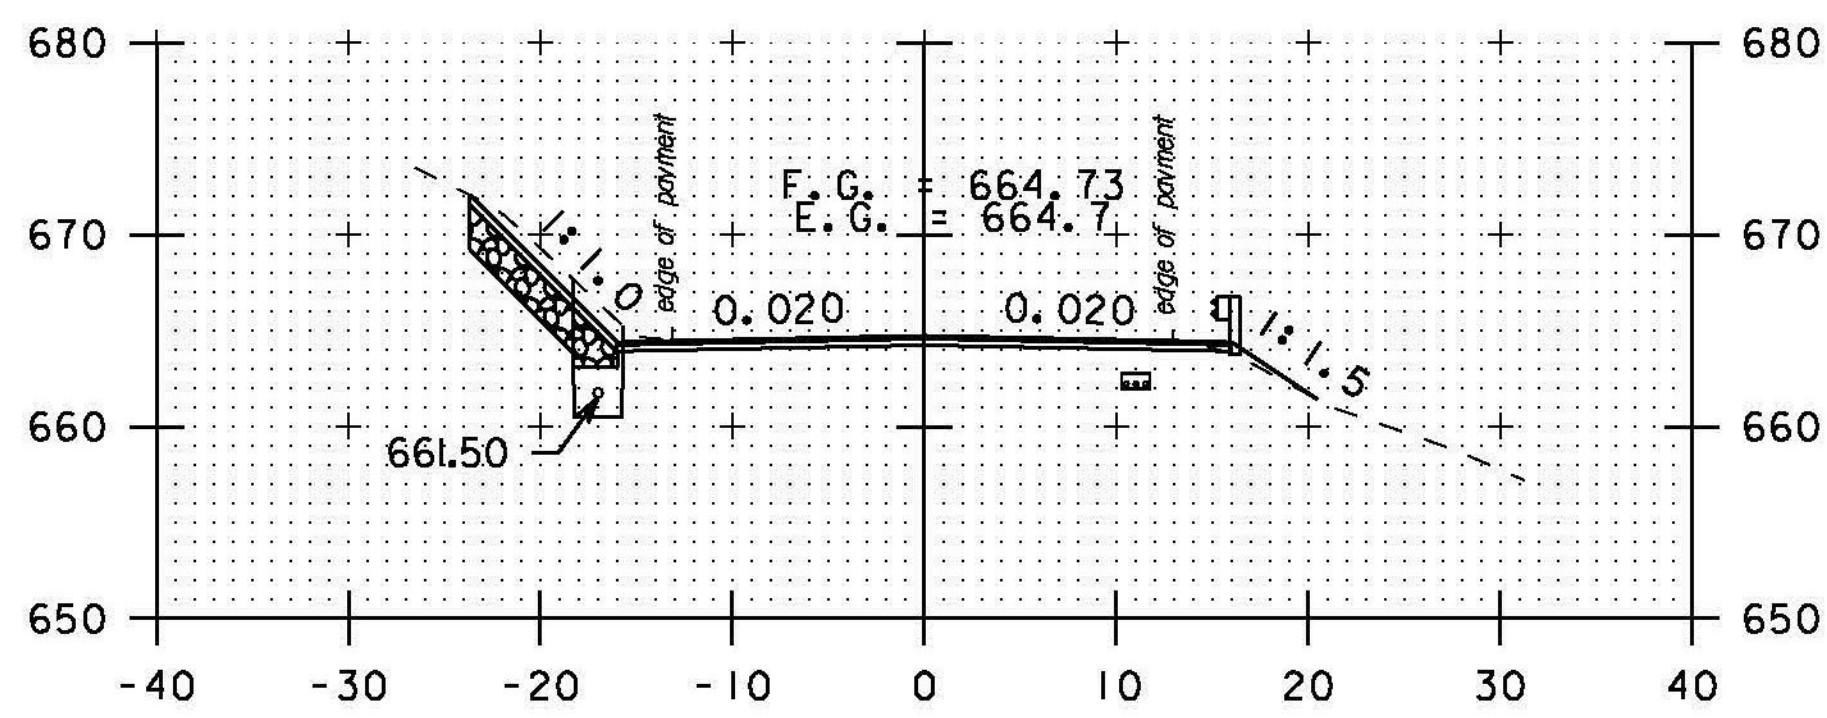


347+00

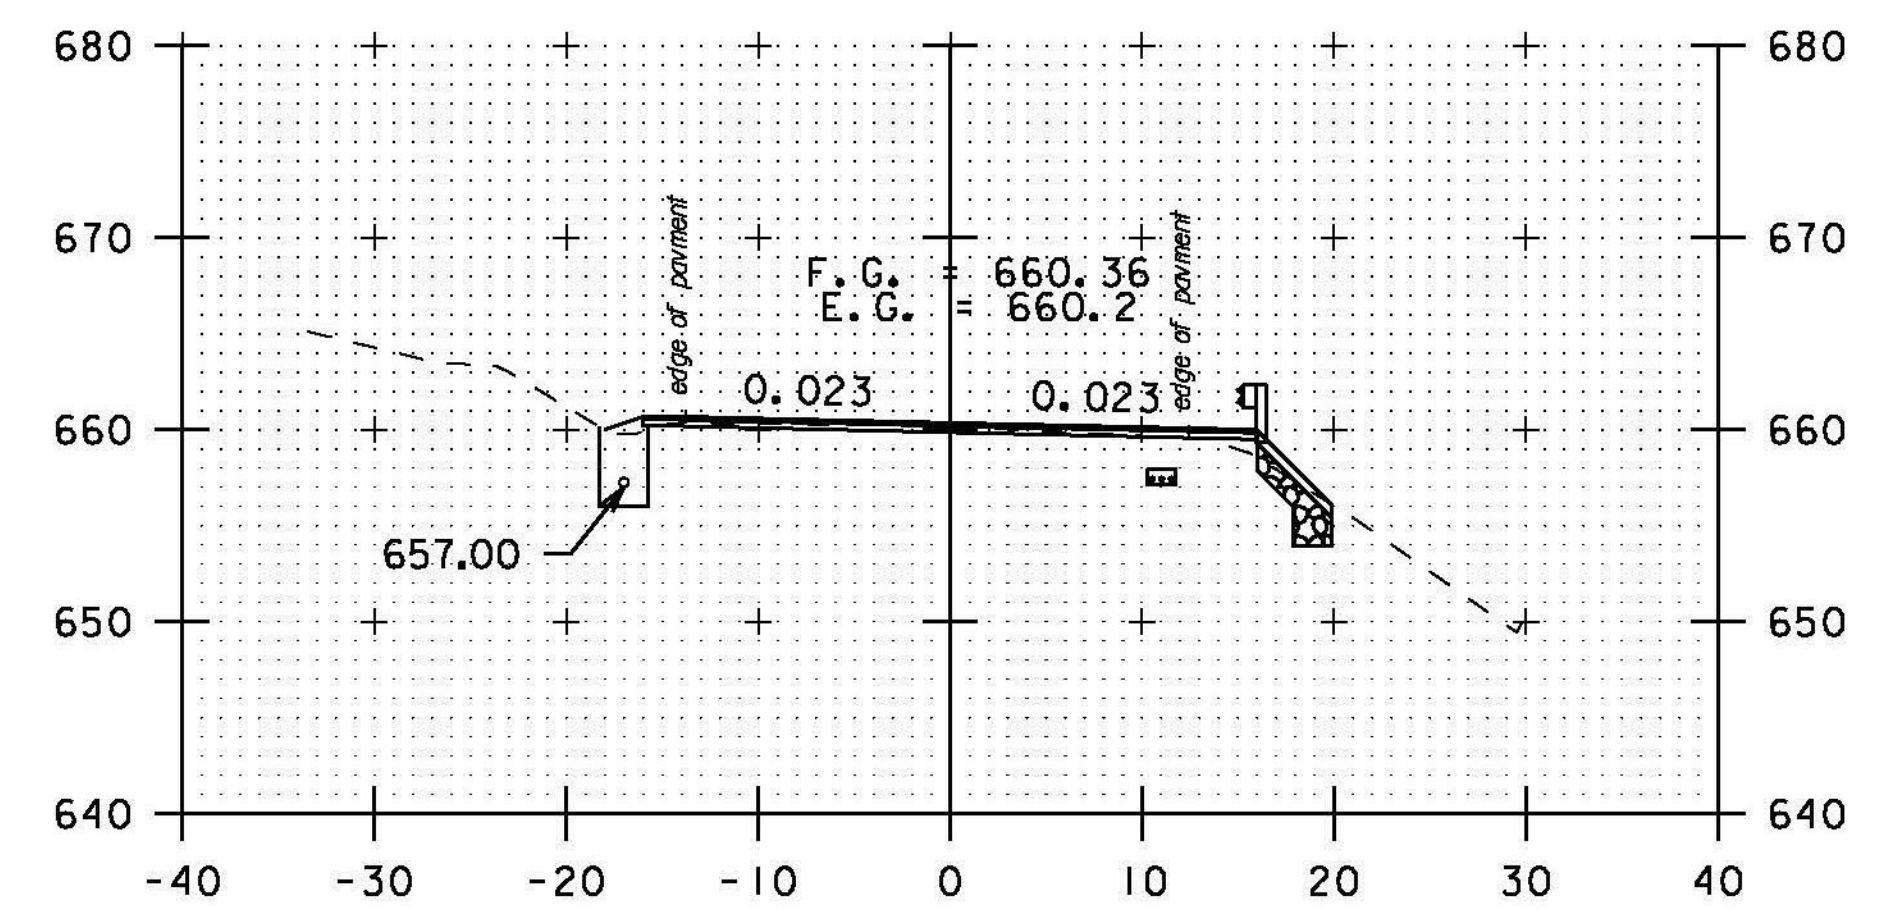


348+50

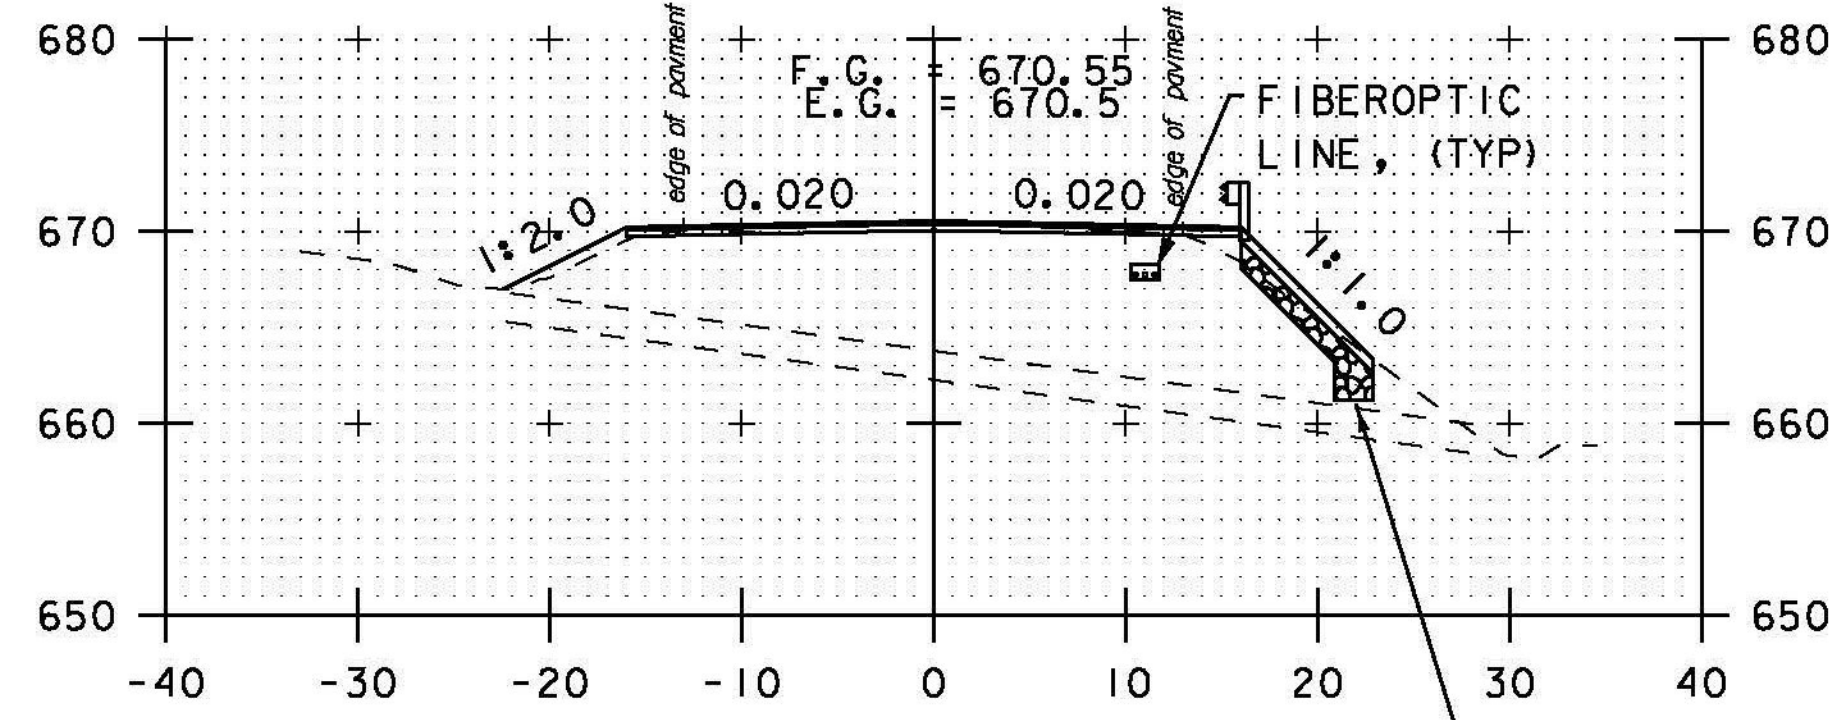

345+00

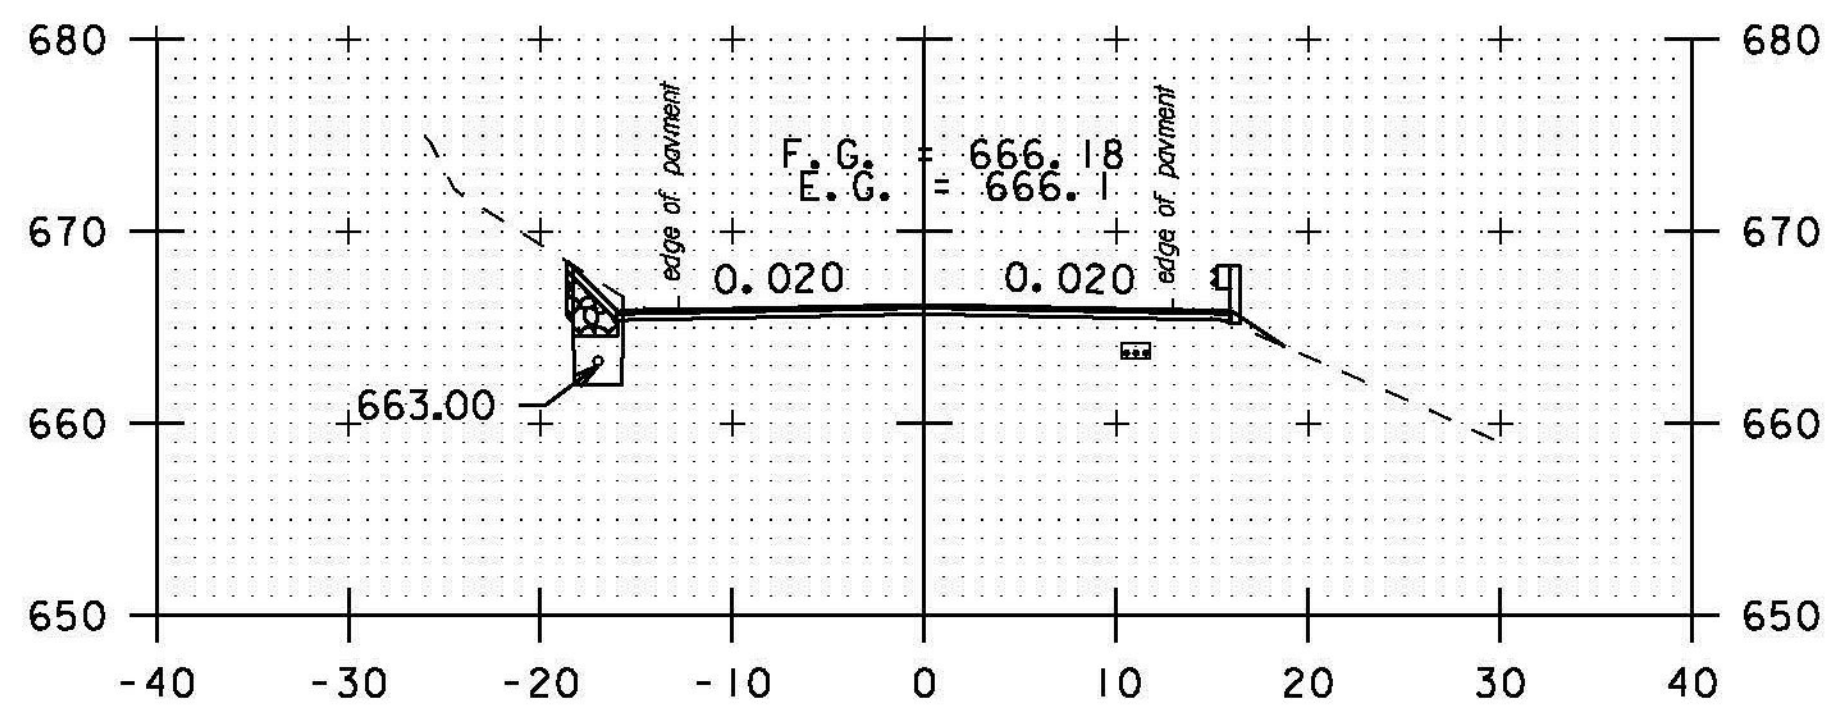


346+50

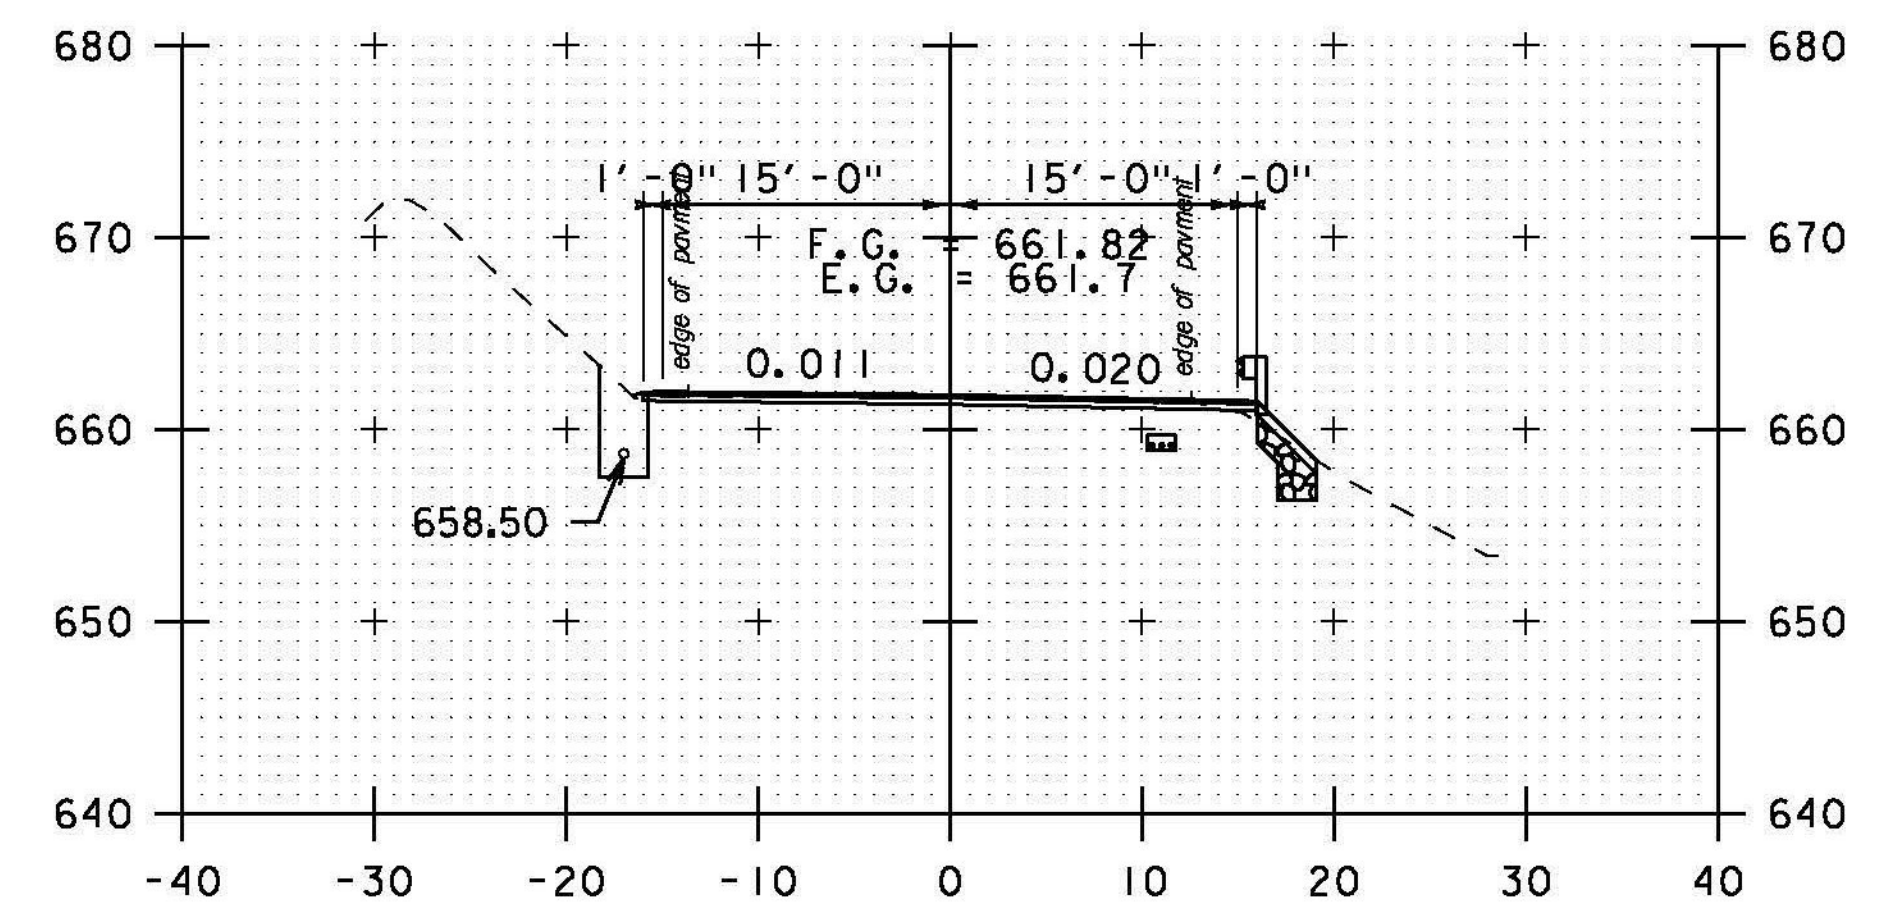

348+00

12" STONE FILL, TYPE I (TYP.)  
 6" GRUBBING MATERIAL (TYP.)  
 GEOTEXTILE UNDER STONE FILL (TYP.)

STA. 345+00 TO STA. 349+00

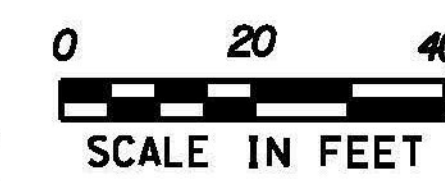

PROJECT NAME: BETHEL-RANDOLPH  
 PROJECT NUMBER: STP 292(I)

FILE NAME: piOC244.dgn  
 PROJECT LEADER: C. LATHROP  
 DESIGNED BY: S. LAMPHERE  
 CROSS SECTION SHEET 45

PLOT DATE: 4/23/2015  
 DRAWN BY: S. LAMPHERE  
 CHECKED BY: C. LATHROP  
 SHEET 179 OF 211