




359+50

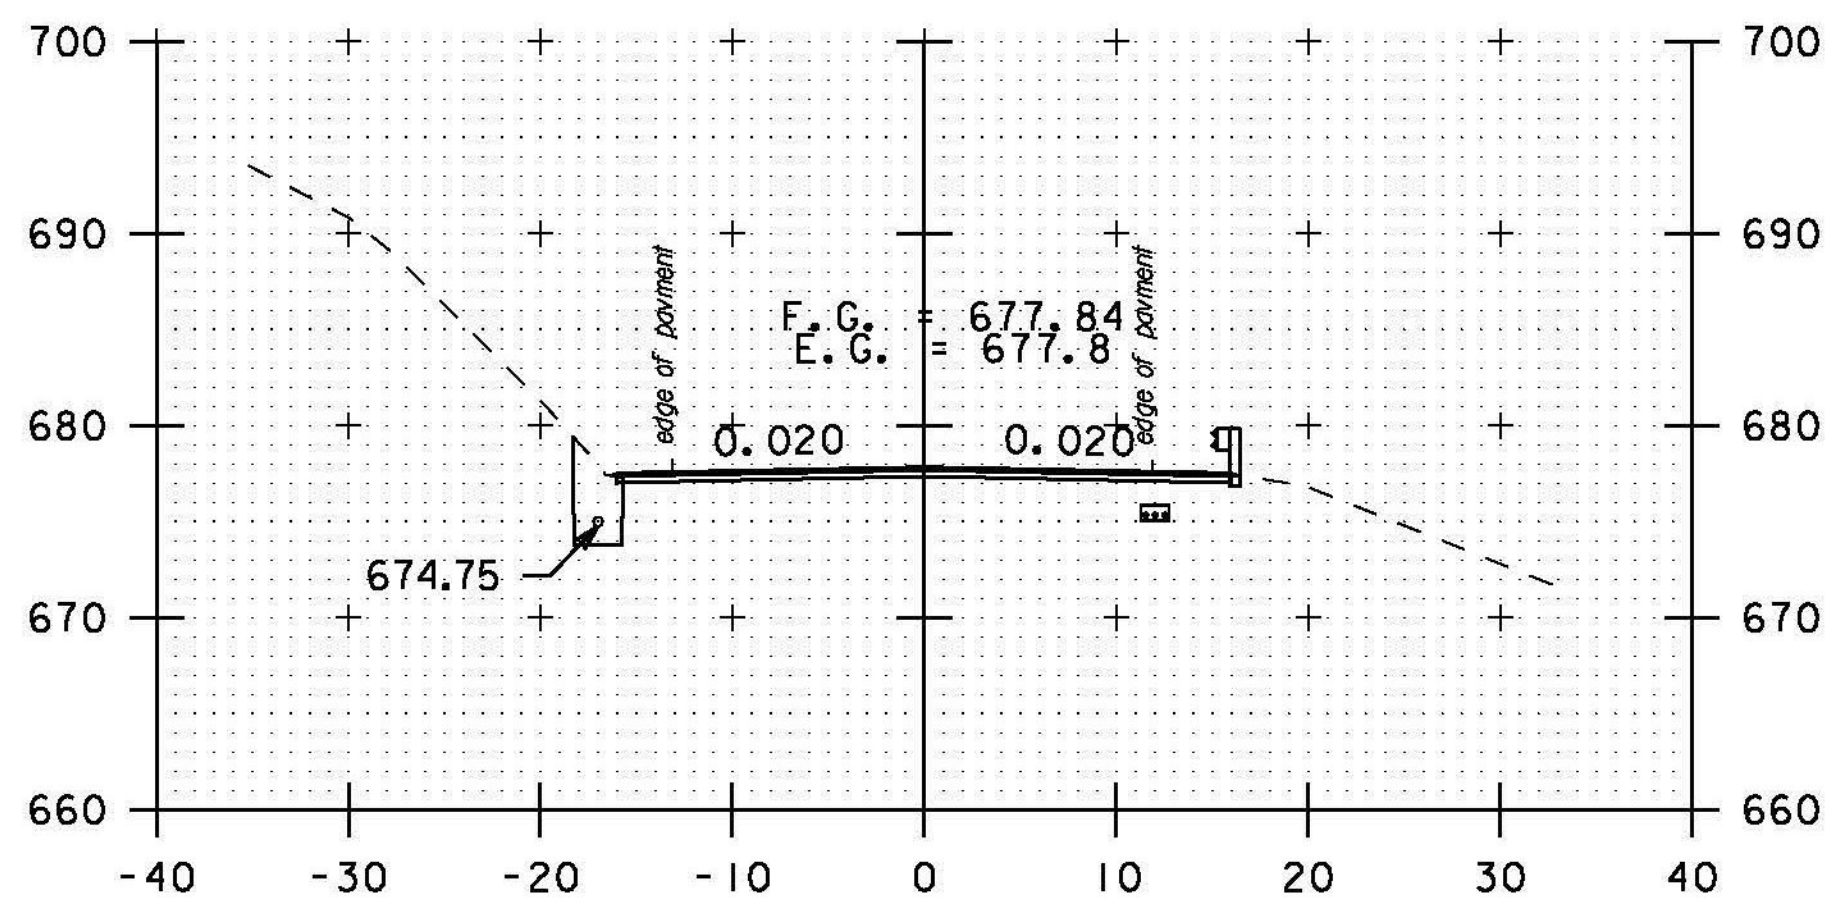


361+00

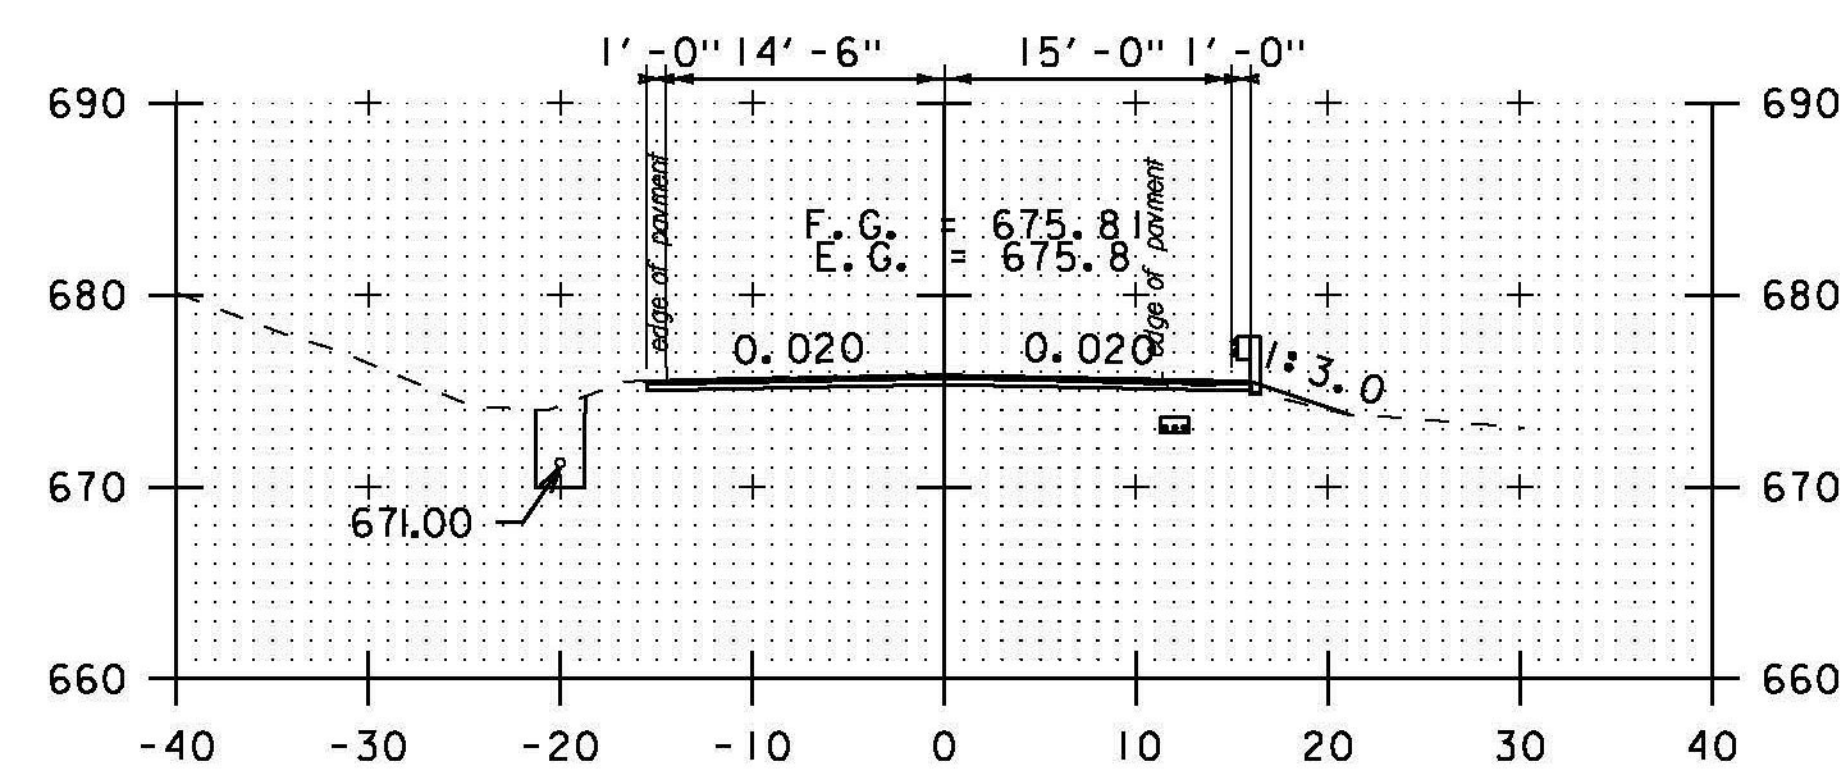


362+50

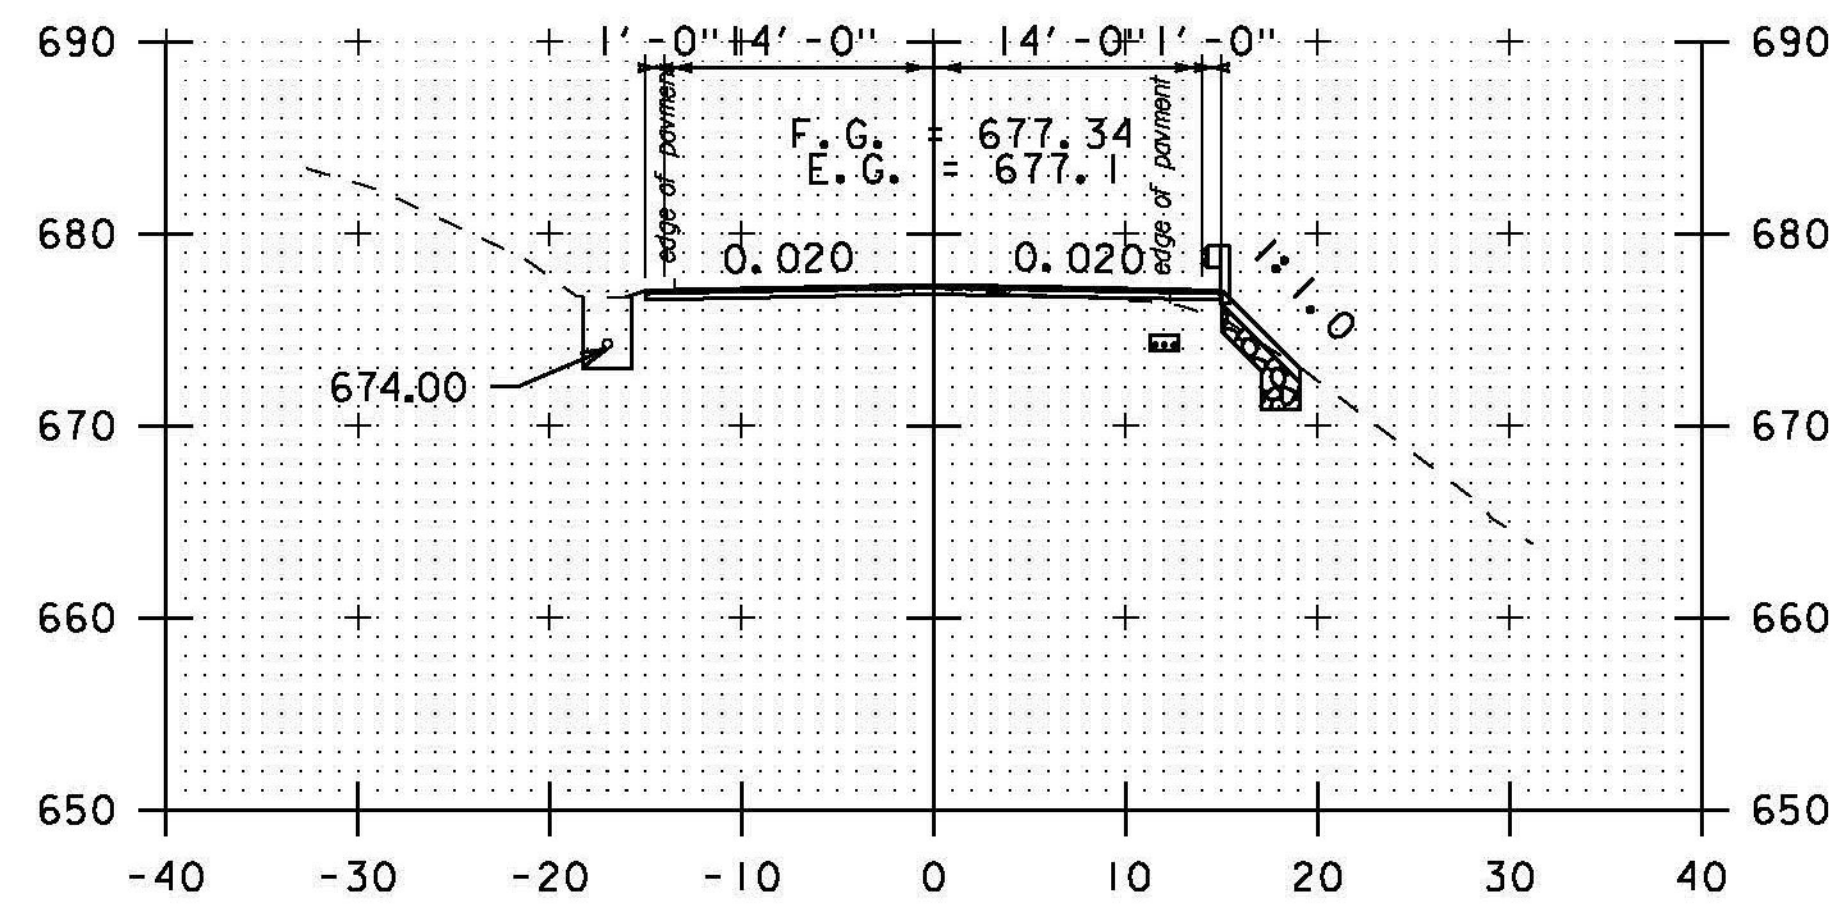


359+00

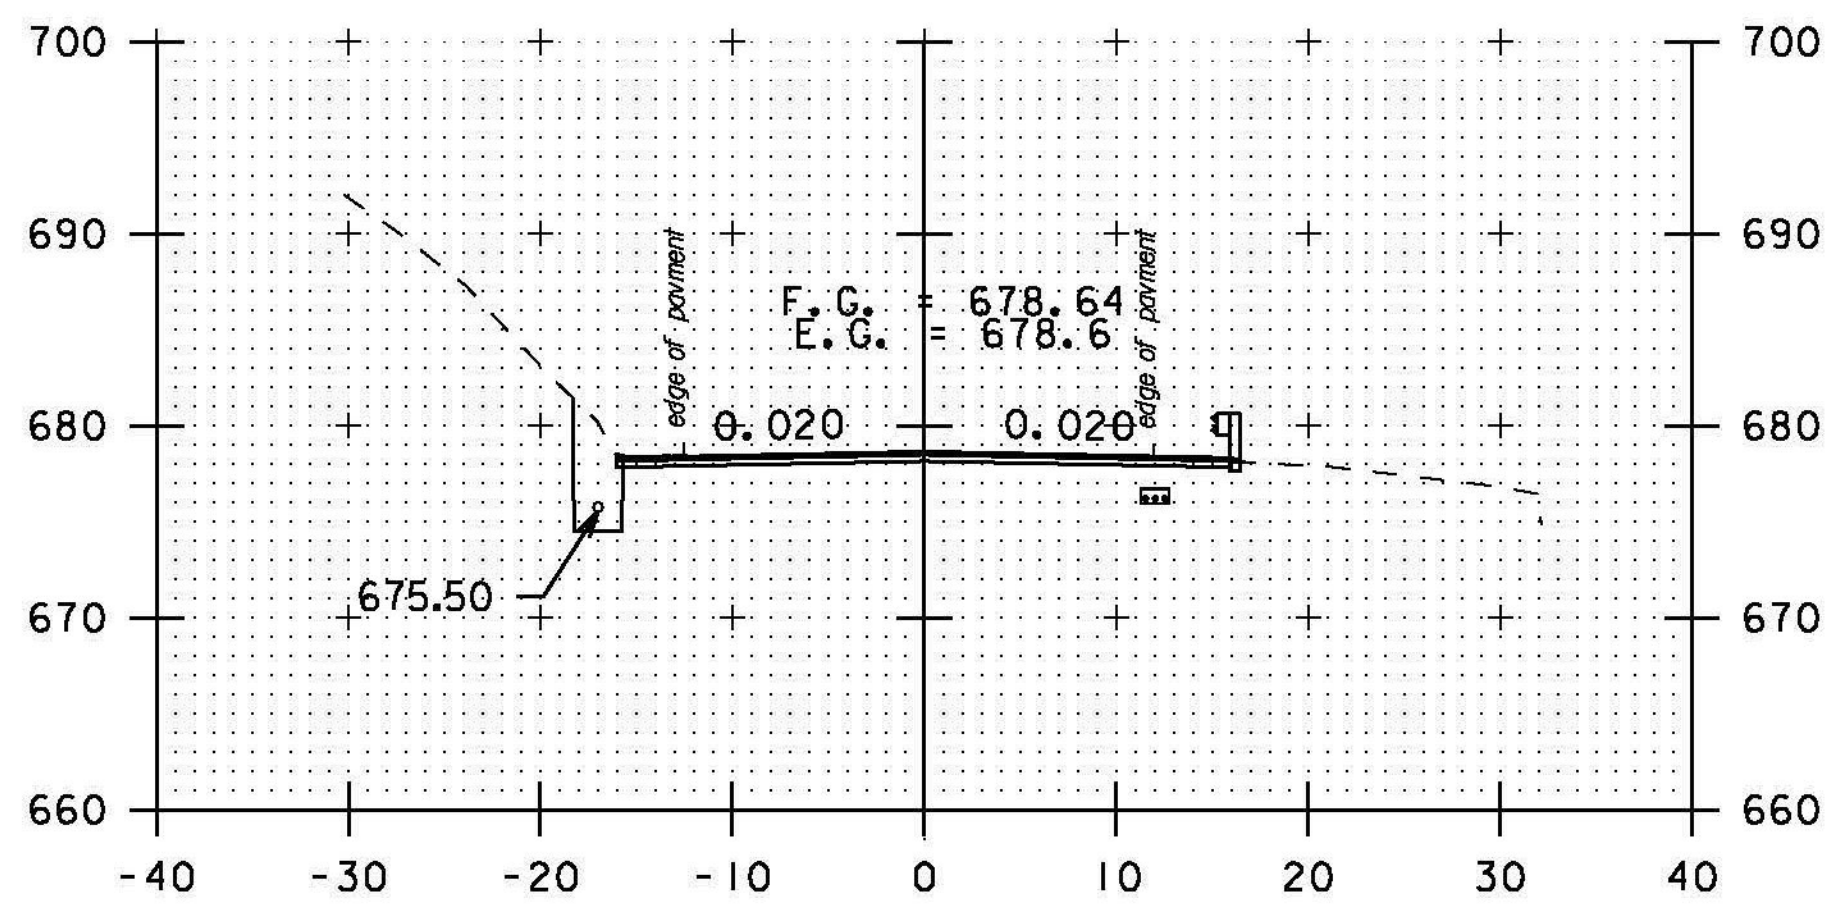


360+50

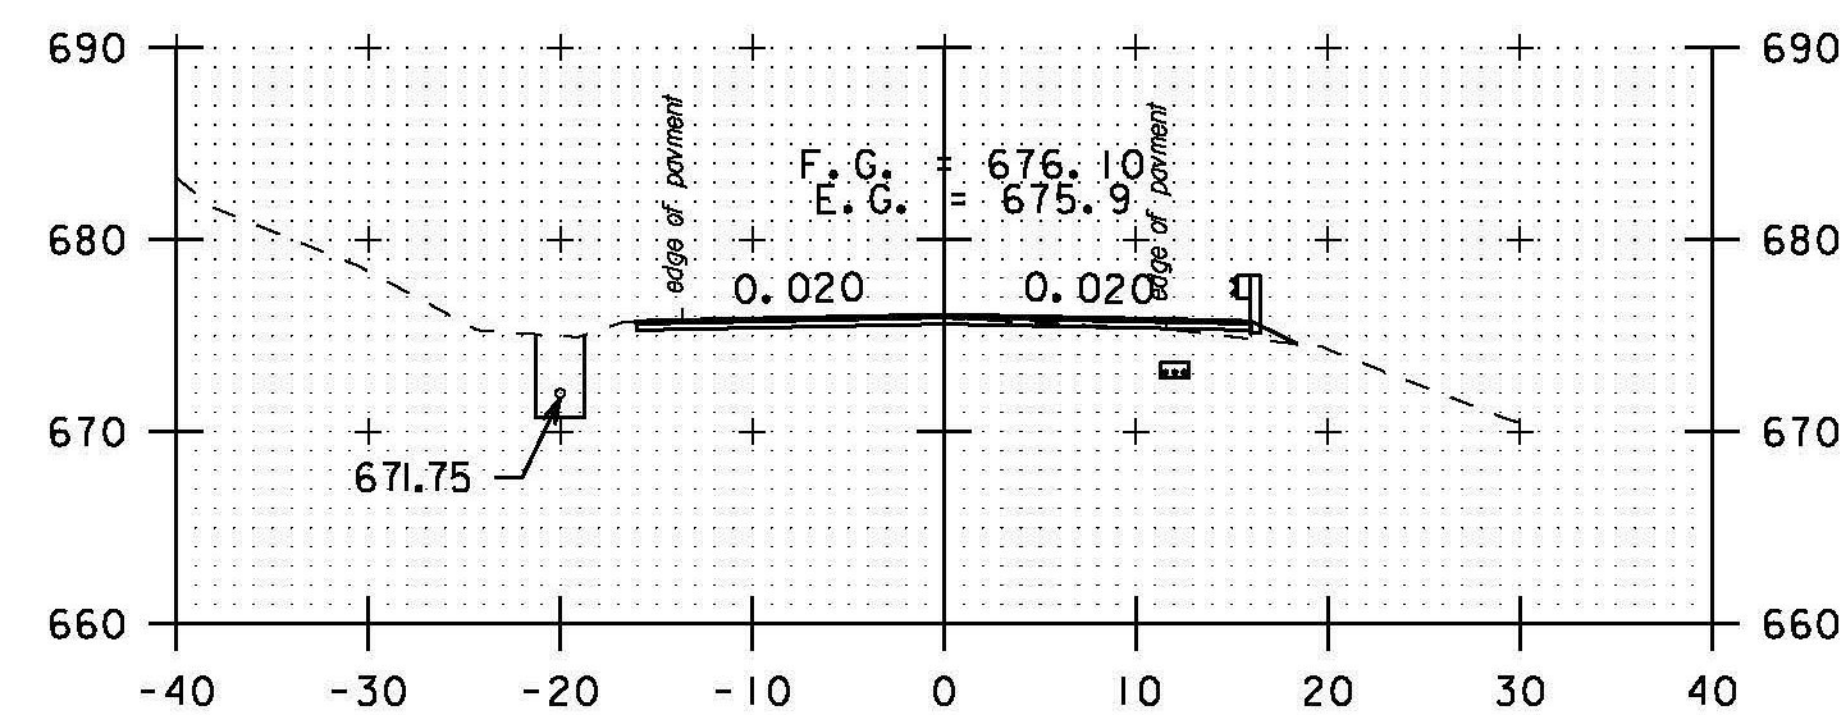


362+00

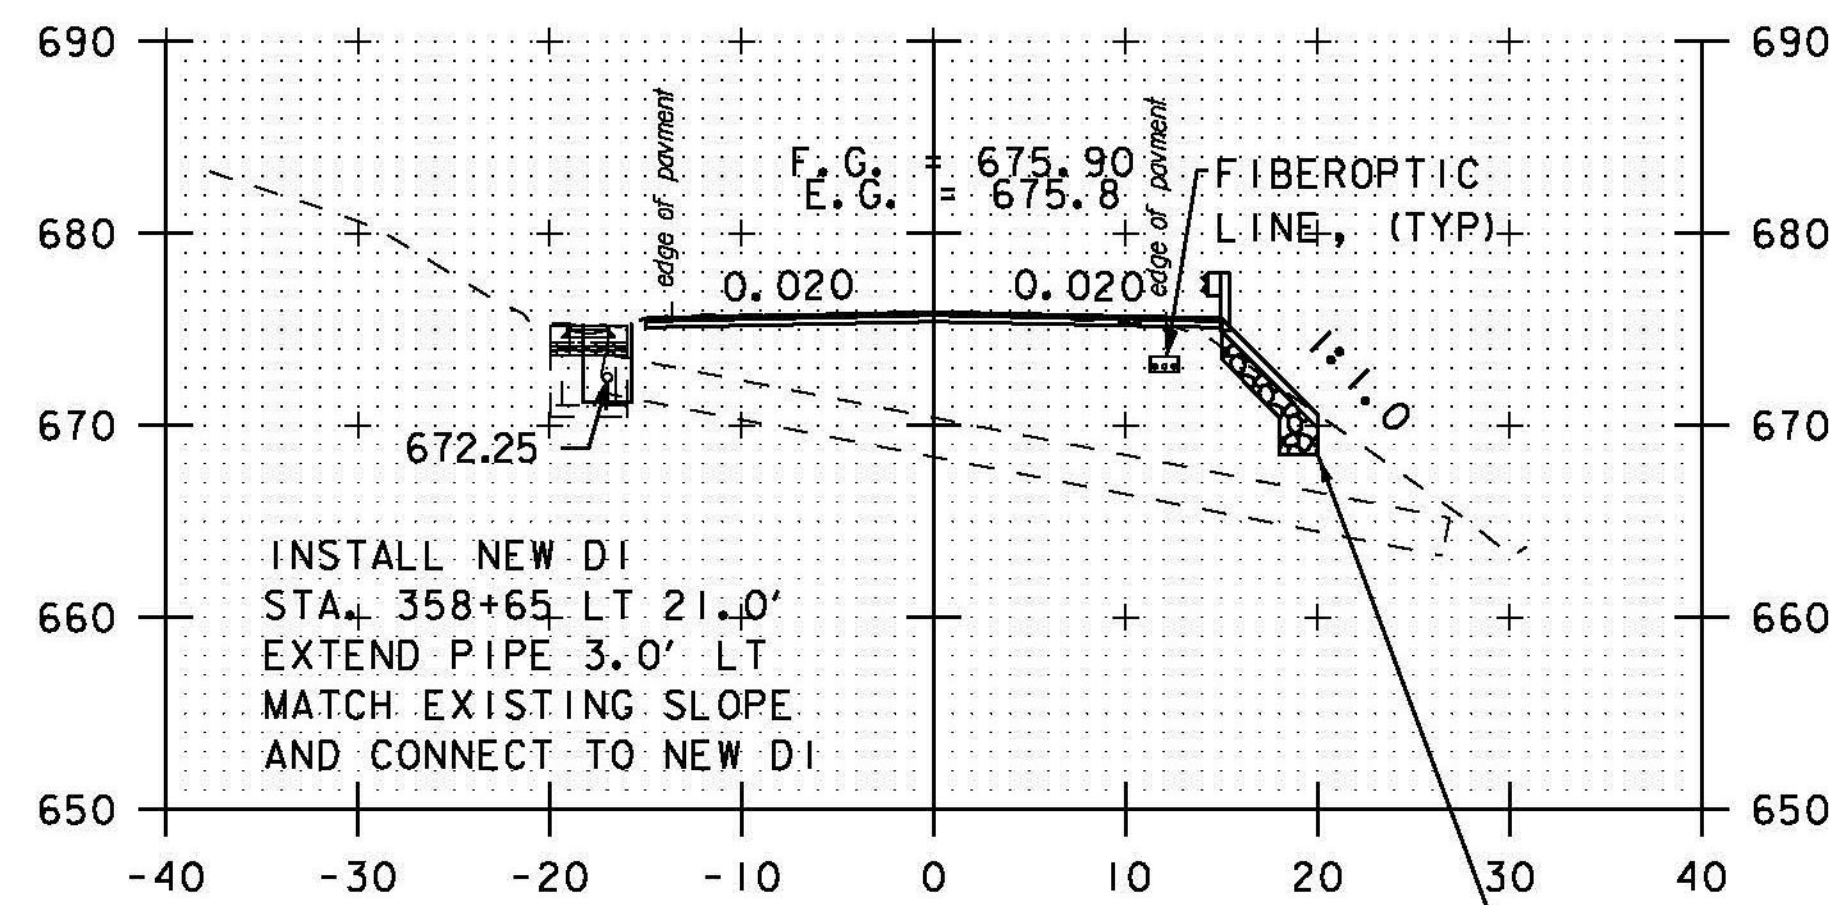

358+50

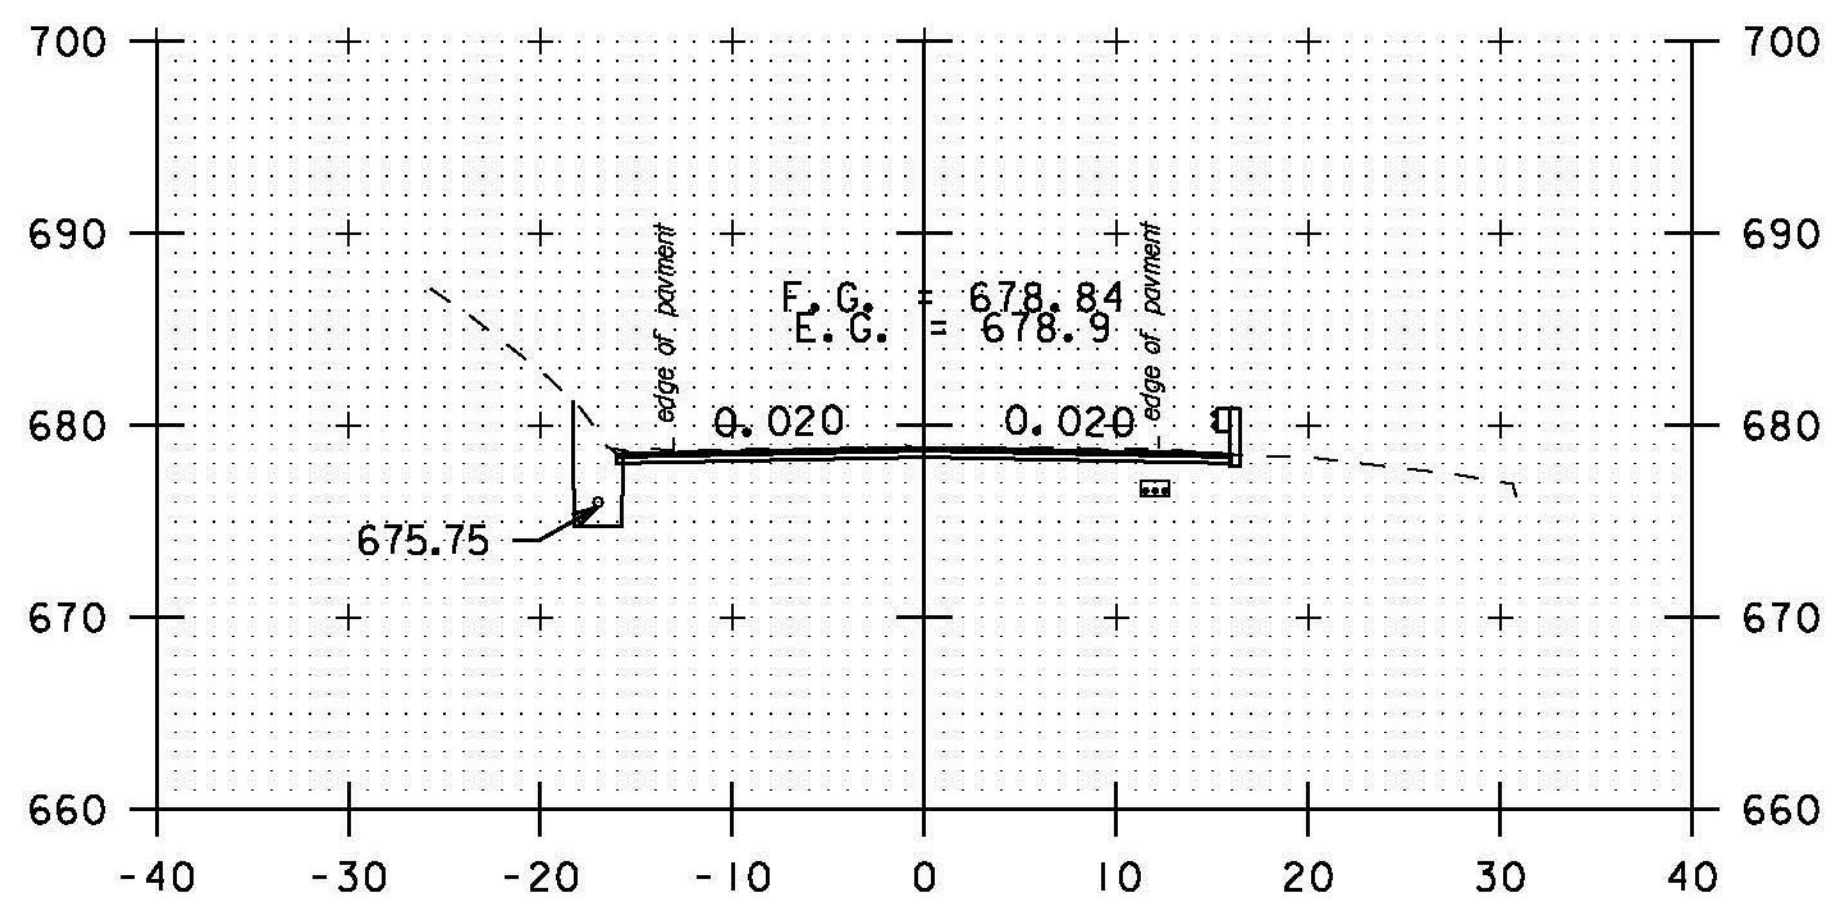


360+00

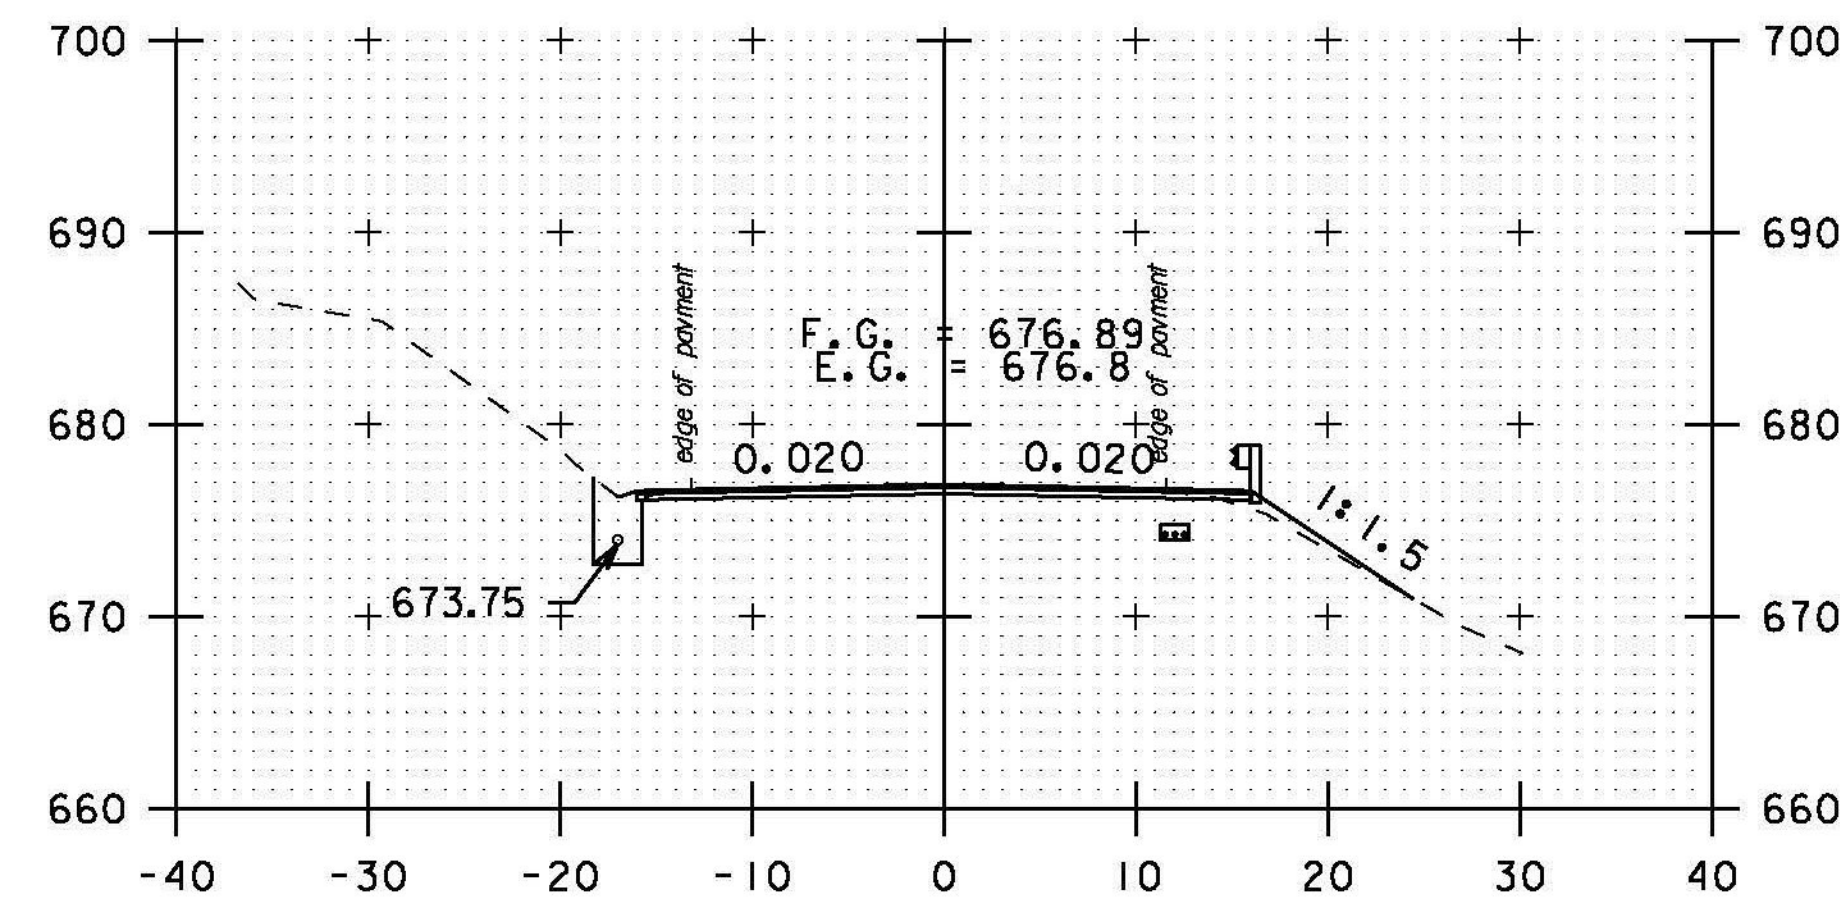

361+50

12" STONE FILL, TYPE I (TYP.)
6" GRUBBING MATERIAL (TYP.)
GEOTEXTILE UNDER STONE FILL (TYP.)

STA. 358+50 TO STA. 362+50

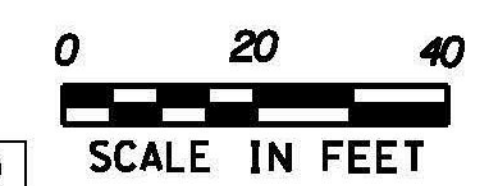

SCALE IN FEET

PROJECT NAME:	BETHEL-RANDOLPH
PROJECT NUMBER:	STP 292(I)
FILE NAME:	piOC244.dgn
PROJECT LEADER:	C. LATHROP
DESIGNED BY:	S. LAMPHERE
CROSS SECTION SHEET:	48
PLOT DATE:	4/23/2015
DRAWN BY:	S. LAMPHERE
CHECKED BY:	C. LATHROP
SHEET:	182 OF 211