




364+00

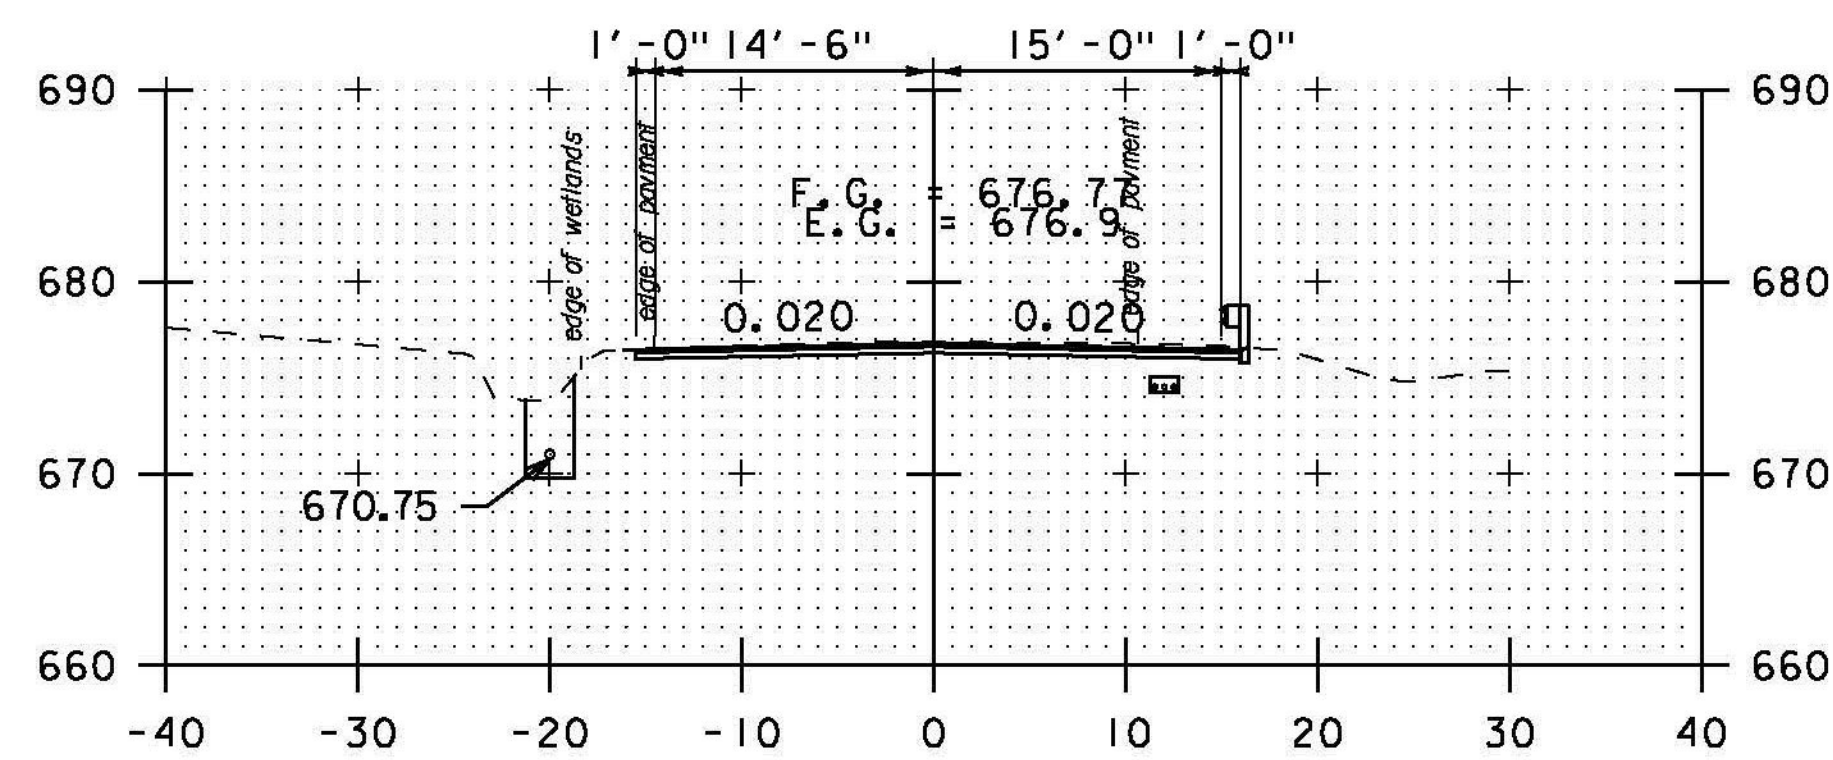


363+50

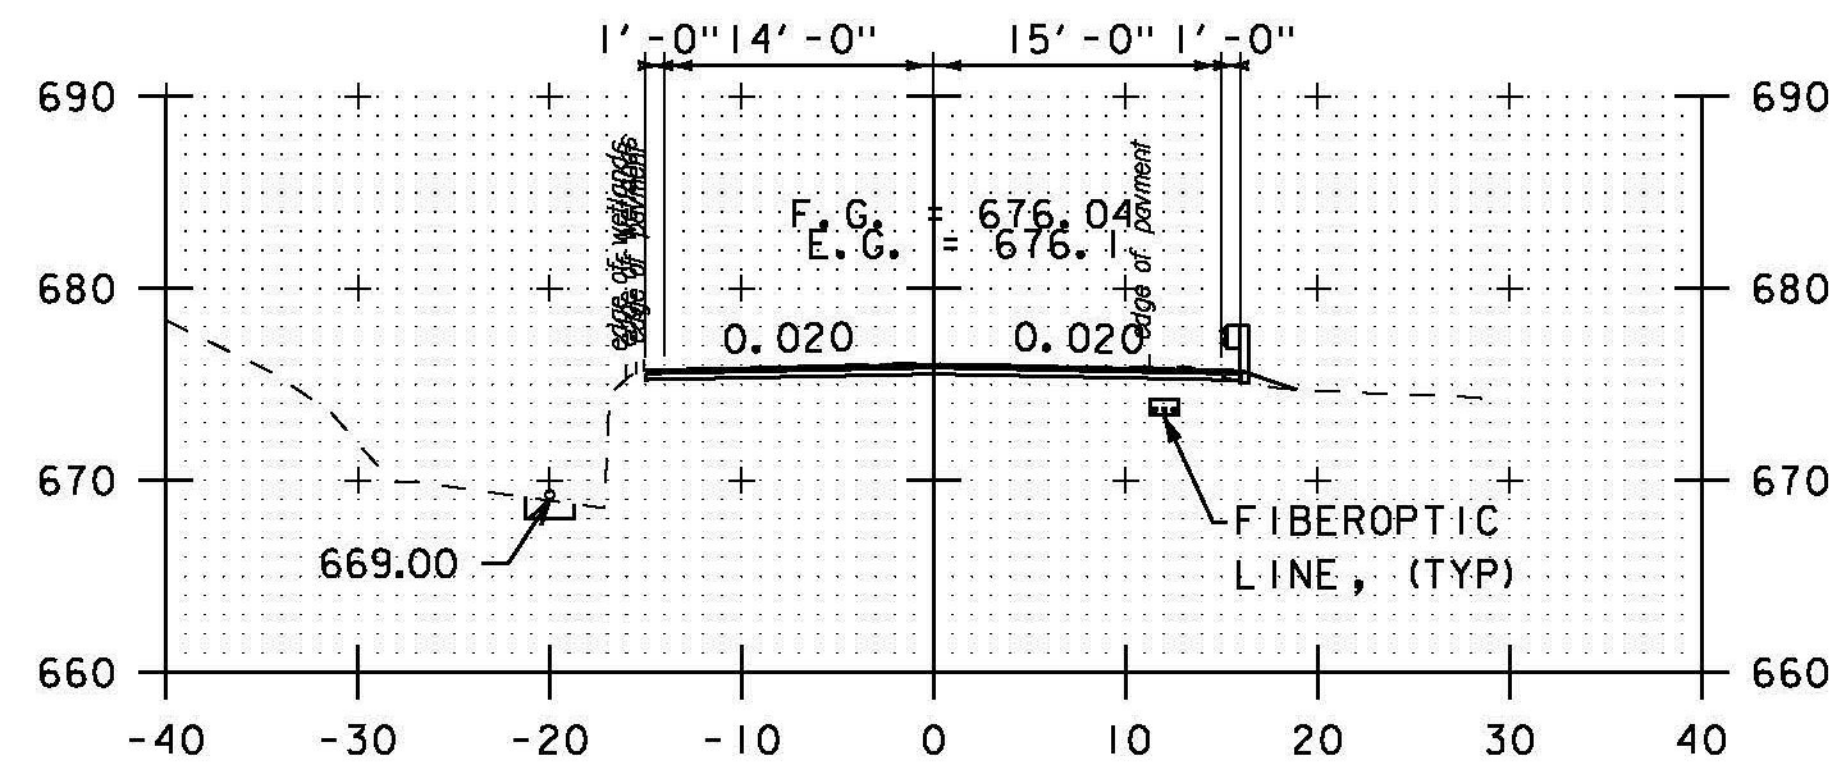


363+00

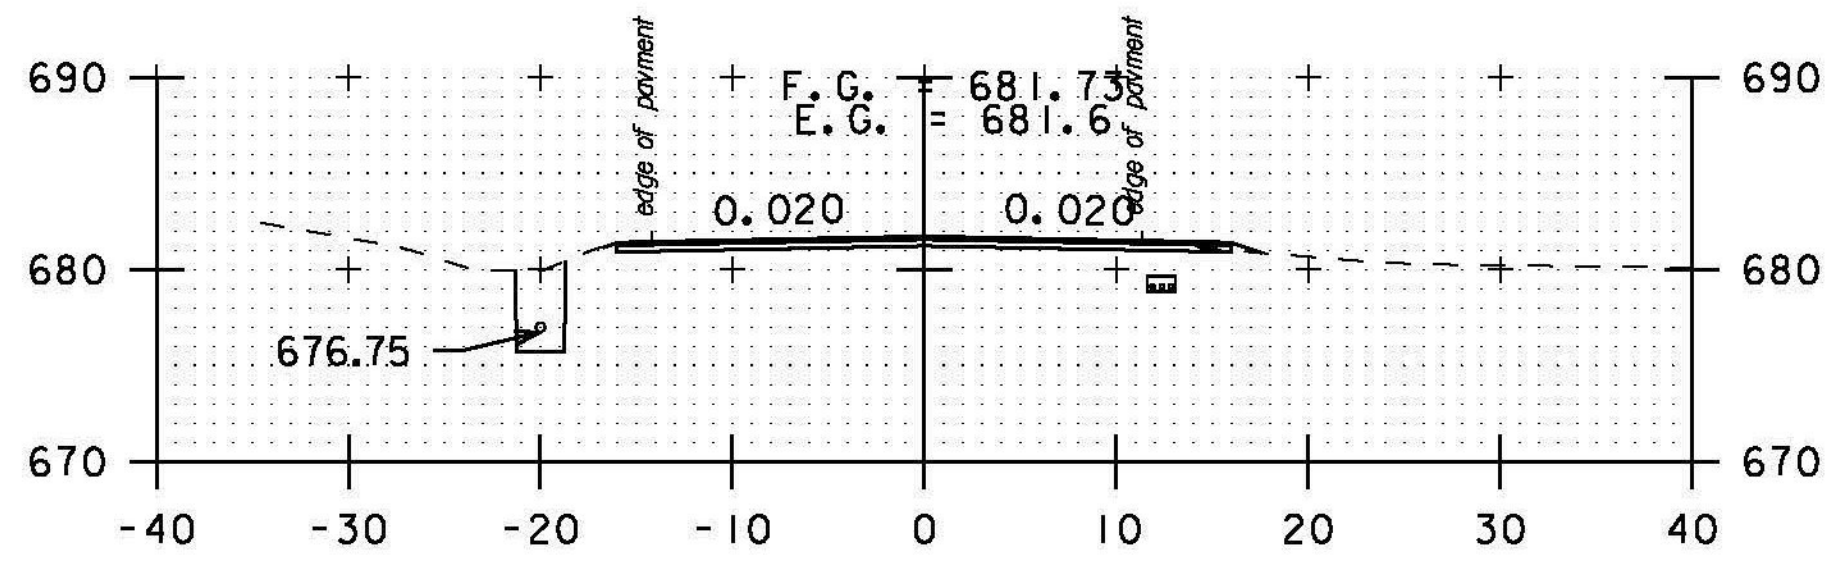


366+00

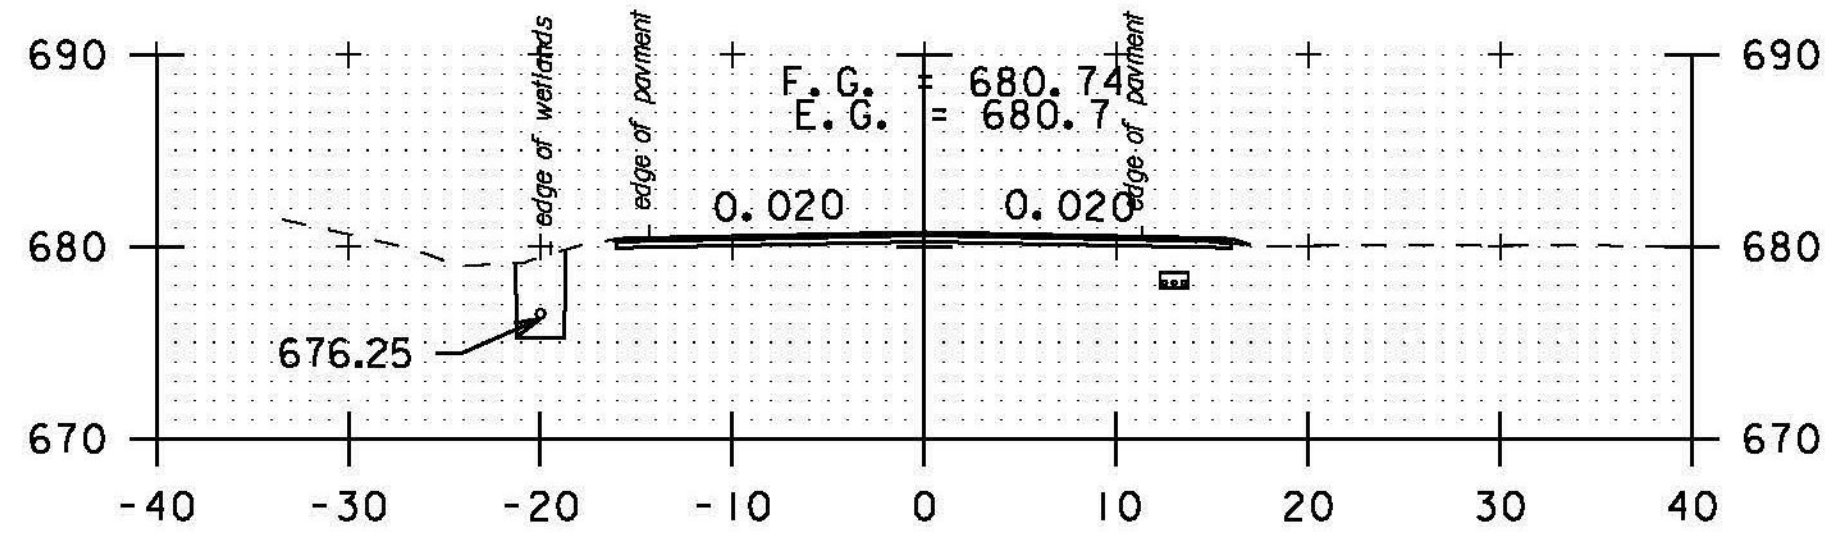


365+50

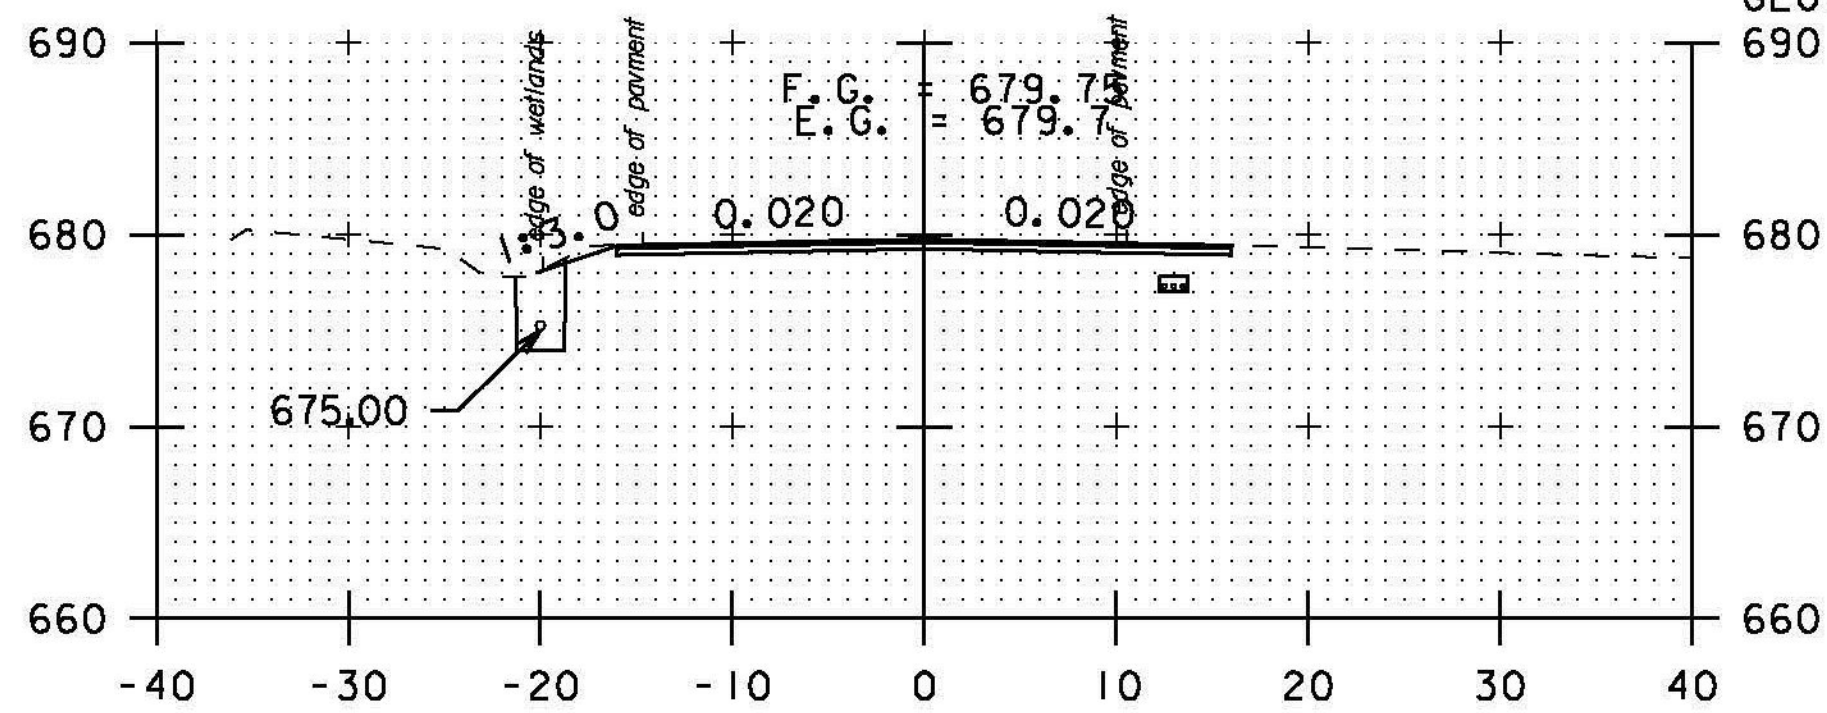


365+00

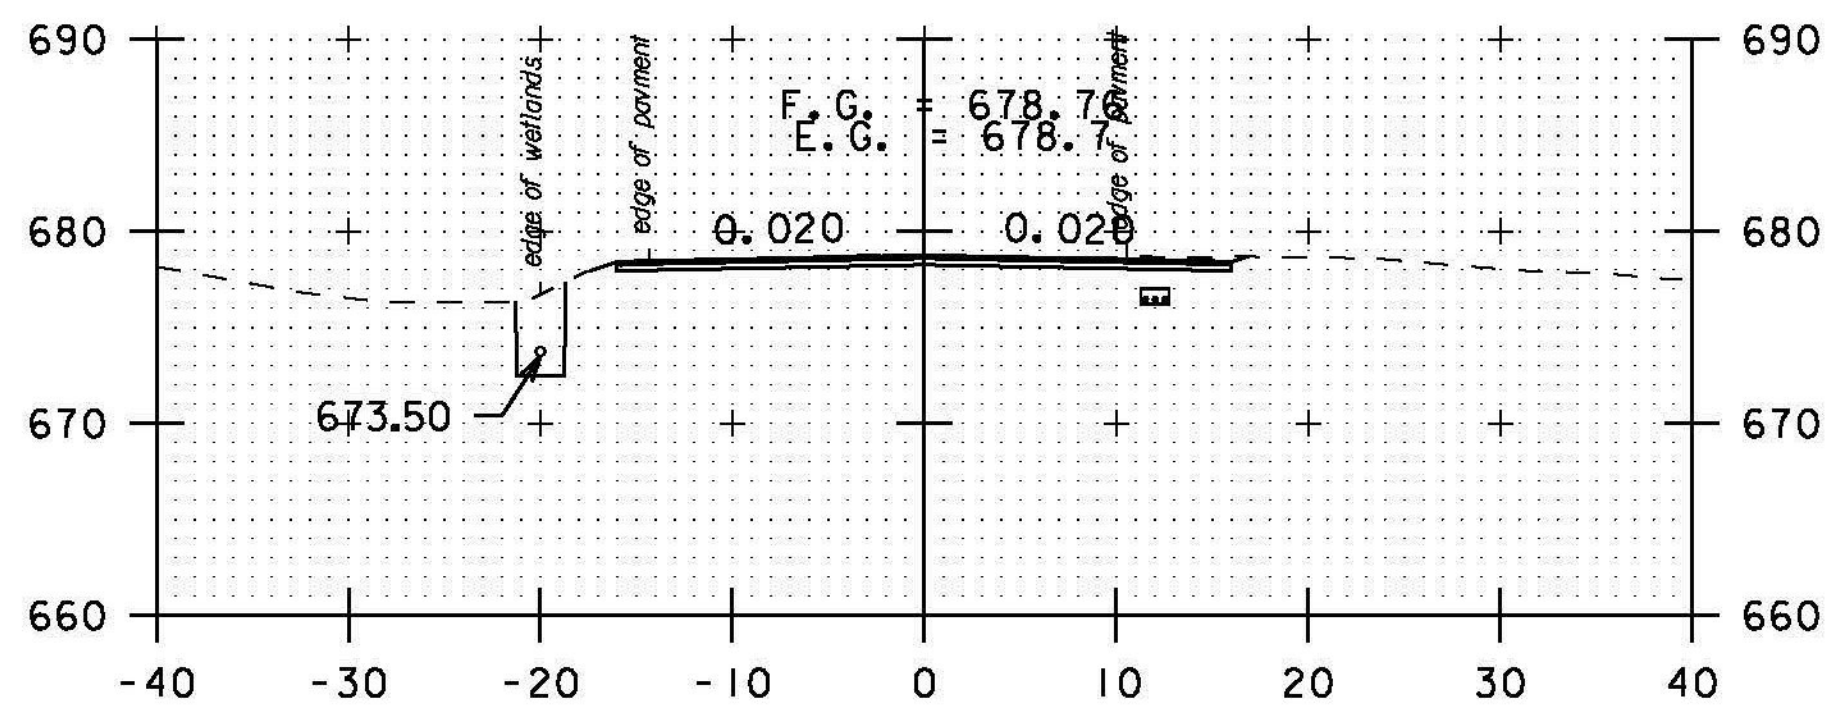


364+50

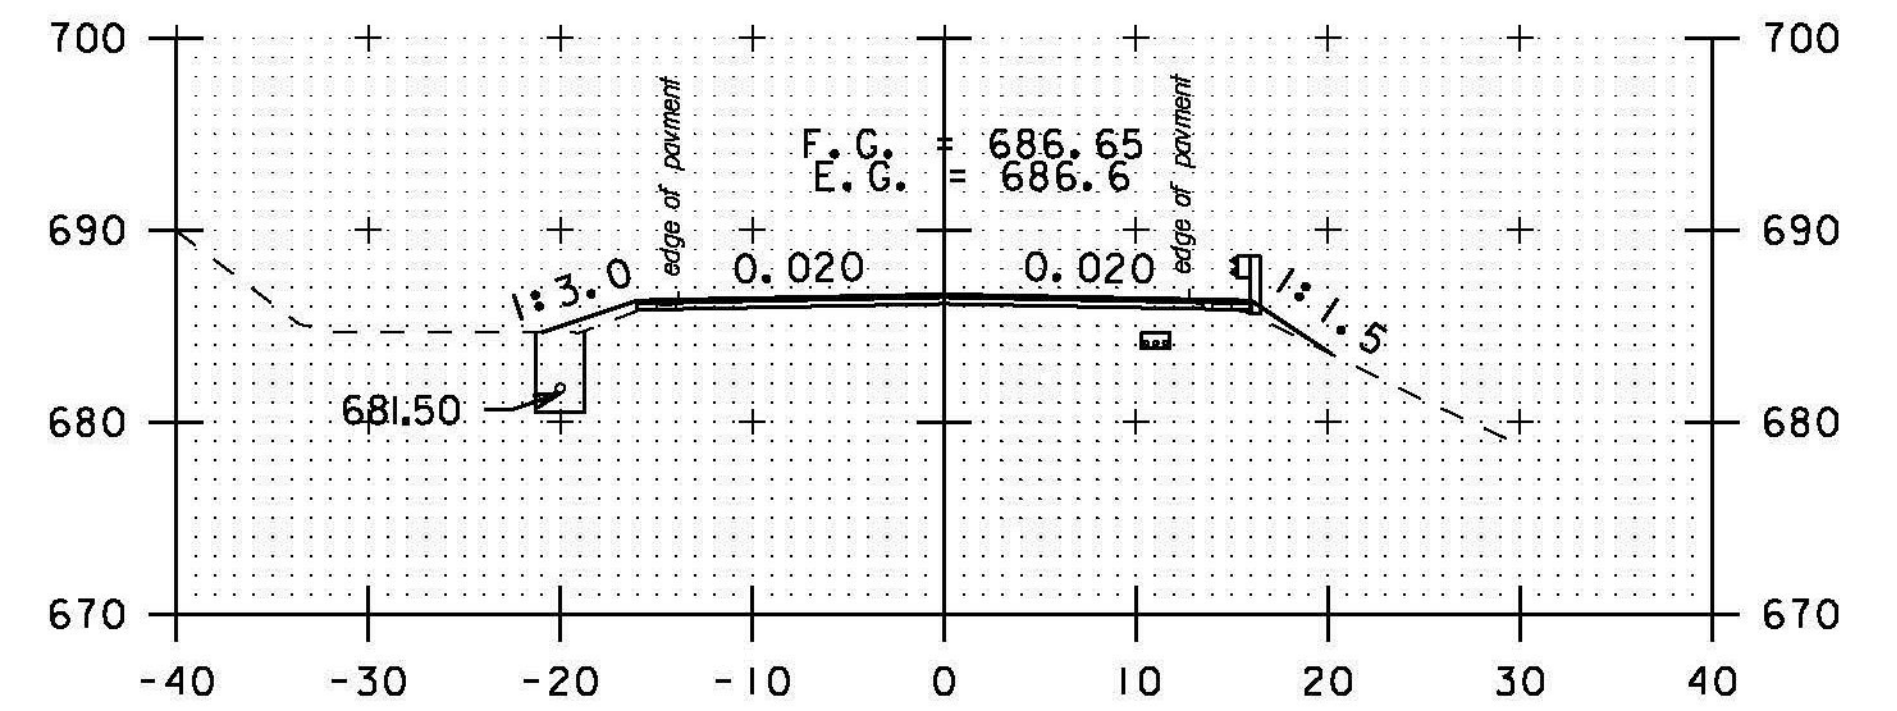


368+00

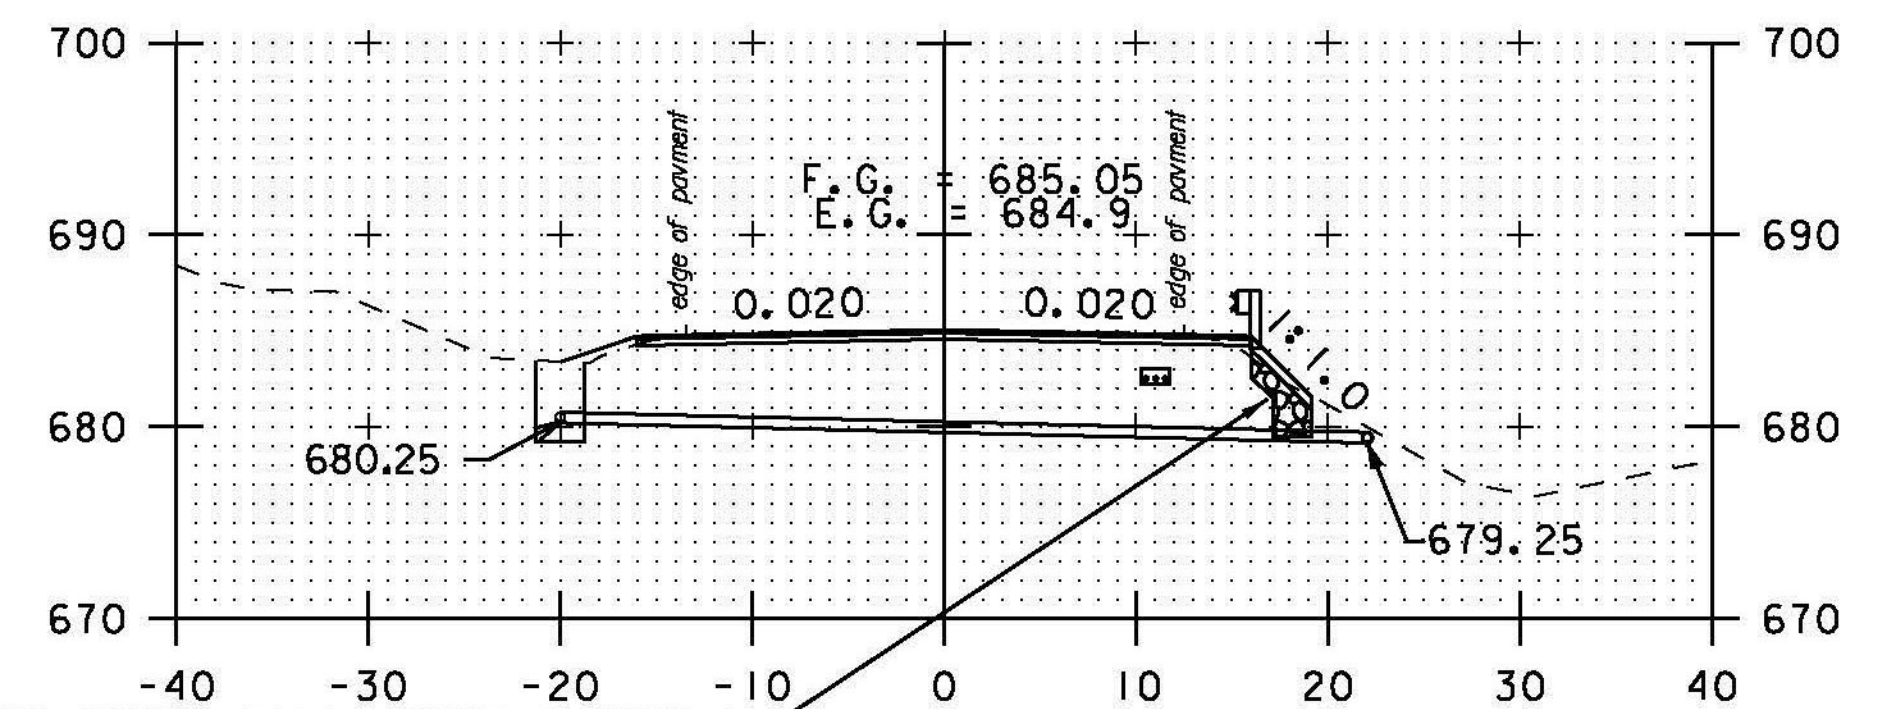

367+50

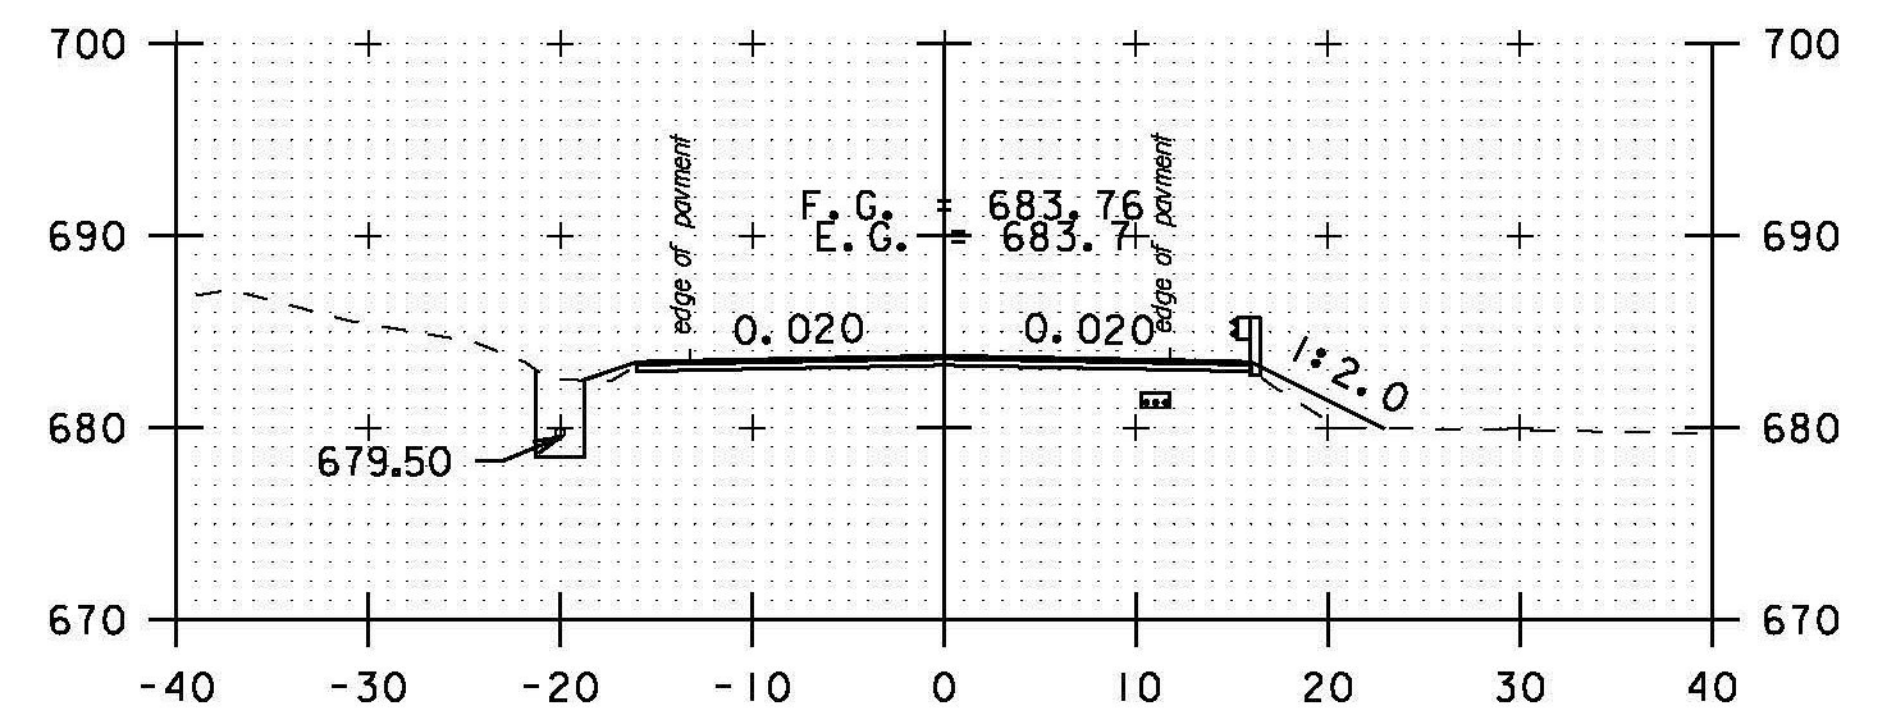

367+00

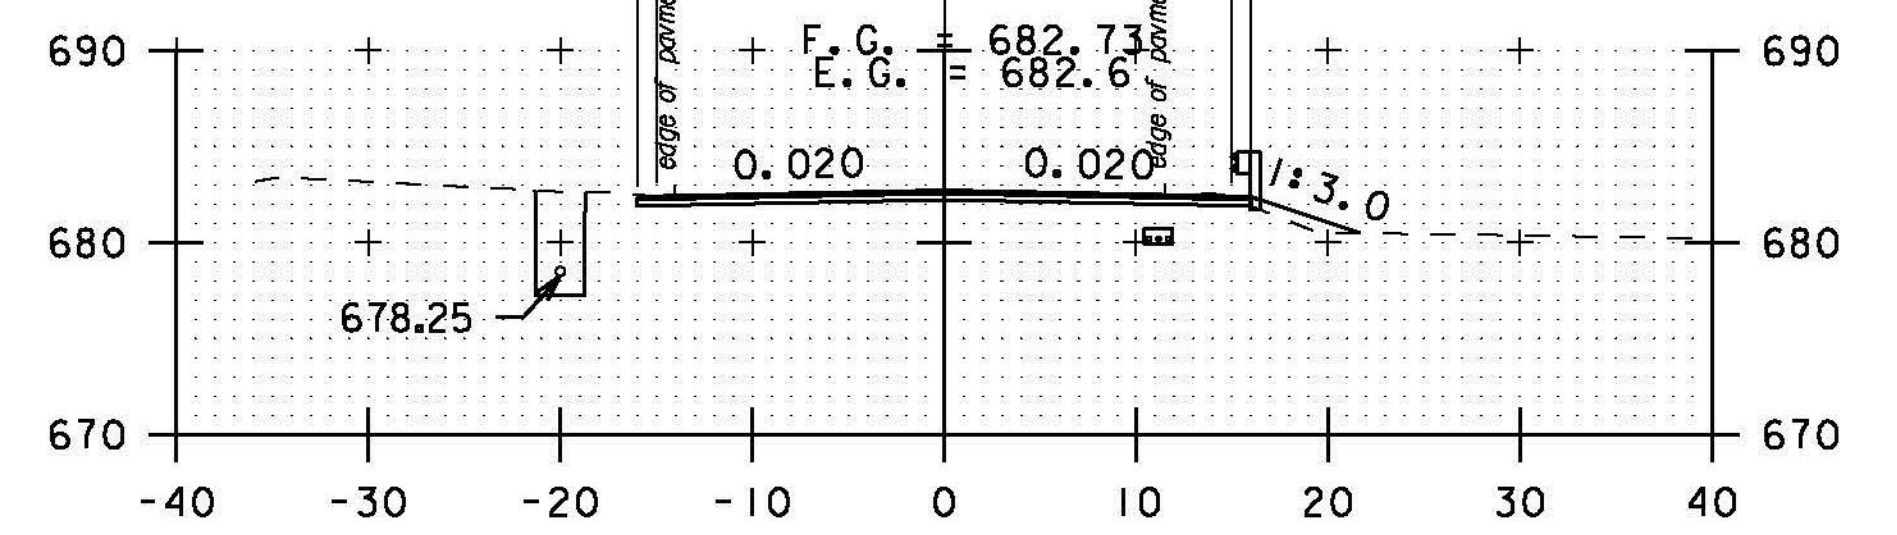


366+50

PROJECT NAME: BETHEL-RANDOLPH
PROJECT NUMBER: STP 292(I)

FILE NAME: piOC244.dgn
PROJECT LEADER: C. LATHROP
DESIGNED BY: S. LAMPHERE
CROSS SECTION SHEET 49

PLOT DATE: 4/23/2015
DRAWN BY: S. LAMPHERE
CHECKED BY: C. LATHROP
SHEET 183 OF 211

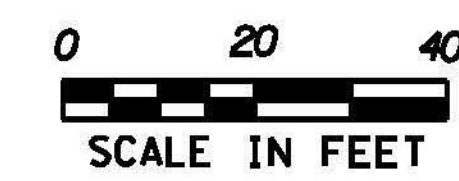

STA. 363+00 TO STA. 368+00