



A 16+50

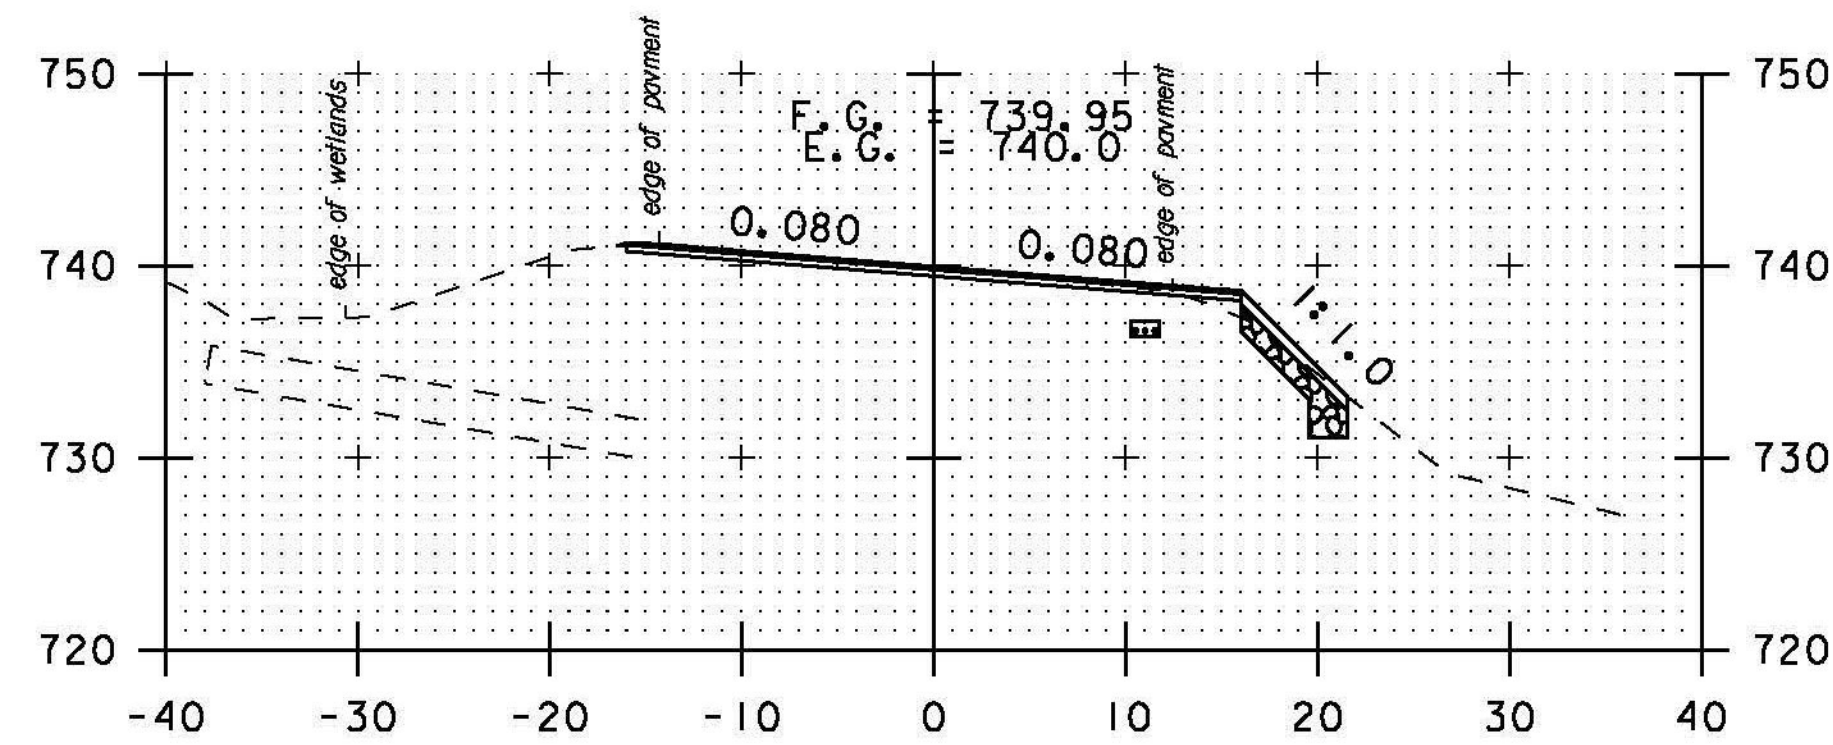


A 16+00

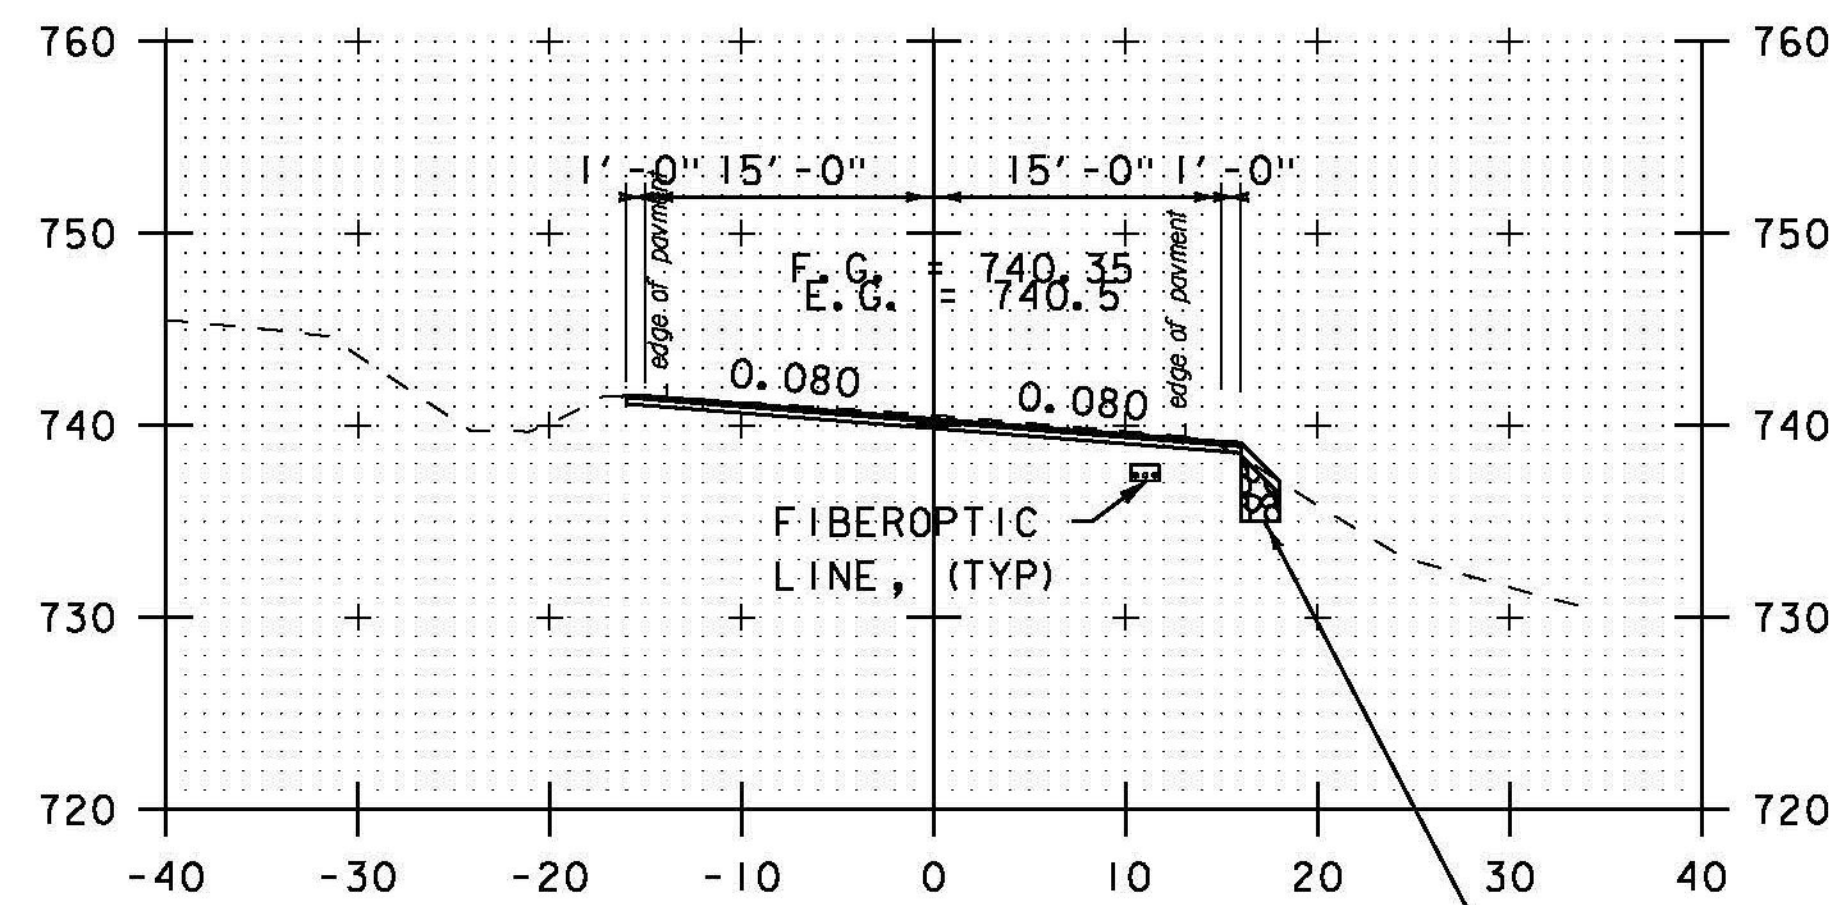


A 15+50


12" STONE FILL, TYPE I (TYP.)  
6" GRUBBING MATERIAL (TYP.)  
GEOTEXTILE UNDER STONE FILL (TYP.)

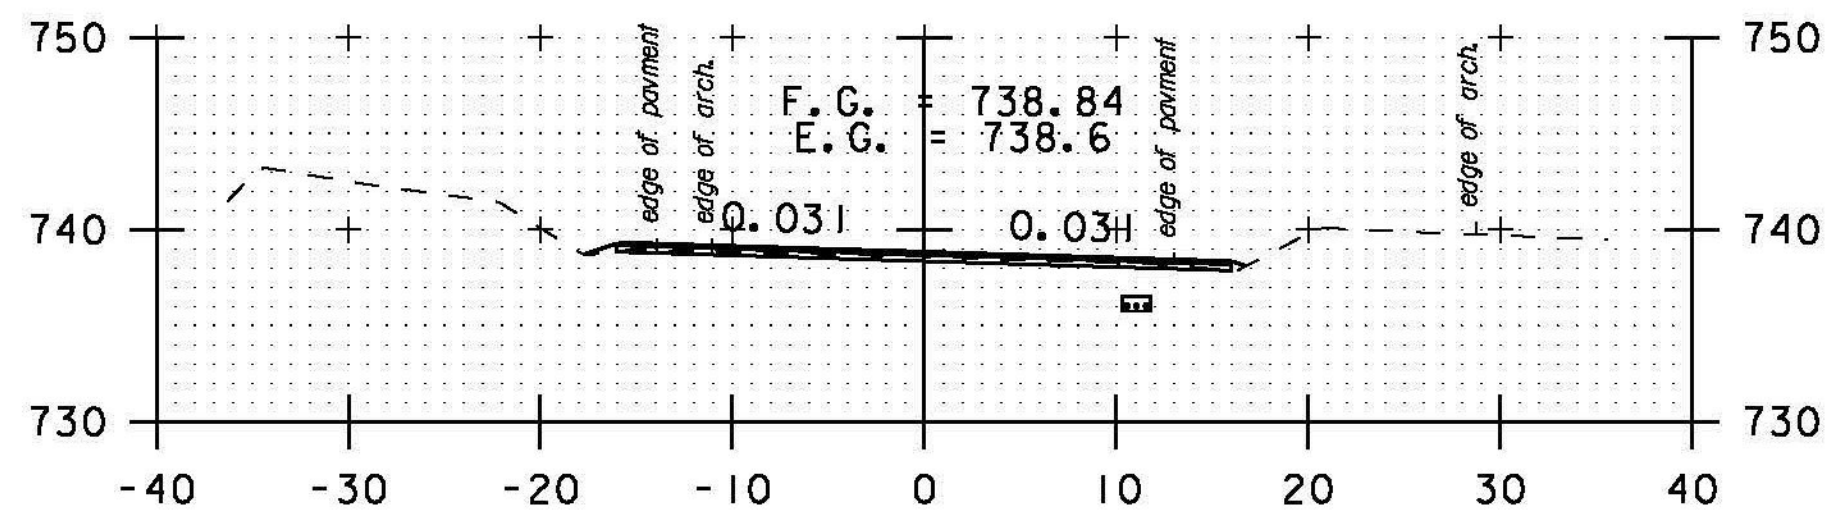


A 18+50

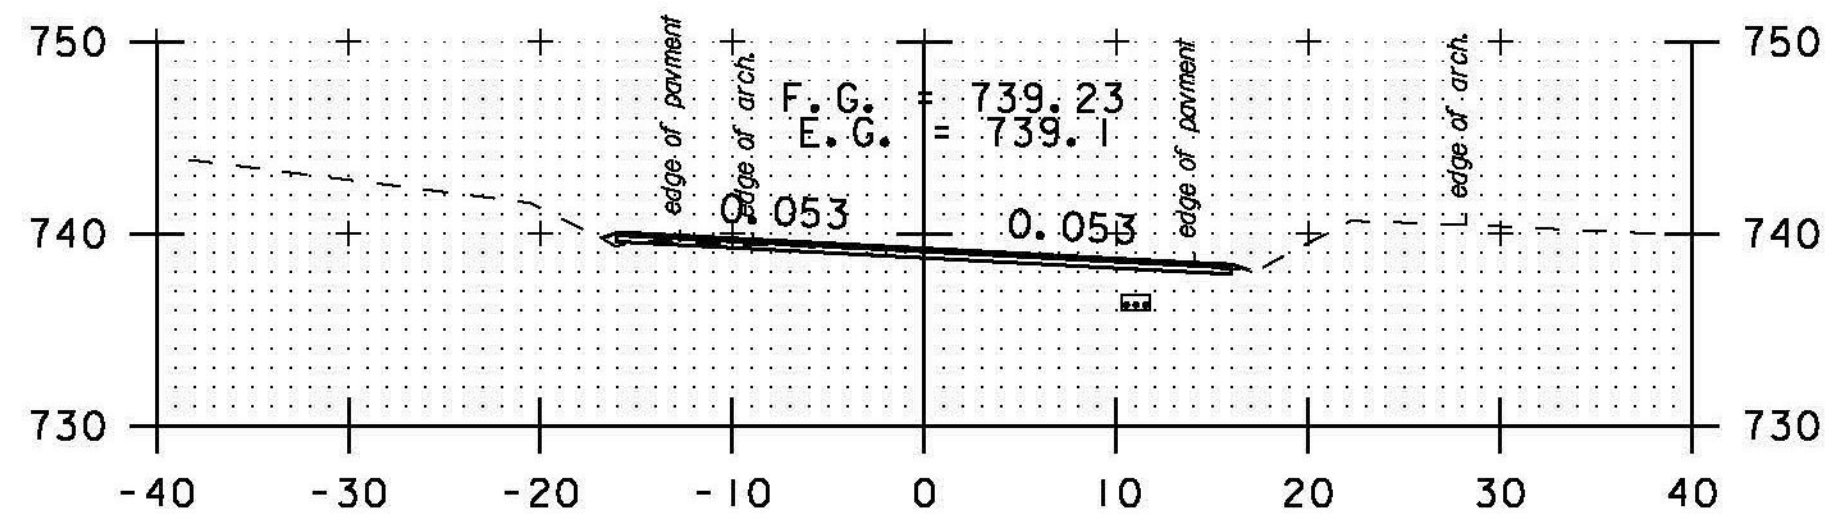


A 18+00

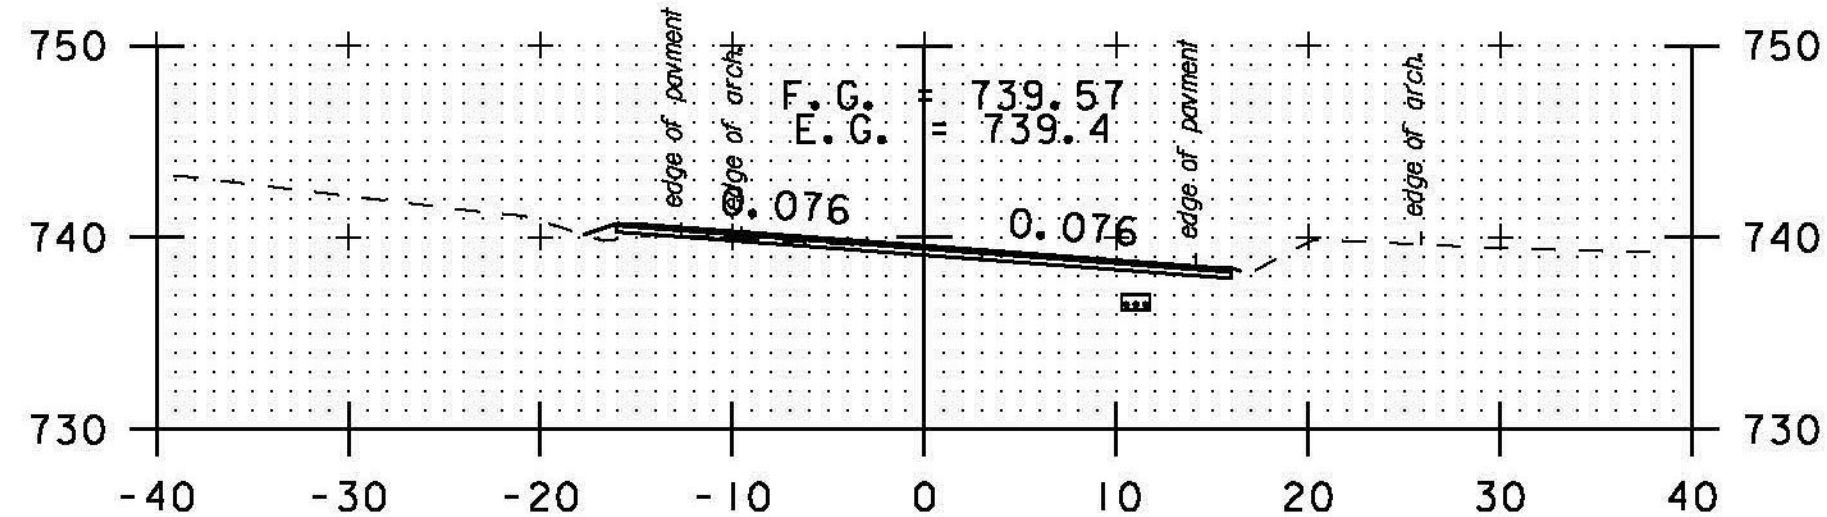


A 17+50

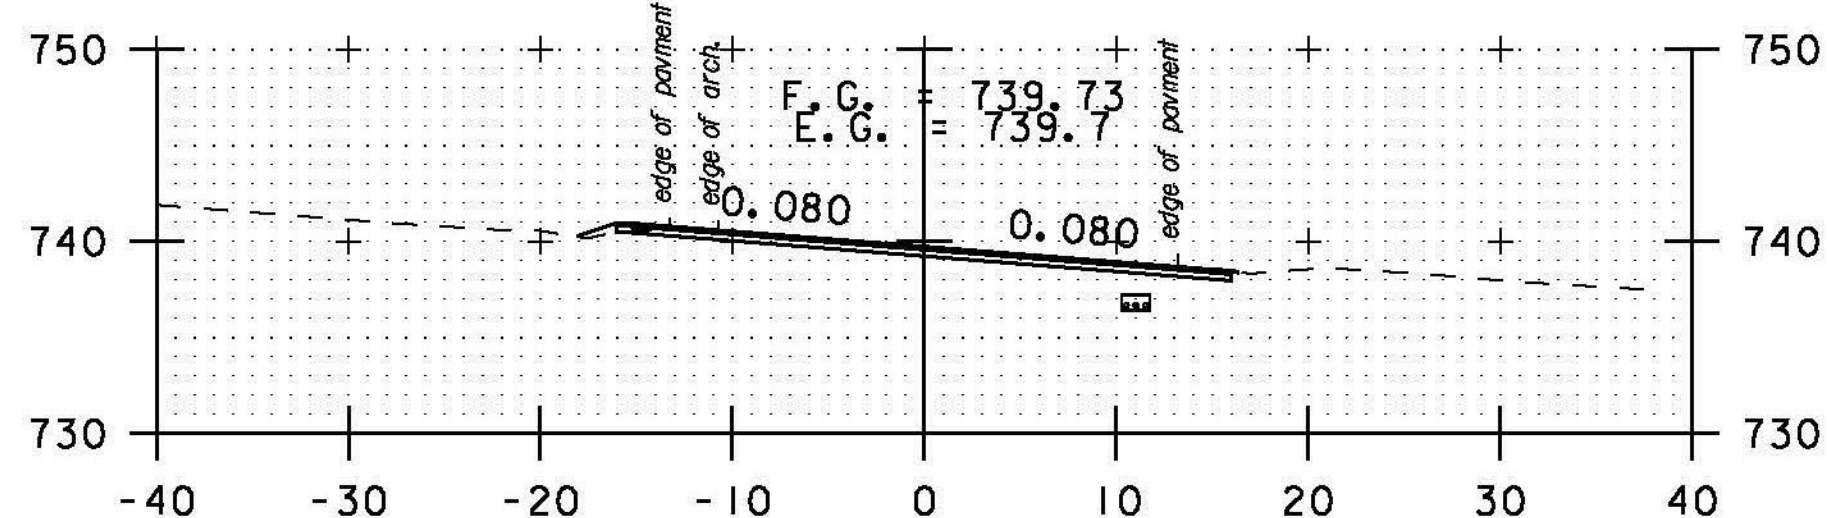


A 17+00

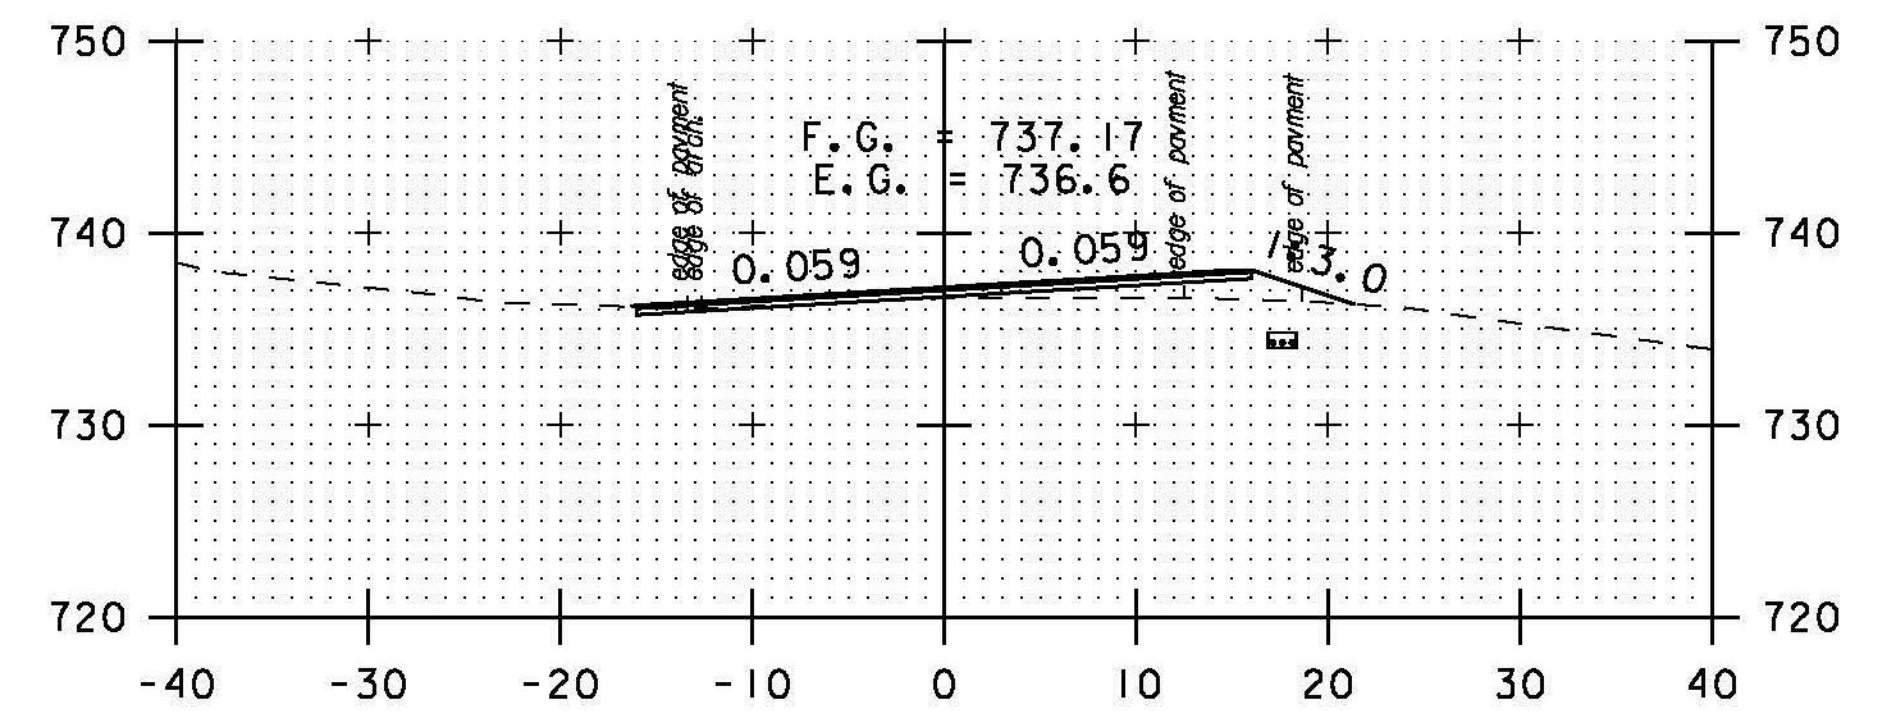


A 20+50

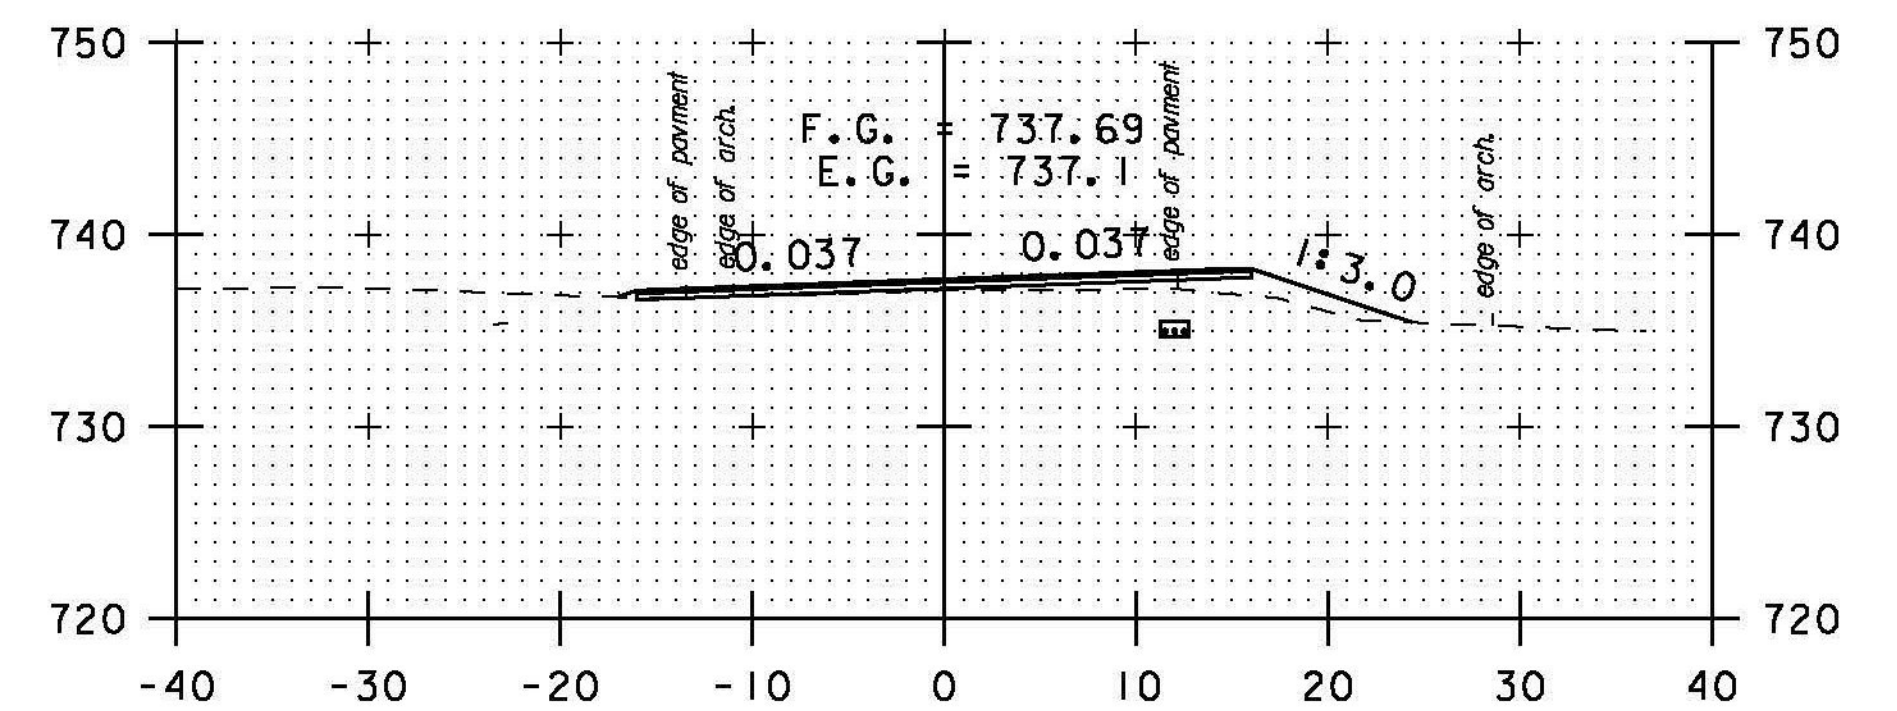

A 20+00

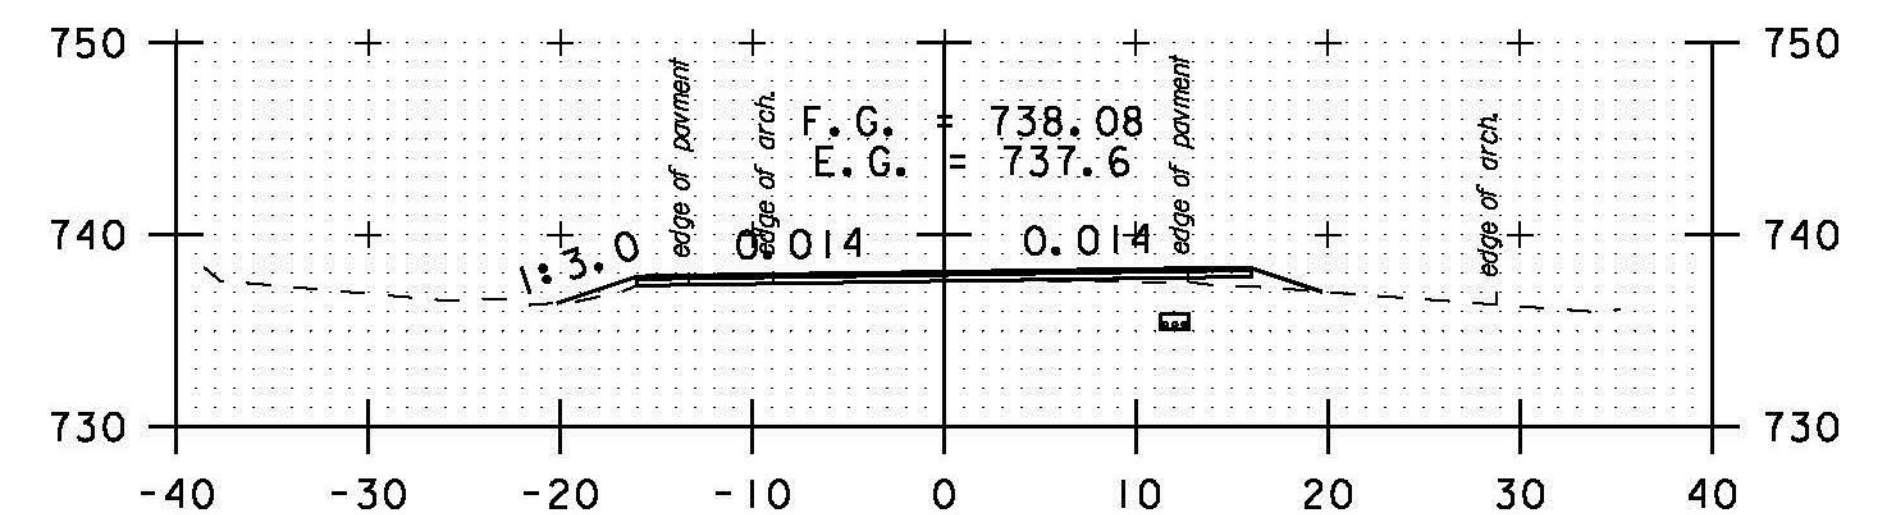


A 19+50

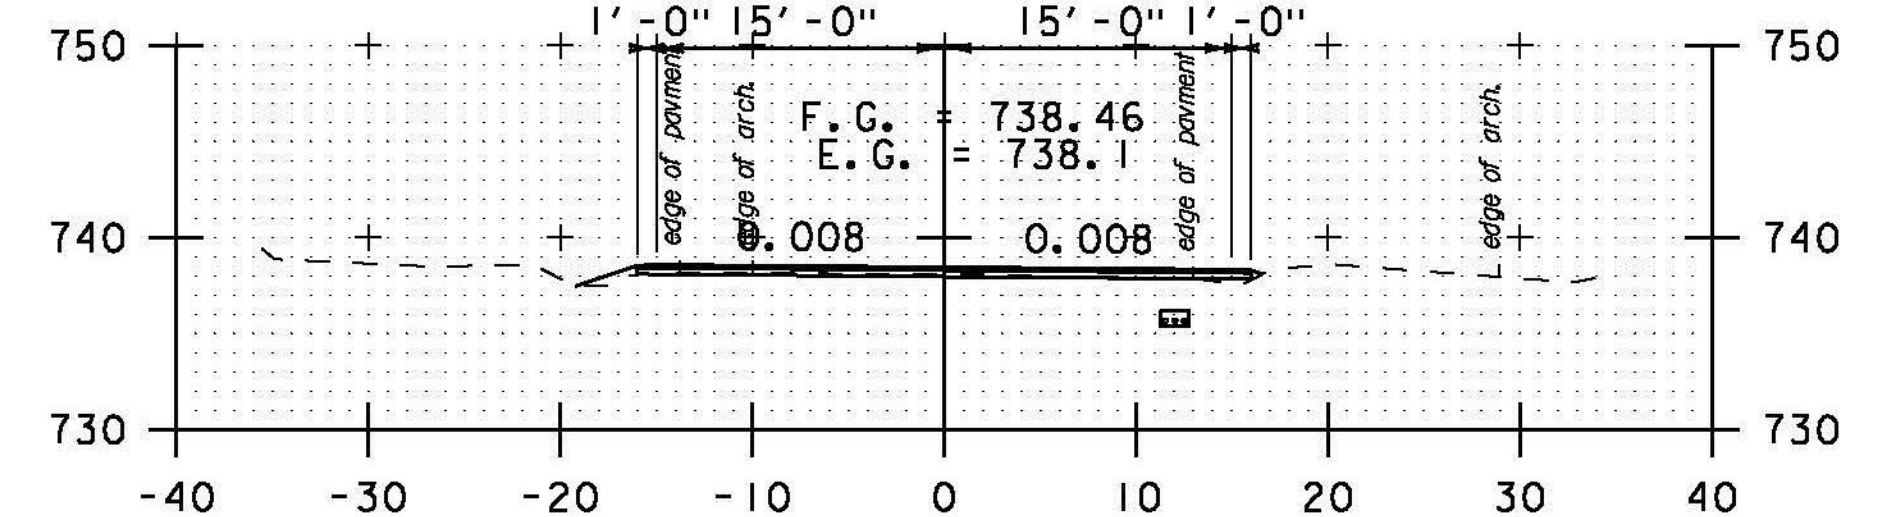

A 19+00

PROJECT NAME: BETHEL-RANDOLPH  
PROJECT NUMBER: STP 292(I)  
FILE NAME: piOC244.dgn  
PROJECT LEADER: C. LATHROP  
DESIGNED BY: S. LAMPHERE  
CROSS SECTION SHEET 54  
PLOT DATE: 4/23/2015  
DRAWN BY: S. LAMPHERE  
CHECKED BY: C. LATHROP  
SHEET 188 OF 211

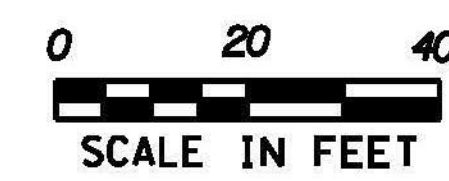

STA. A 15+50 TO STA. A 20+50