




A 28+50

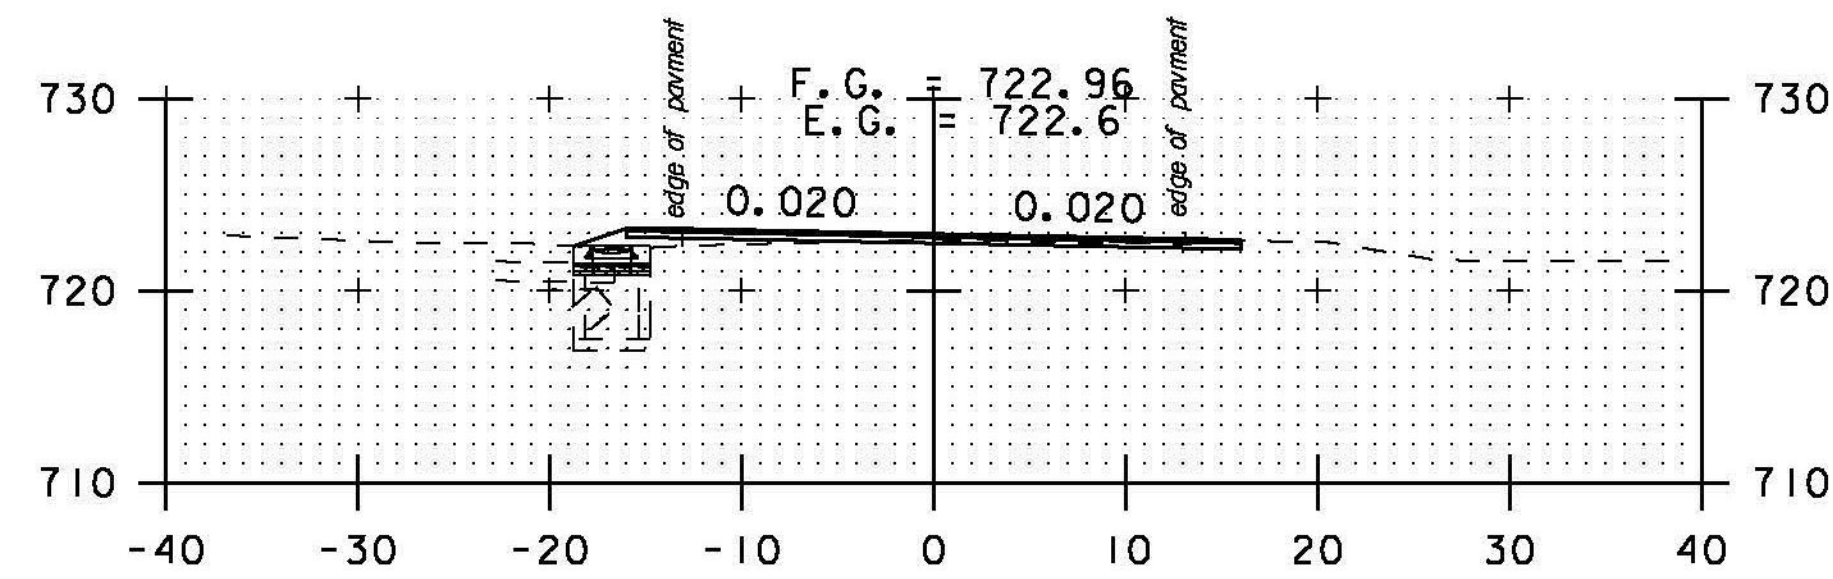


A 28+00

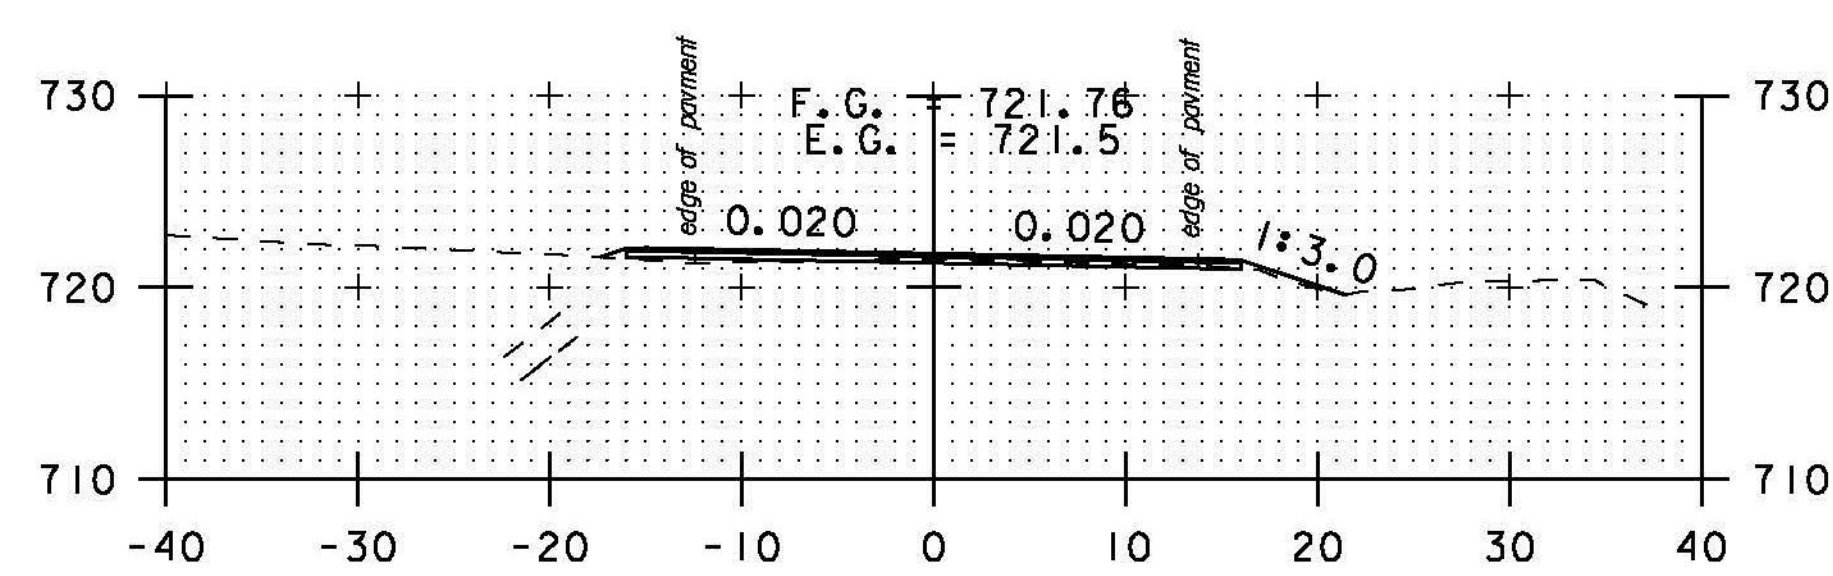


A 27+50

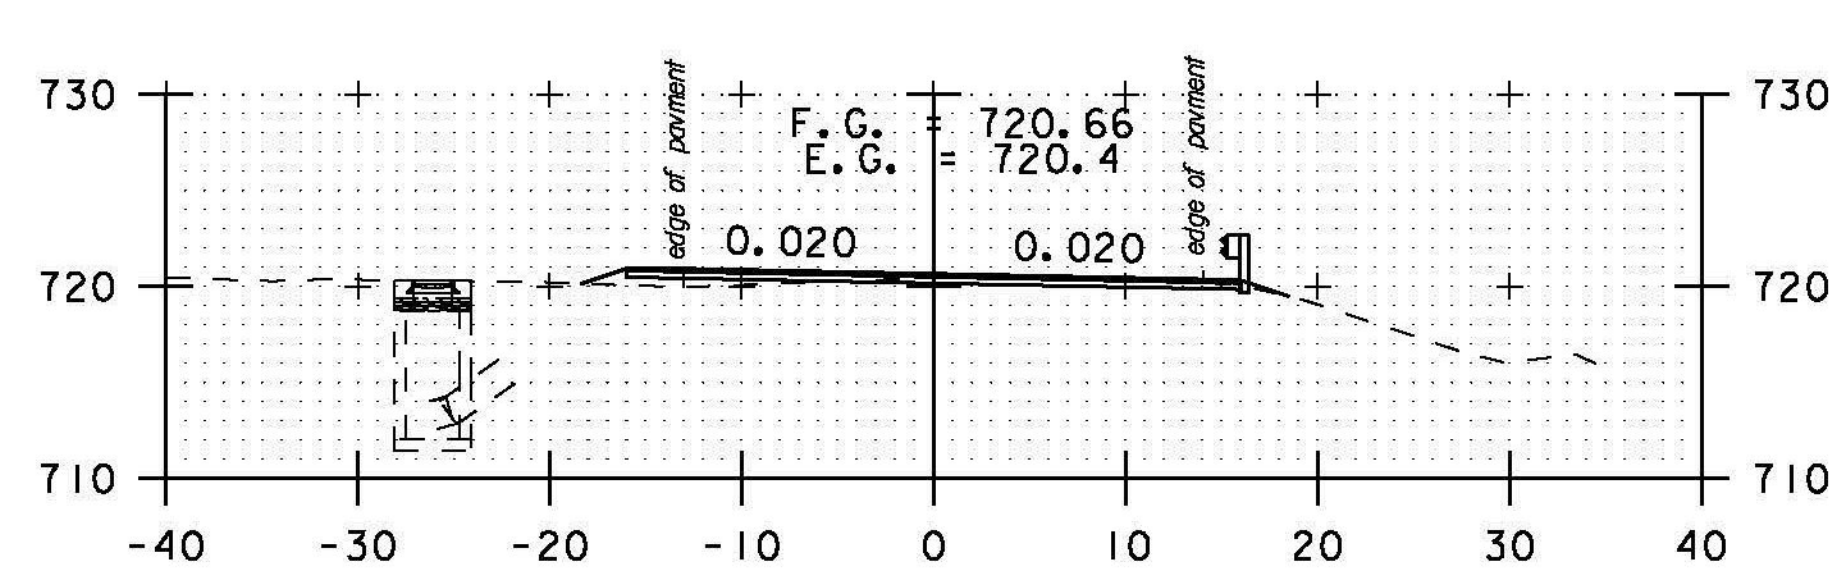


A 27+00

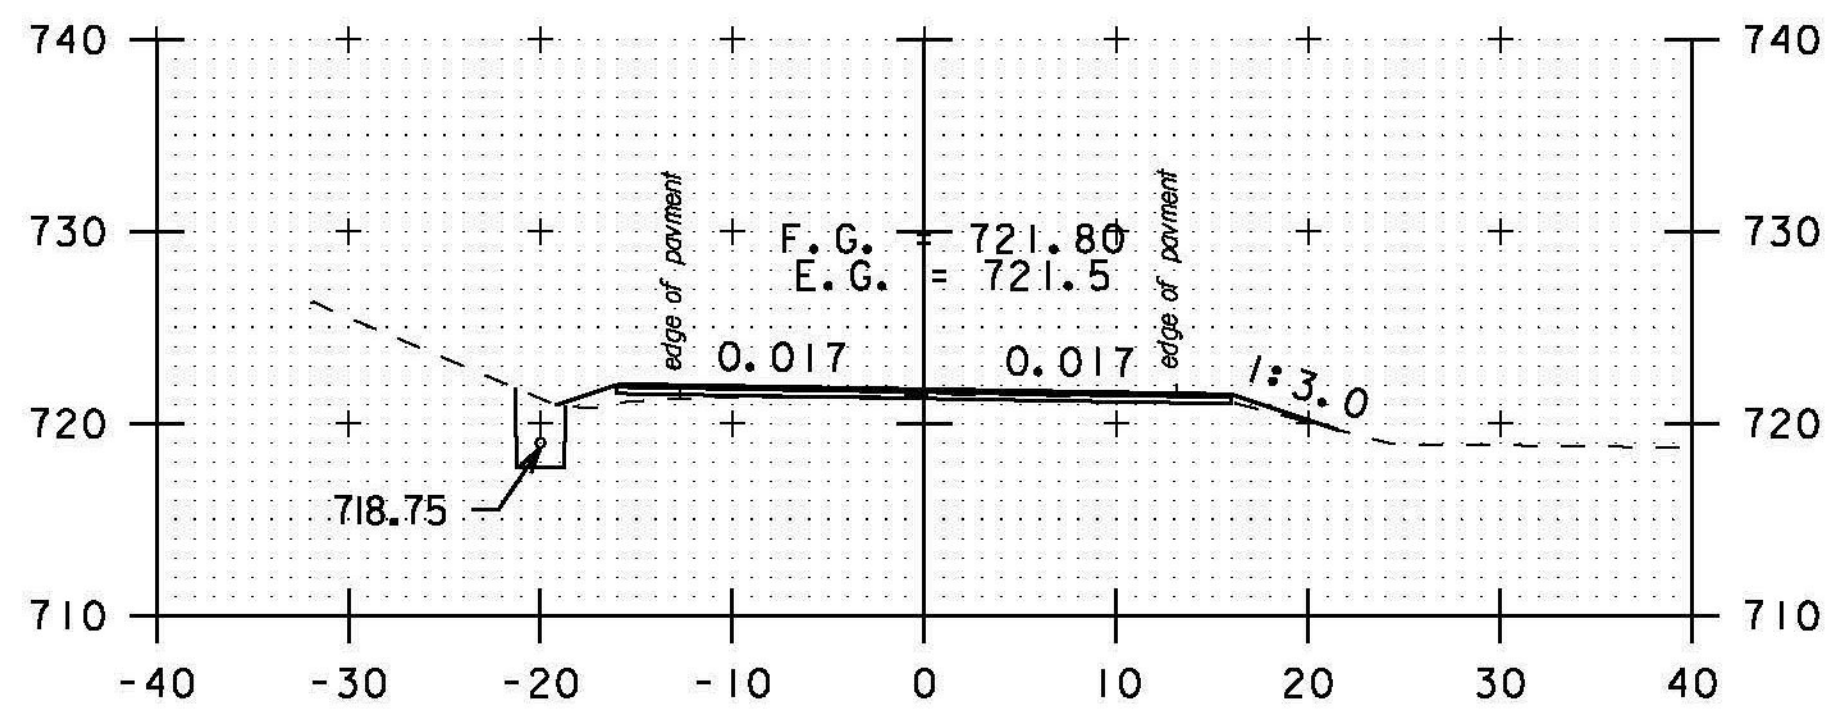


A 30+50

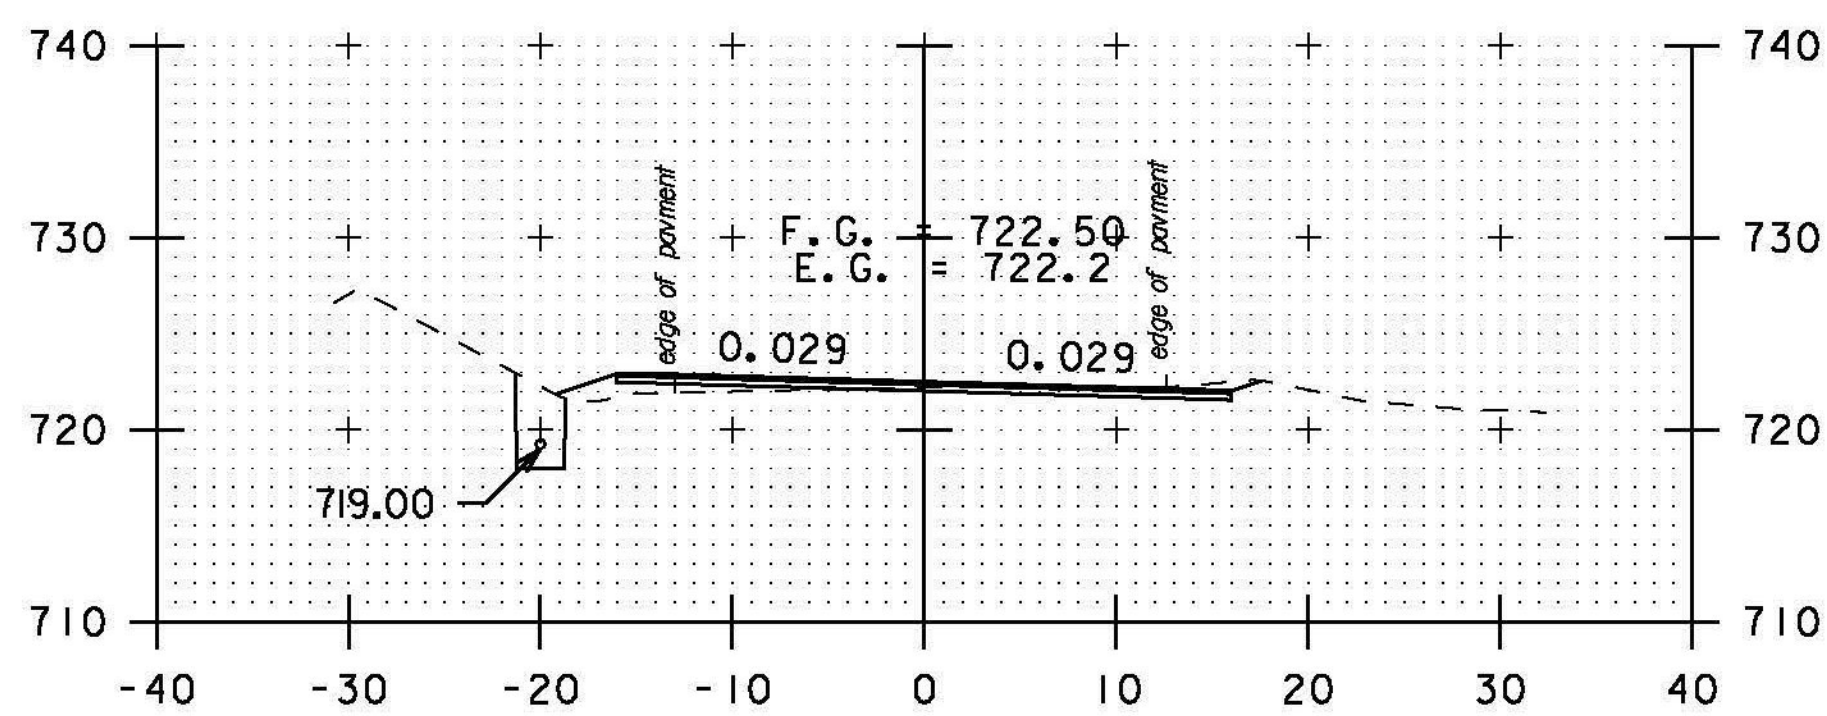


A 30+00

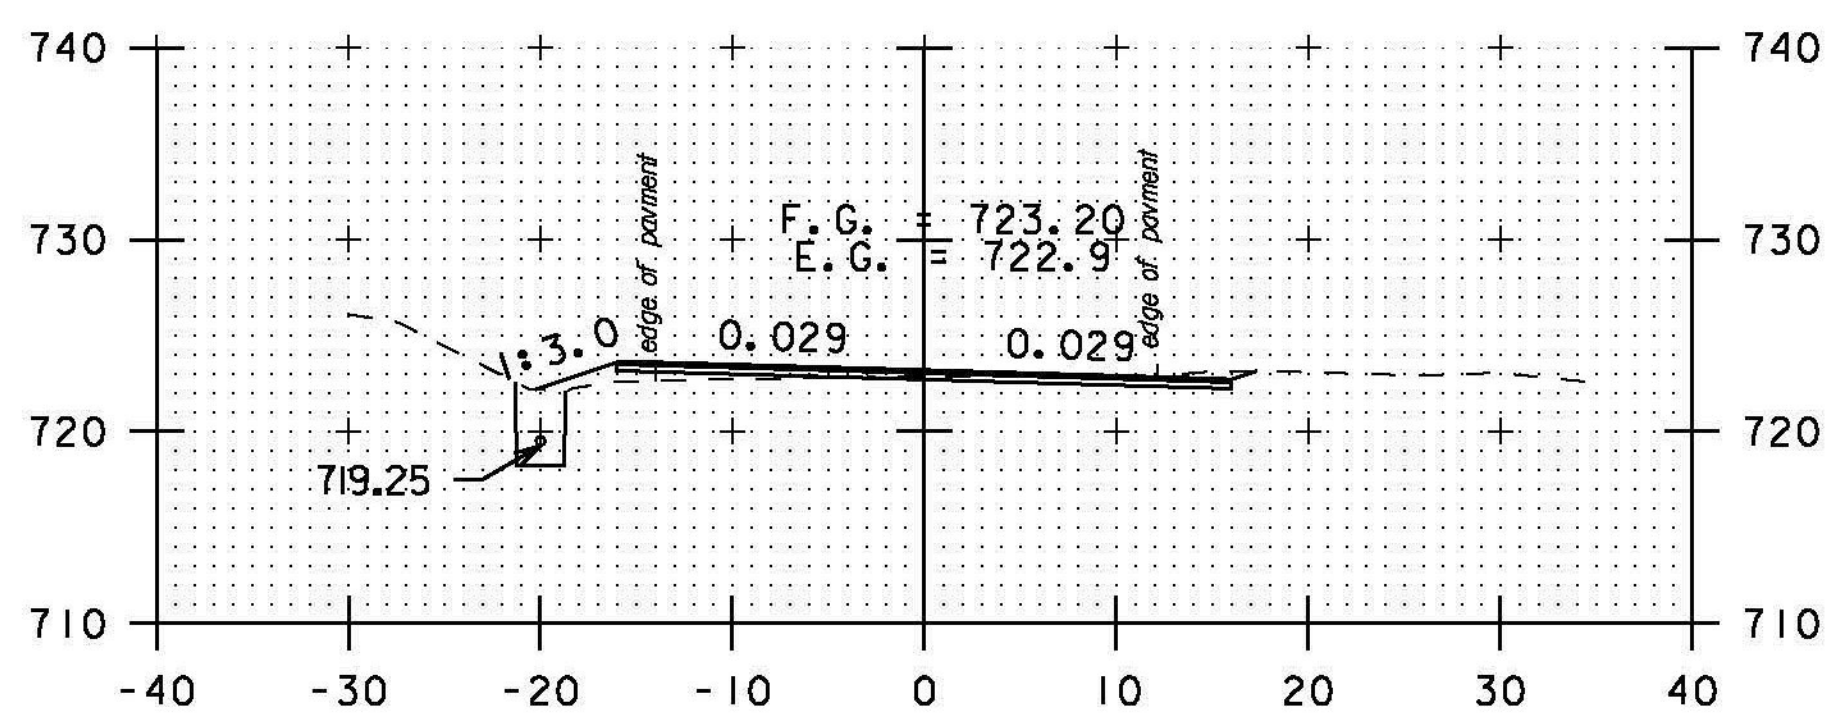


A 29+50

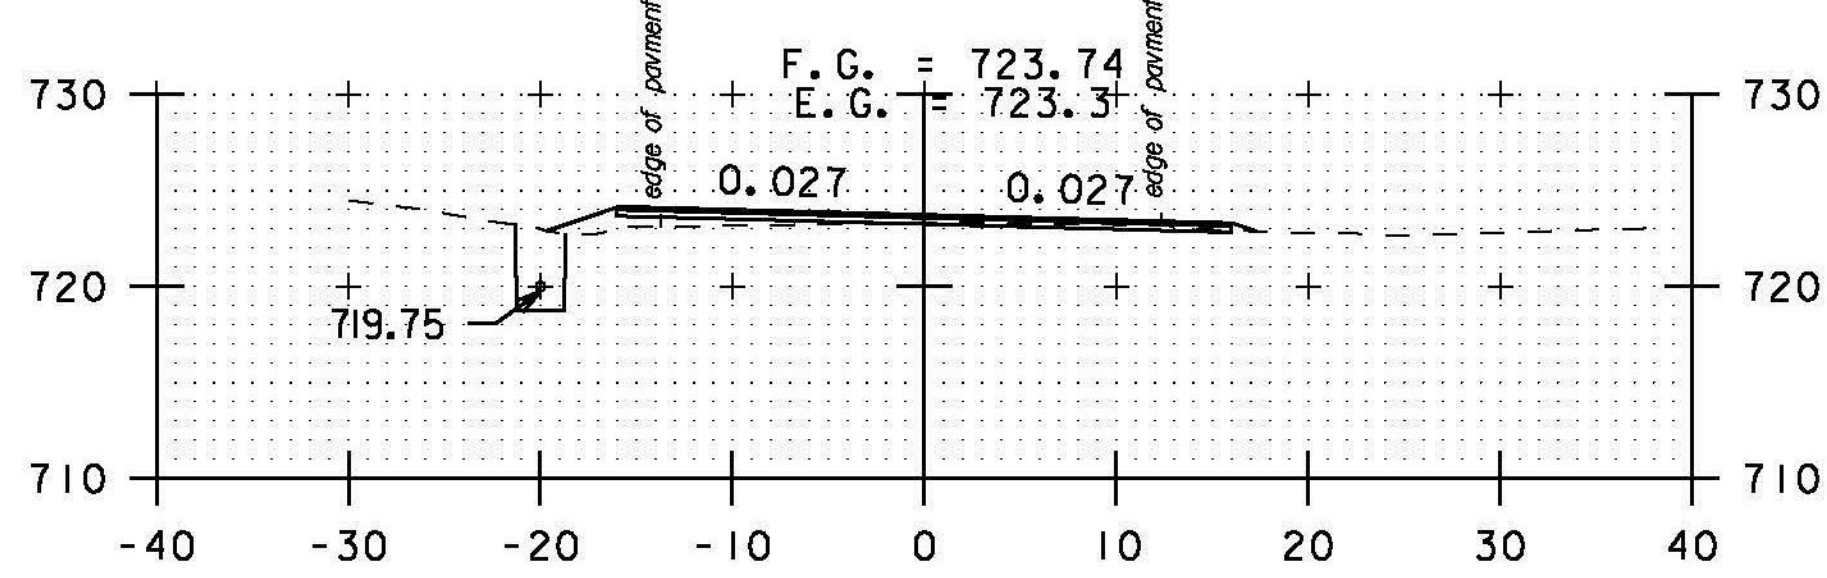


A 29+00

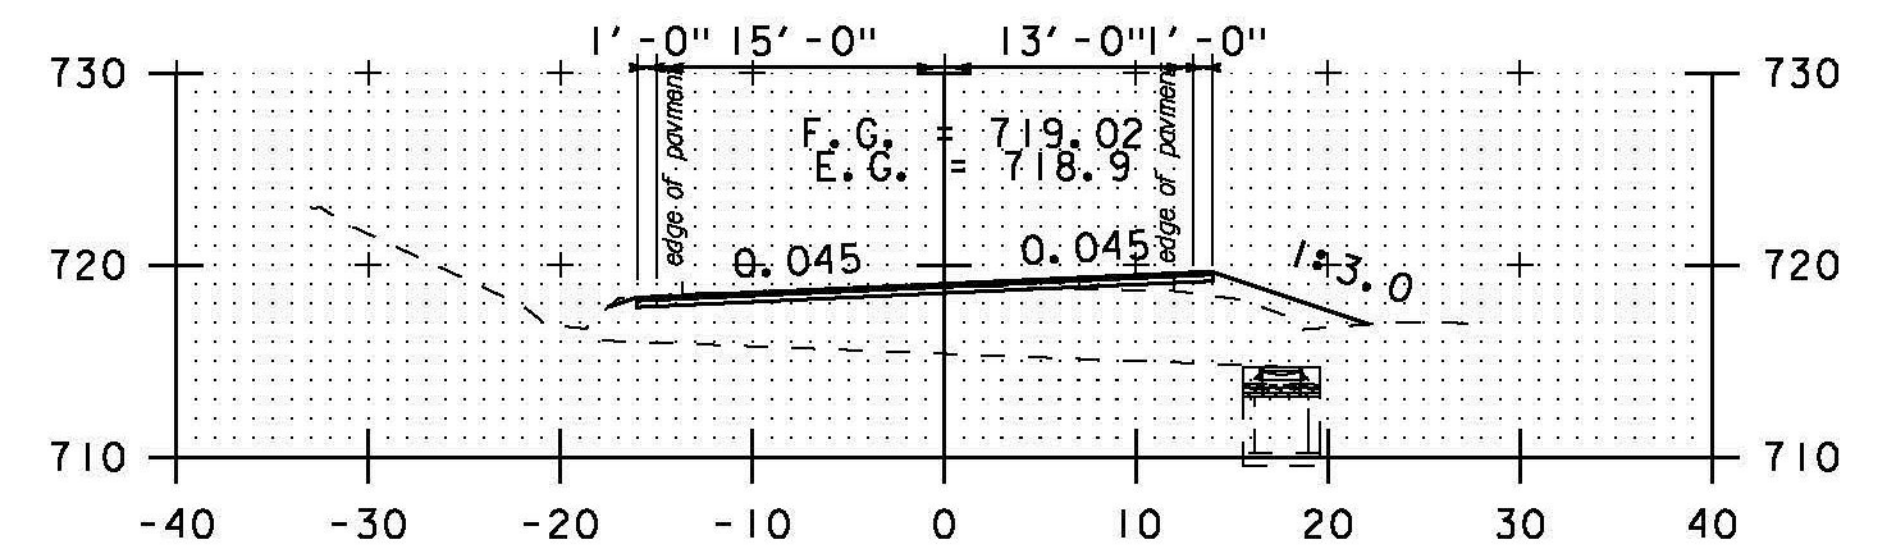


A 32+50

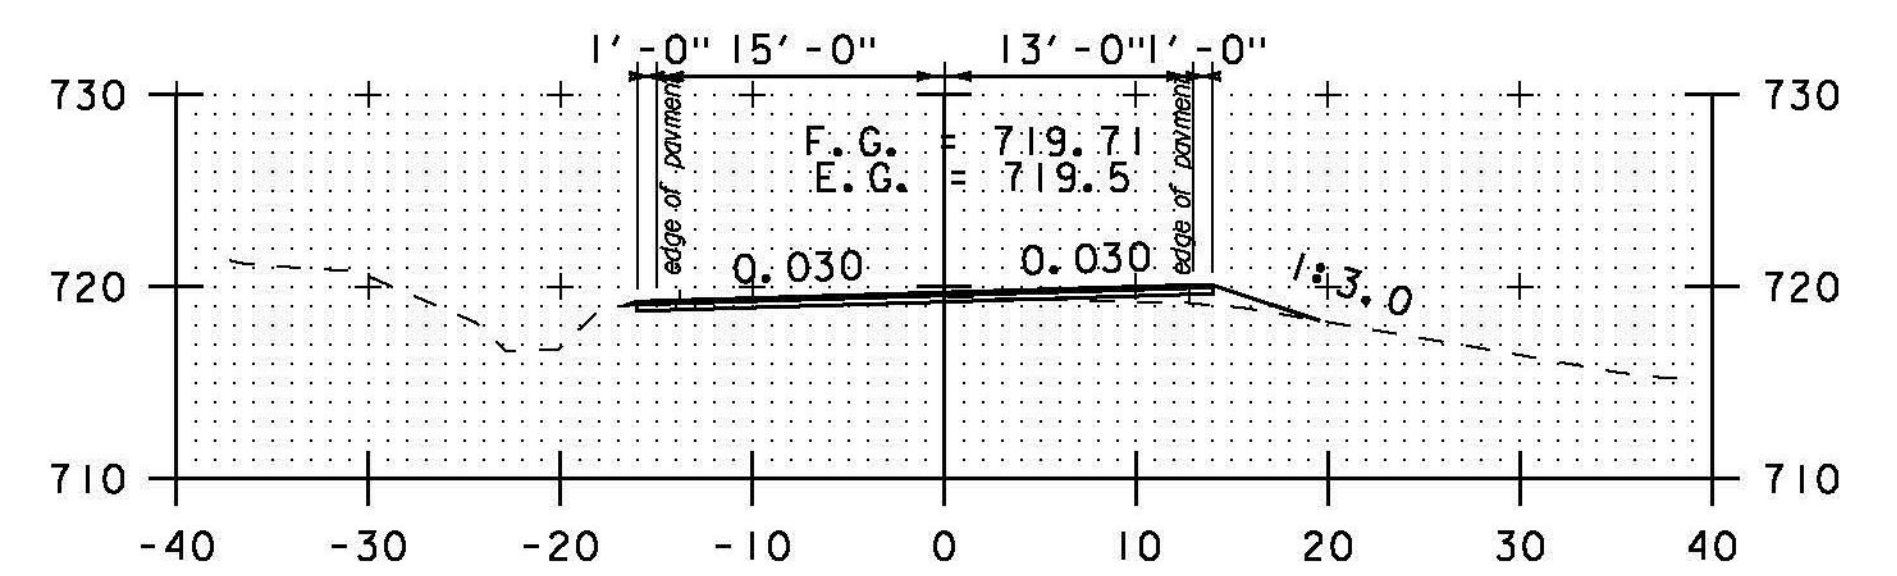

A 32+00

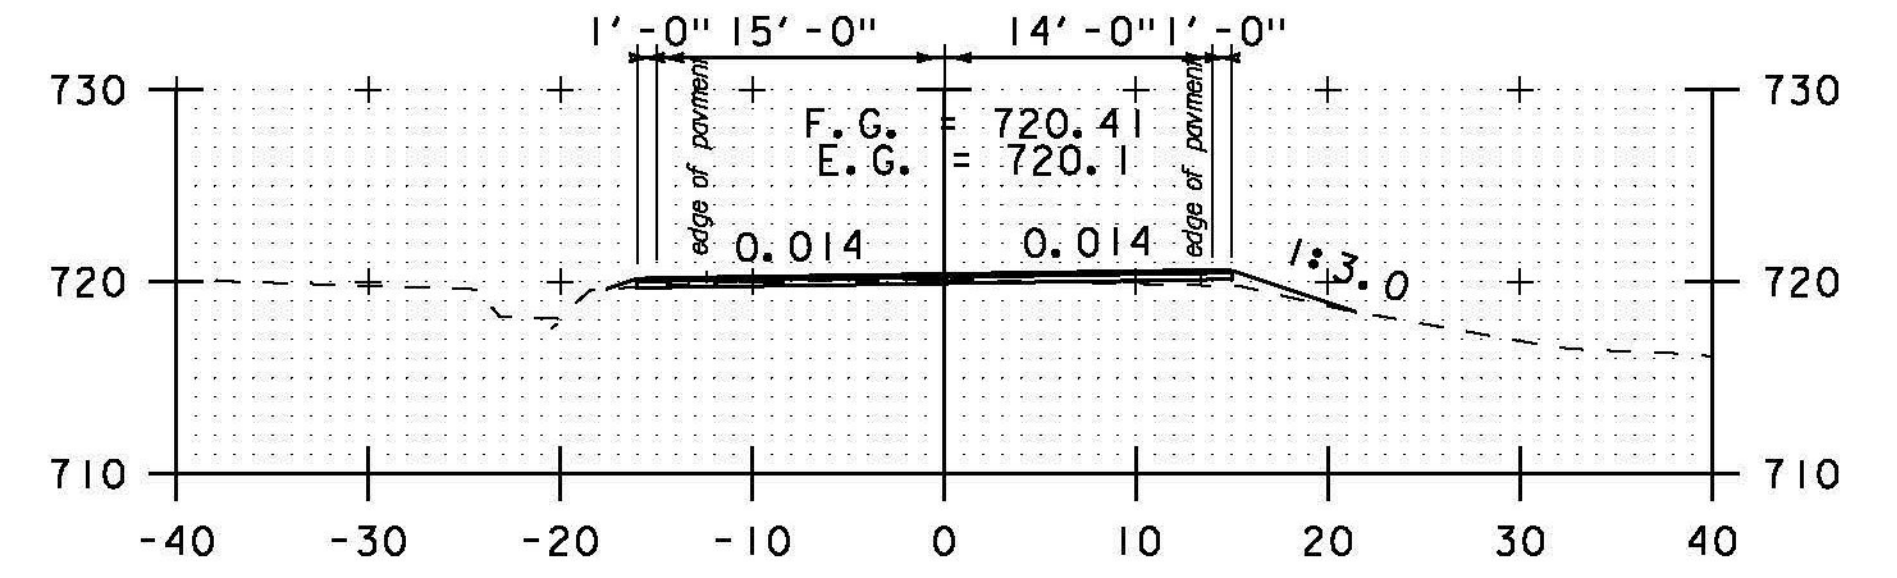

A 31+50

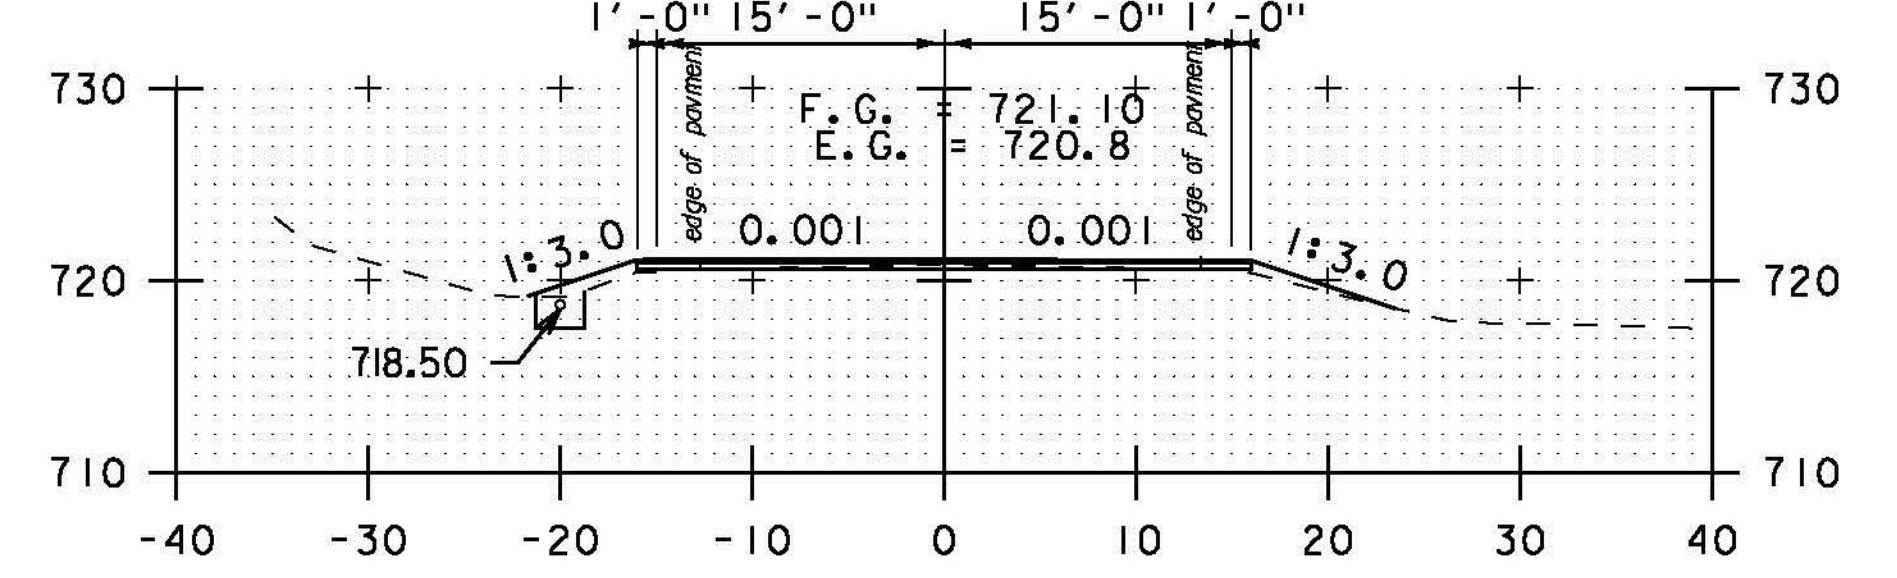


A 31+00

DRIVE RT

TH#79 LT

DRIVE RT

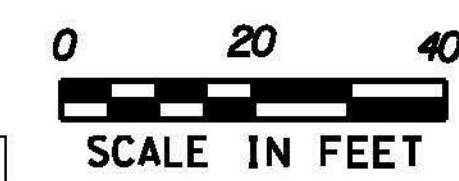

STA. A 27+00 TO STA. A 32+50

SCALE IN FEET

PROJECT NAME: BETHEL-RANDOLPH  
PROJECT NUMBER: STP 292(I)

FILE NAME: piOC244.dgn  
PROJECT LEADER: C. LATHROP  
DESIGNED BY: S. LAMPHERE  
CROSS SECTION SHEET 56

PLOT DATE: 4/23/2015  
DRAWN BY: S. LAMPHERE  
CHECKED BY: C. LATHROP  
SHEET 190 OF 211