




A 43+50

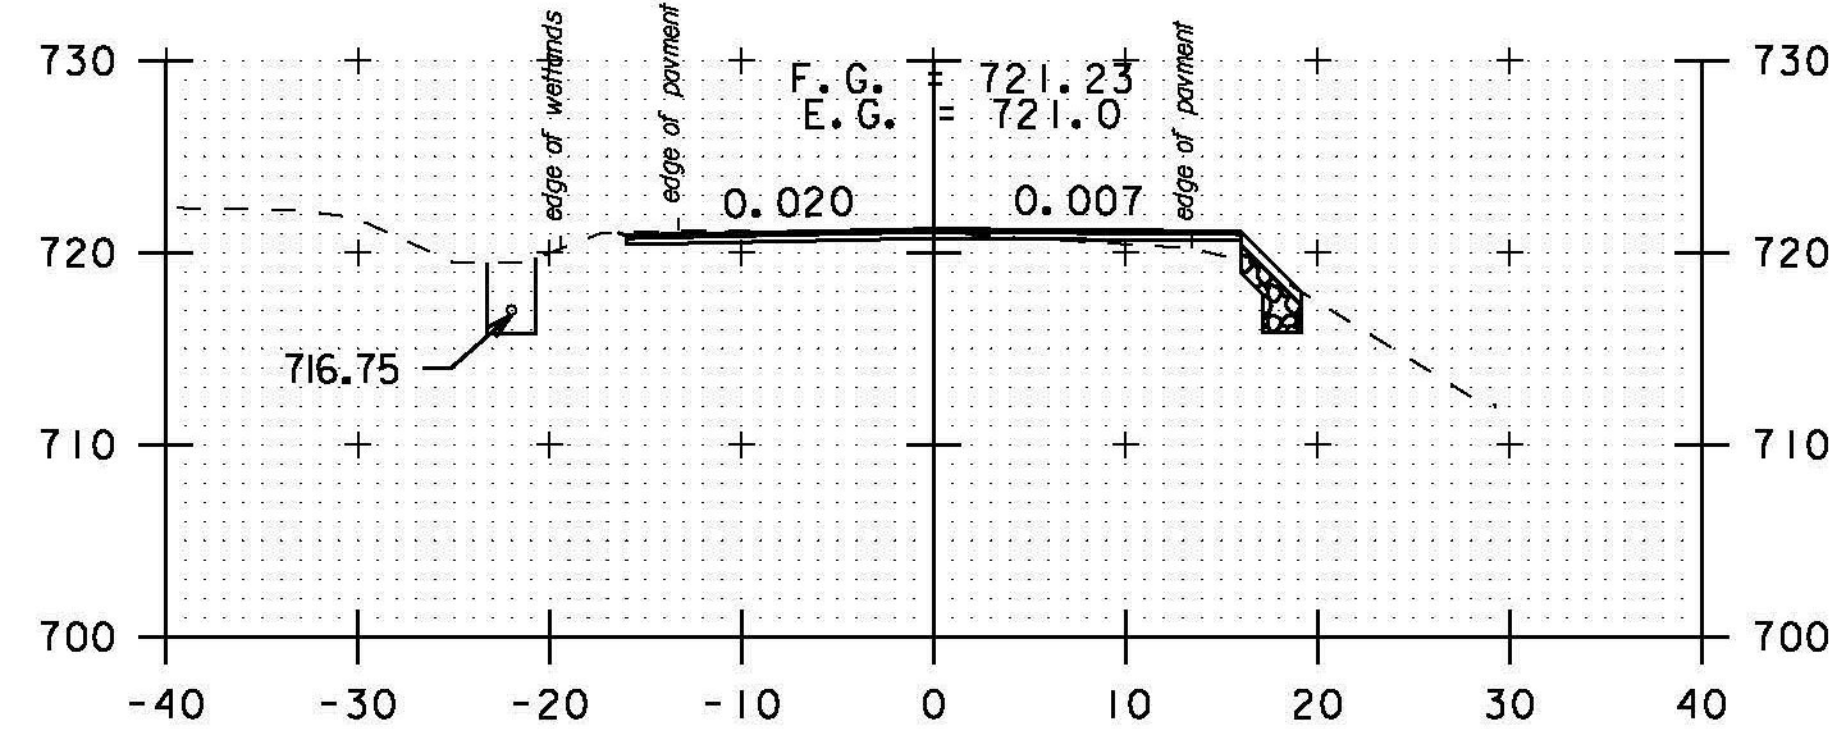


A 43+00

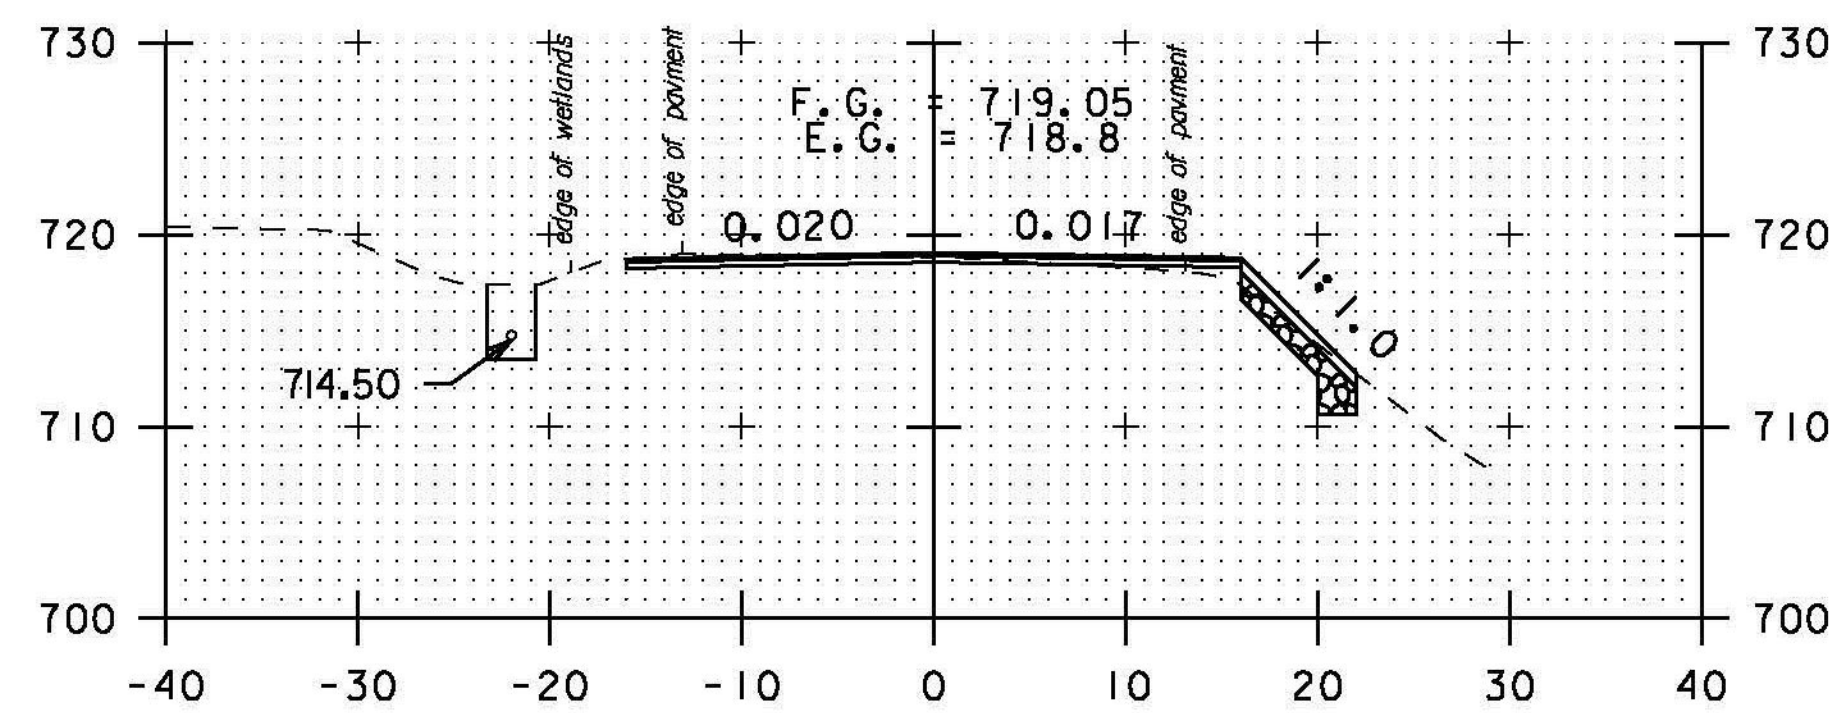


A 42+50

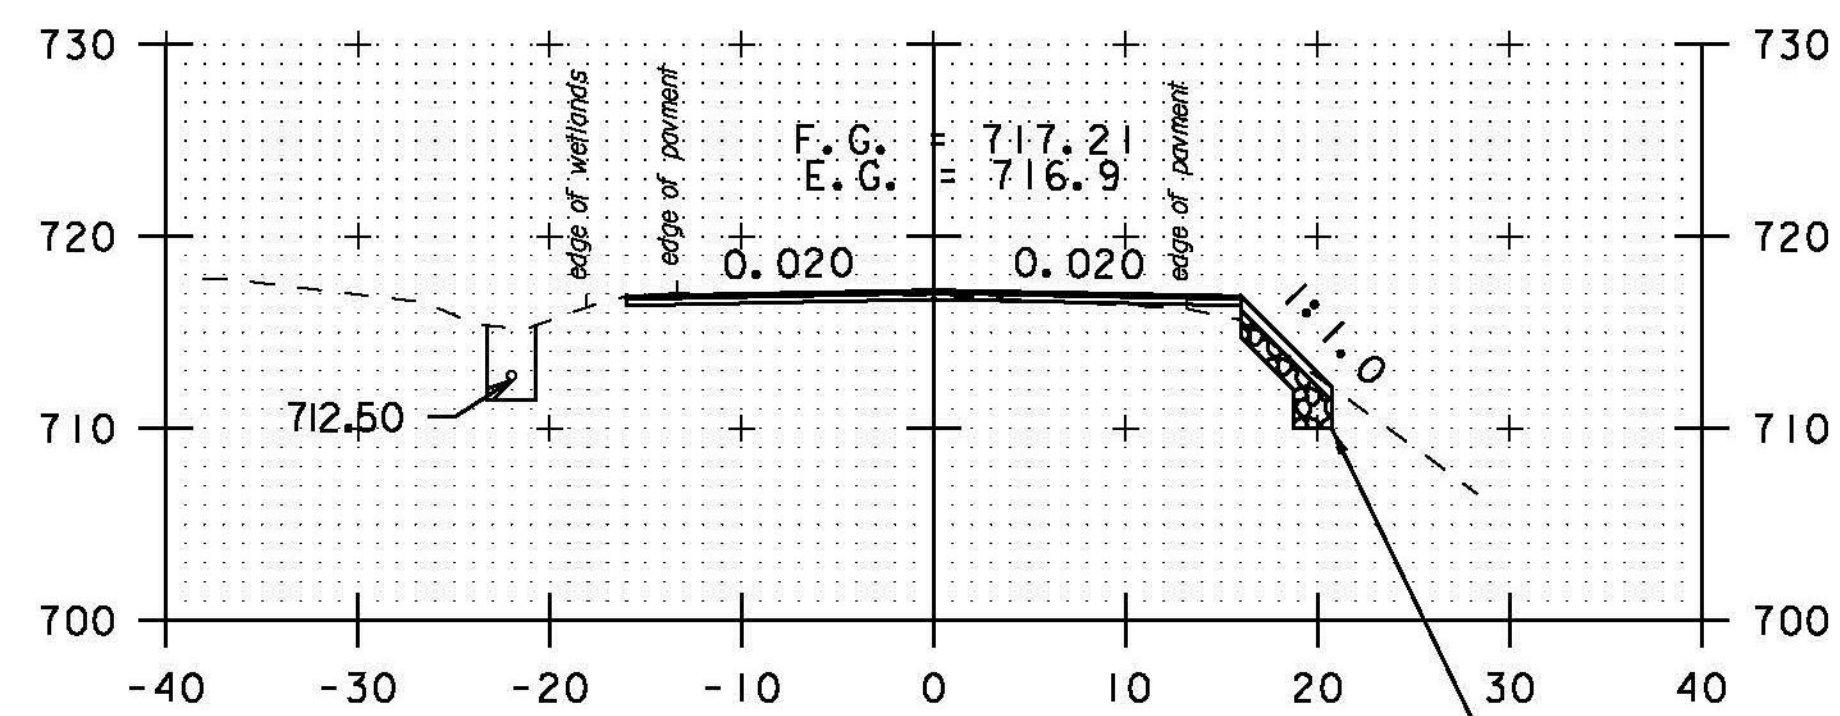


A 42+00

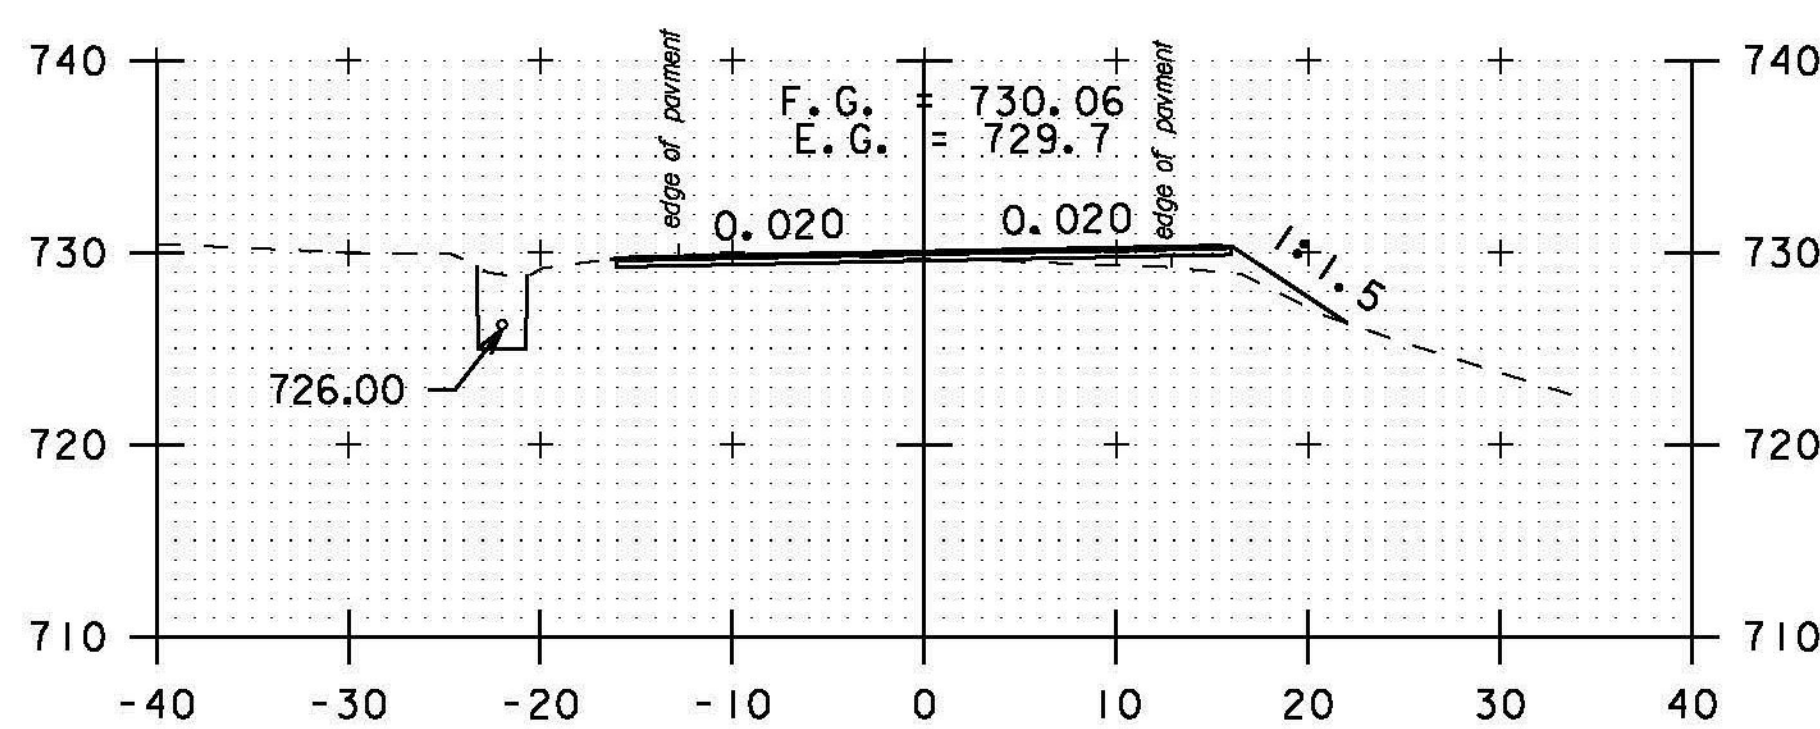


A 45+00

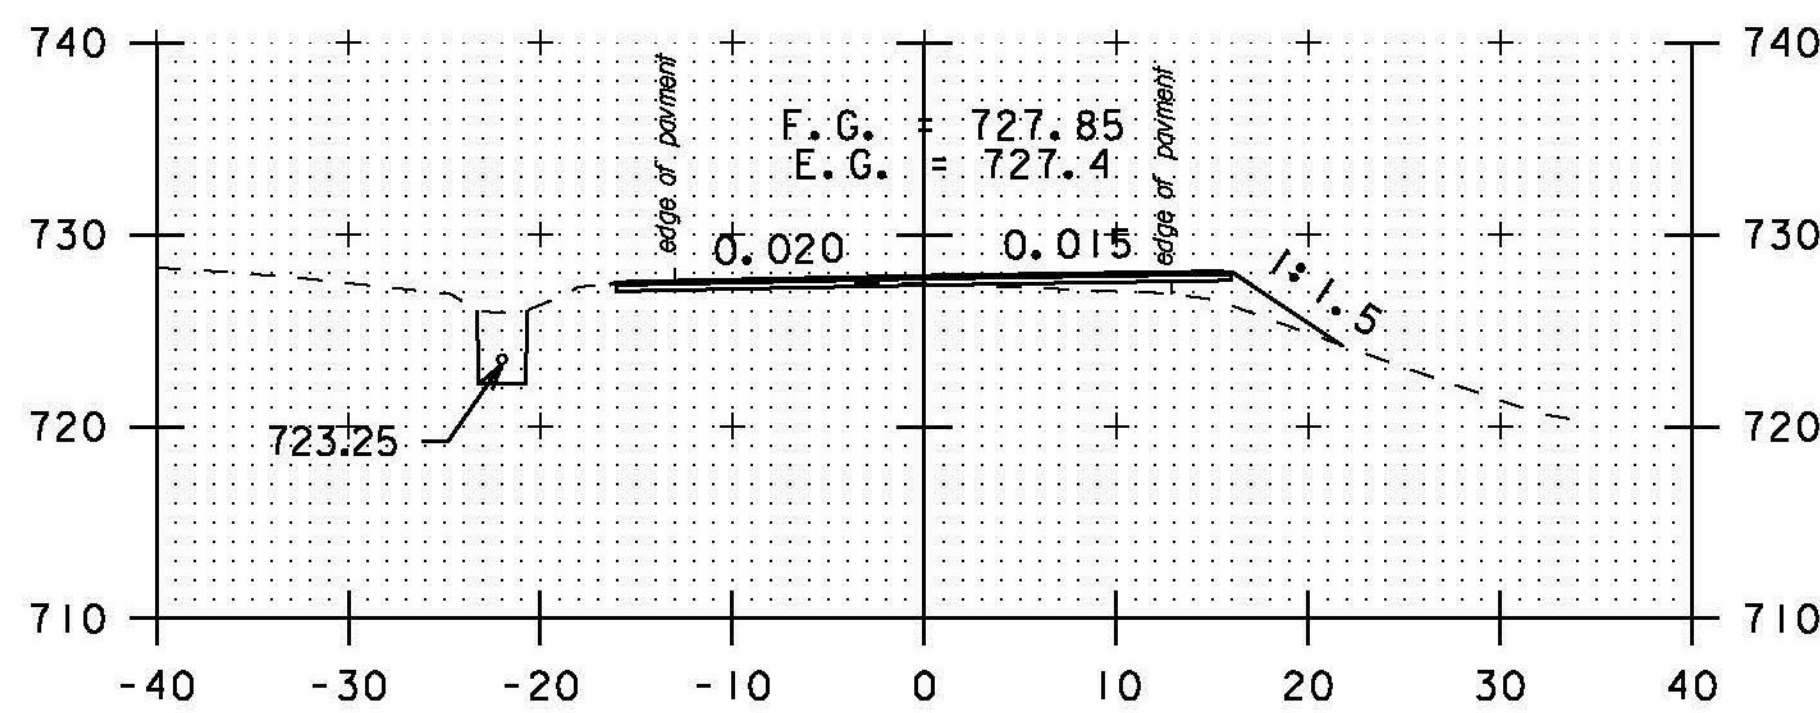


A 44+50

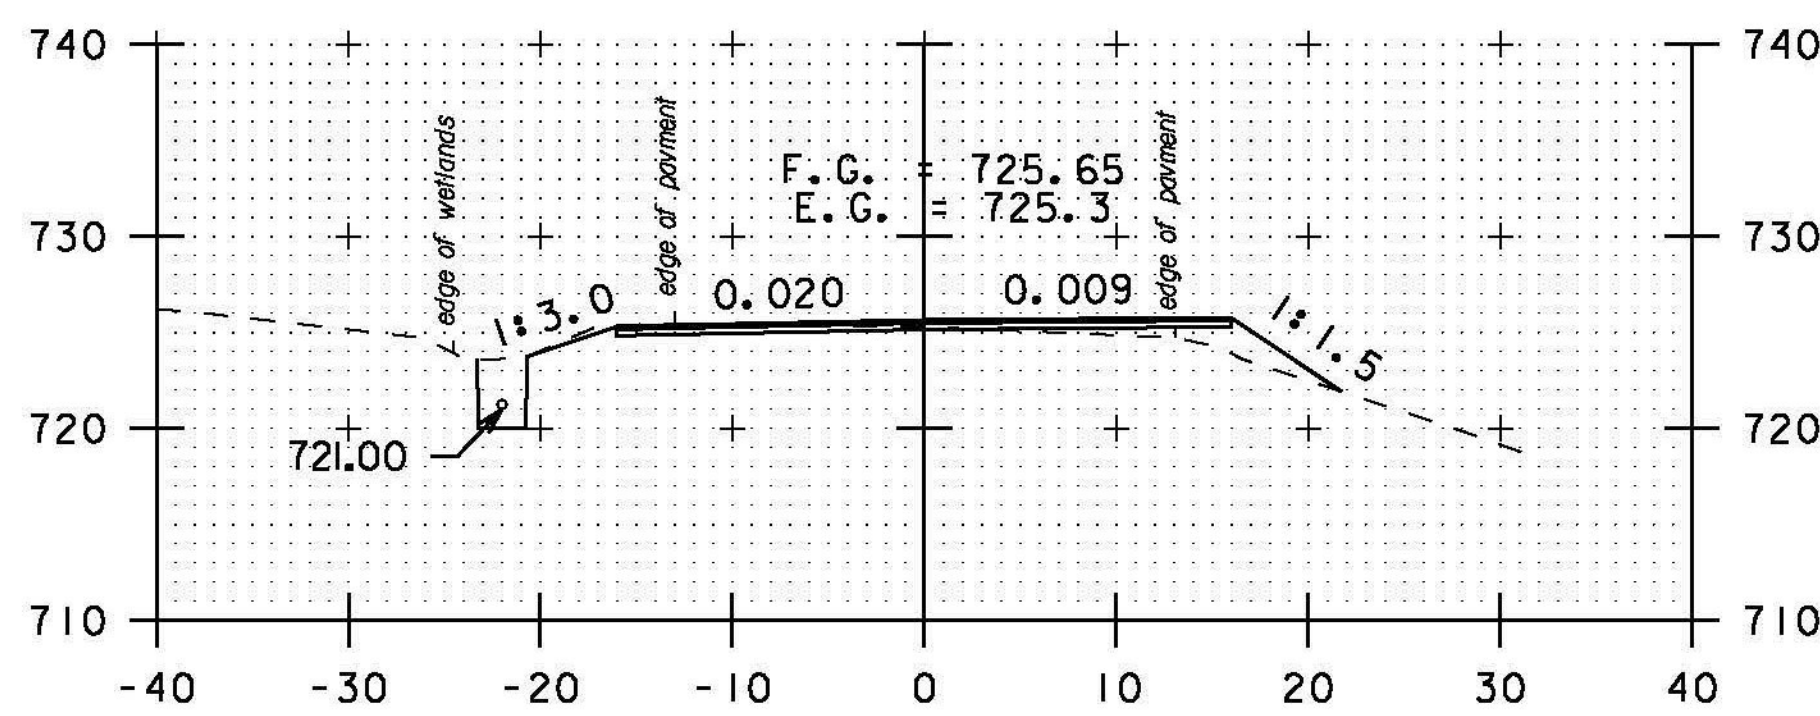


A 44+00

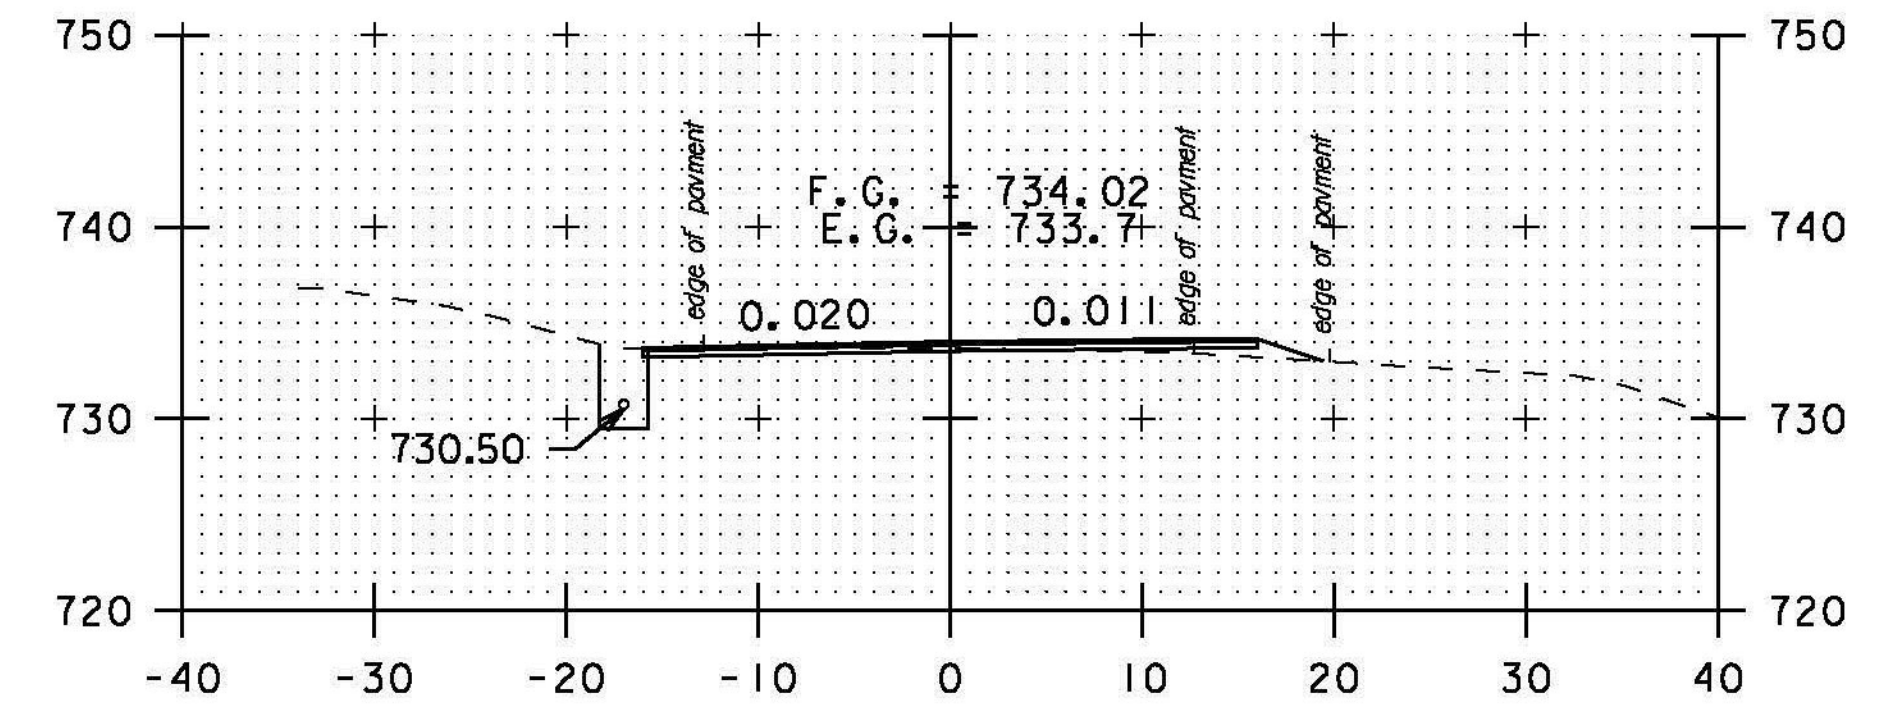

A 46+50

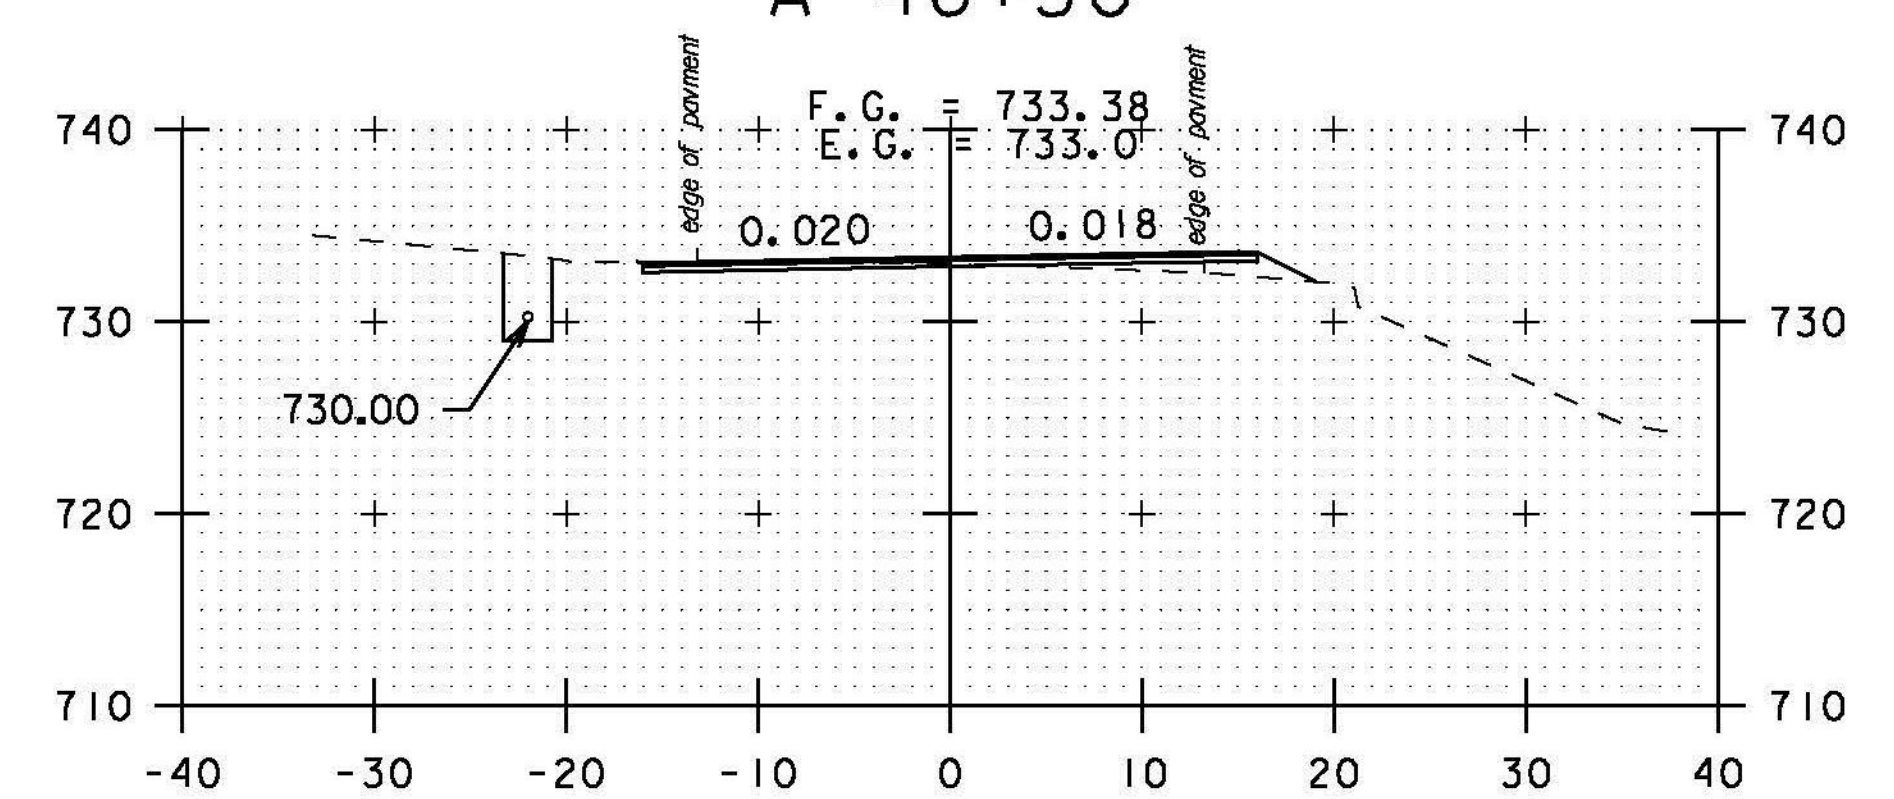


A 46+00

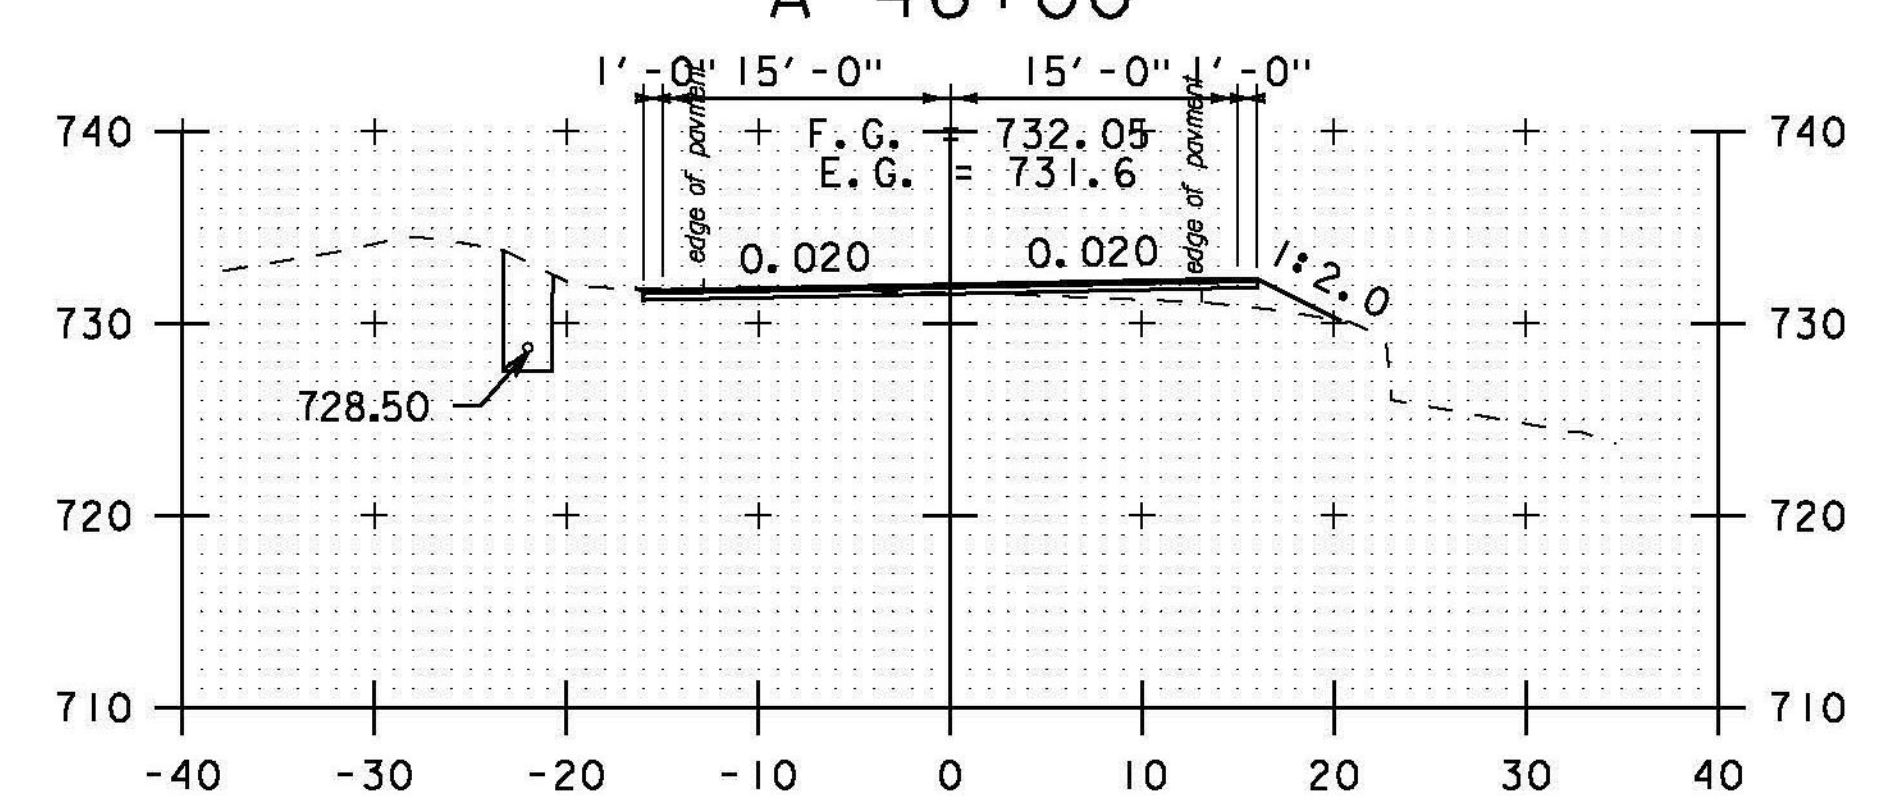

A 45+50

12" STONE FILL, TYPE I (TYP.)
6" GRUBBING MATERIAL (TYP.)
GEOTEXTILE UNDER STONE FILL (TYP.)

STA. A 42+00 TO STA. A 46+50

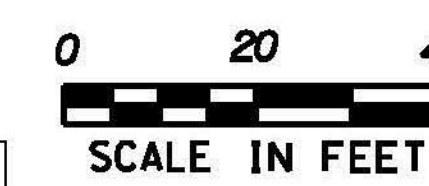

PROJECT NAME: BETHEL-RANDOLPH
PROJECT NUMBER: STP 2921(I)

FILE NAME: piOC244.dgn
PROJECT LEADER: C. LATHROP
DESIGNED BY: S. LAMPHERE
CROSS SECTION SHEET 59

PLOT DATE: 4/23/2015
DRAWN BY: S. LAMPHERE
CHECKED BY: C. LATHROP
SHEET 193 OF 211