




A 48+50

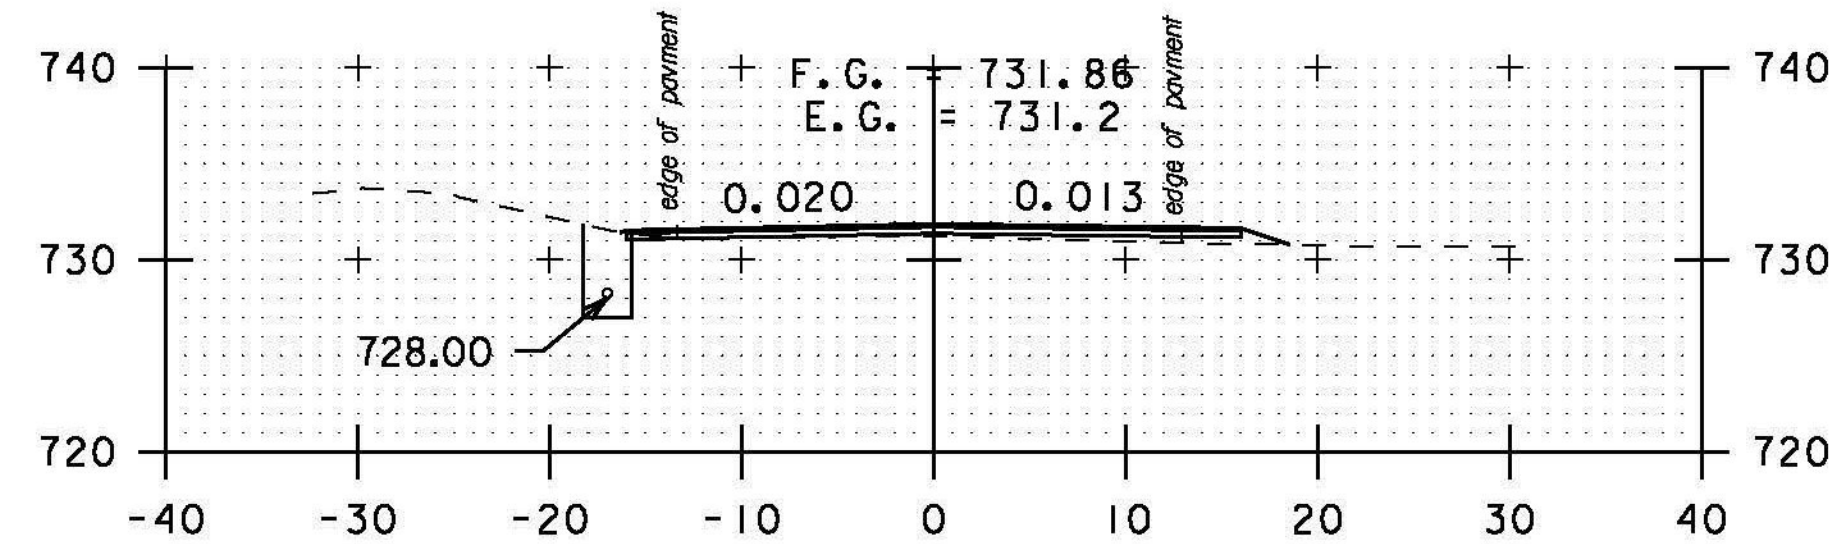


A 48+00

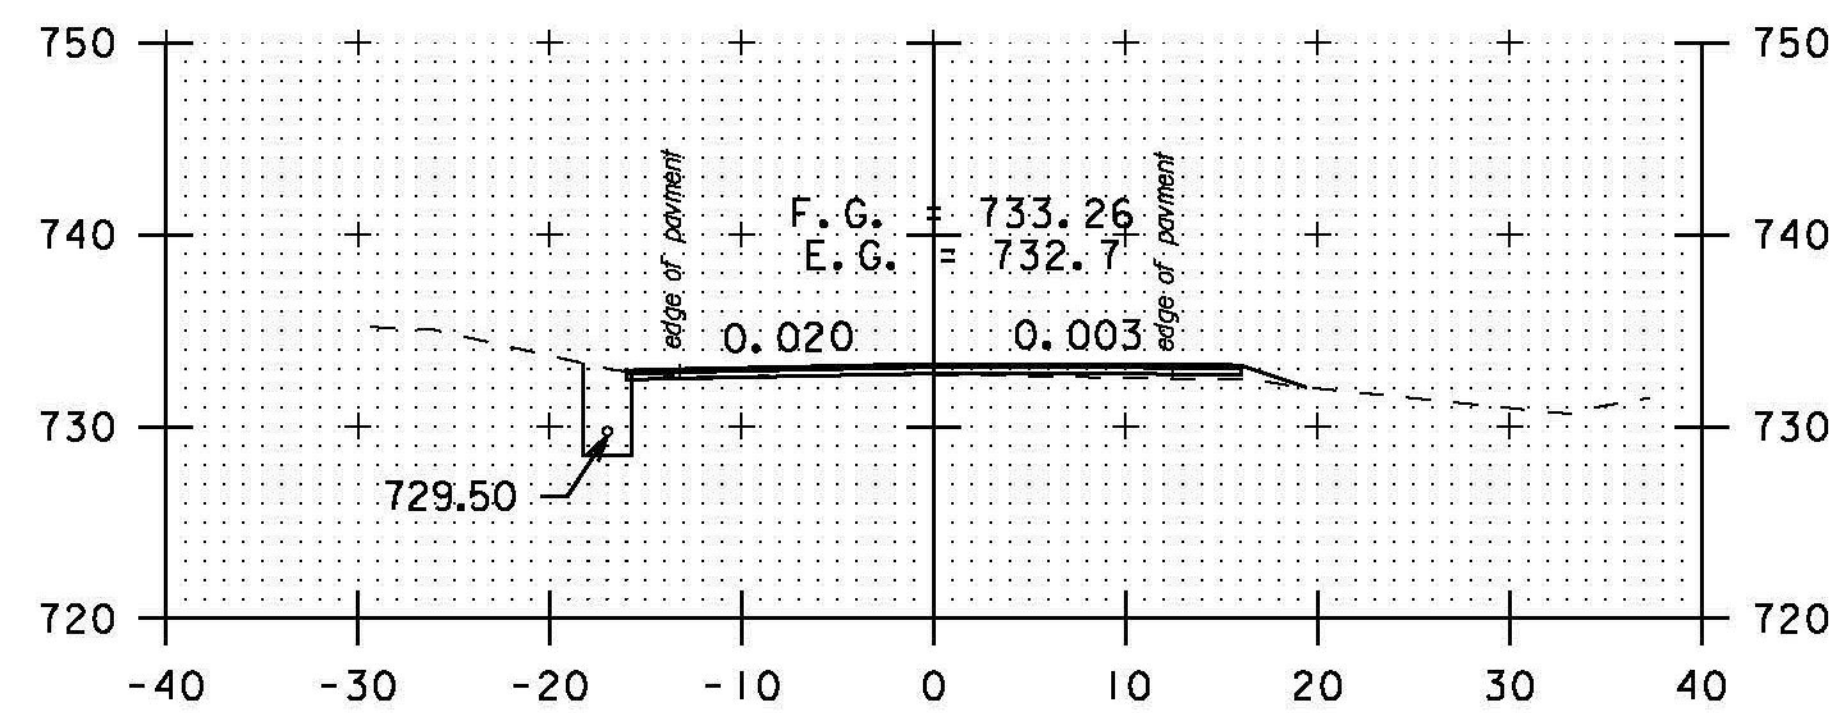


A 47+50

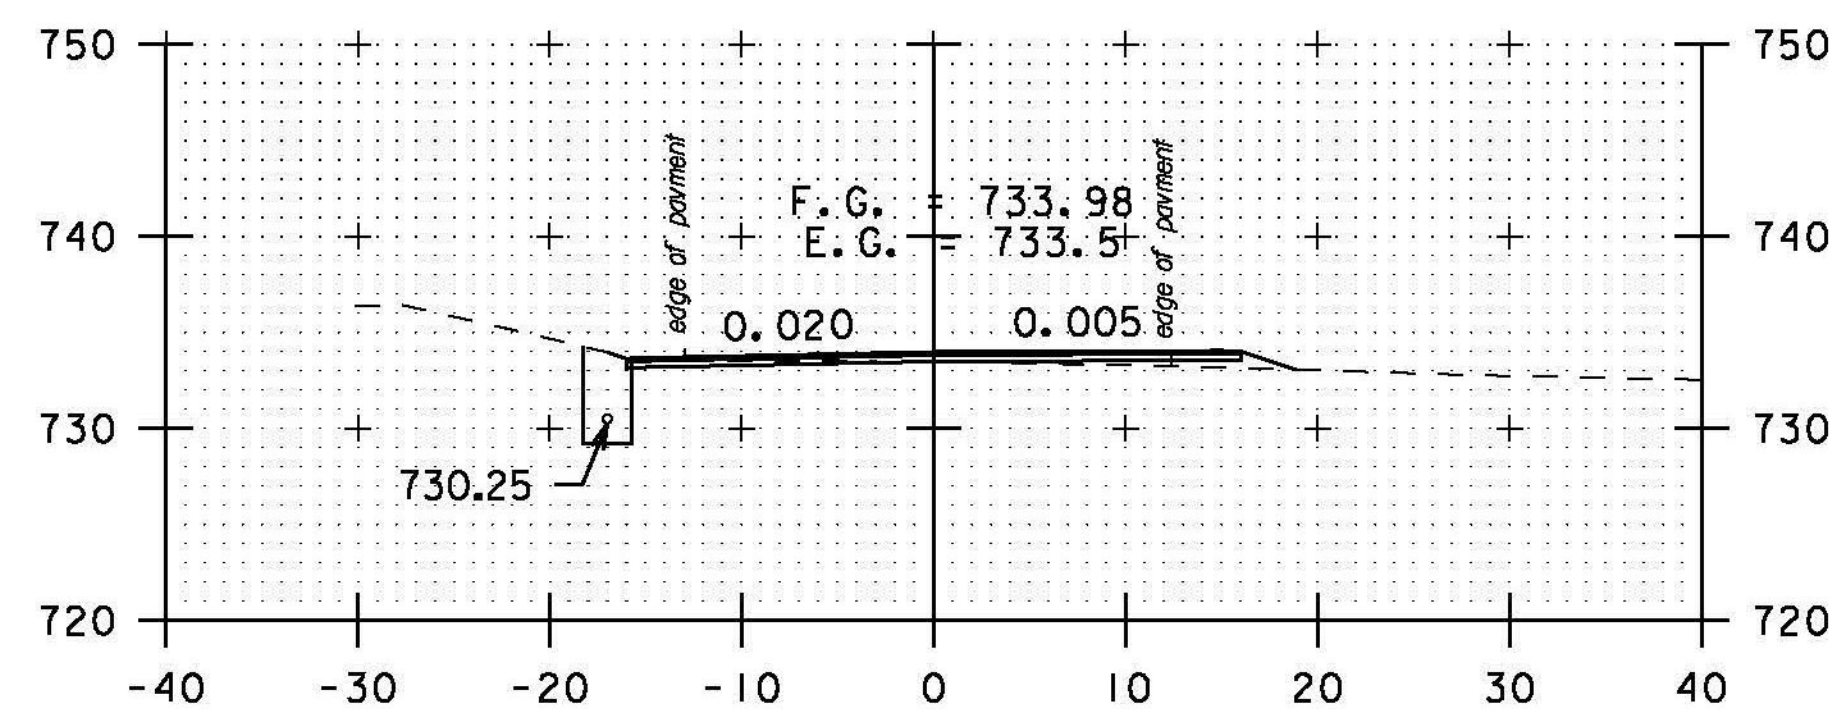


A 47+00

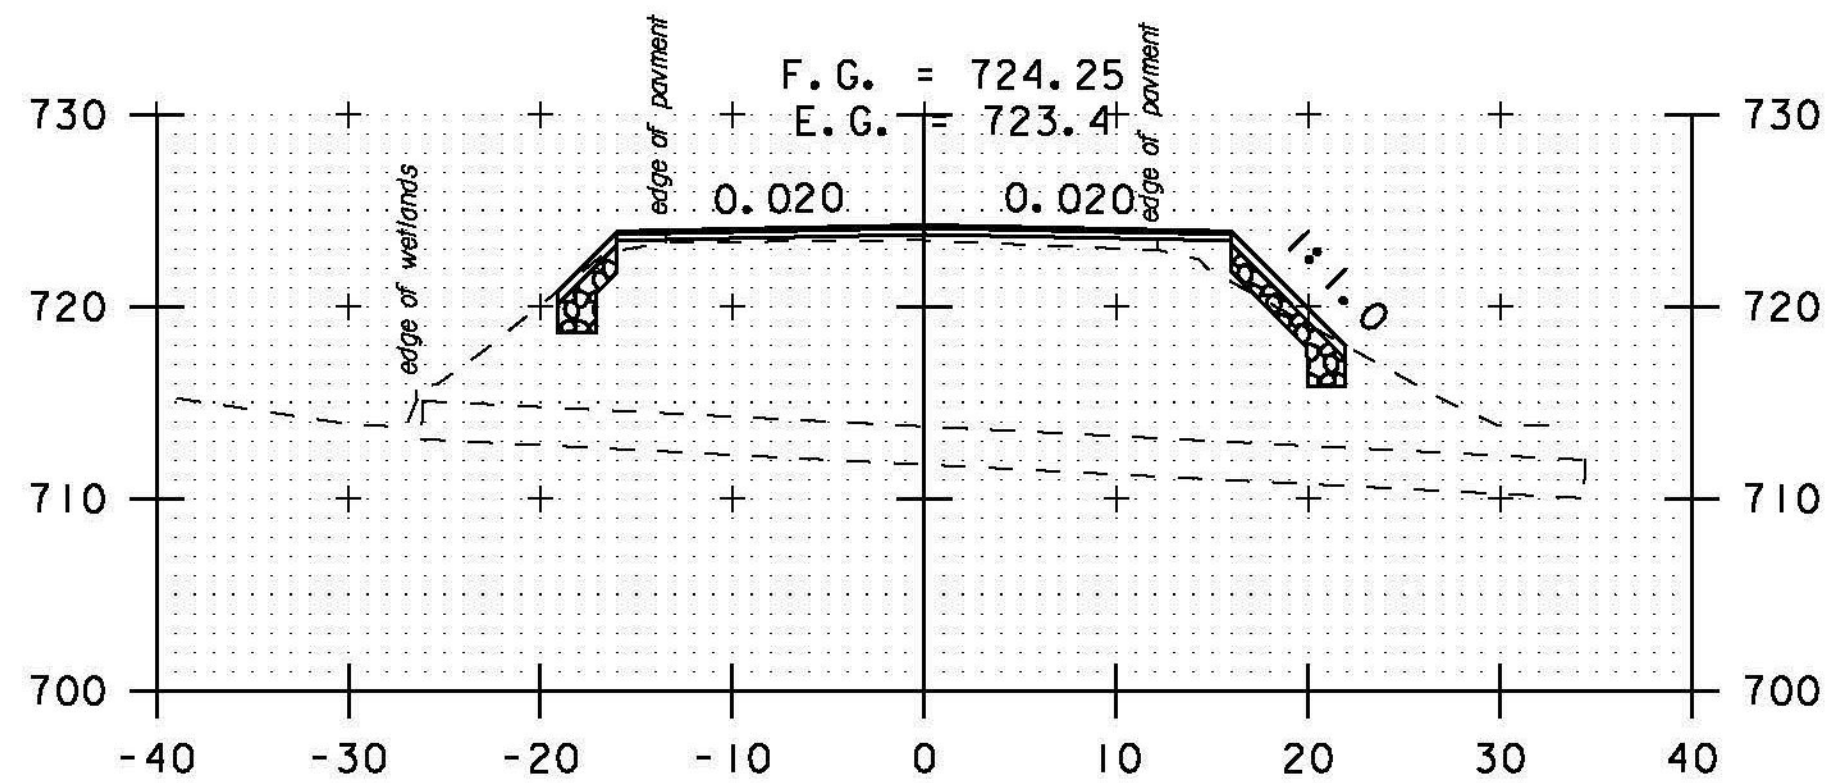


A 50+00

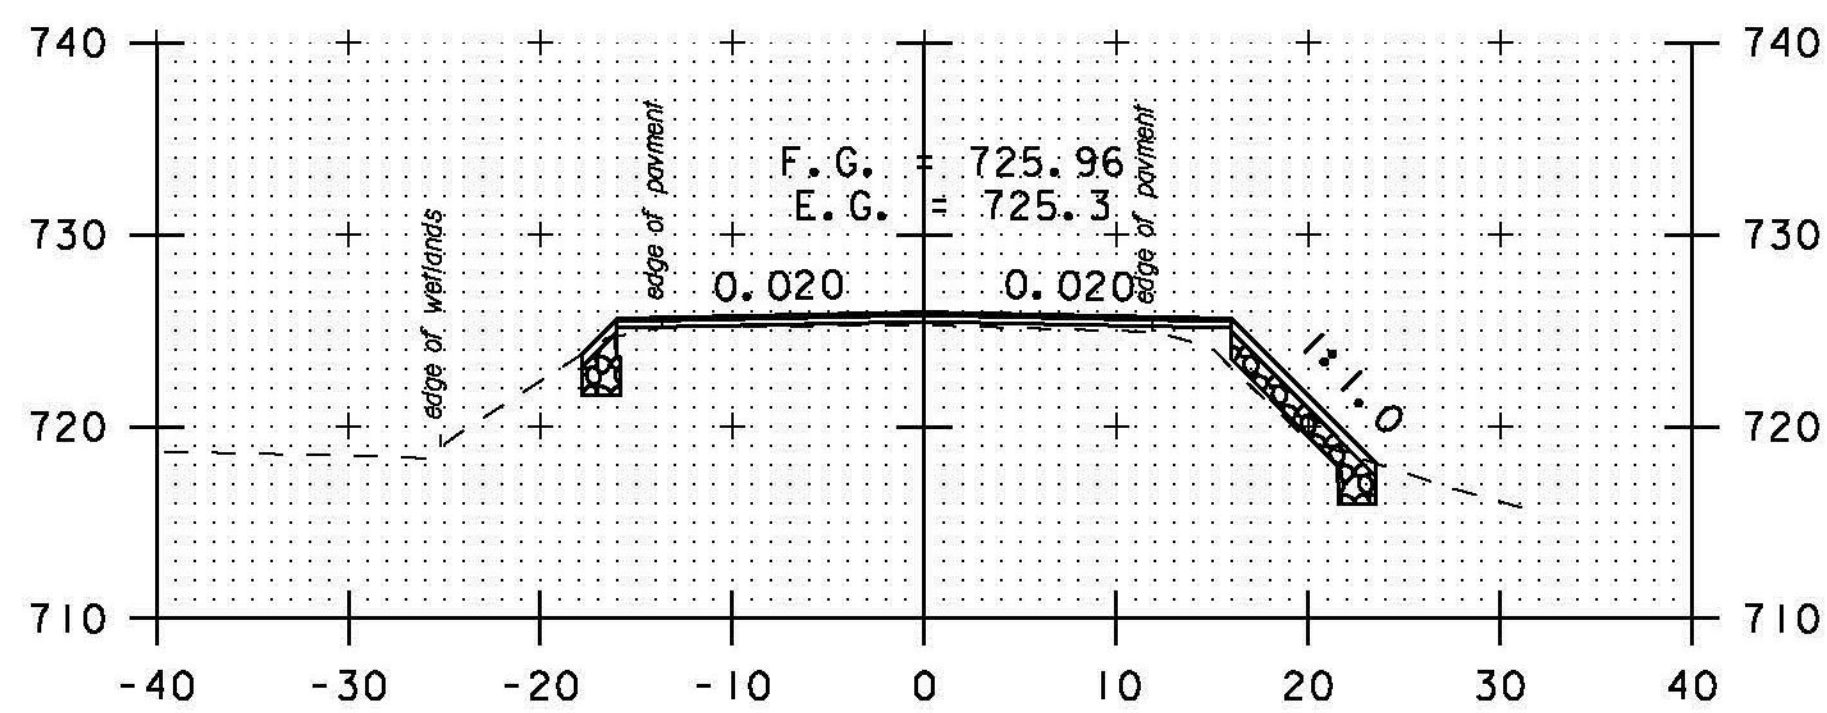


A 49+50

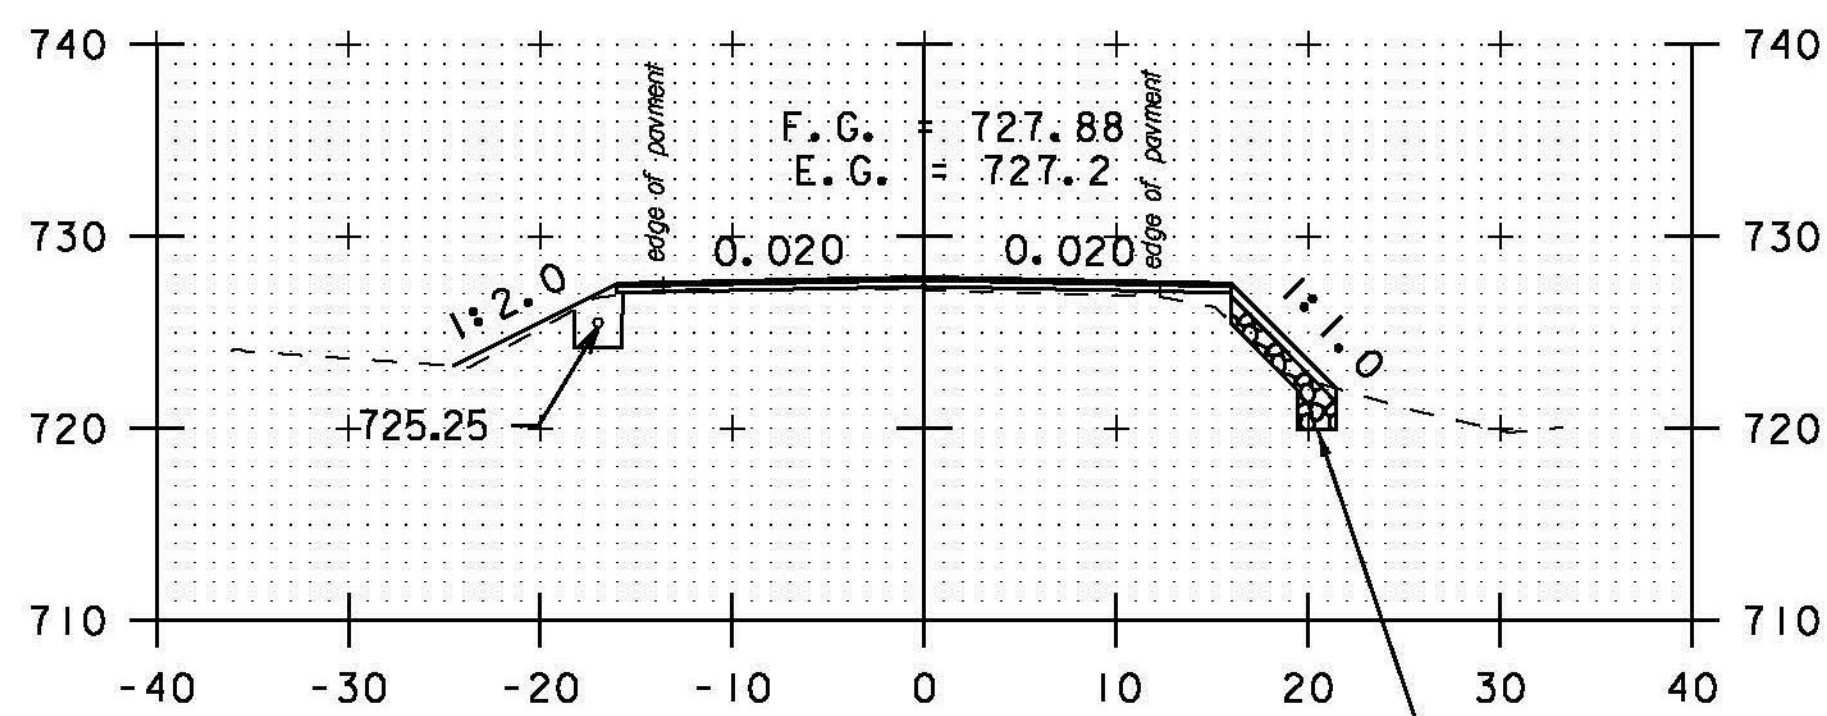


A 49+00

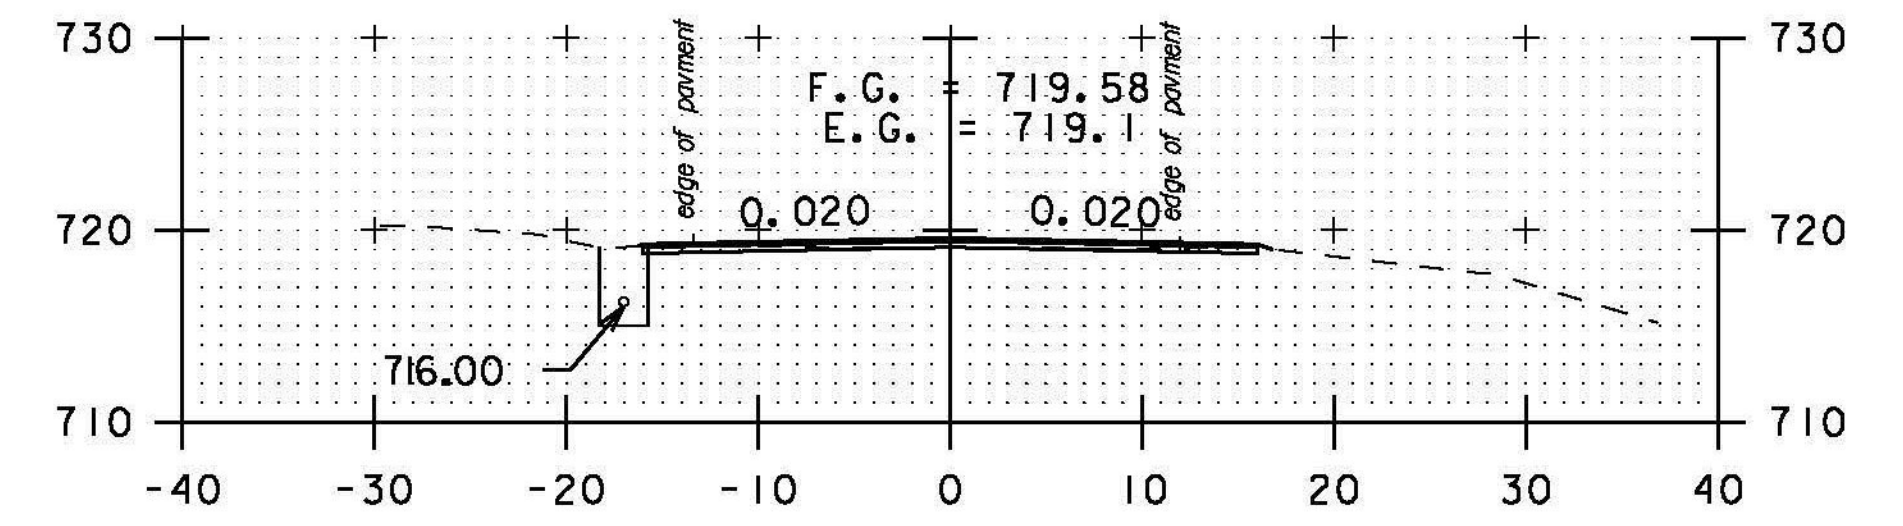


A 52+00

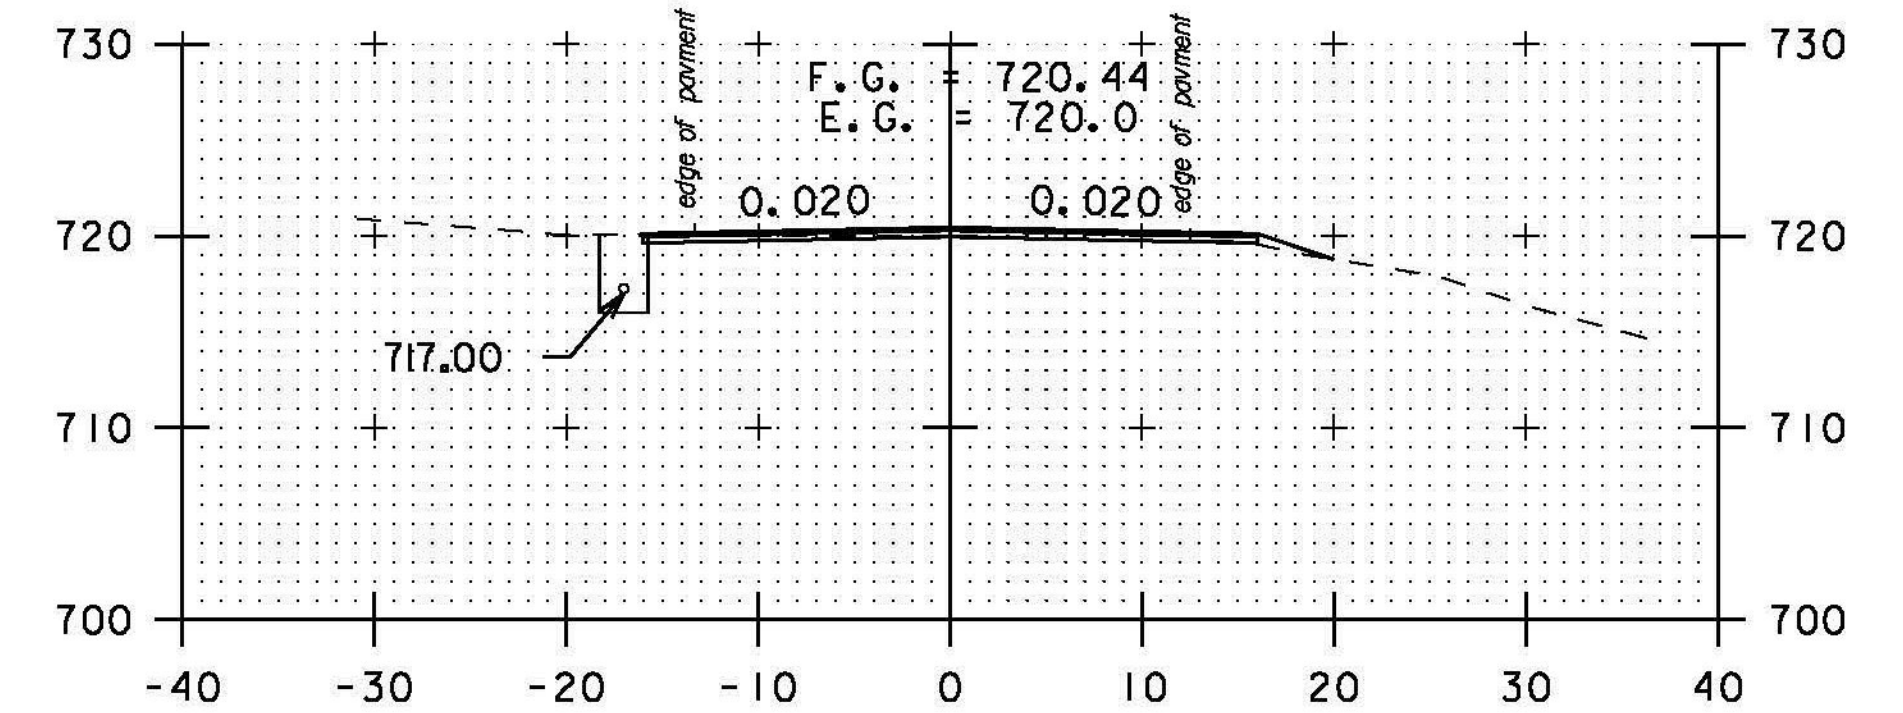

A 51+50

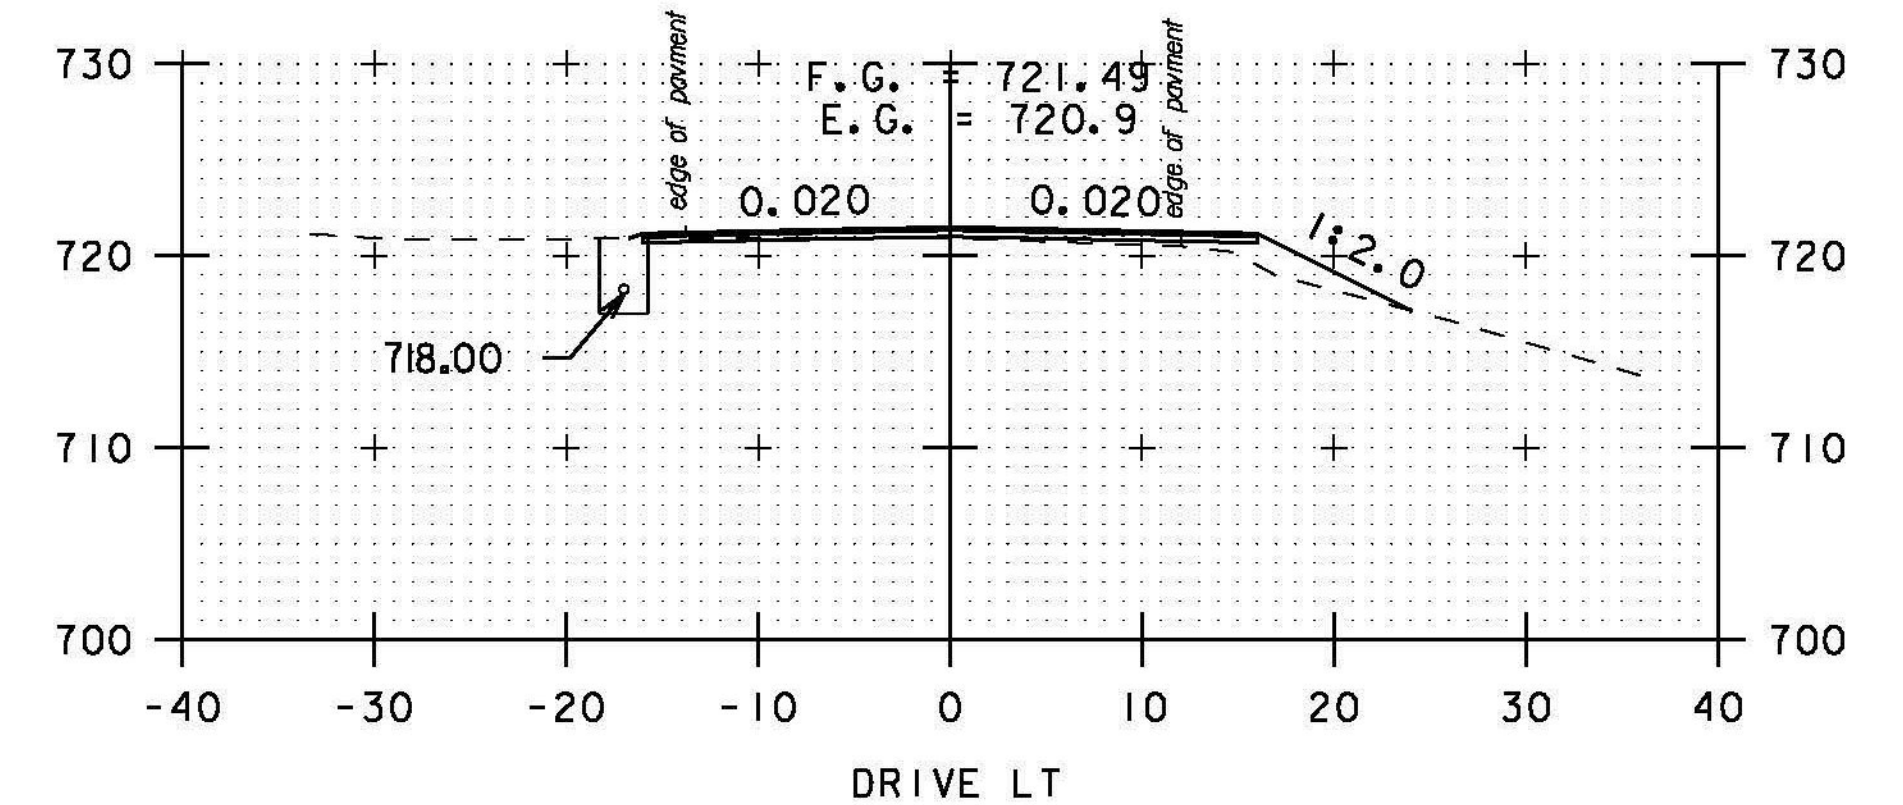


A 51+00

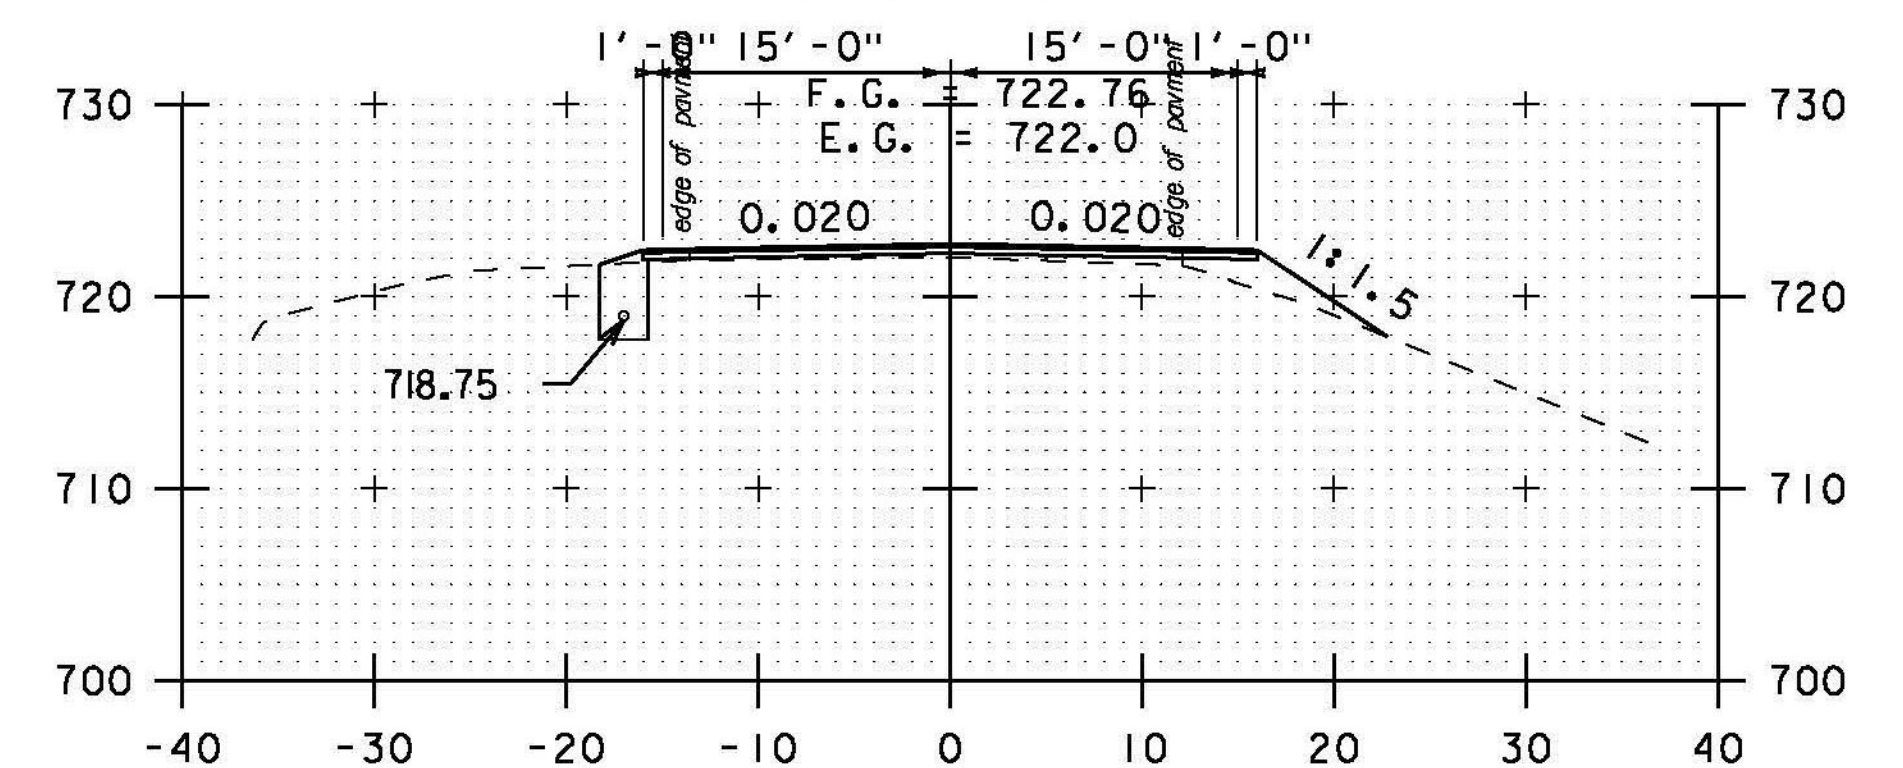

A 50+50

12" STONE FILL, TYPE I (TYP.)  
6" GRUBBING MATERIAL (TYP.)  
GEOTEXTILE UNDER STONE FILL (TYP.)

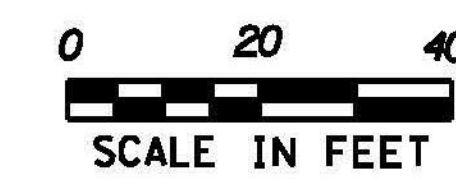

STA. A 47+00 TO STA. A 52+00

PROJECT NAME: BETHEL-RANDOLPH  
PROJECT NUMBER: STP 292(I)

FILE NAME: piOC244.dgn  
PROJECT LEADER: C. LATHROP  
DESIGNED BY: S. LAMPHERE  
CROSS SECTION SHEET 60

PLOT DATE: 4/23/2015  
DRAWN BY: S. LAMPHERE  
CHECKED BY: C. LATHROP  
SHEET 194 OF 211