



A 54+00

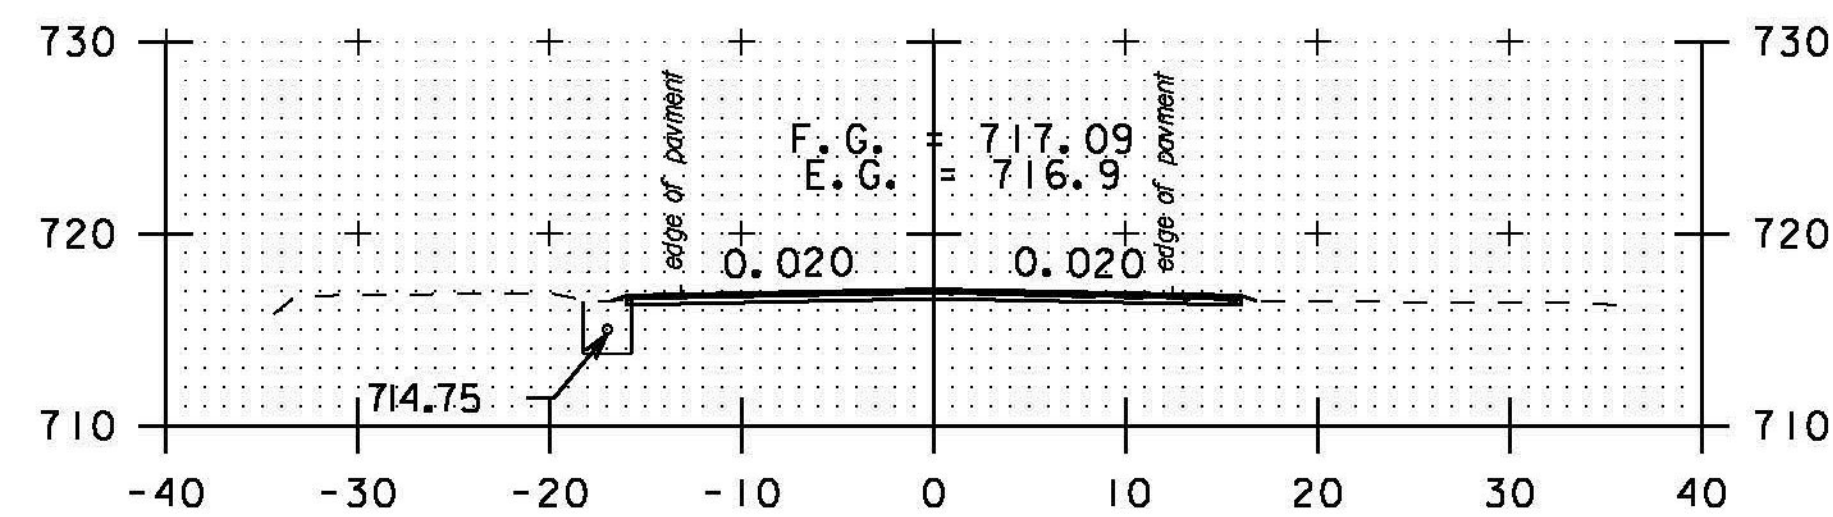


DRIVE RT

A 53+50

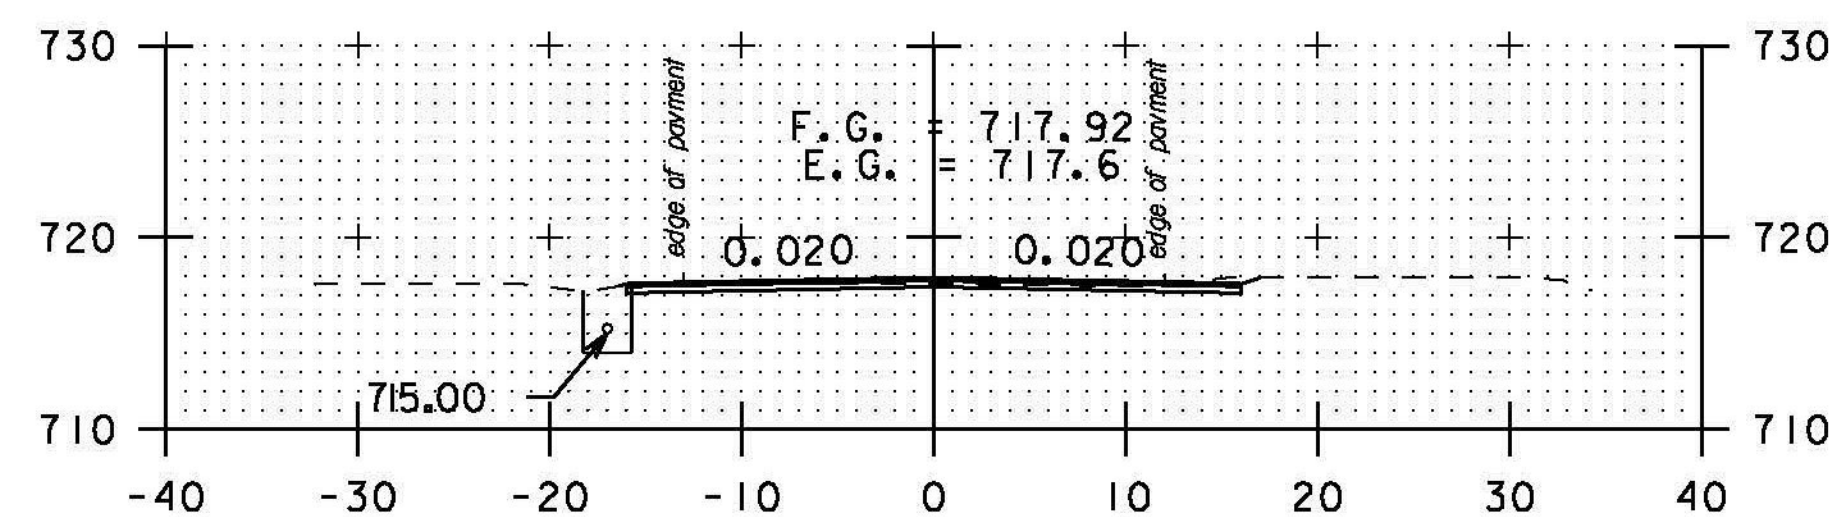


A 53+00

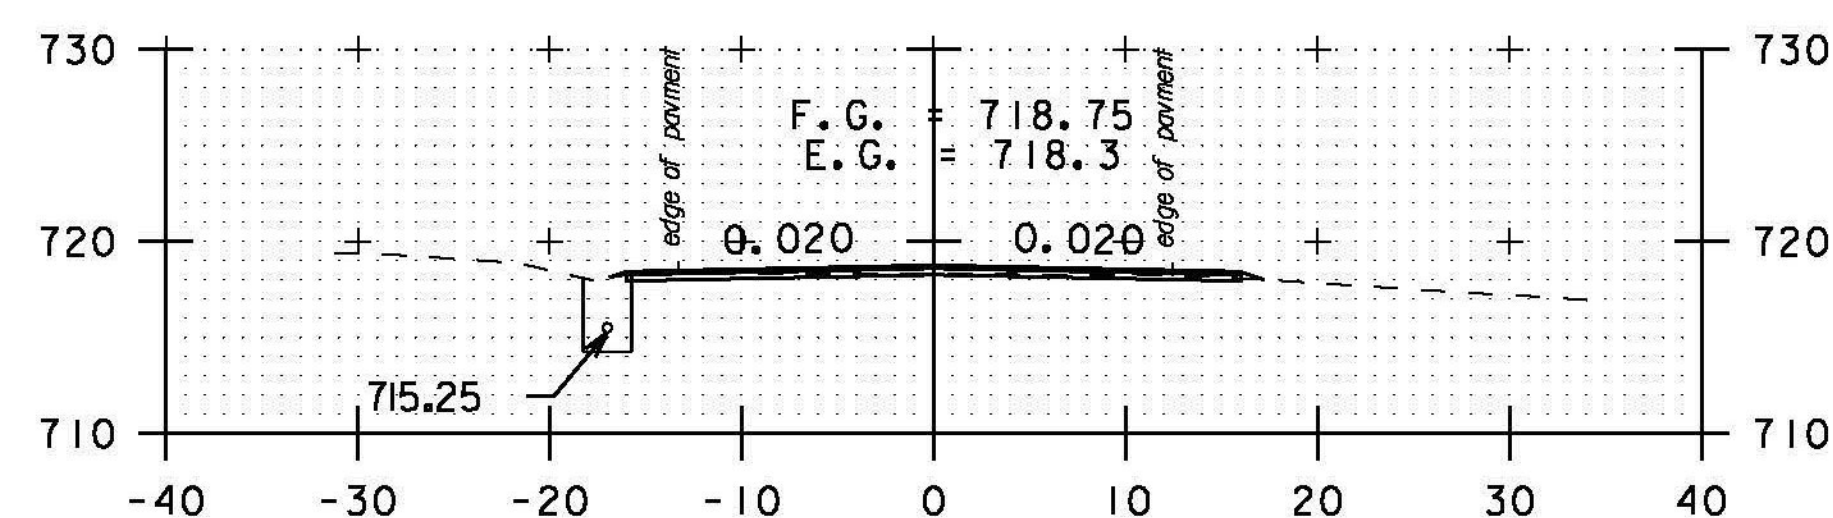


DRIVE RT


A 52+50

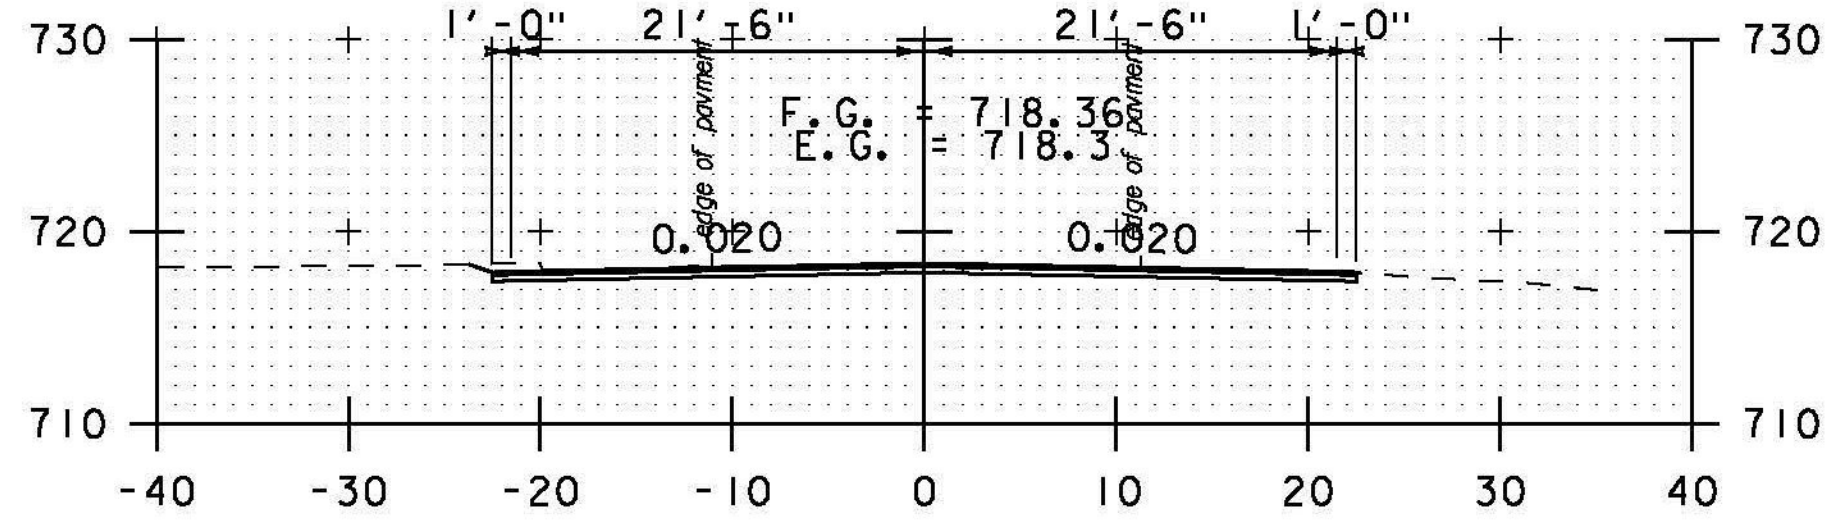

A 56+00

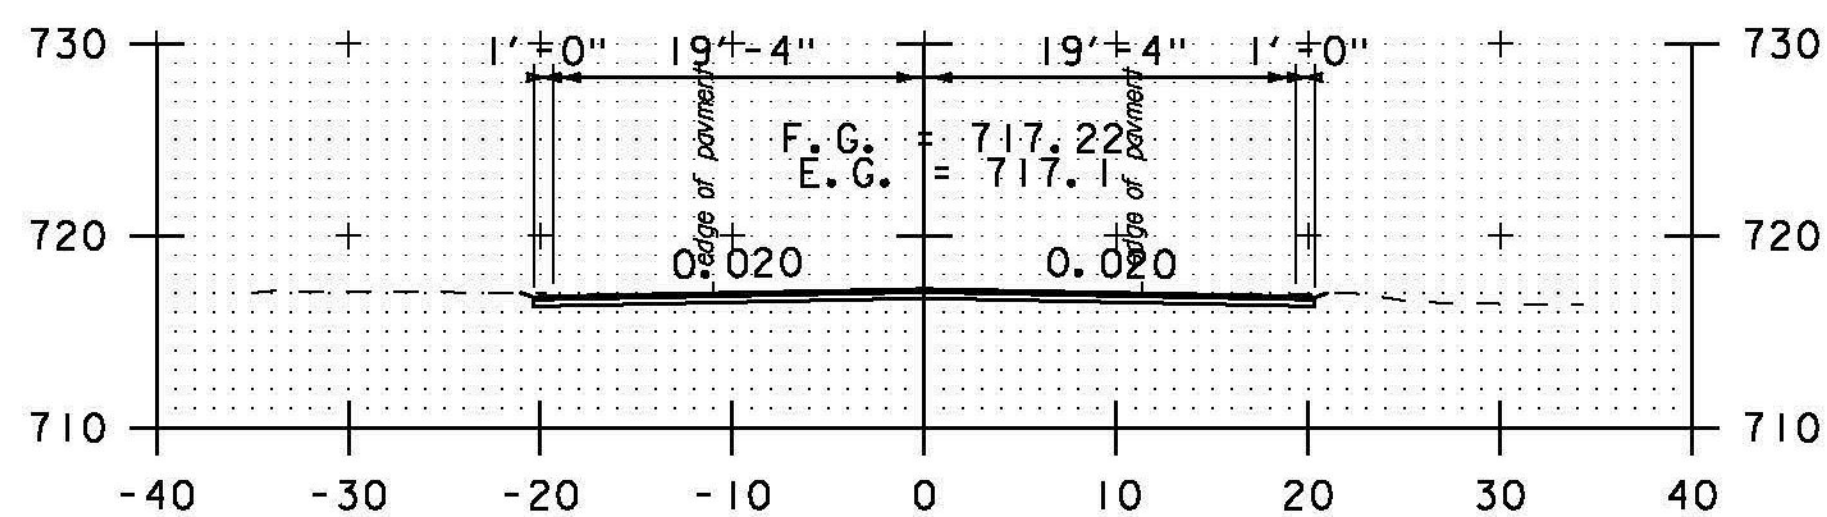


A 55+50

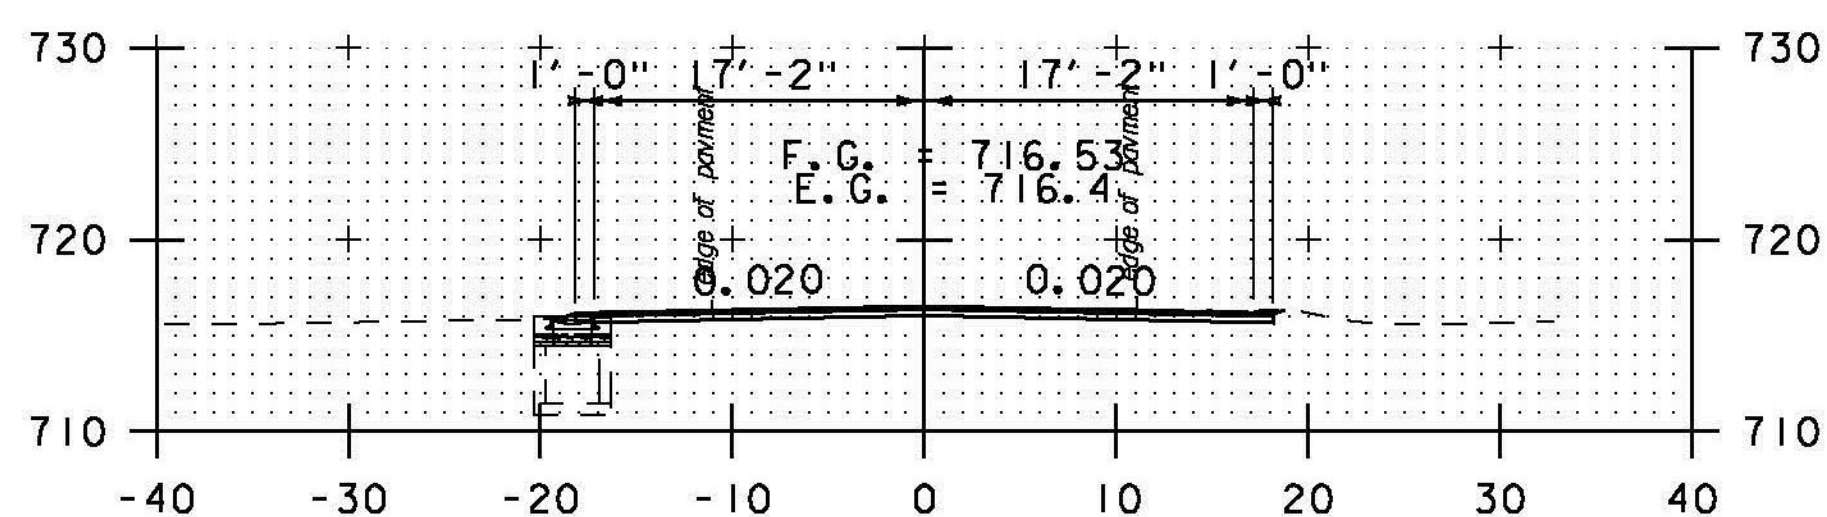


DRIVE LT

A 55+00

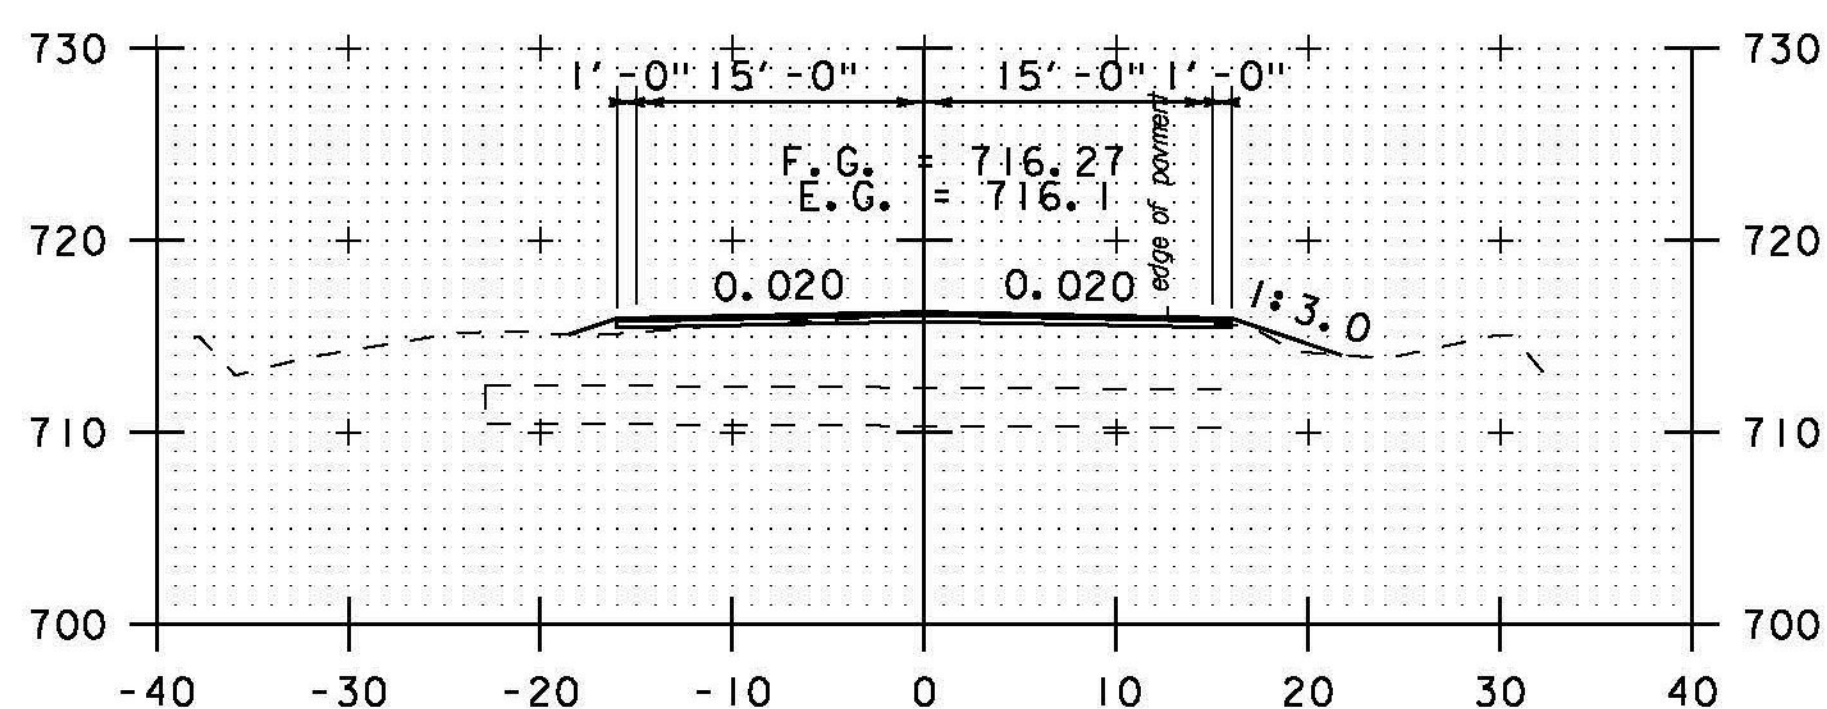


A 54+50

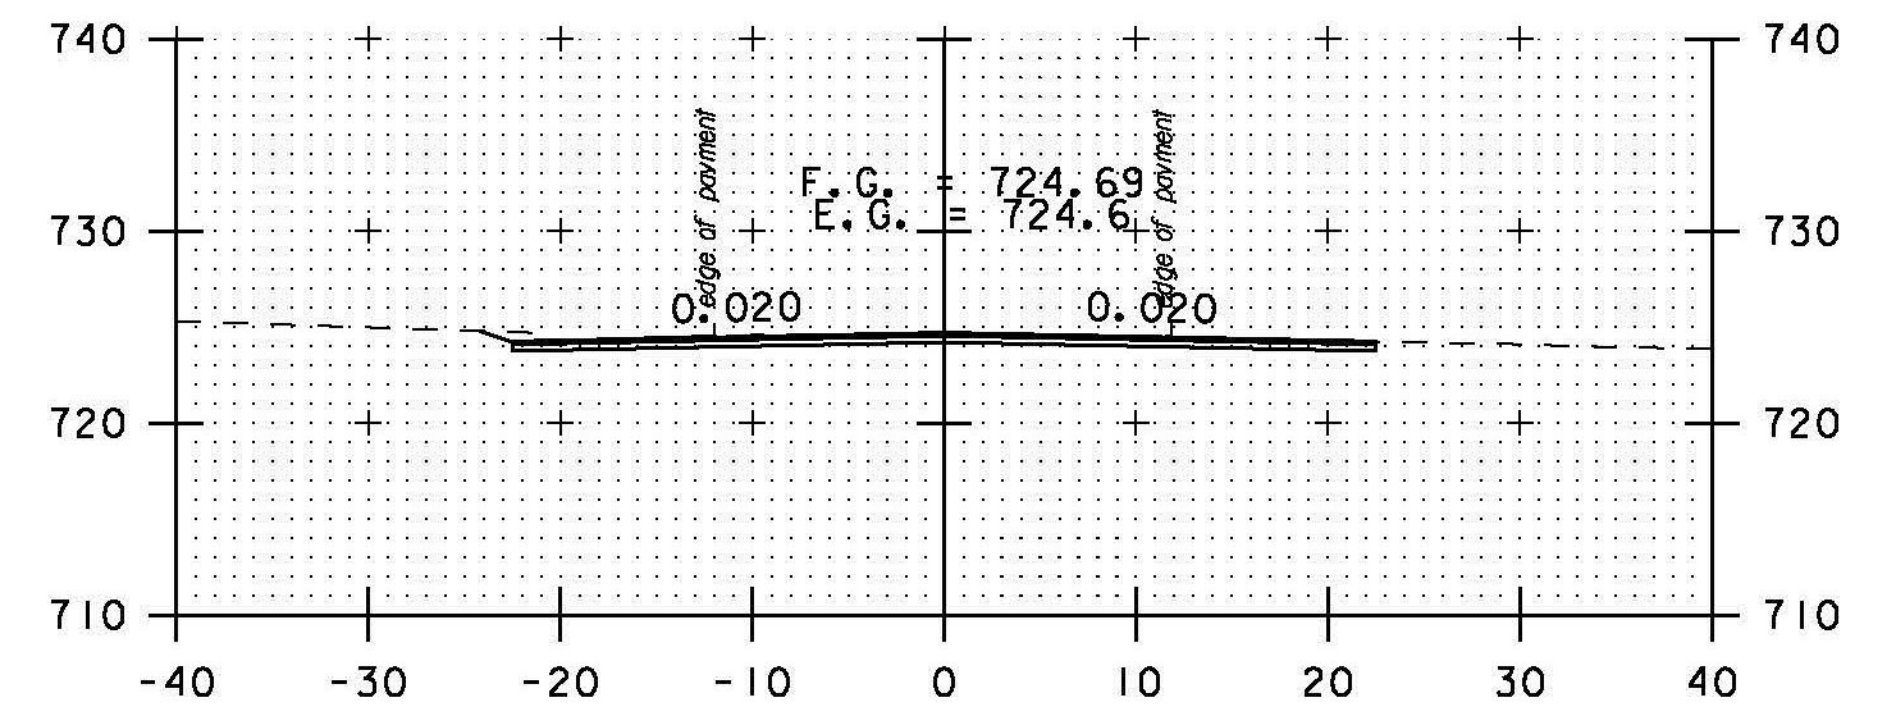


TH#87 LT

A 58+00

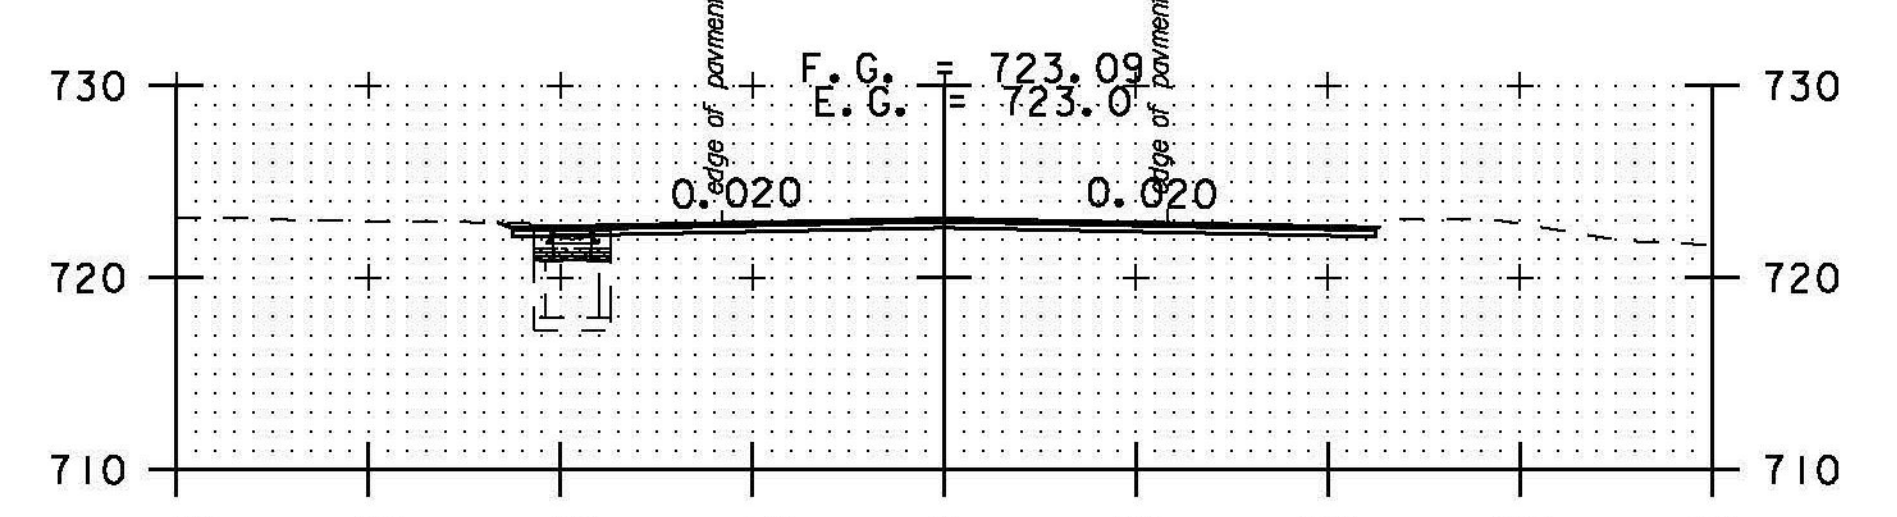


TH#87 LT

A 57+50

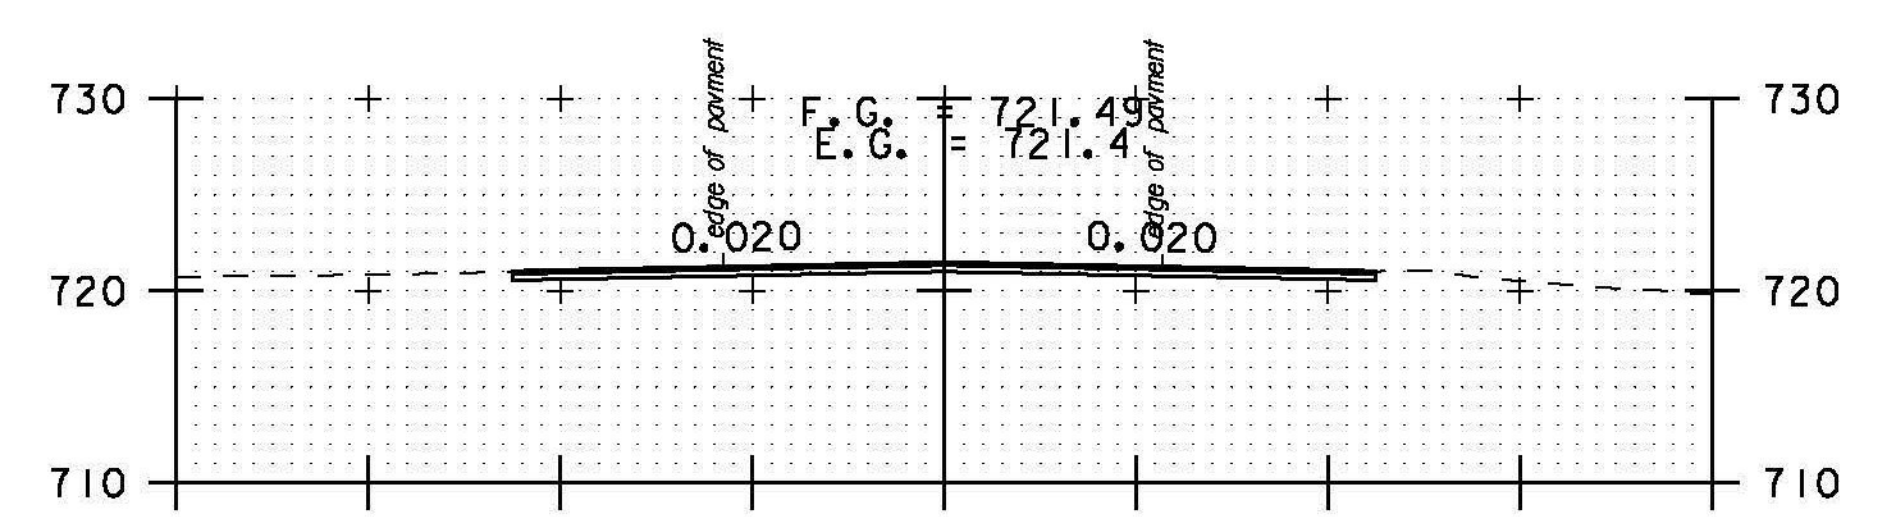

DRIVE LT

A 57+00

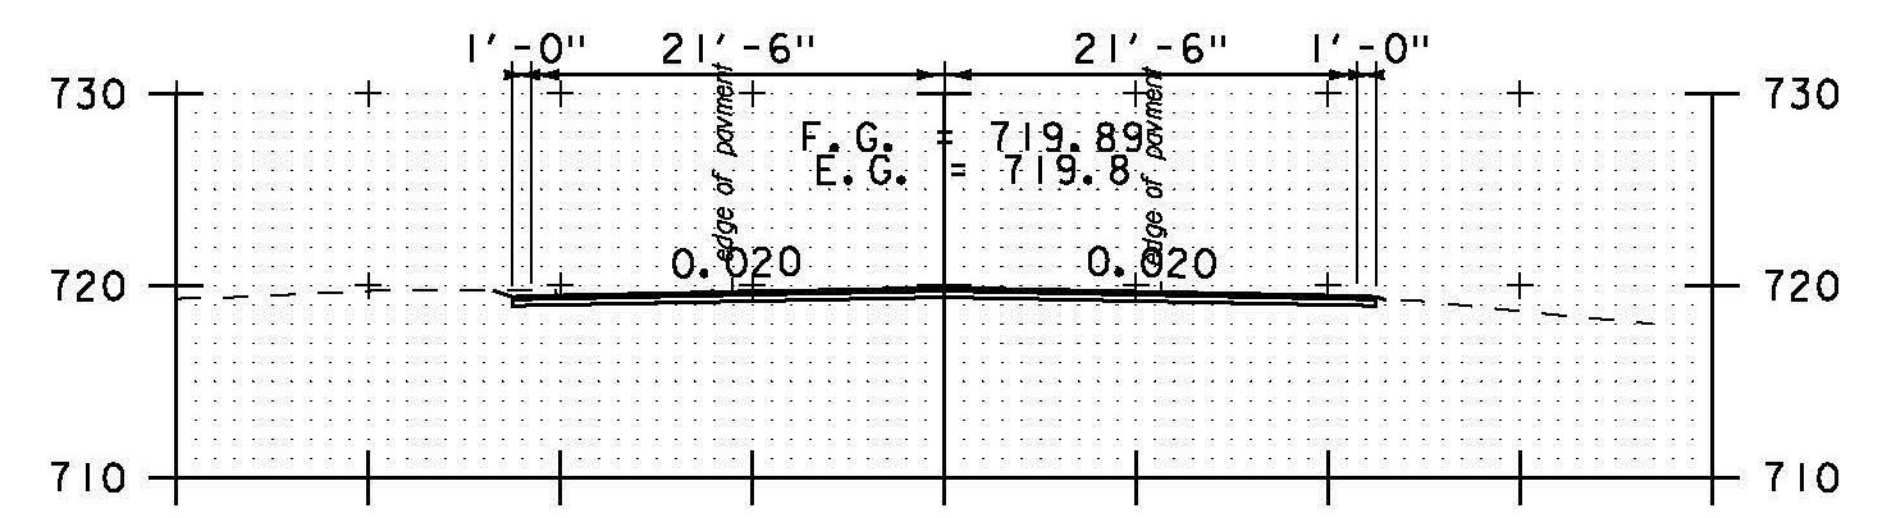


A 56+50

PROJECT NAME: BETHEL-RANDOLPH
PROJECT NUMBER: STP 292(I)

FILE NAME: piOC244.dgn
PROJECT LEADER: C. LATHROP
DESIGNED BY: S. LAMPHERE
CROSS SECTION SHEET 6I

PLOT DATE: 4/23/2015
DRAWN BY: S. LAMPHERE
CHECKED BY: C. LATHROP
SHEET 195 OF 211

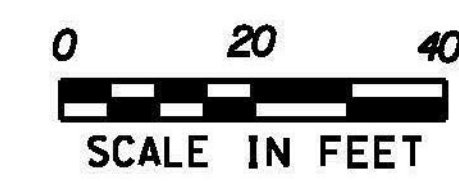

STA. A 52+50 TO STA. A 58+00