




TH#5 LT
A 60+00

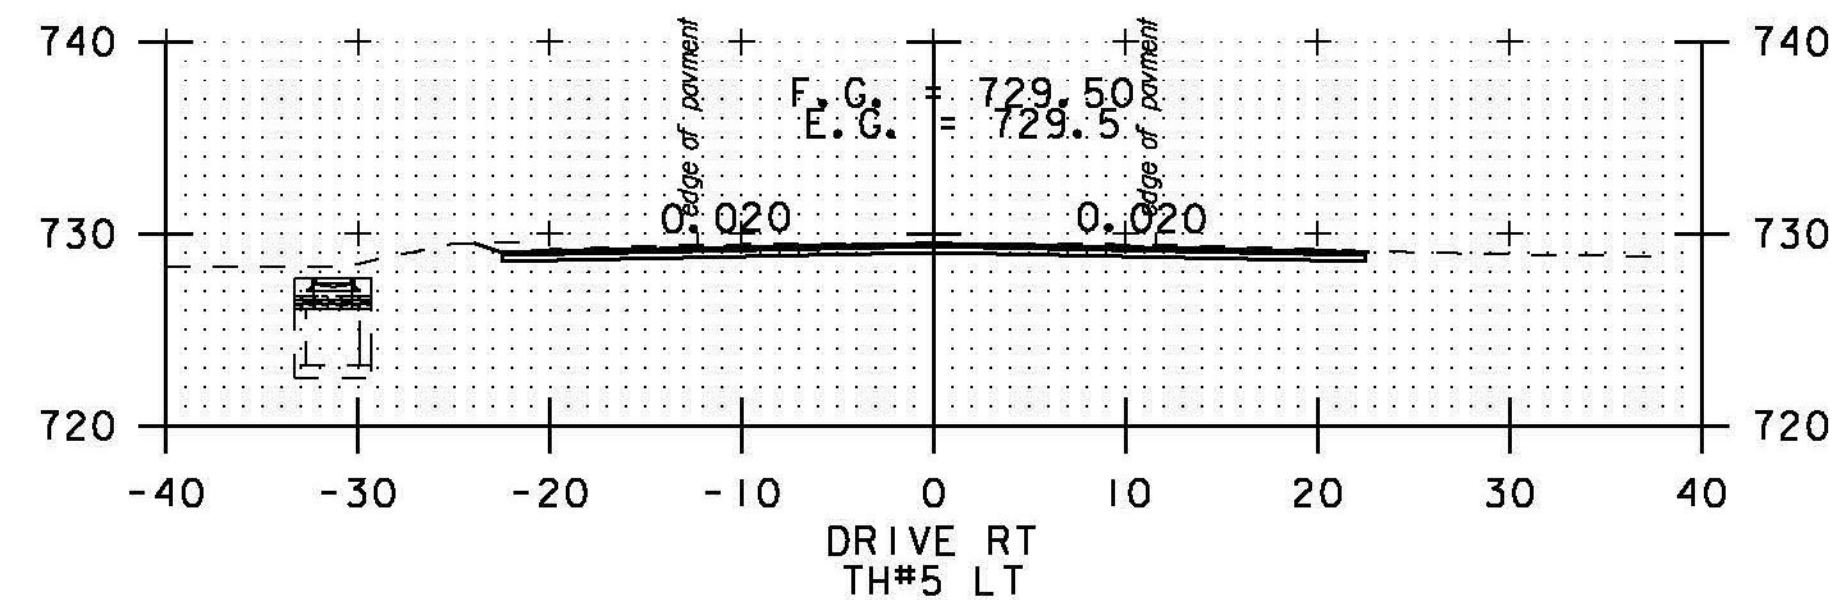


DRIVE RT
TH#5 LT
A 59+50

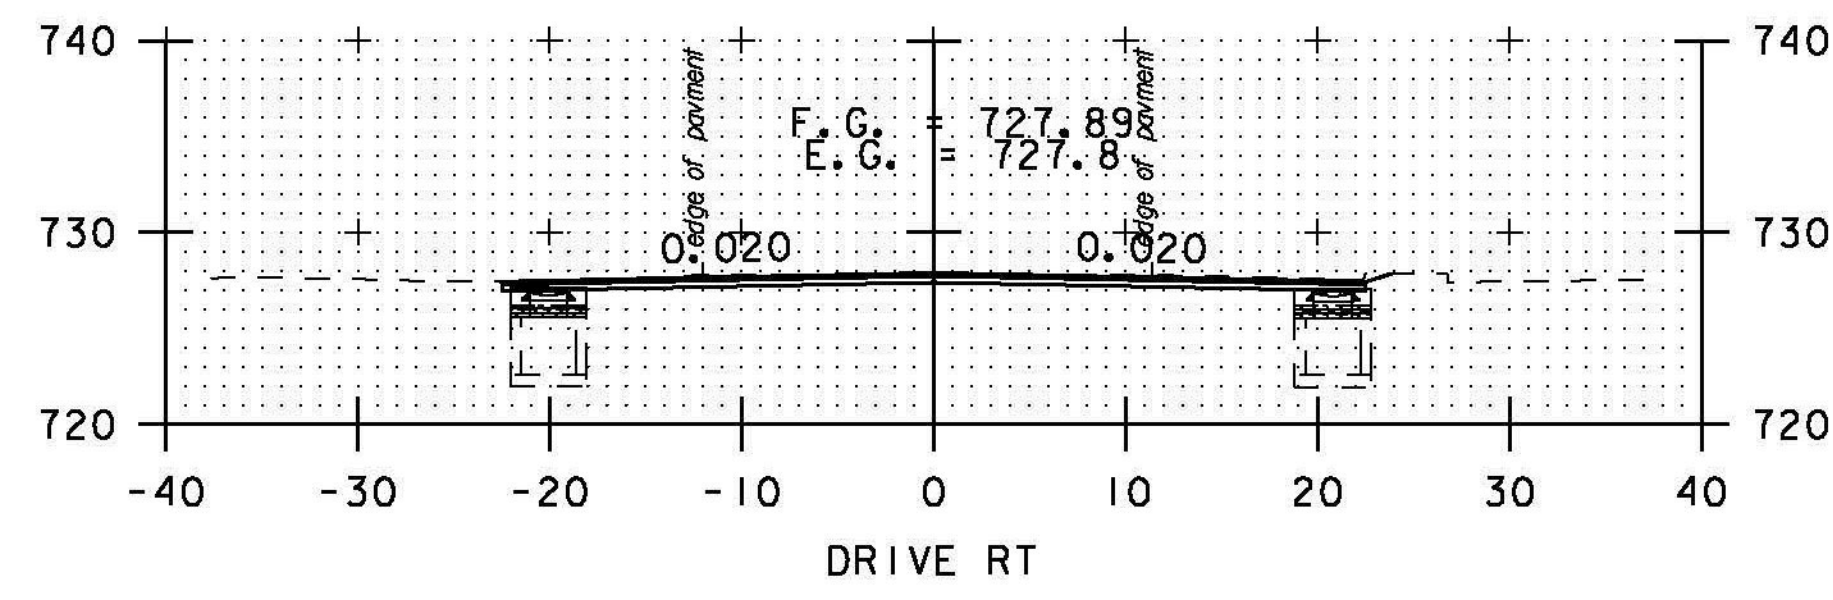


DRIVE RT
A 59+00

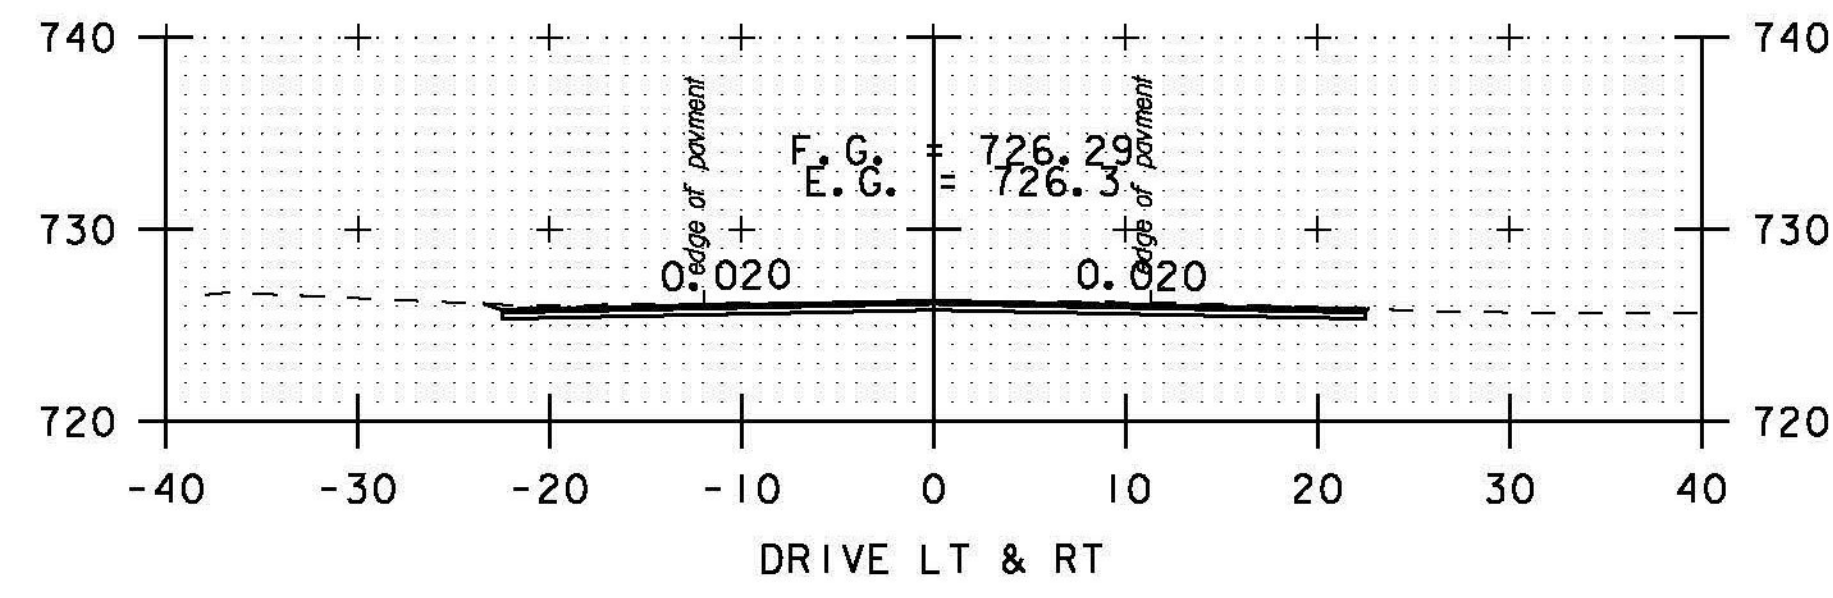


DRIVE LT & RT
A 58+50

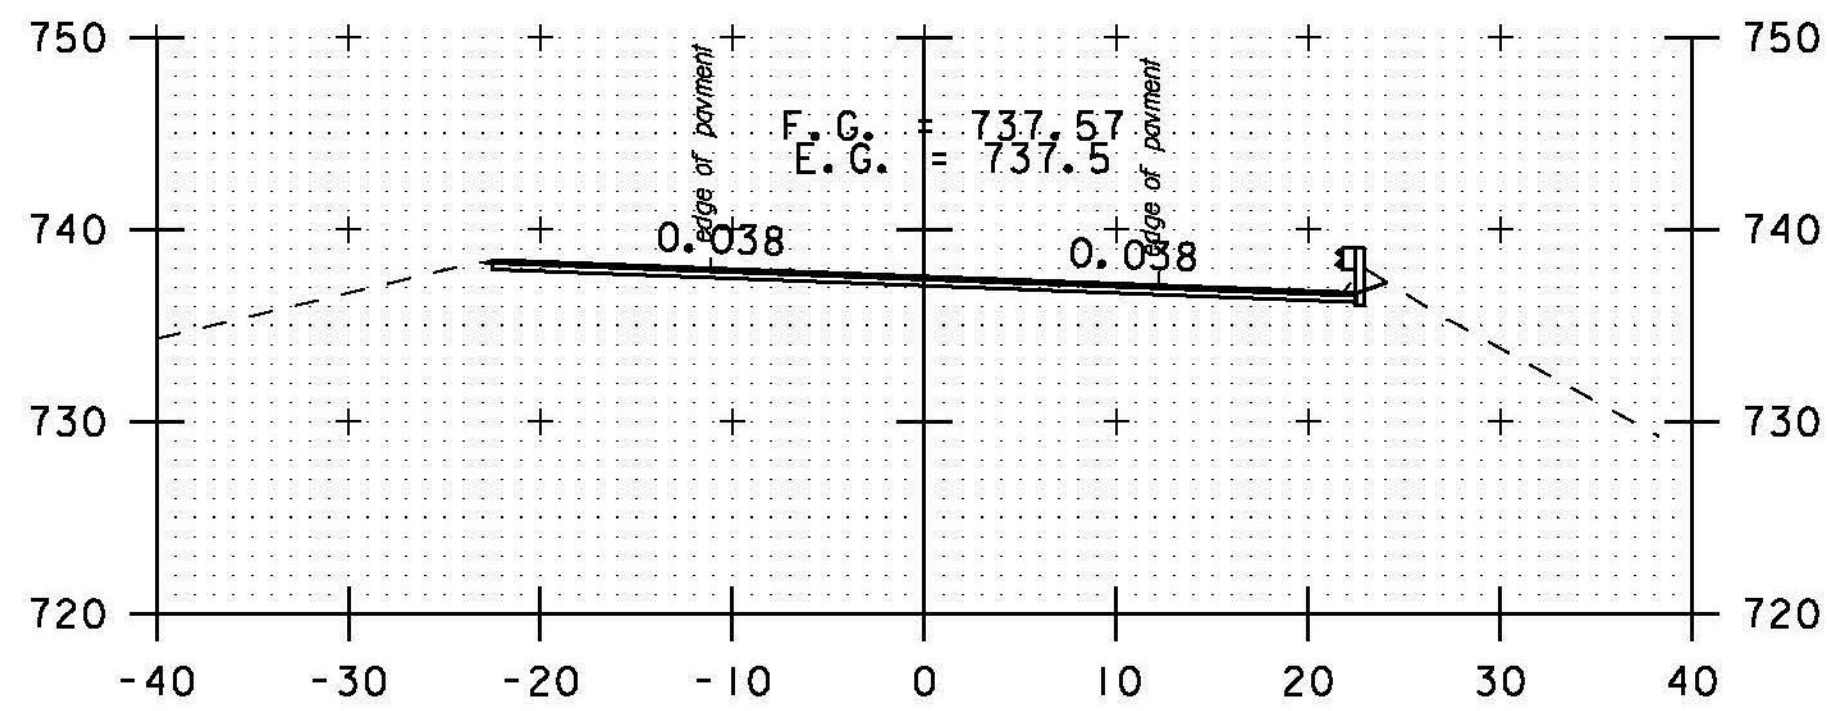


A 62+00

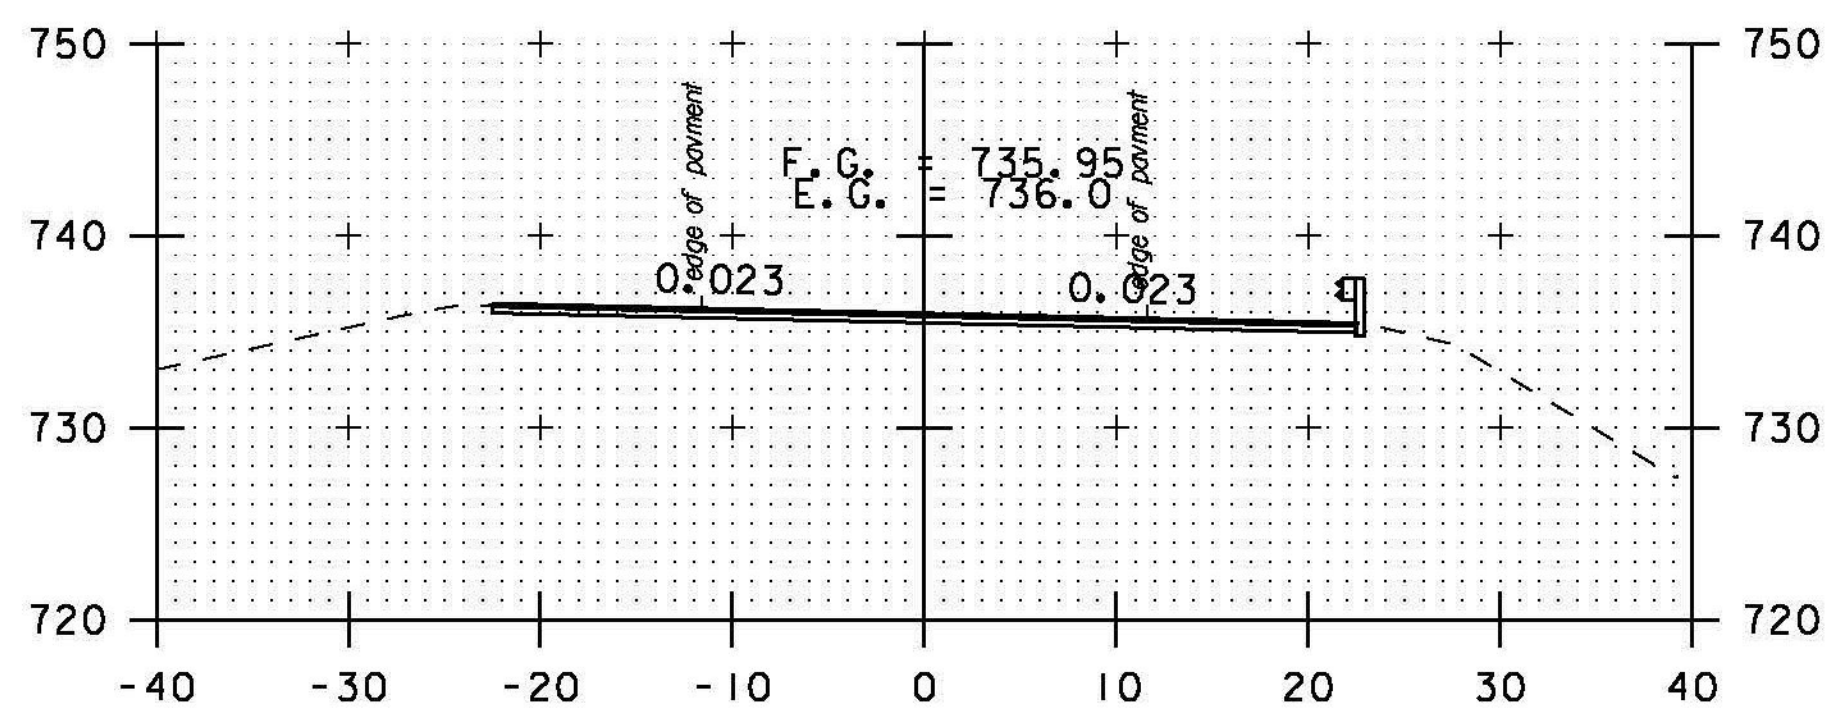


A 61+50

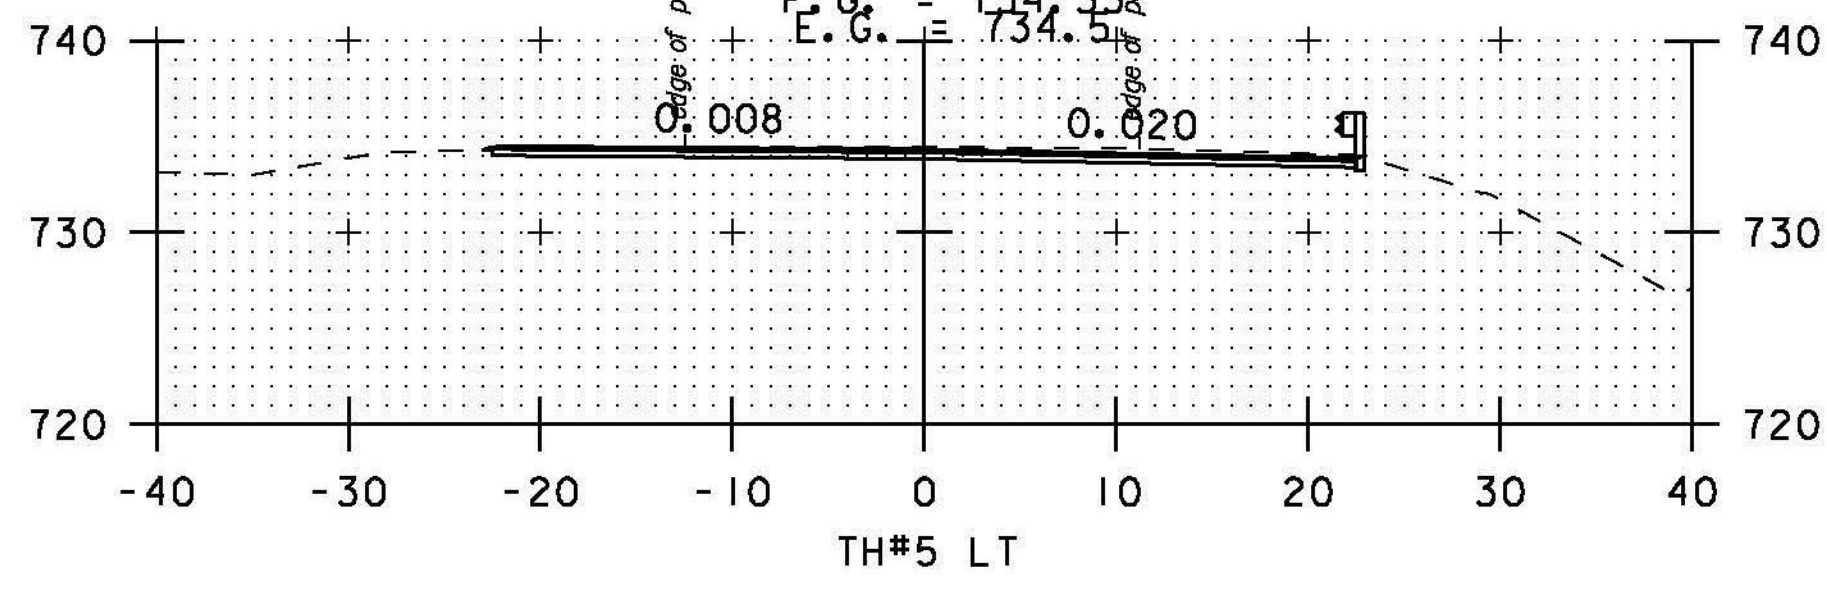


TH#5 LT
A 61+00

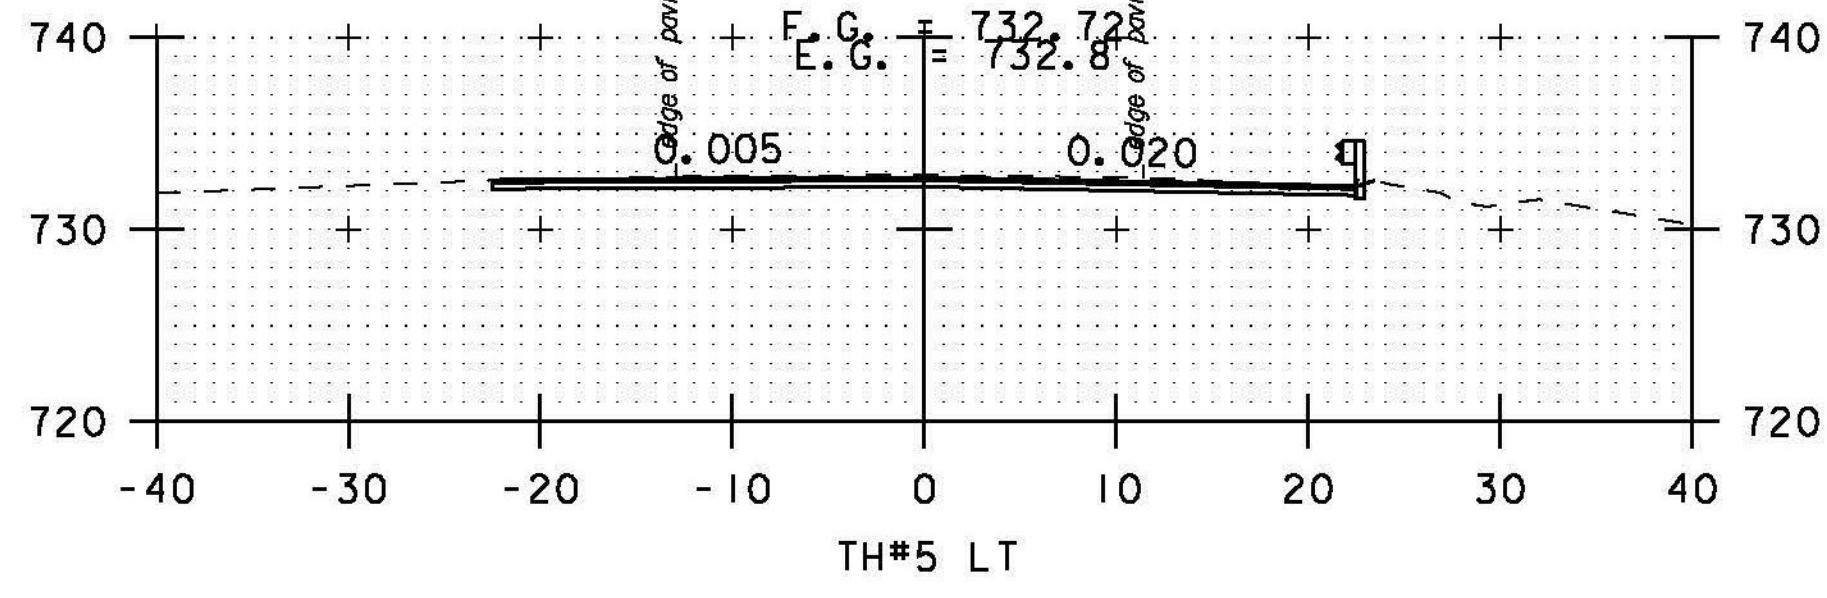


TH#5 LT
A 60+50

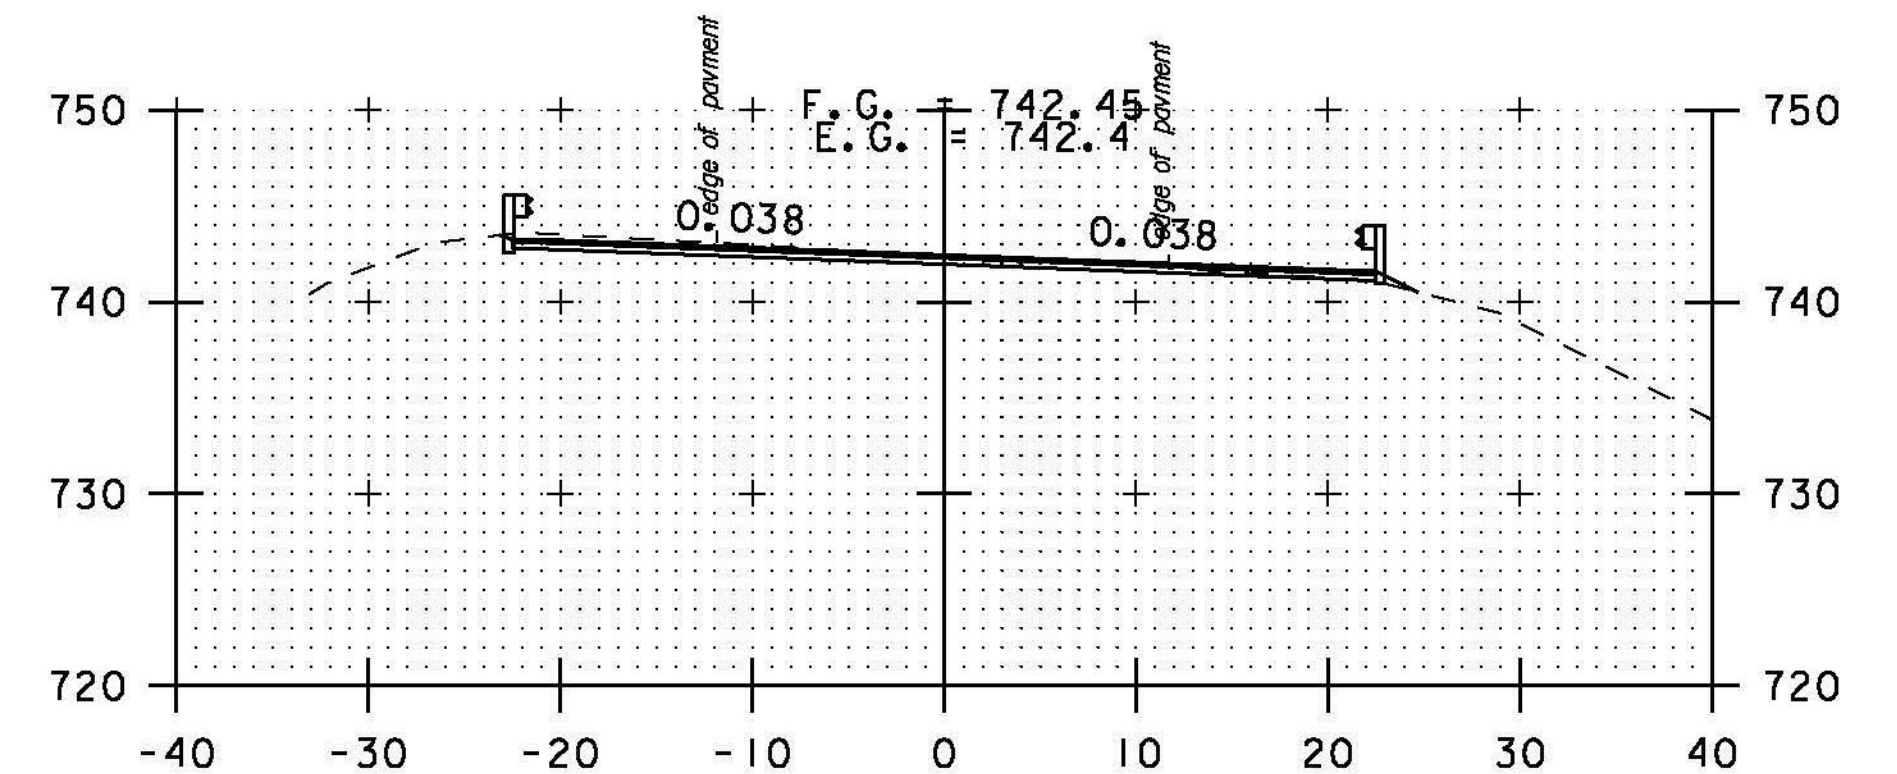

A 63+50

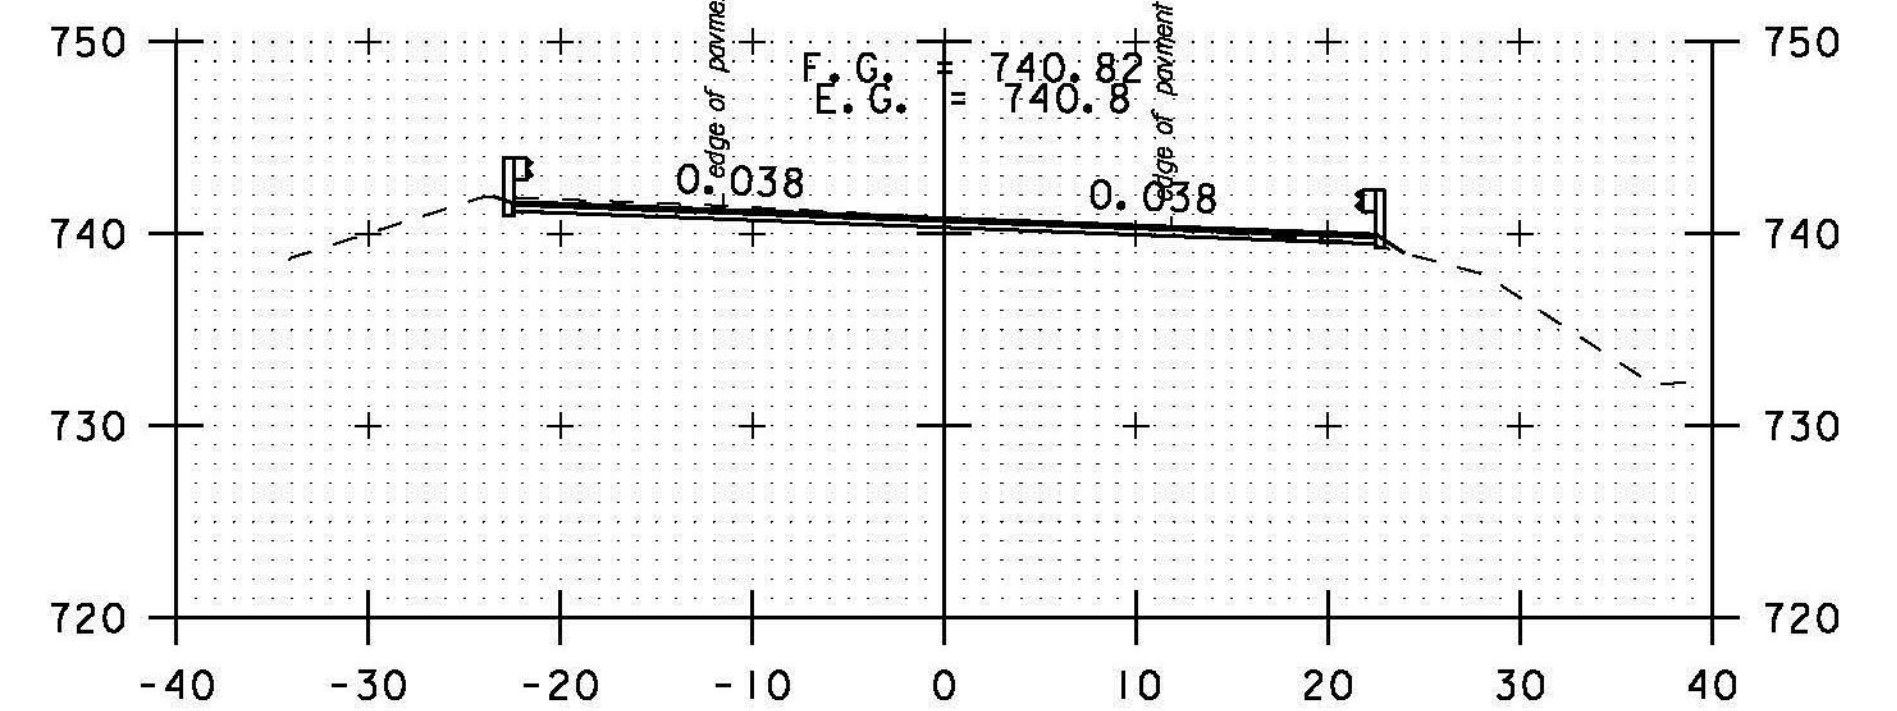


A 63+00

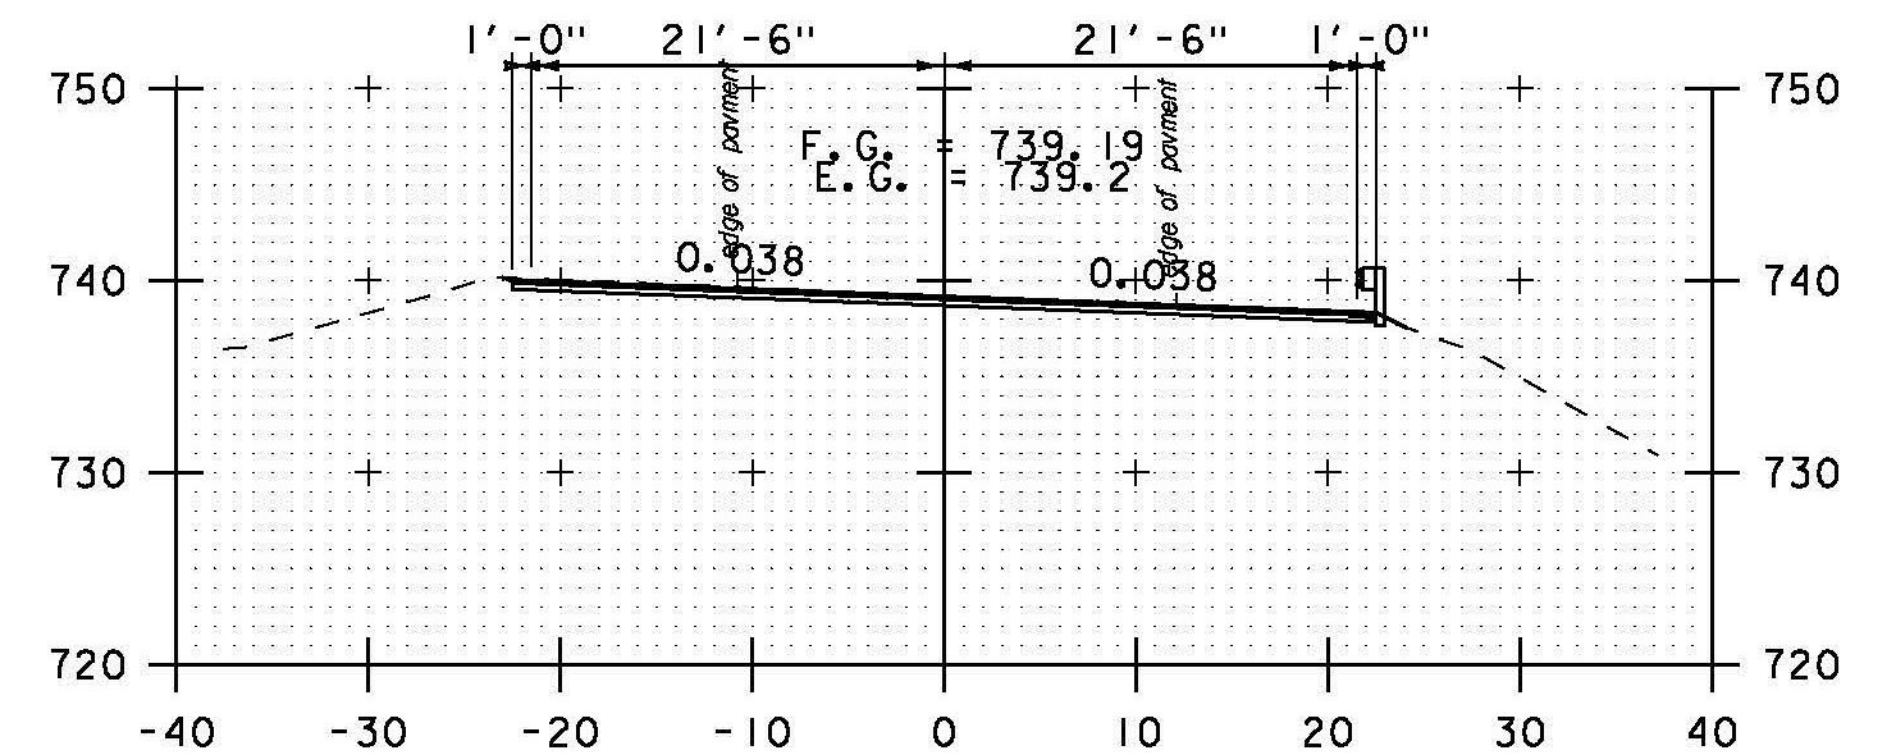

A 62+50

PROJECT NAME: BETHEL-RANDOLPH	
PROJECT NUMBER: STP 292(I)	
FILE NAME: piOC244.dgn	PLOT DATE: 4/23/2015
PROJECT LEADER: C. LATHROP	DRAWN BY: S. LAMPHERE
DESIGNED BY: S. LAMPHERE	CHECKED BY: C. LATHROP
CROSS SECTION SHEET 62	SHEET 196 OF 211

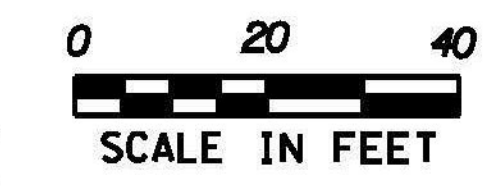

STA. A 58+50 TO STA. A 63+50