




A 65+00

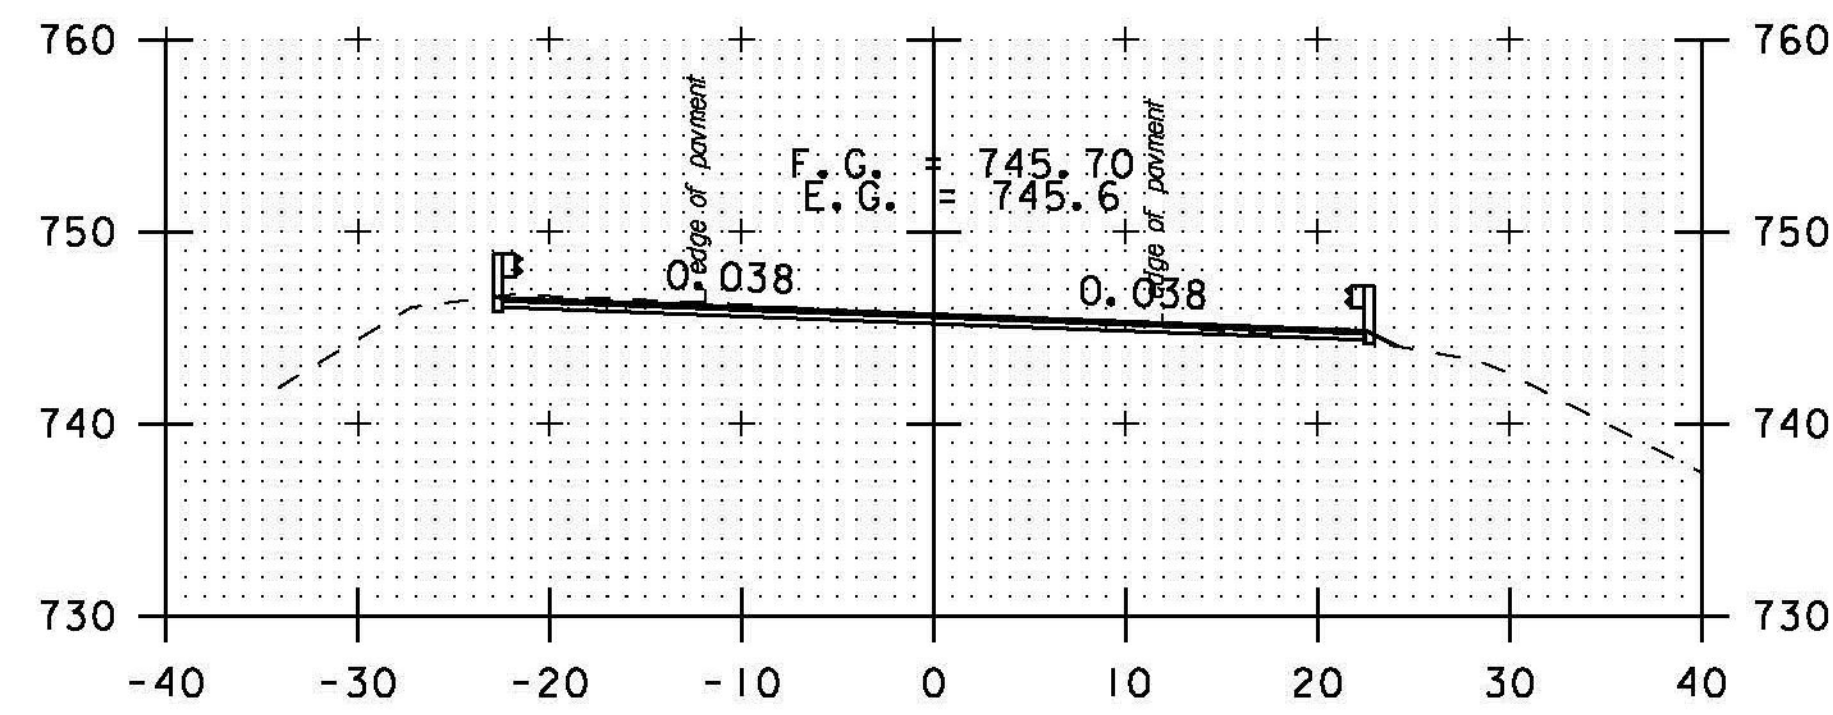


A 64+50

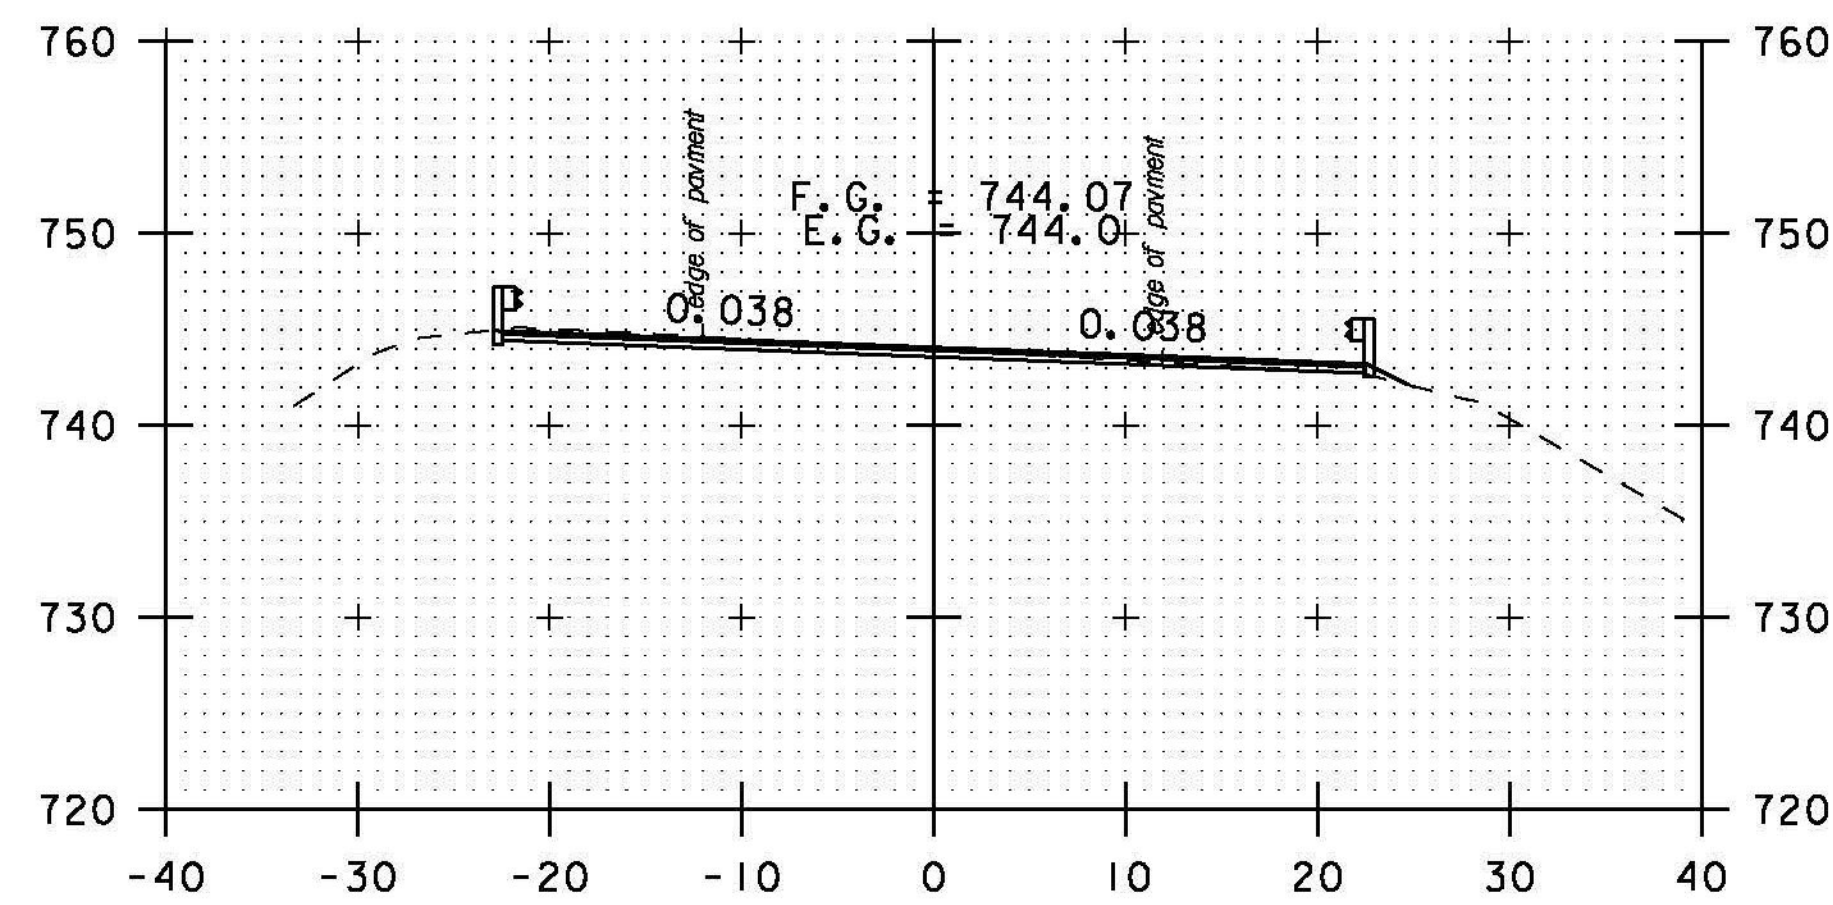


A 64+00

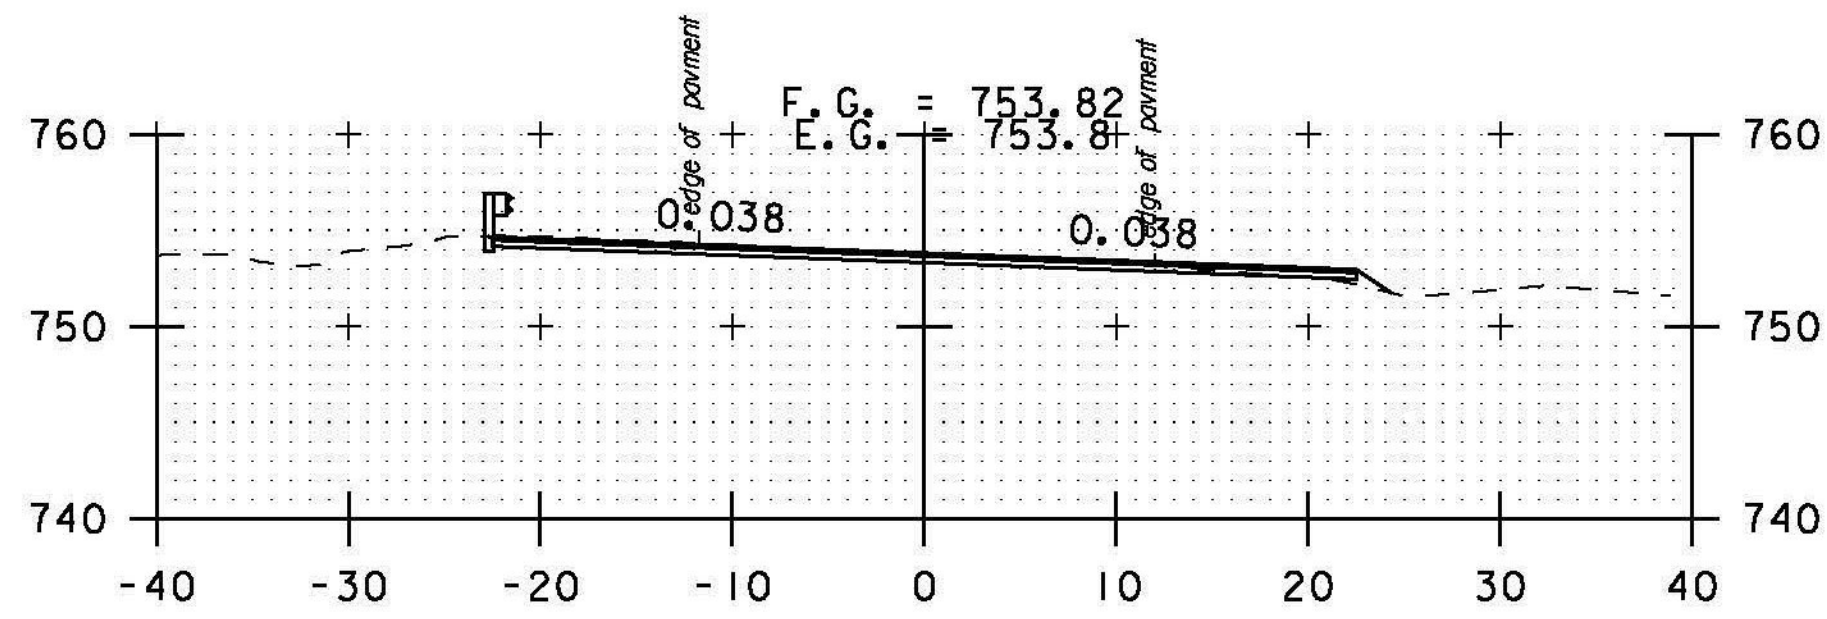


A 67+00

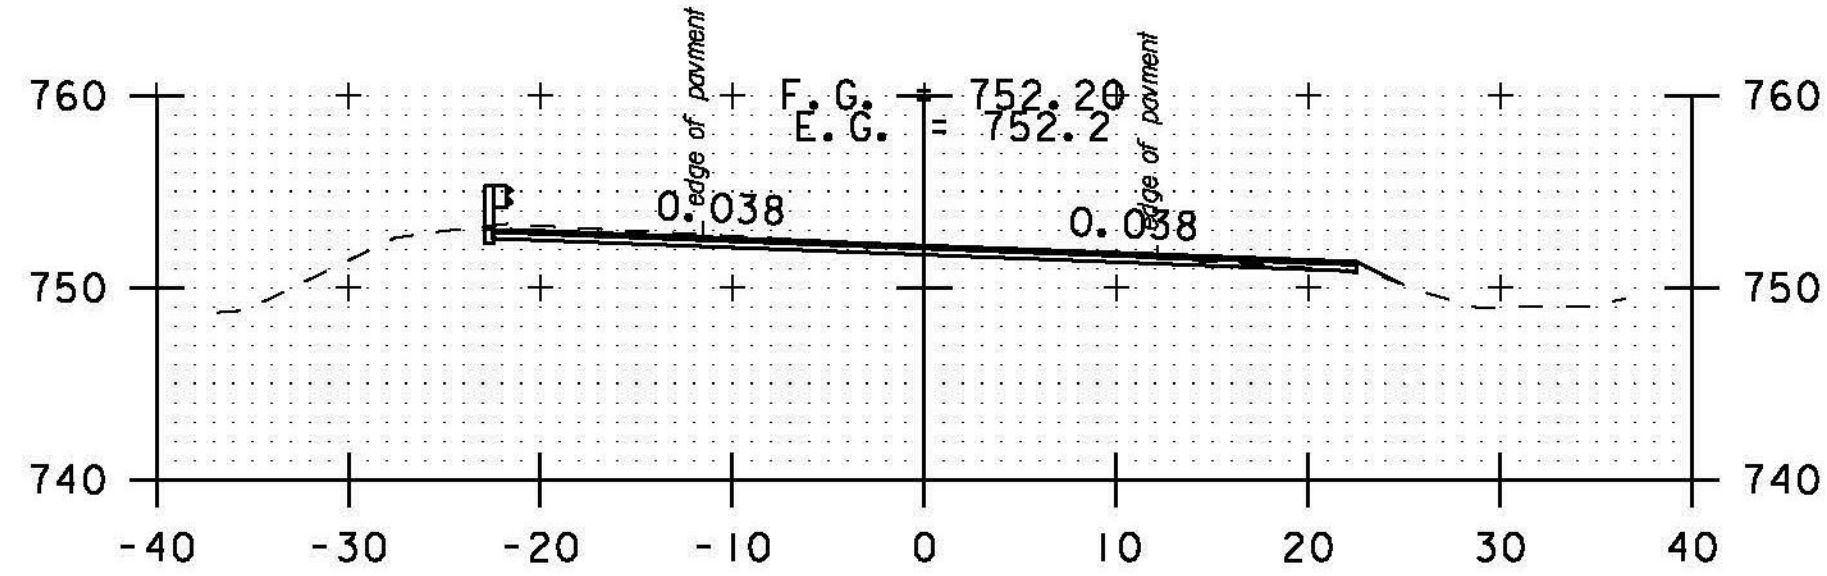


A 66+50

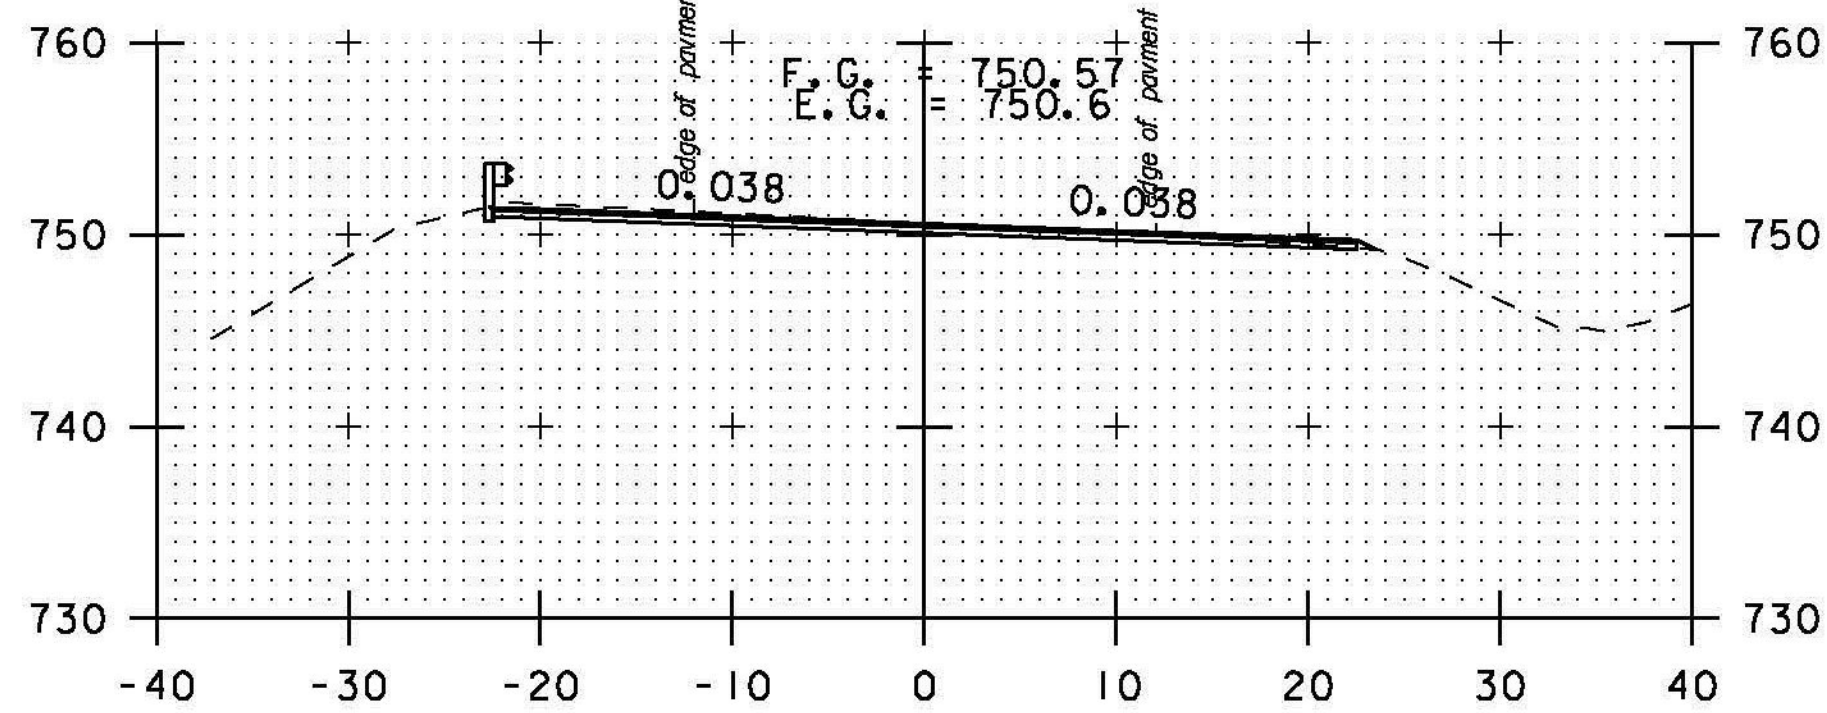


A 66+00

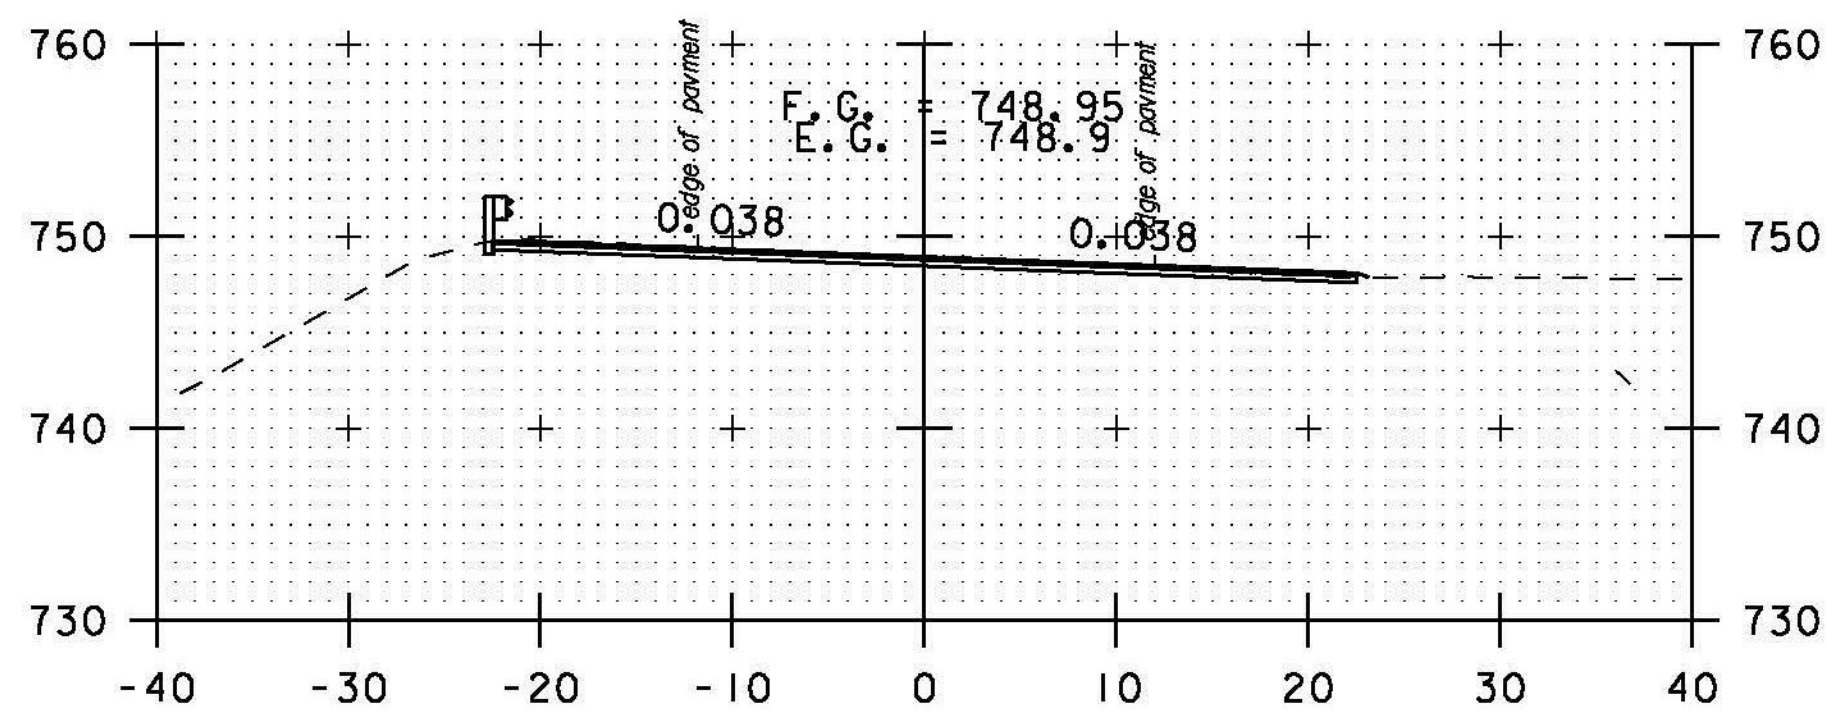


A 65+50

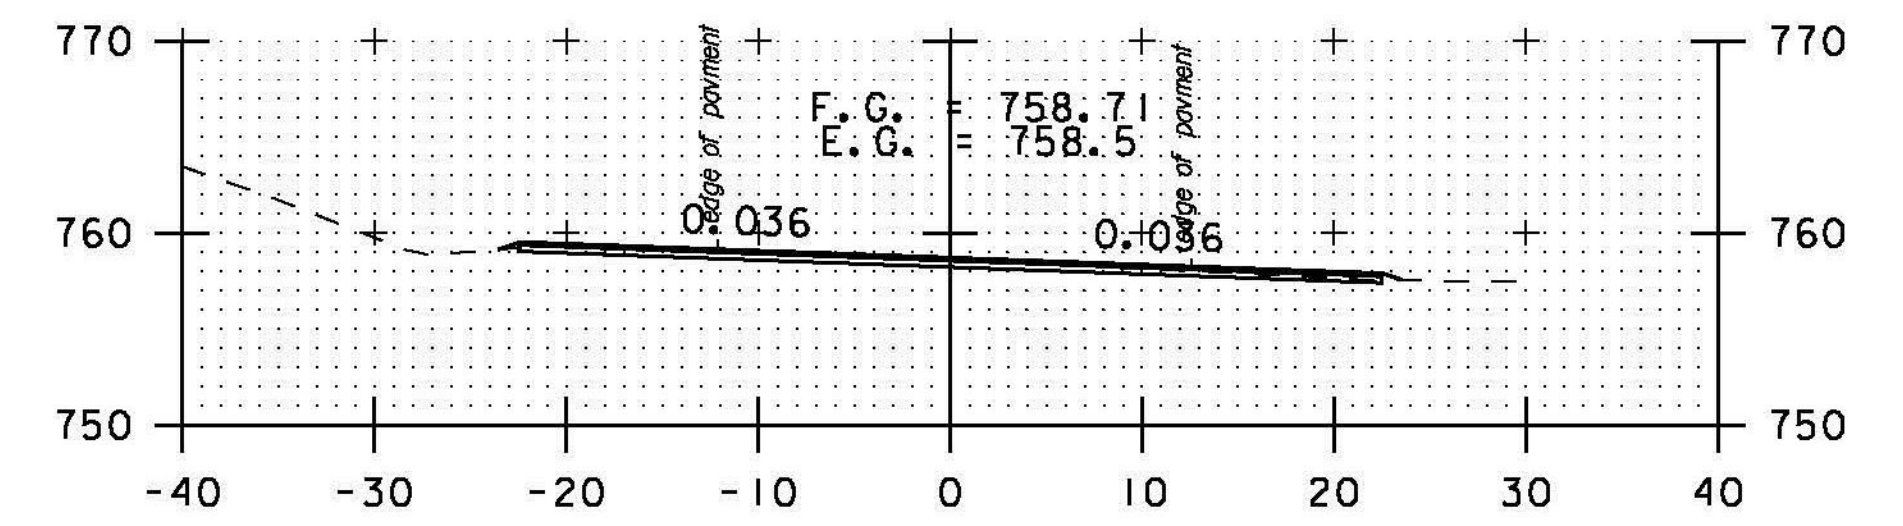


A 69+00

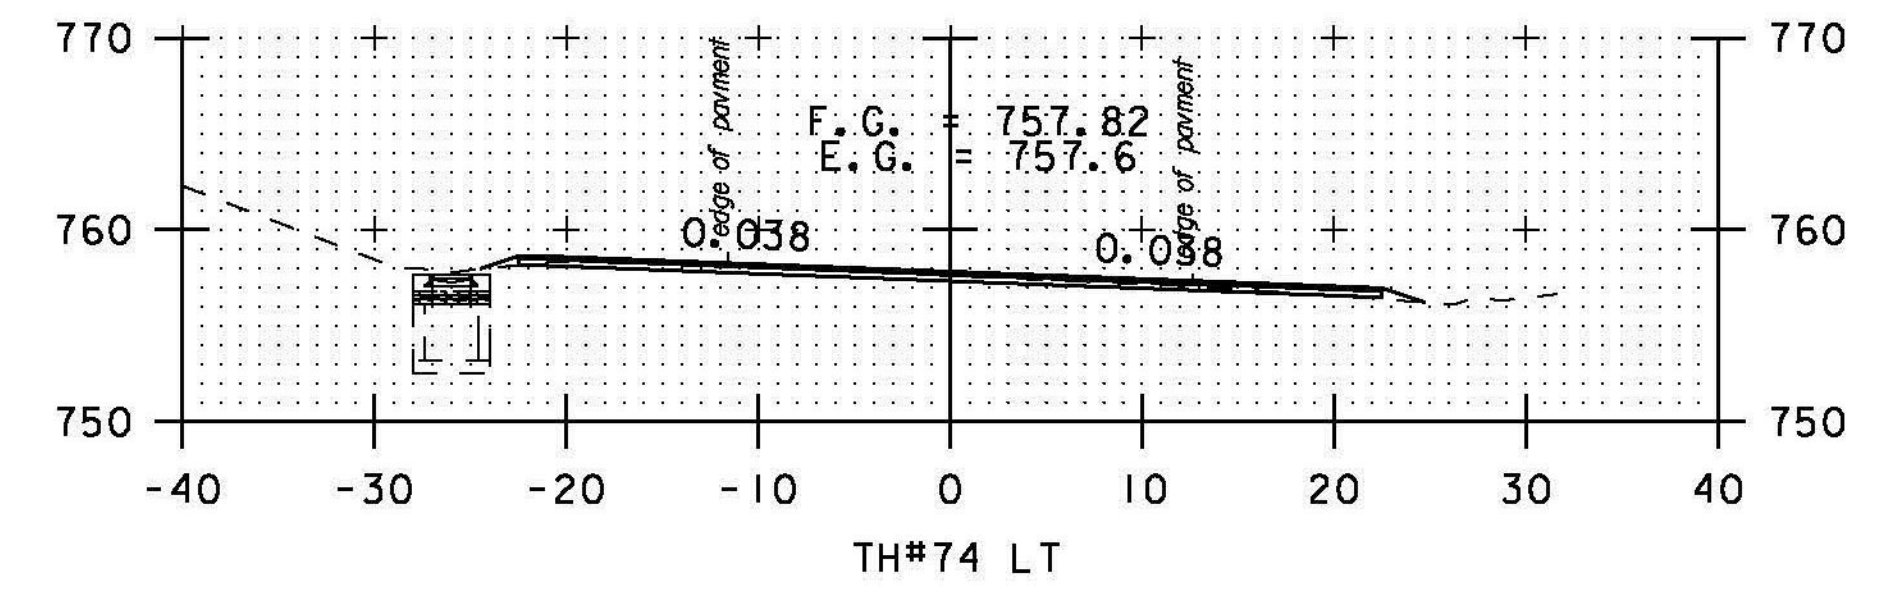

A 68+50

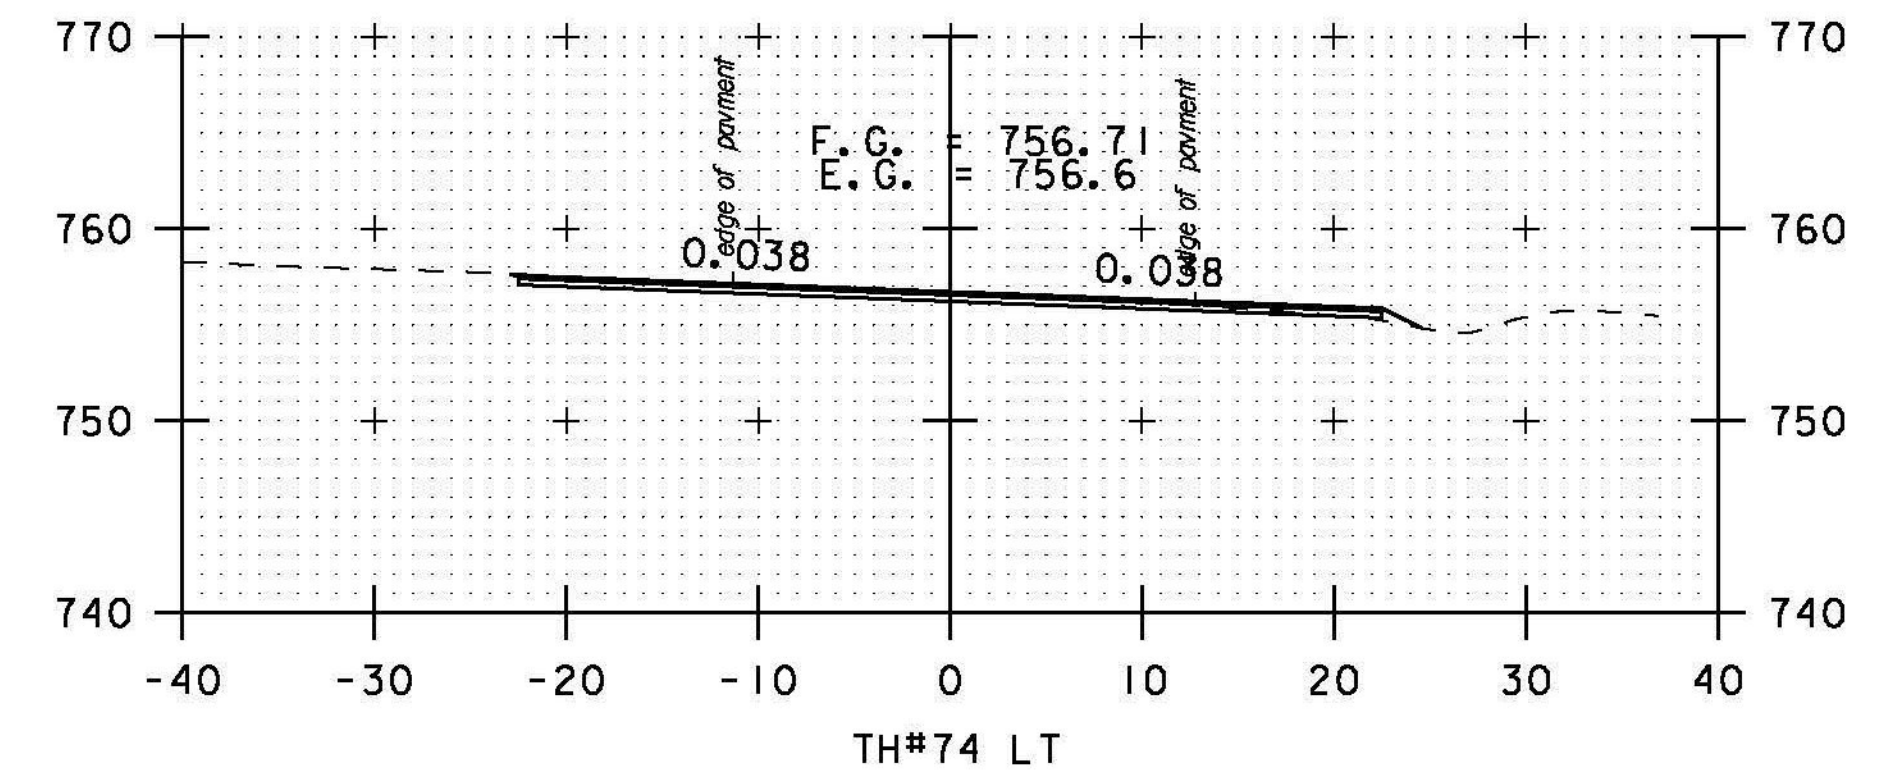


A 68+00

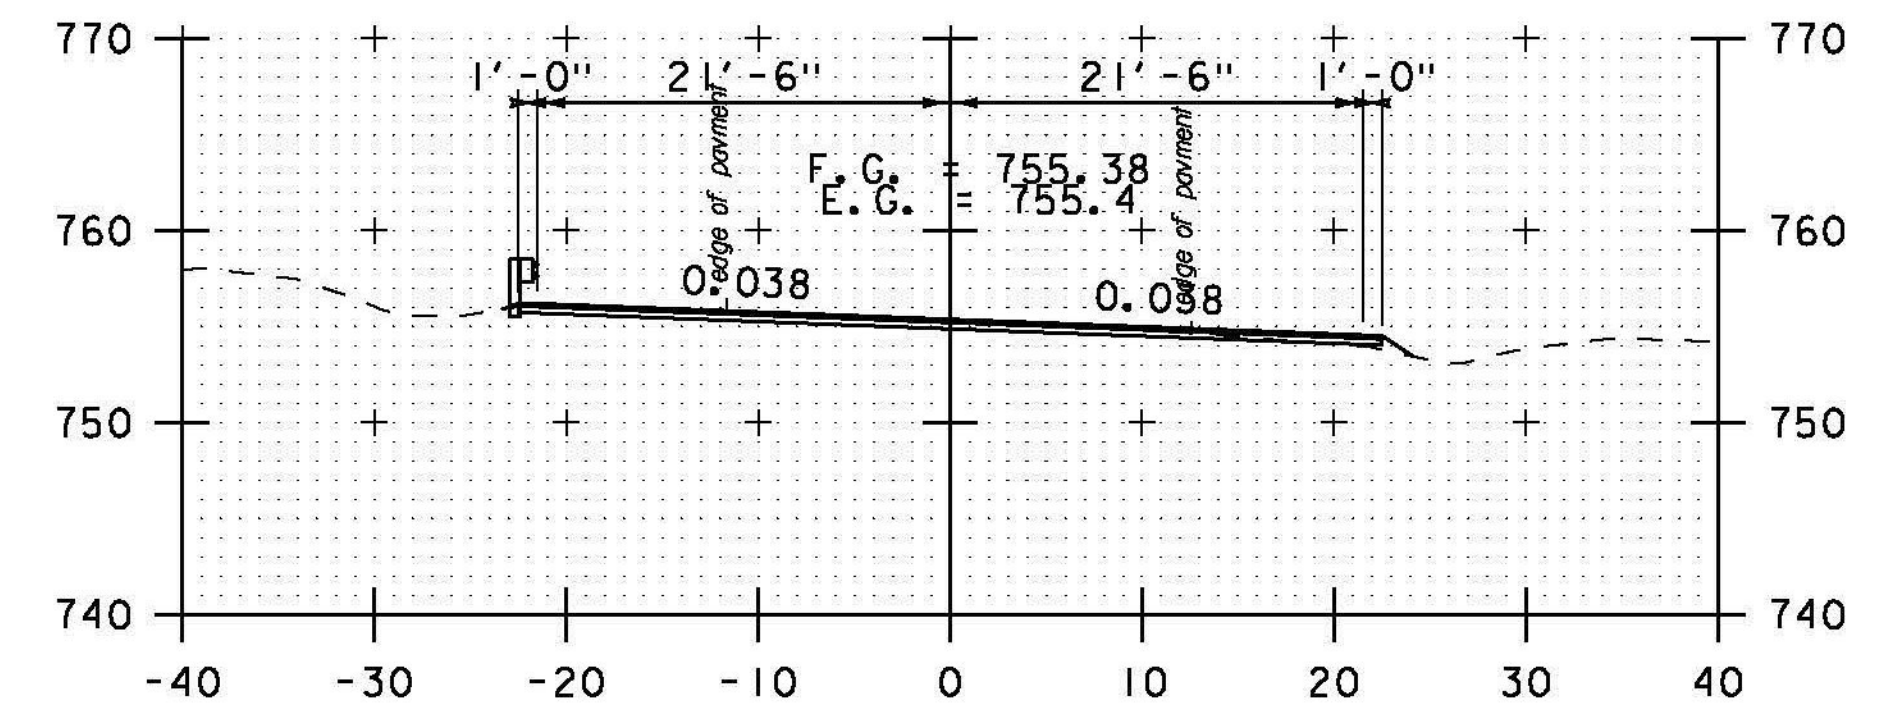

A 67+50

PROJECT NAME: BETHEL-RANDOLPH
 PROJECT NUMBER: STP 292(I)
 FILE NAME: piOC244.dgn
 PROJECT LEADER: C. LATHROP
 DESIGNED BY: S. LAMPHERE
 CROSS SECTION SHEET 63
 PLOT DATE: 4/23/2015
 DRAWN BY: S. LAMPHERE
 CHECKED BY: C. LATHROP
 SHEET 197 OF 211

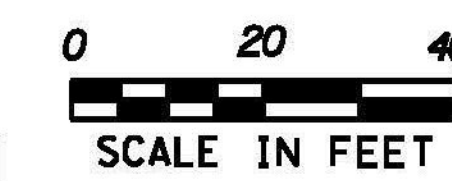

STA. A 64+00 TO STA. A 69+00

DRIVE RT