




A 71+00

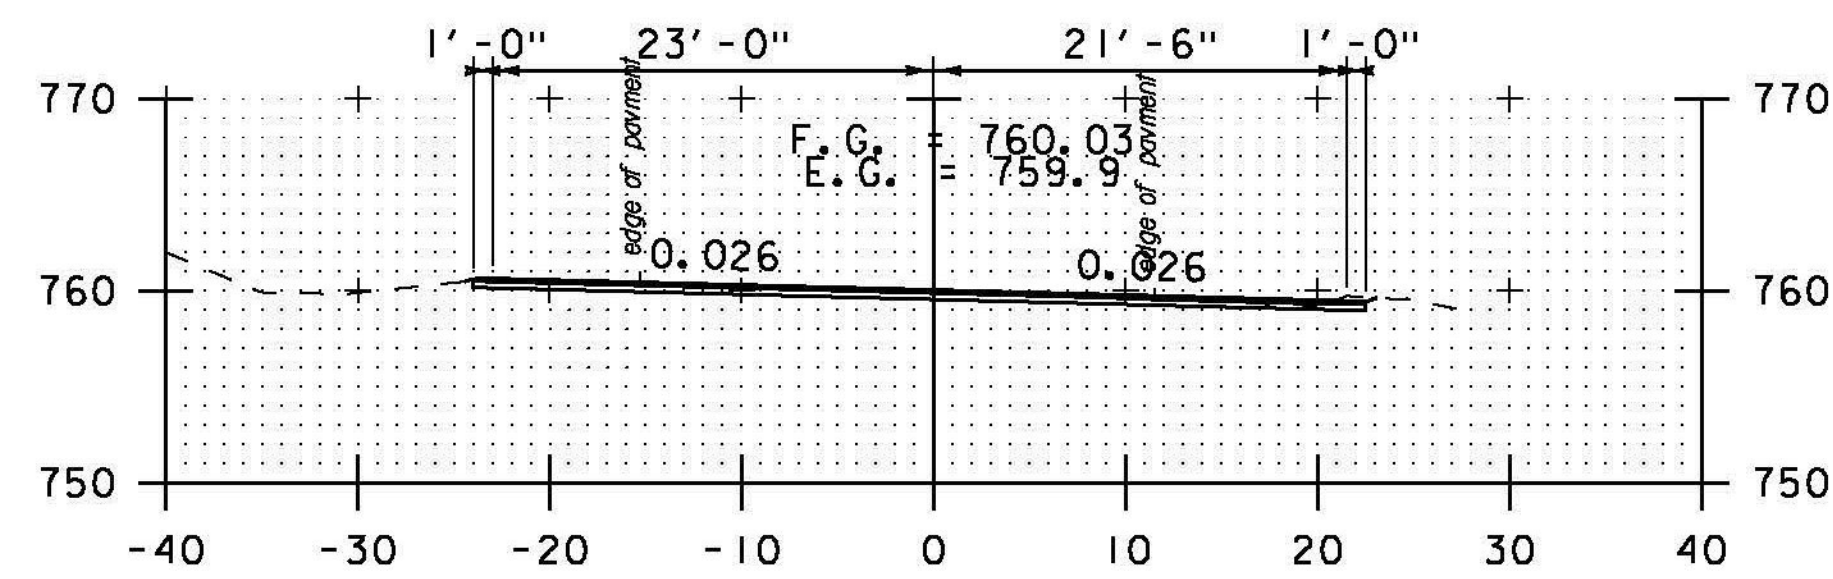


A 70+50

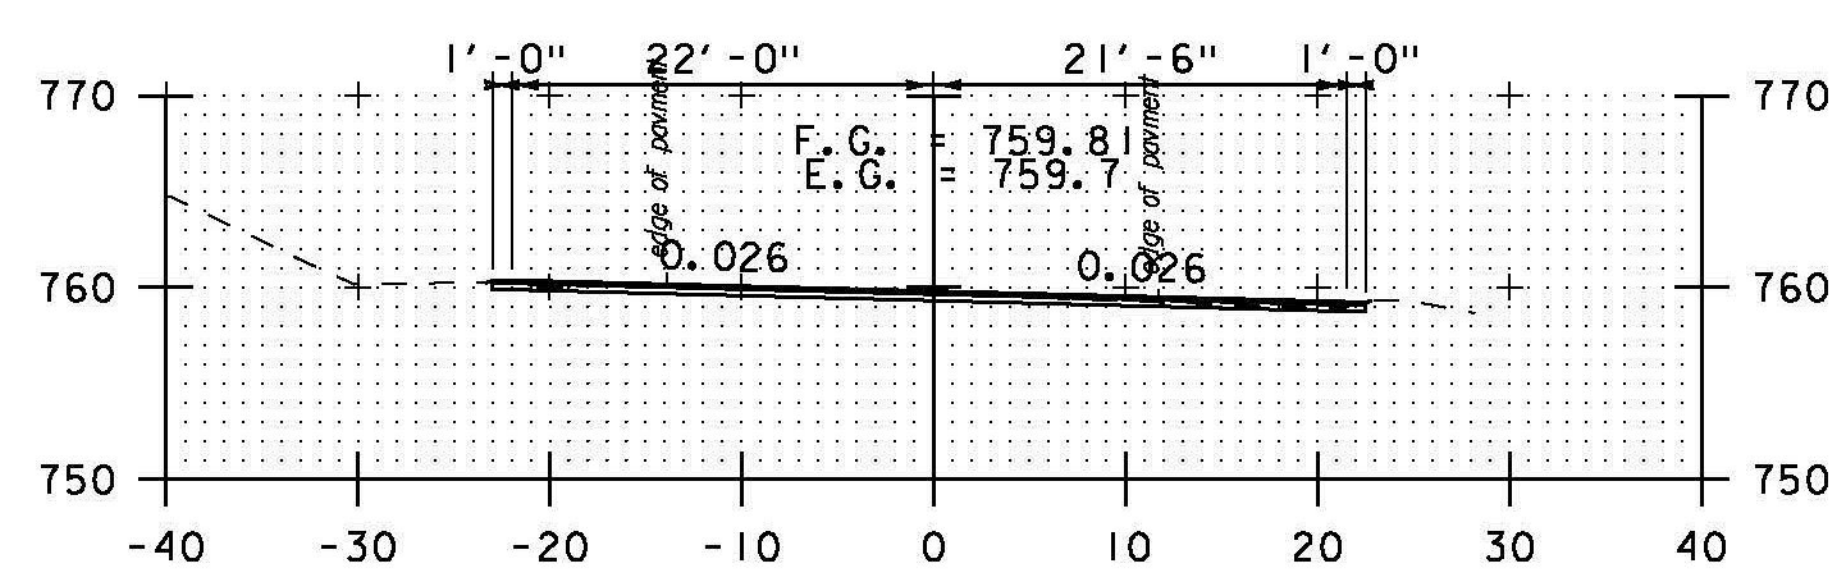


A 70+00

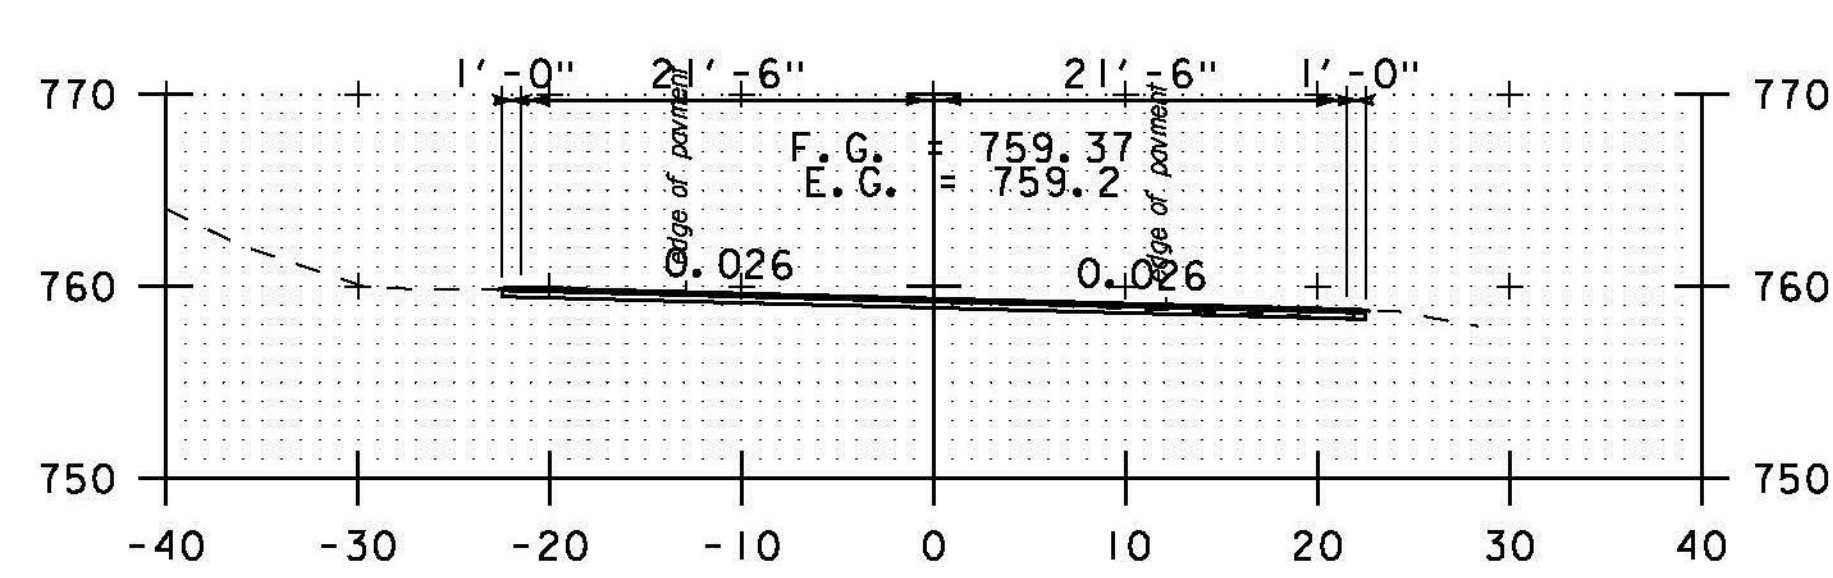


A 69+50

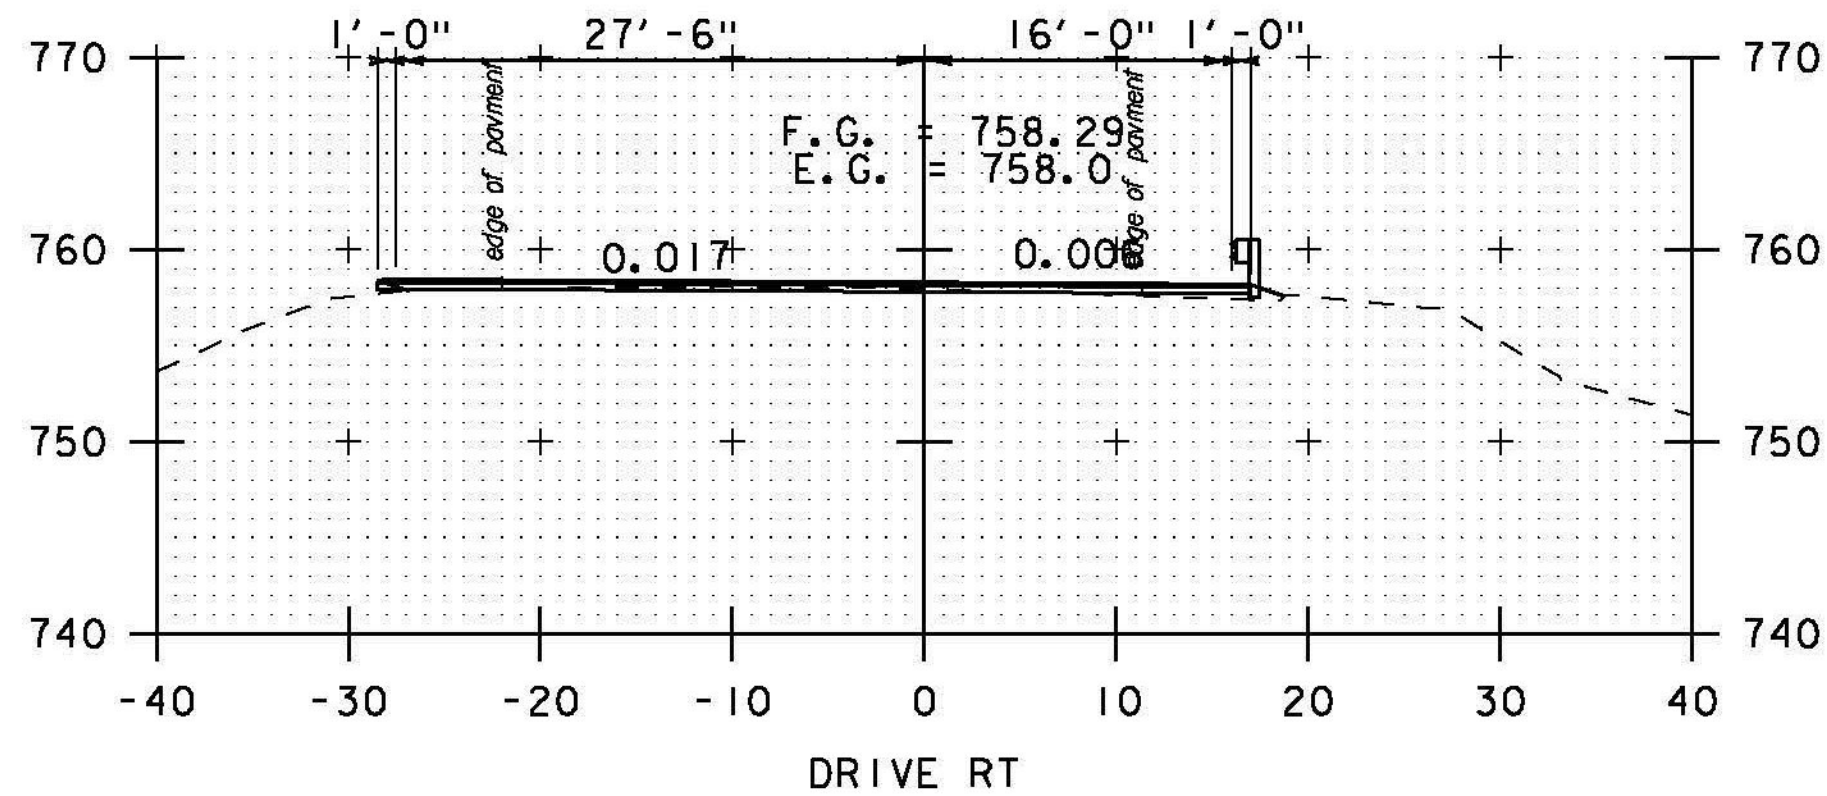


A 73+00

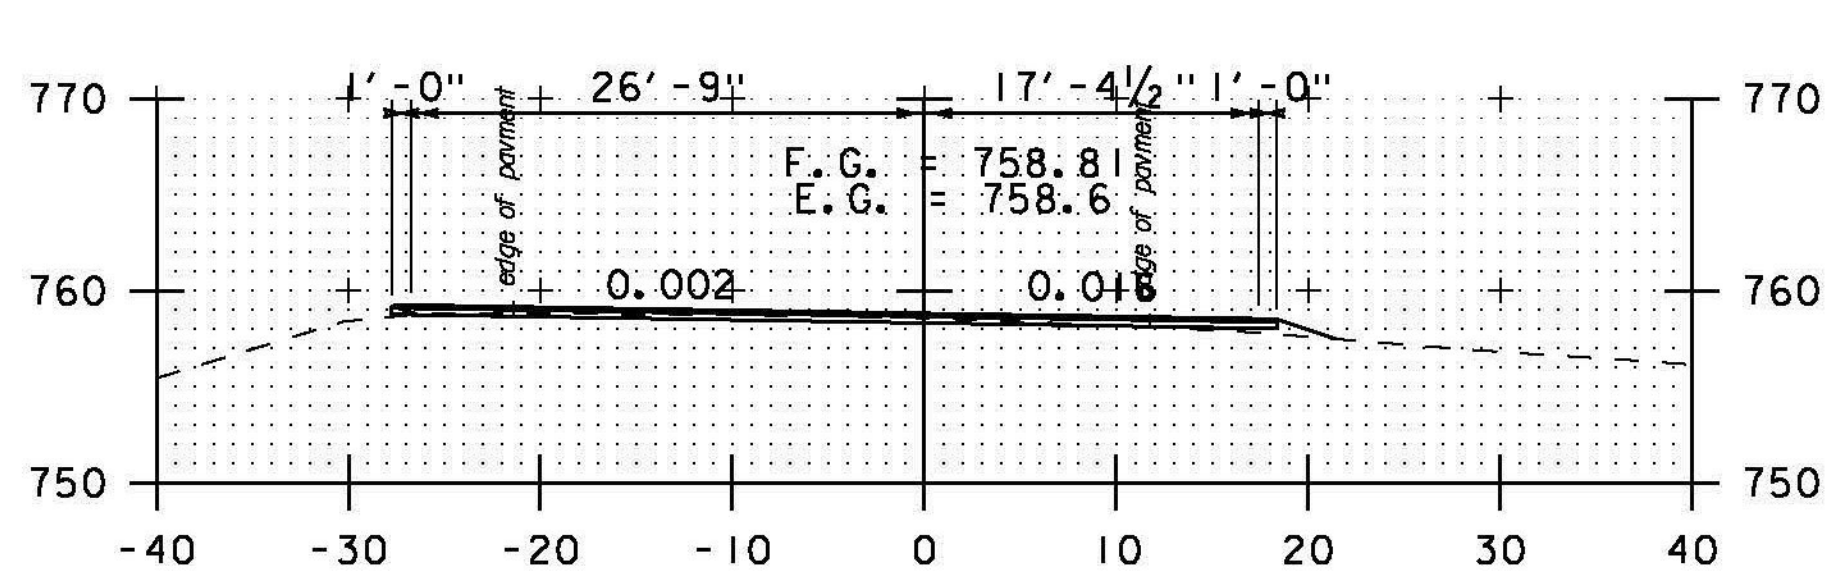


A 72+50

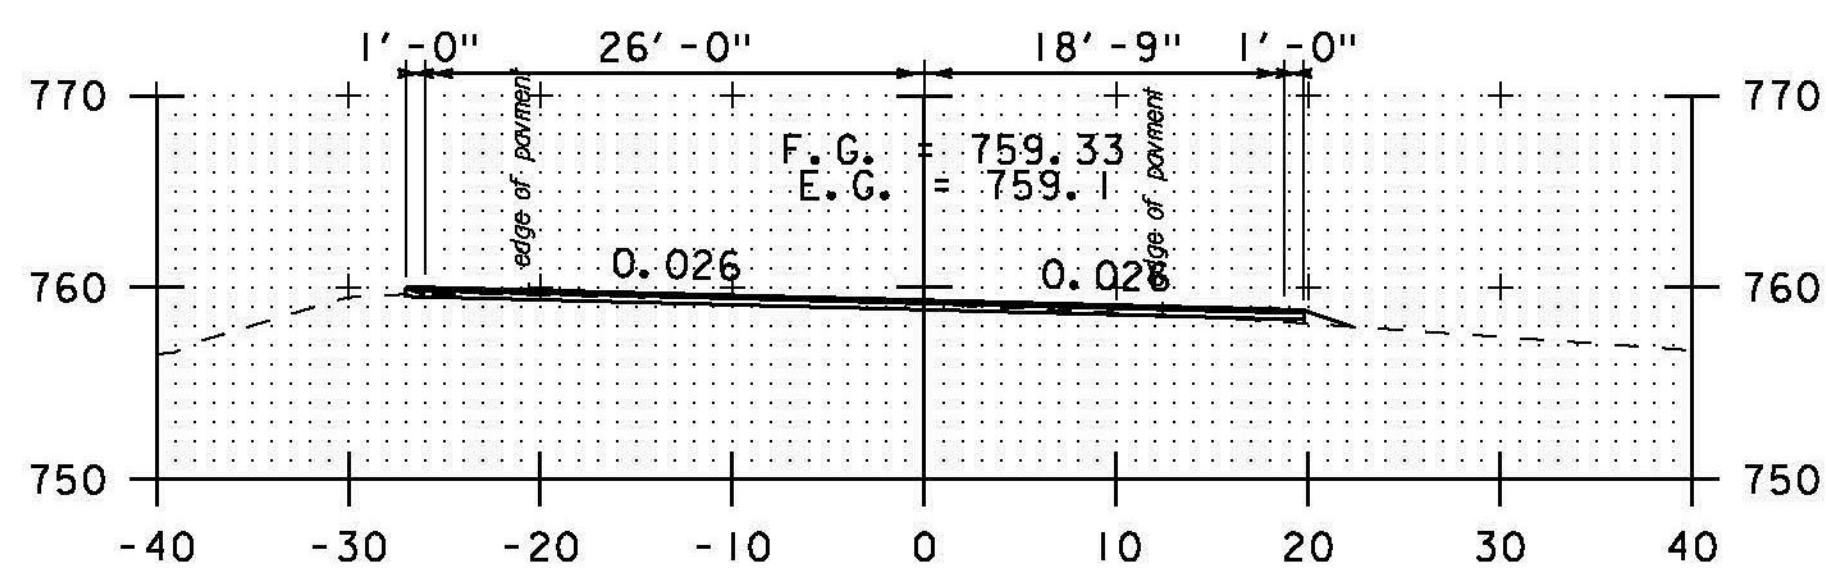


A 72+00

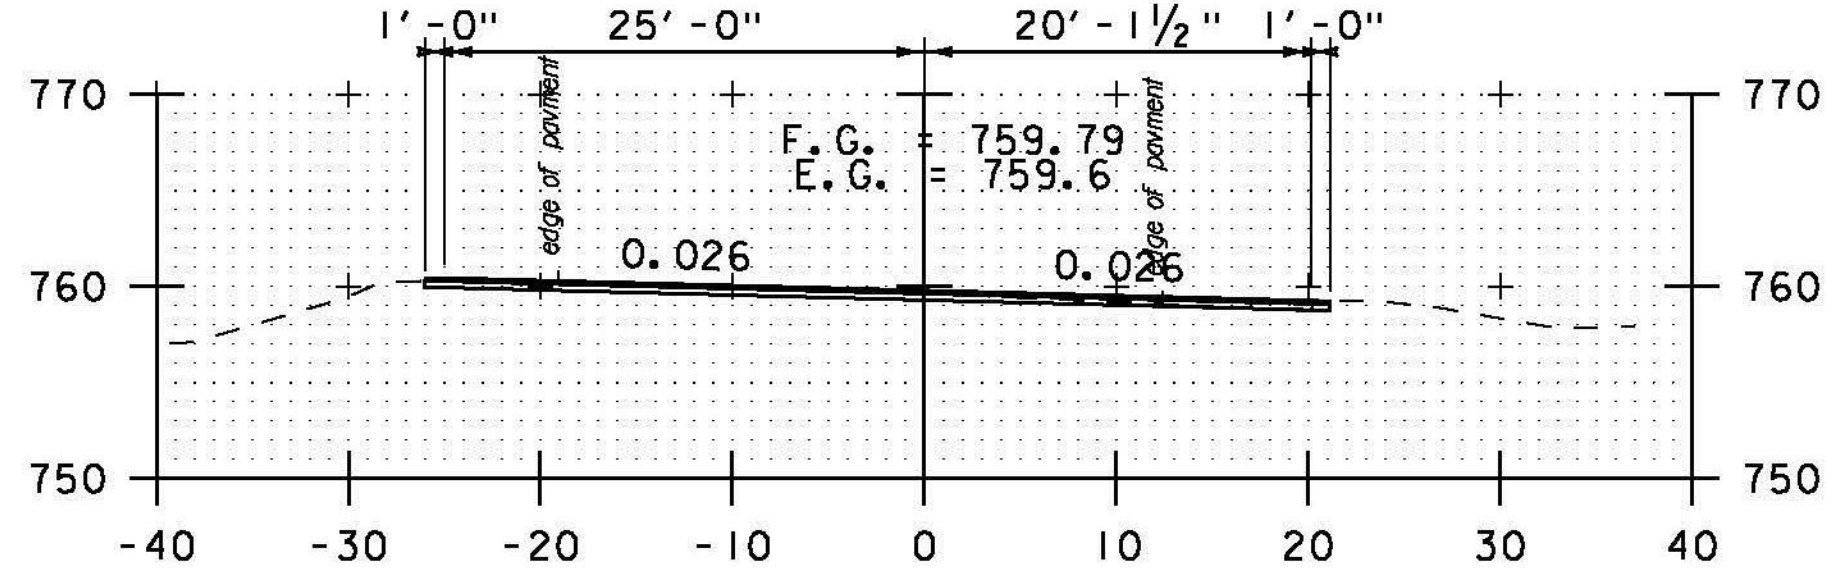


A 71+50

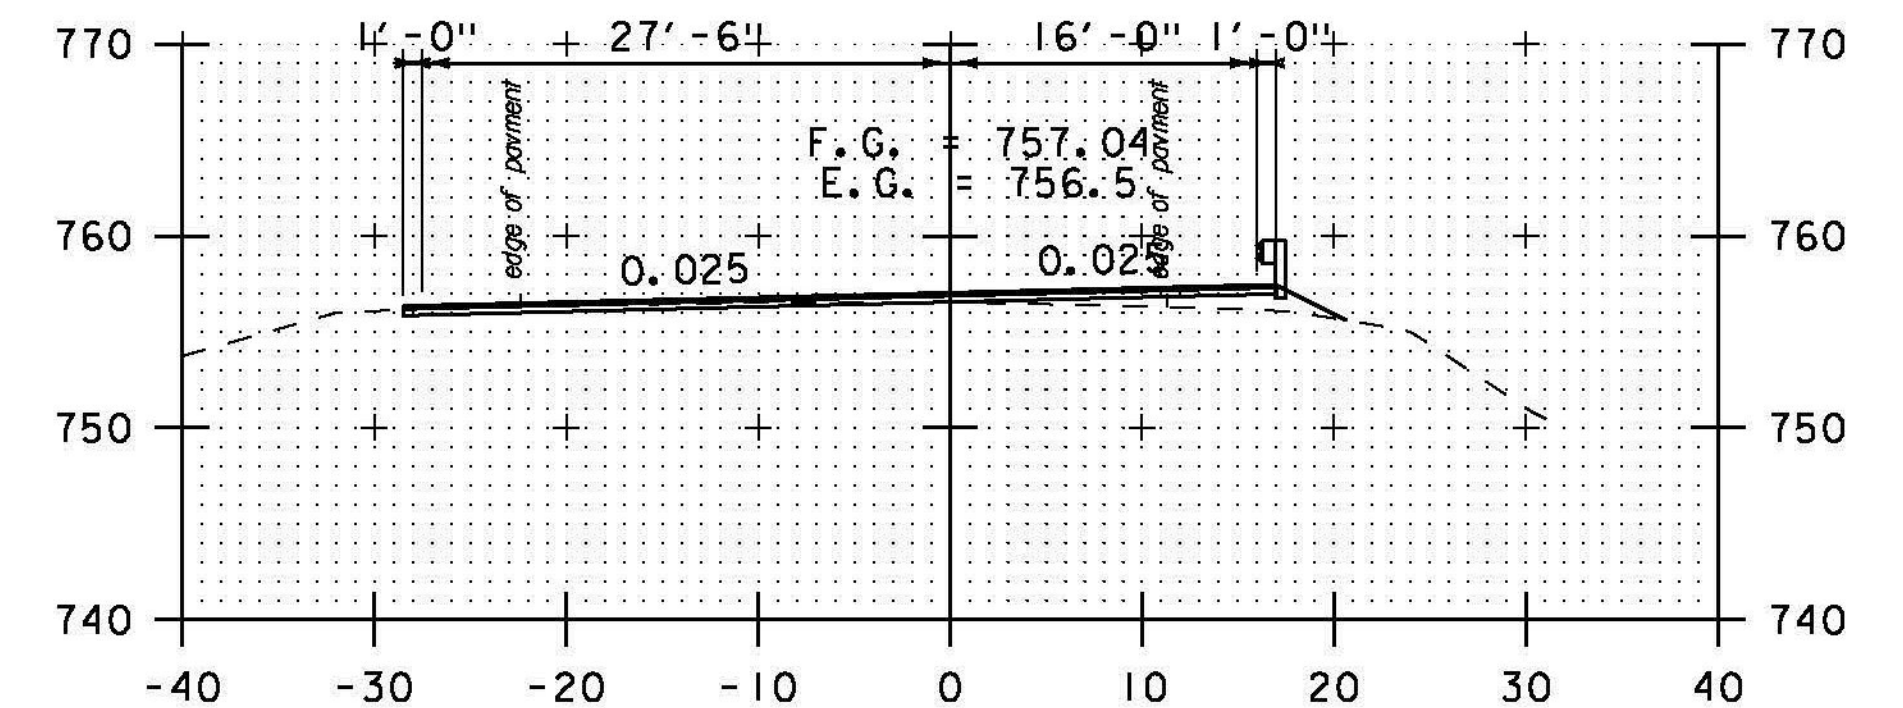

A 74+50

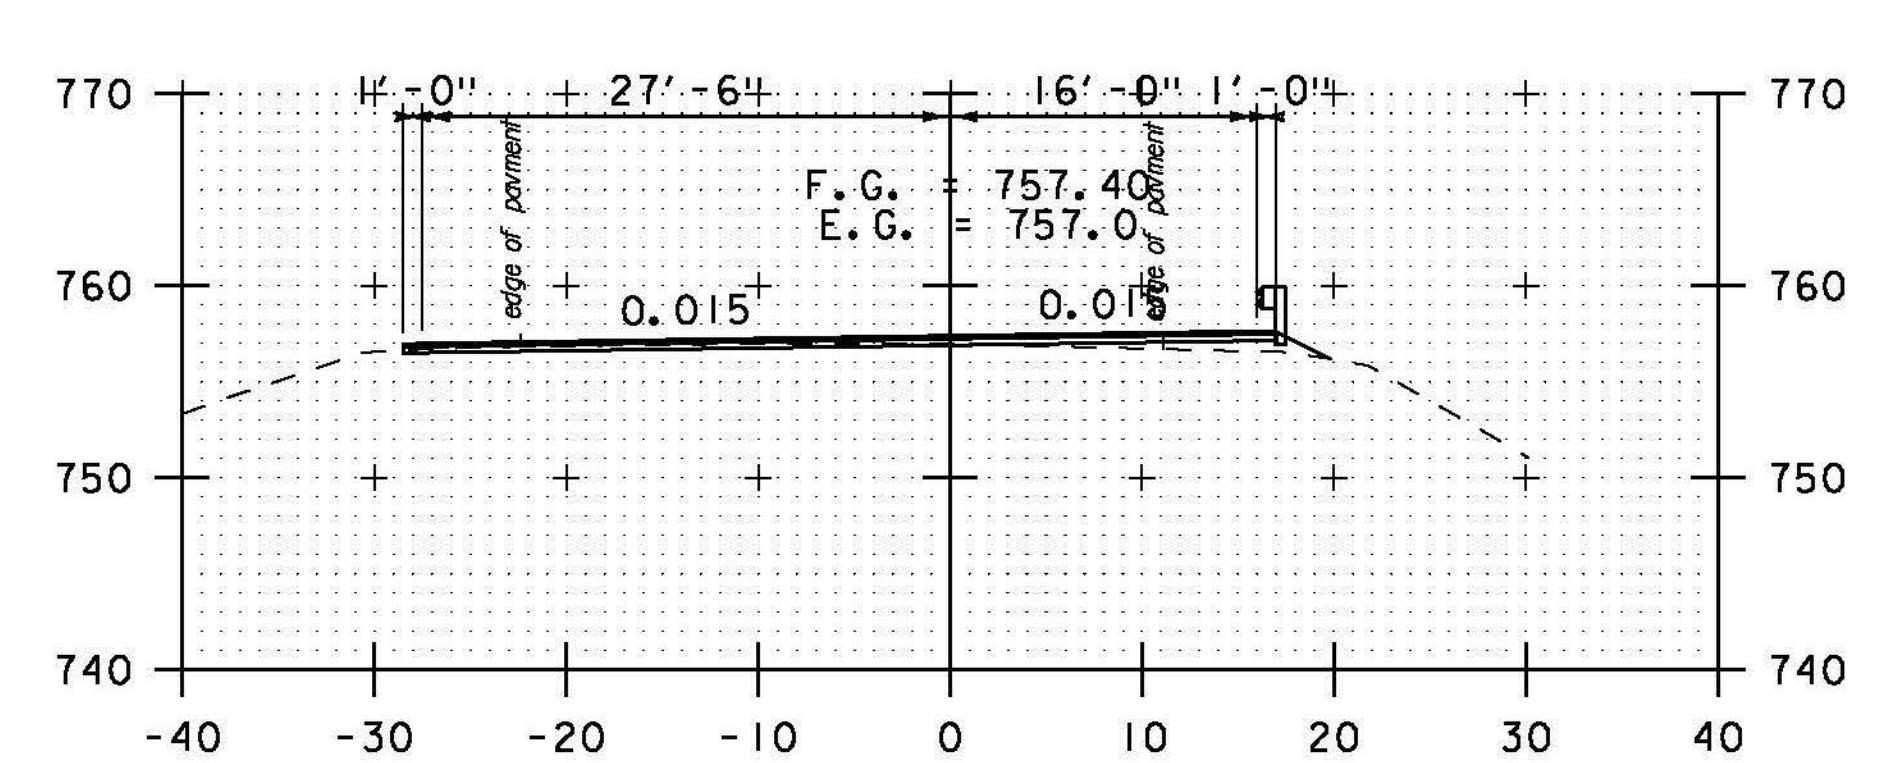


A 74+00

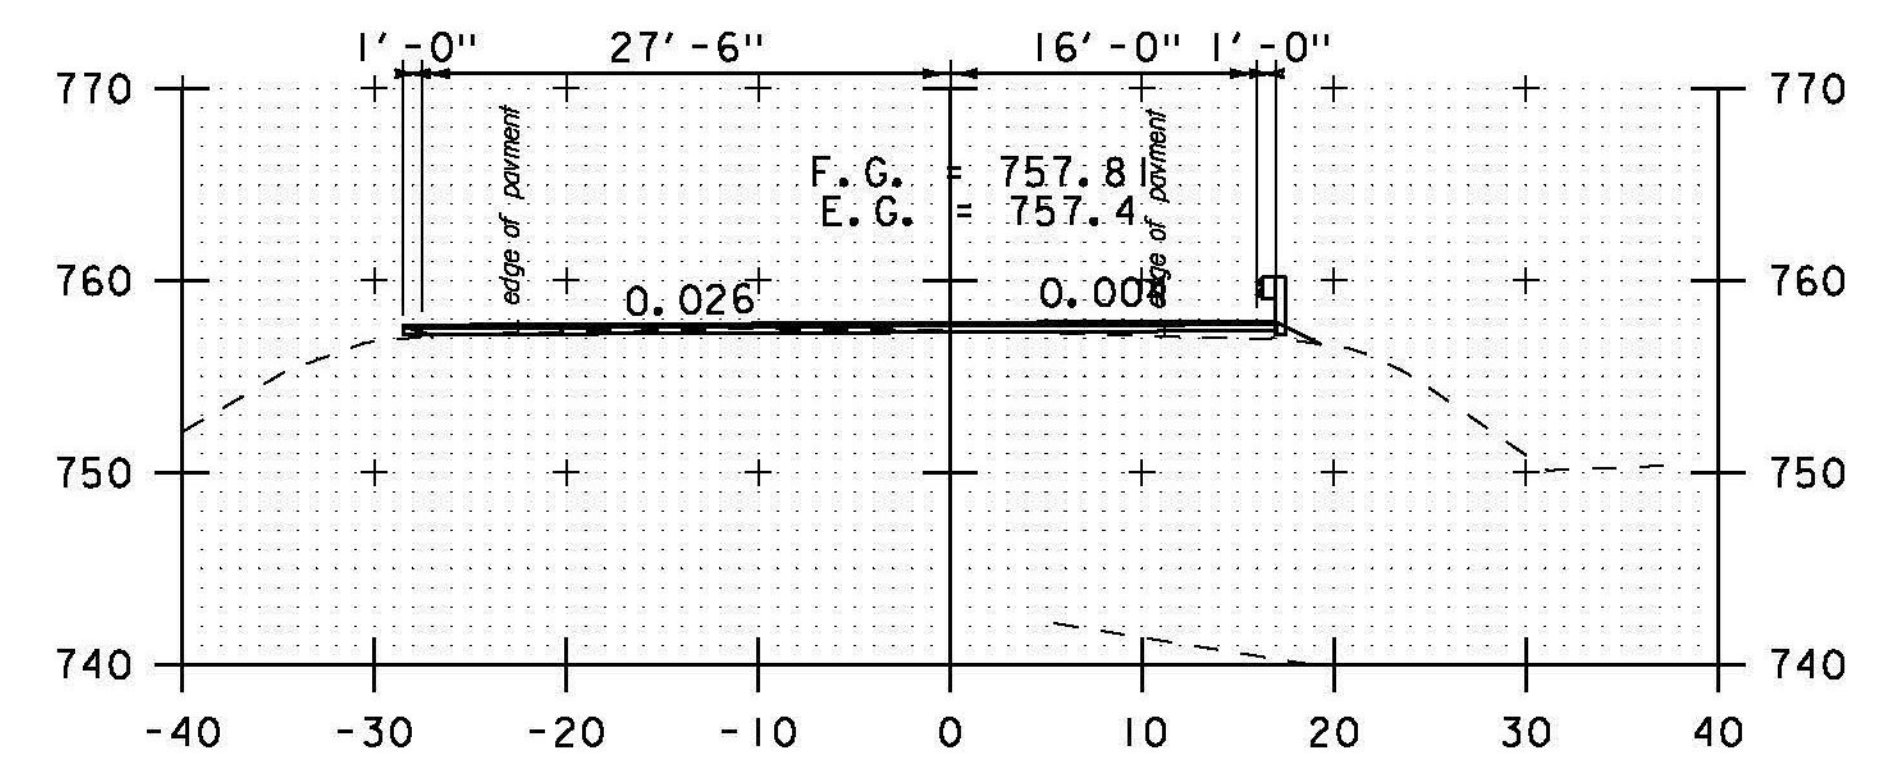

A 73+50

STA. A 69+50 TO STA. A 74+50

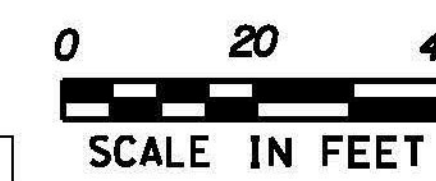

SCALE IN FEET

PROJECT NAME: BETHEL-RANDOLPH
PROJECT NUMBER: STP 292(I)

FILE NAME: piOC244.dgn
PROJECT LEADER: C. LATHROP
DESIGNED BY: S. LAMPHERE
CROSS SECTION SHEET 64

PLOT DATE: 4/23/2015
DRAWN BY: S. LAMPHERE
CHECKED BY: C. LATHROP
SHEET 198 OF 211