




A 76+00

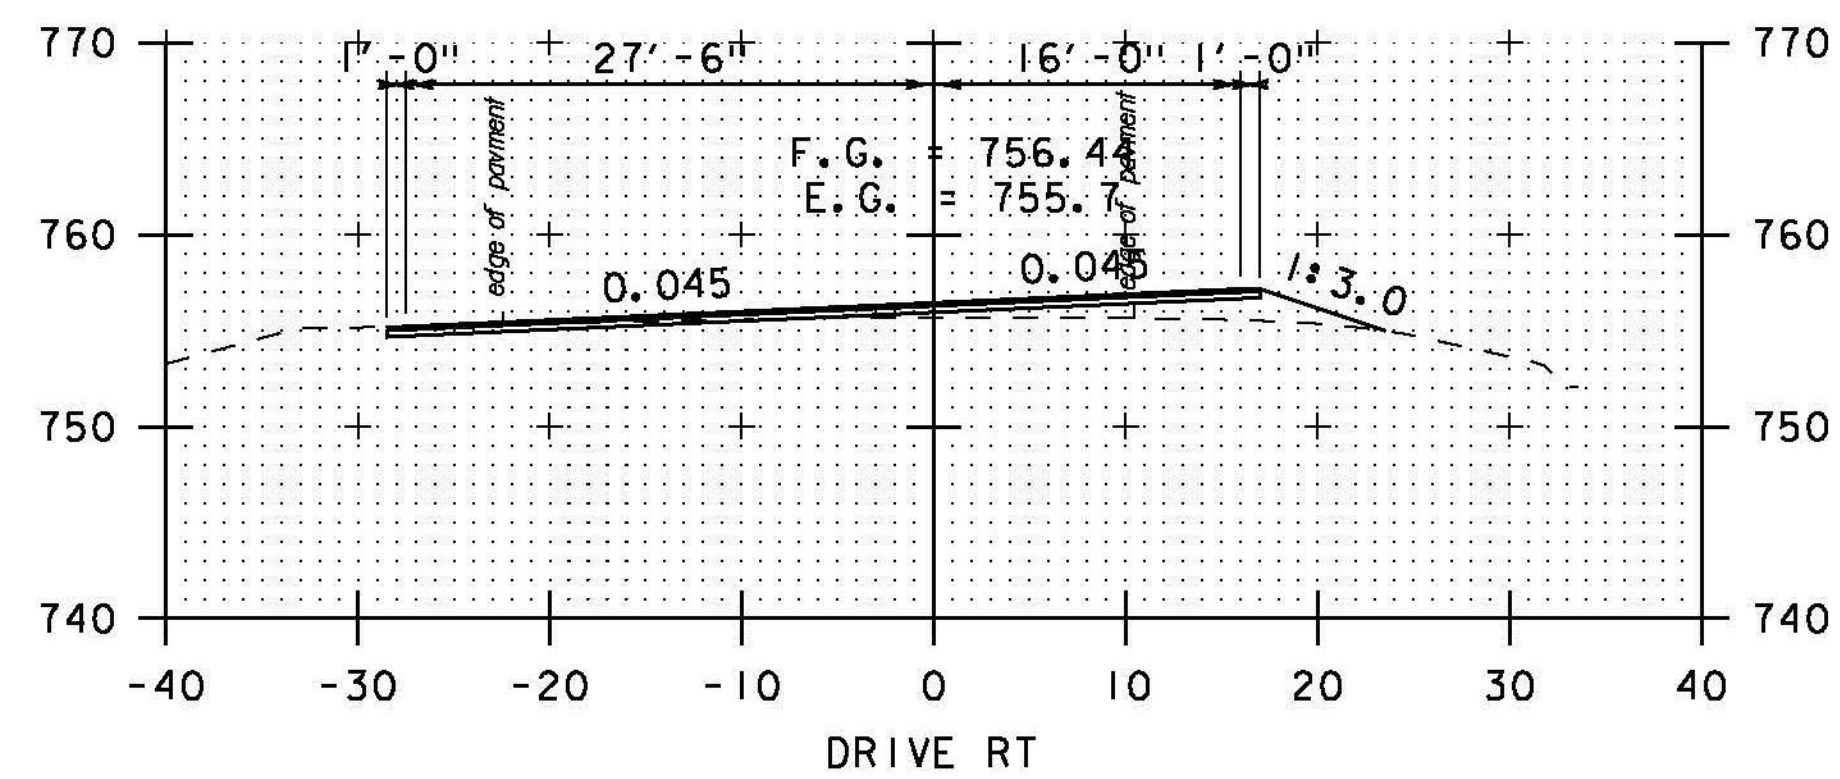


A 75+50

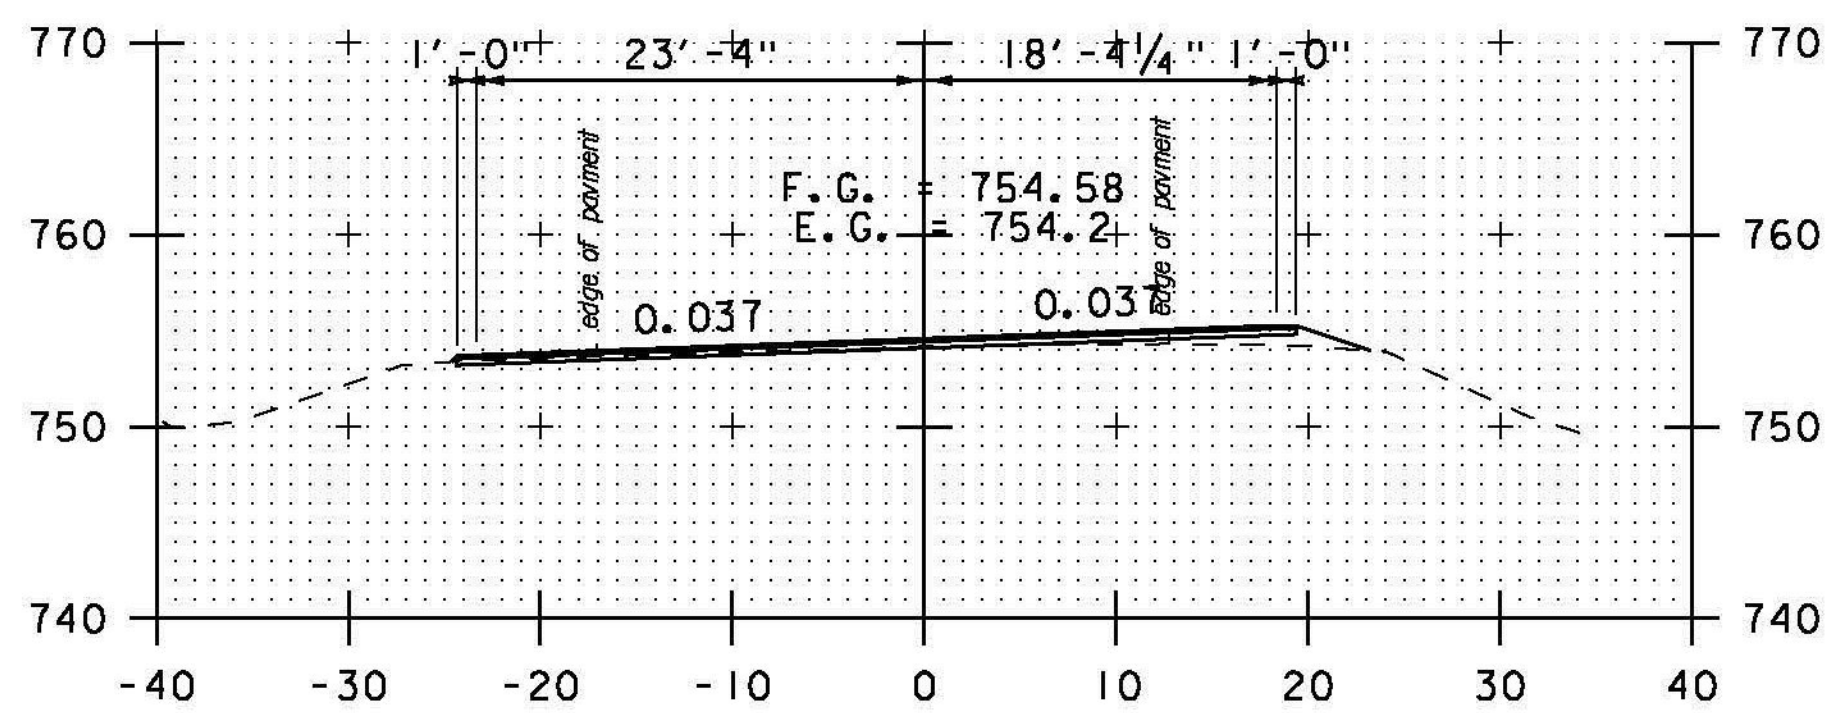

A 77+00

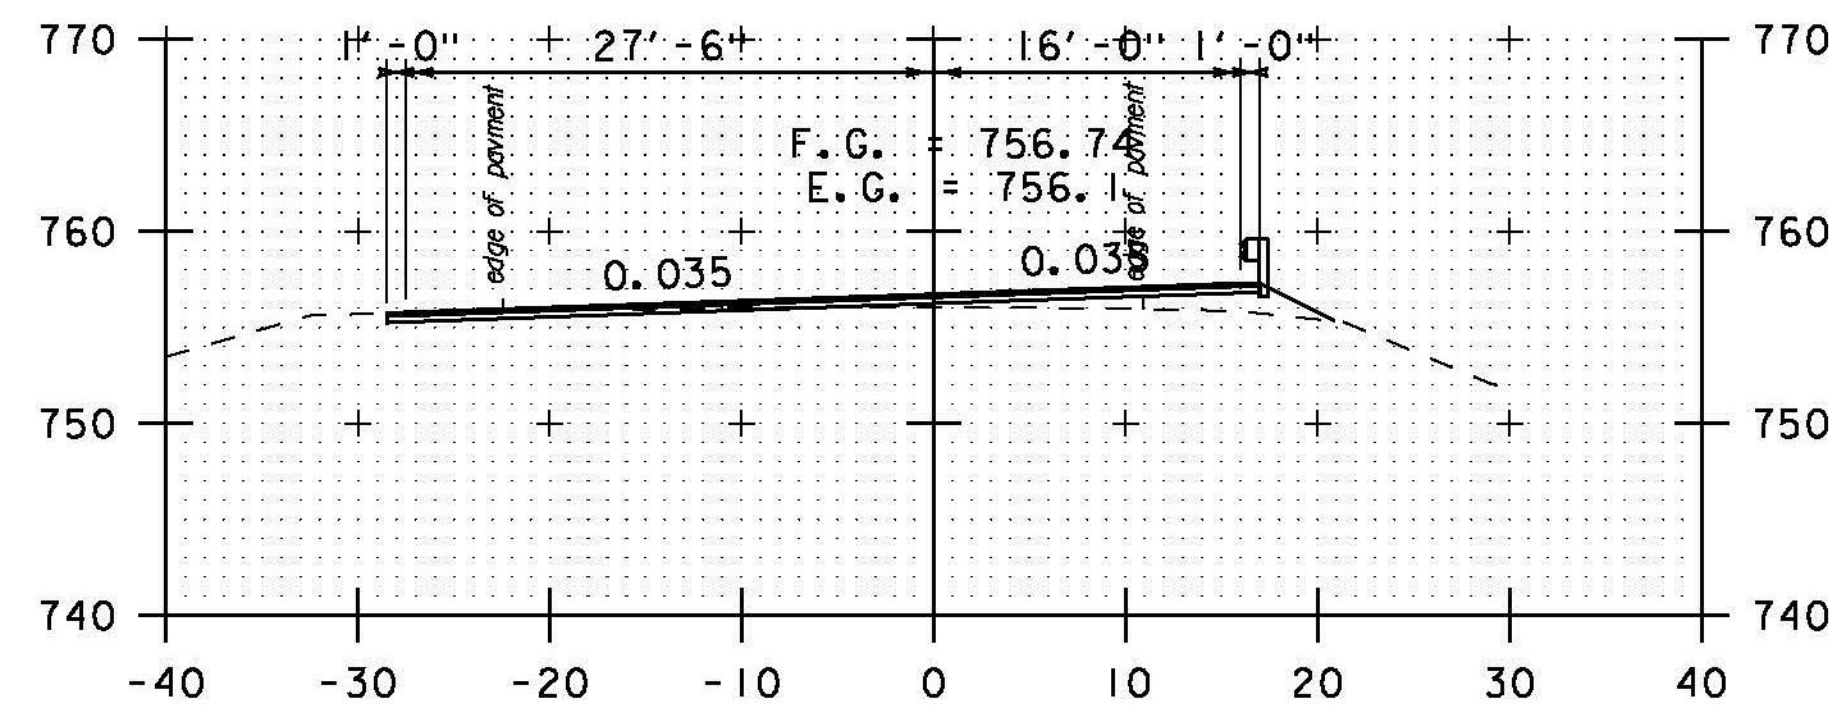


A 75+00

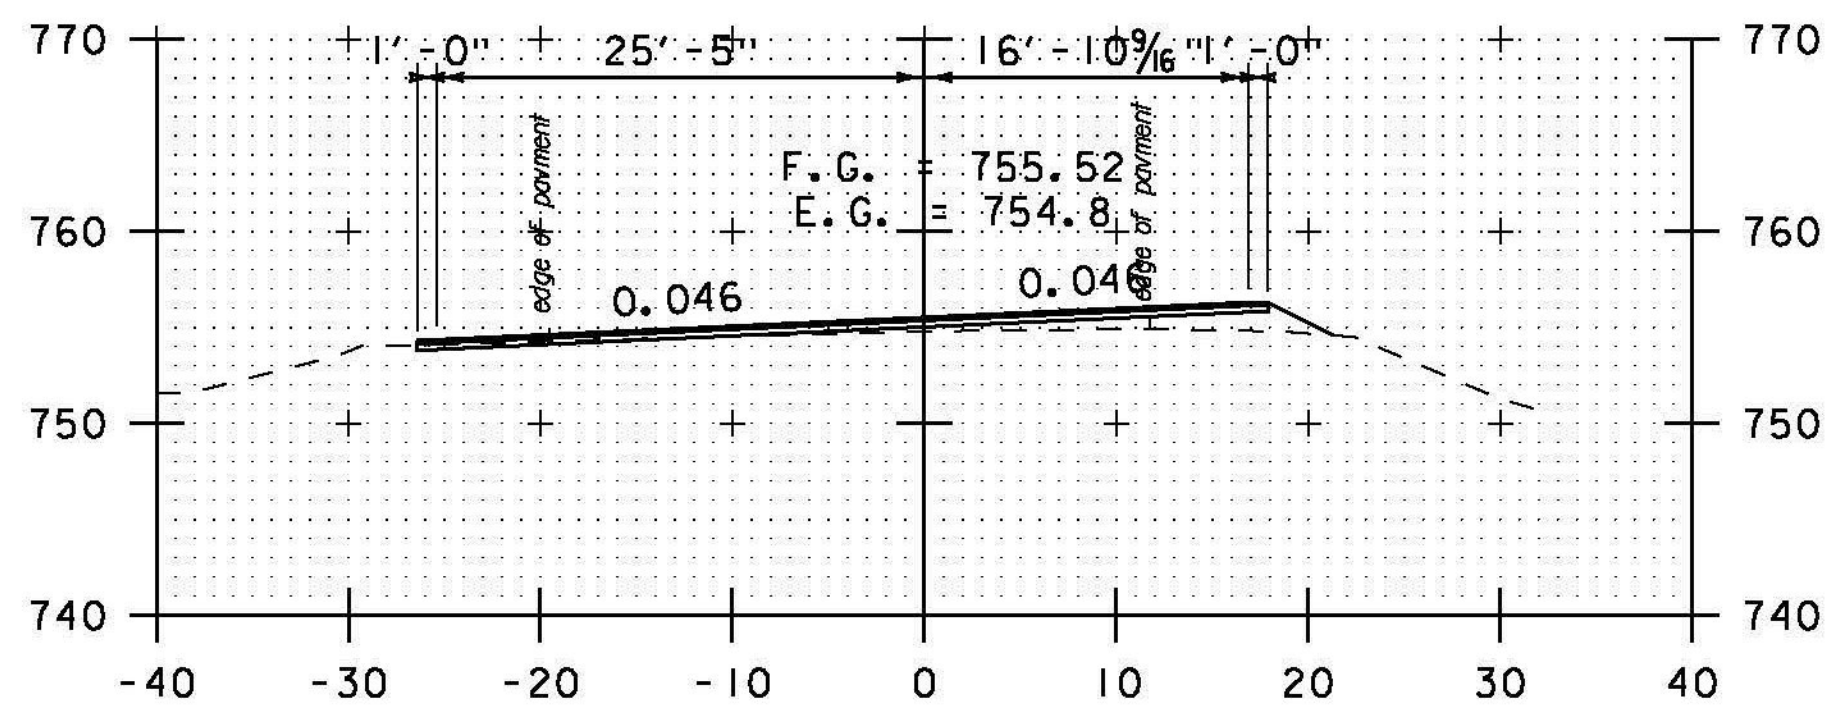

A 76+50

STA. A 75+00 TO STA. A 77+50

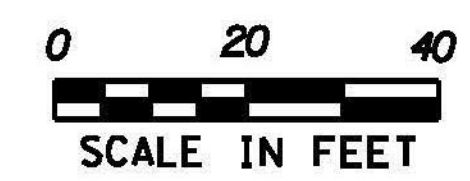

PROJECT NAME:	BETHEL-RANDOLPH	PLOT DATE:	4/23/2015
PROJECT NUMBER:	STP 292(I)	DRAWN BY:	S. LAMPHERE
FILE NAME:	plOC244.dgn	CHECKED BY:	C. LATHROP
PROJECT LEADER:	C. LATHROP	CROSS SECTION SHEET	65
DESIGNED BY:	S. LAMPHERE	SHEET	199 OF 211