




140+22

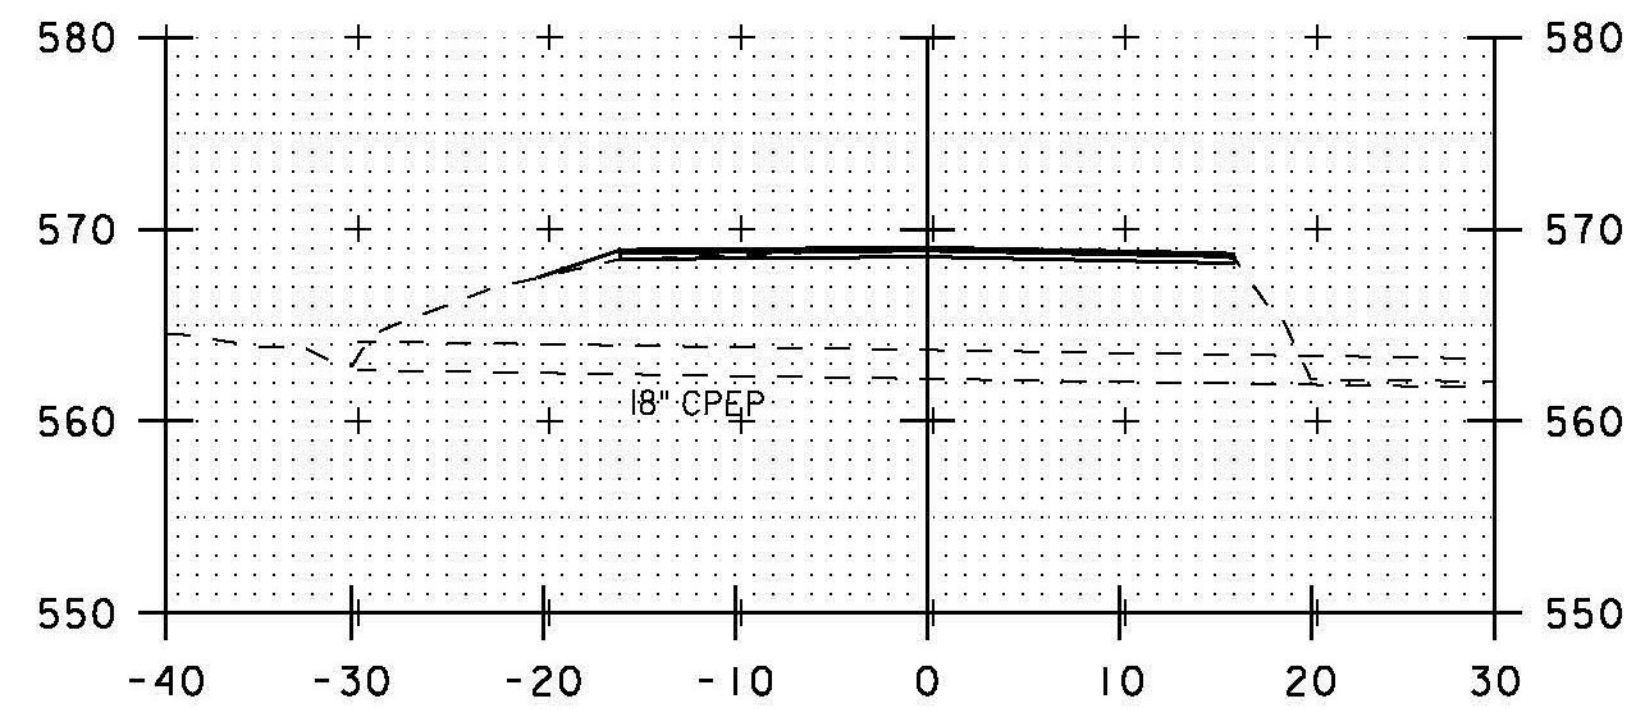


134+93

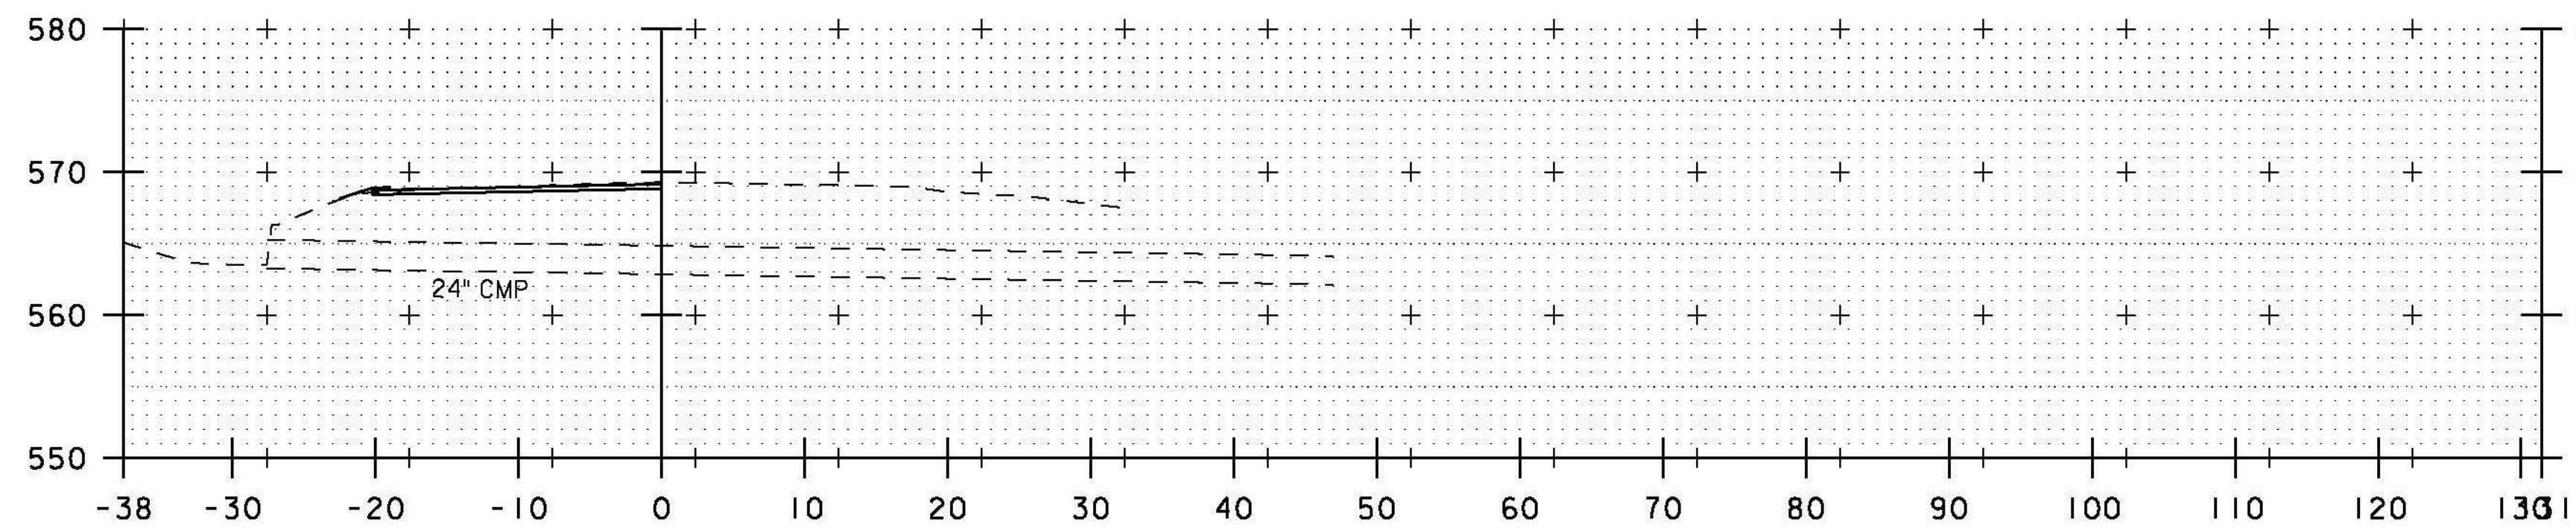


124+45

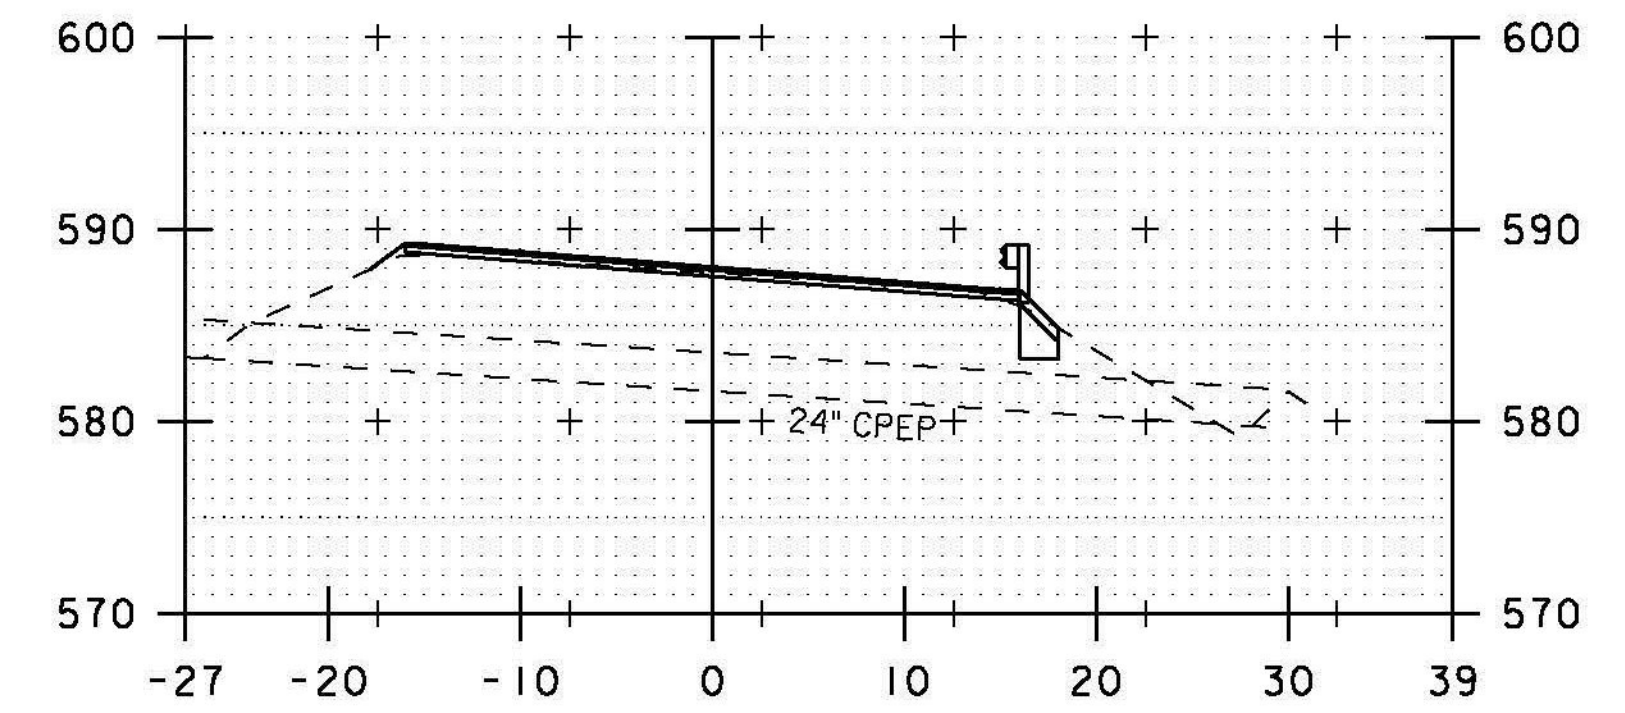

152+48

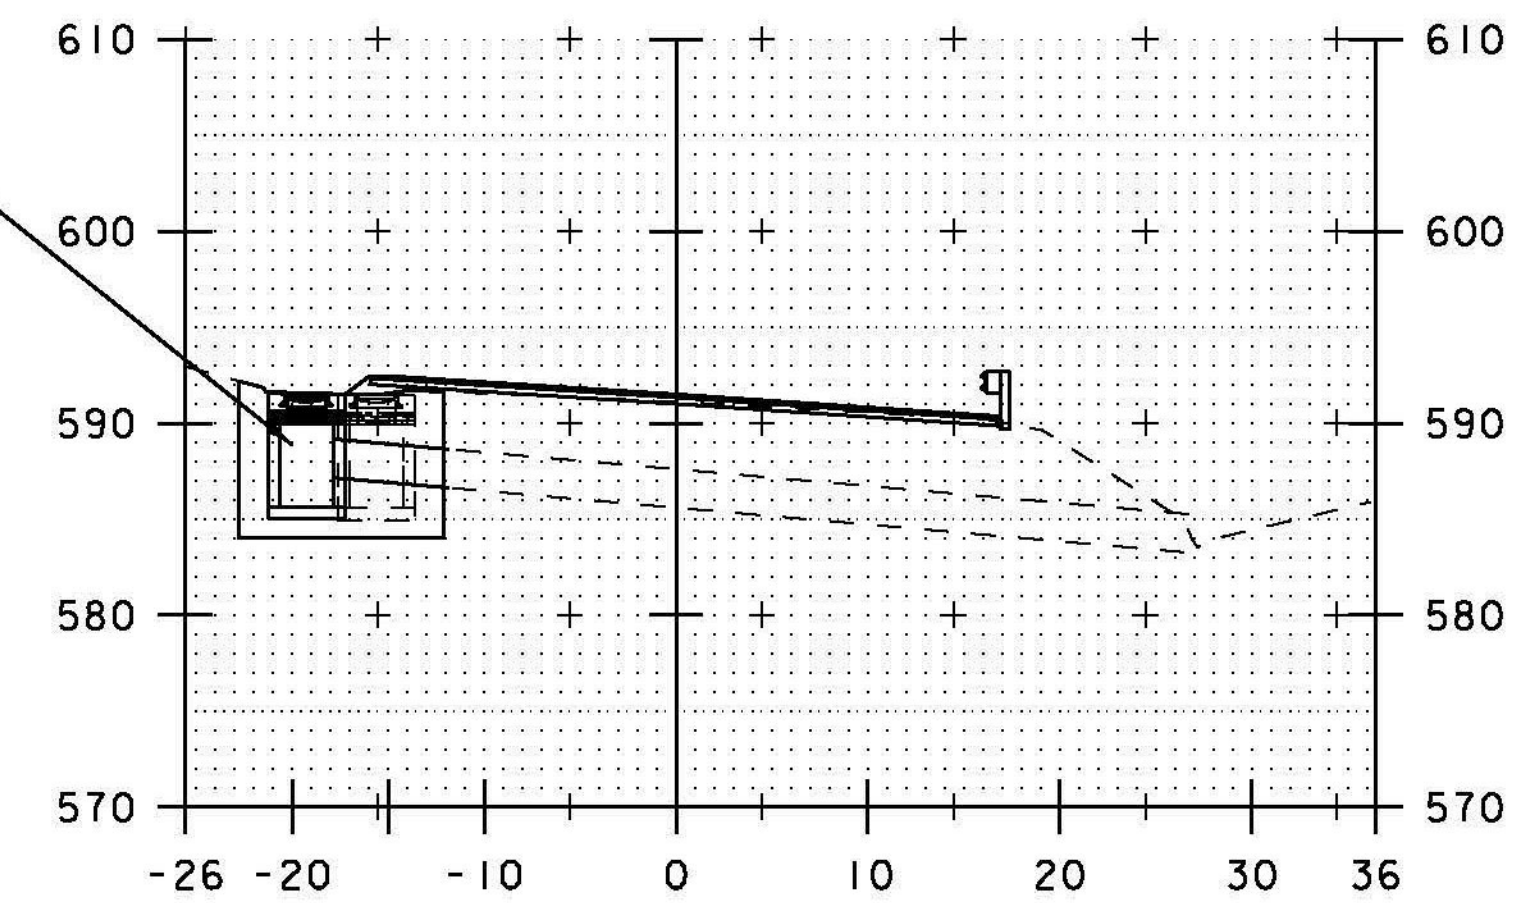

150+39

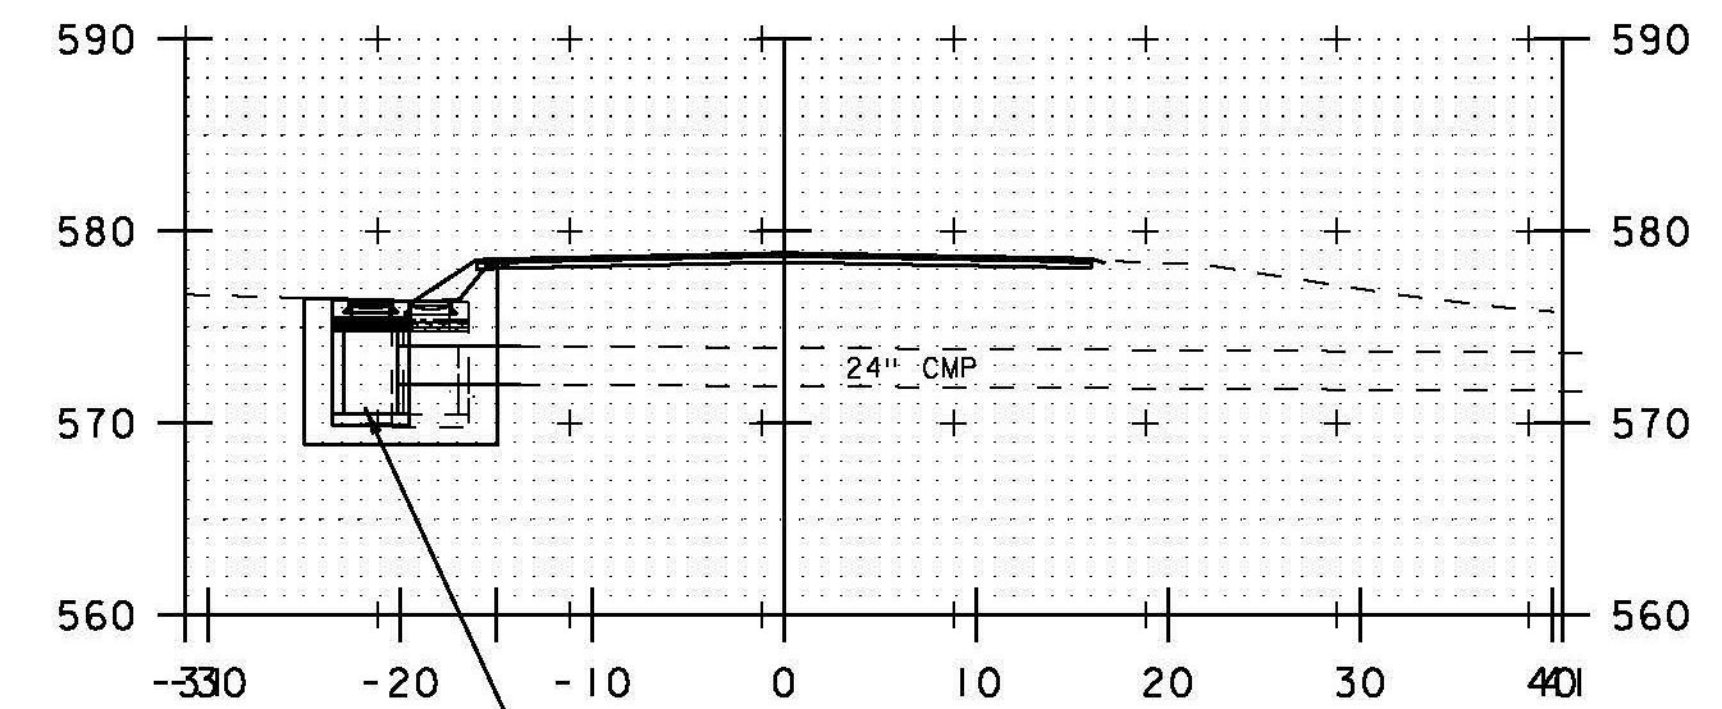

145+56

② REMOVE EXISTING DI AND
INSTALL NEW DI WITH
CAST IRON GRATE (TYPE A)
STA. 150+34 LT 21.0'
EXTEND 15" RCP 3.0' LT
MATCH EXISTING SLOPE
AND CONNECT TO NEW DI
RIM EL. = 591.53'

① REMOVE EXISTING DI AND
INSTALL NEW DI WITH
CAST IRON GRATE (TYPE A)
STA. 145+54 LT 21.4'
EXTEND 24" CMP 2.0' LT
MATCH EXISTING SLOPE
AND CONNECT TO NEW DI
RIM EL. = 576.40'

PROJECT NAME: BETHEL-RANDOLPH
PROJECT NUMBER: STP 292(1)

PLOT FILE: z10c244.dgn
PROJECT LEADER: C. LATHROP
DESIGNED BY: S. LAMPHERE
CULVERT CROSS SECTION SHEET 1

PLOT DATE: 4/23/2015
DRAWN BY: S. LAMPHERE
CHECKED BY: C. LATHROP
SHEET 200 OF 211

STA. 124+45 TO STA. 152+48