




163+07

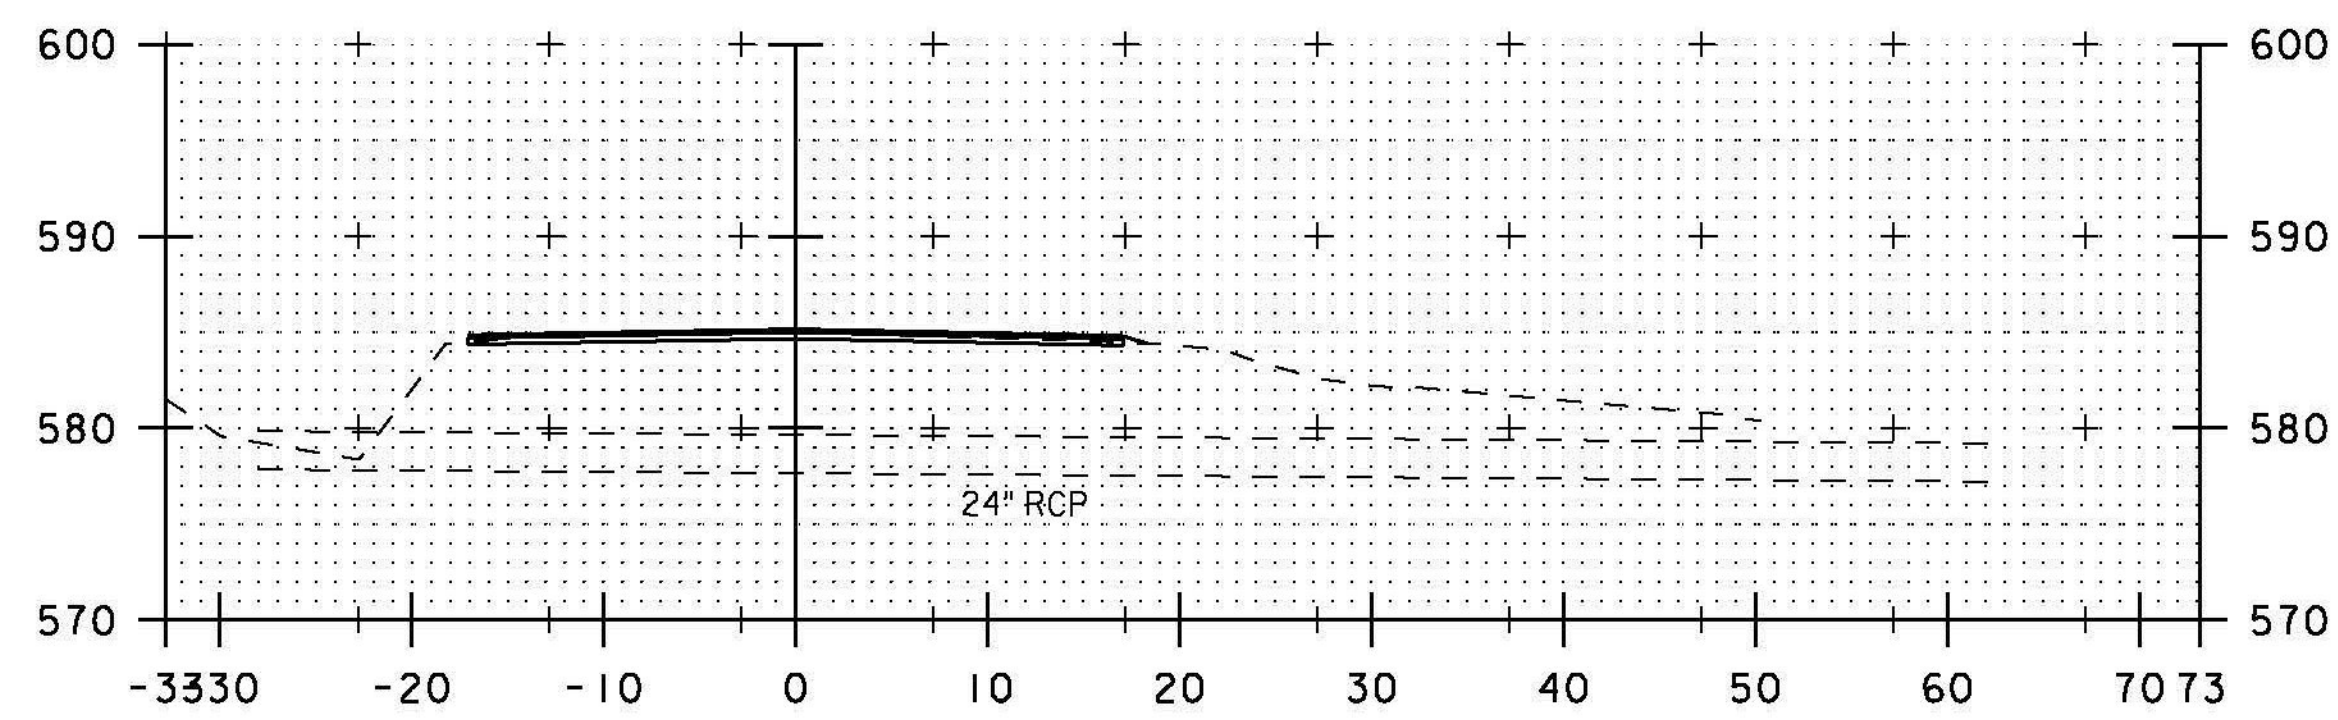

155+75

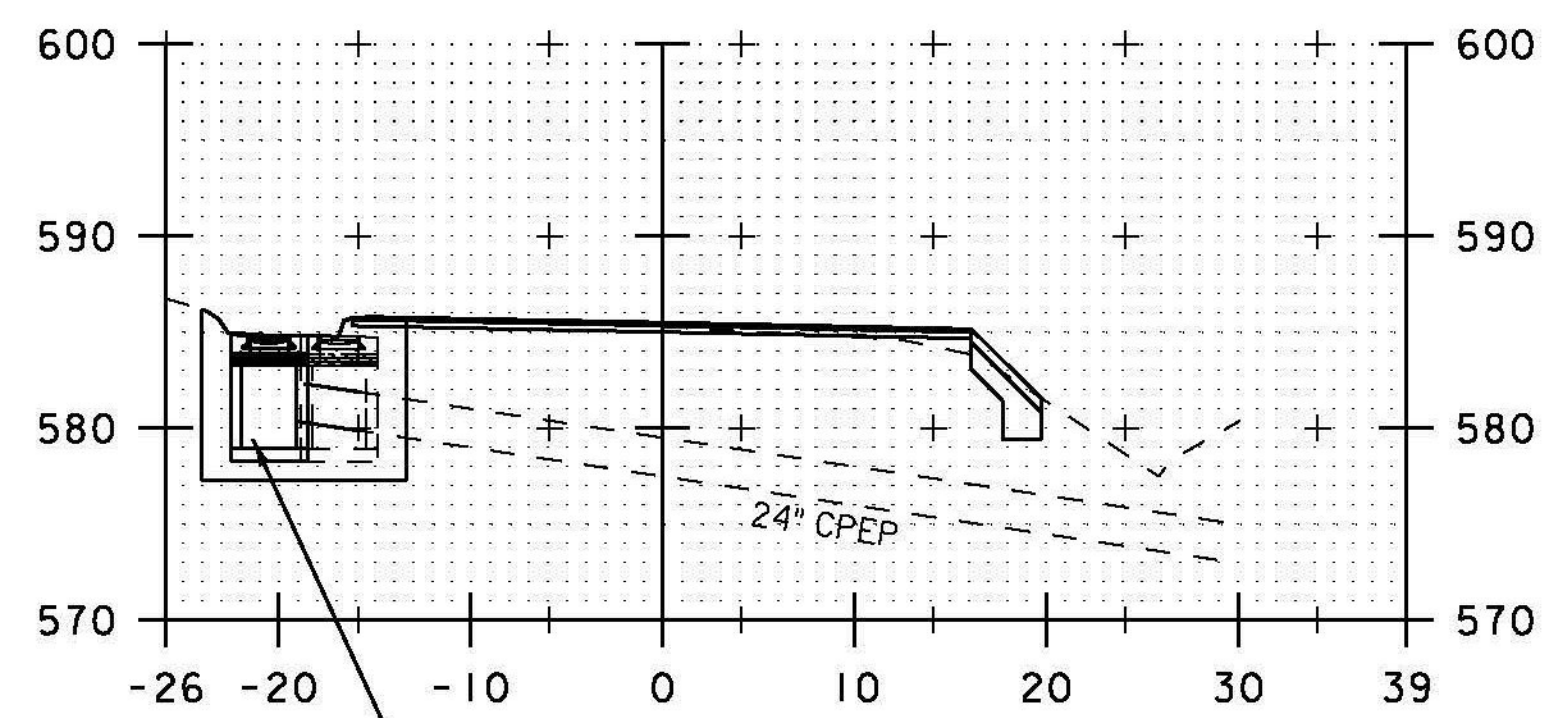

154+23

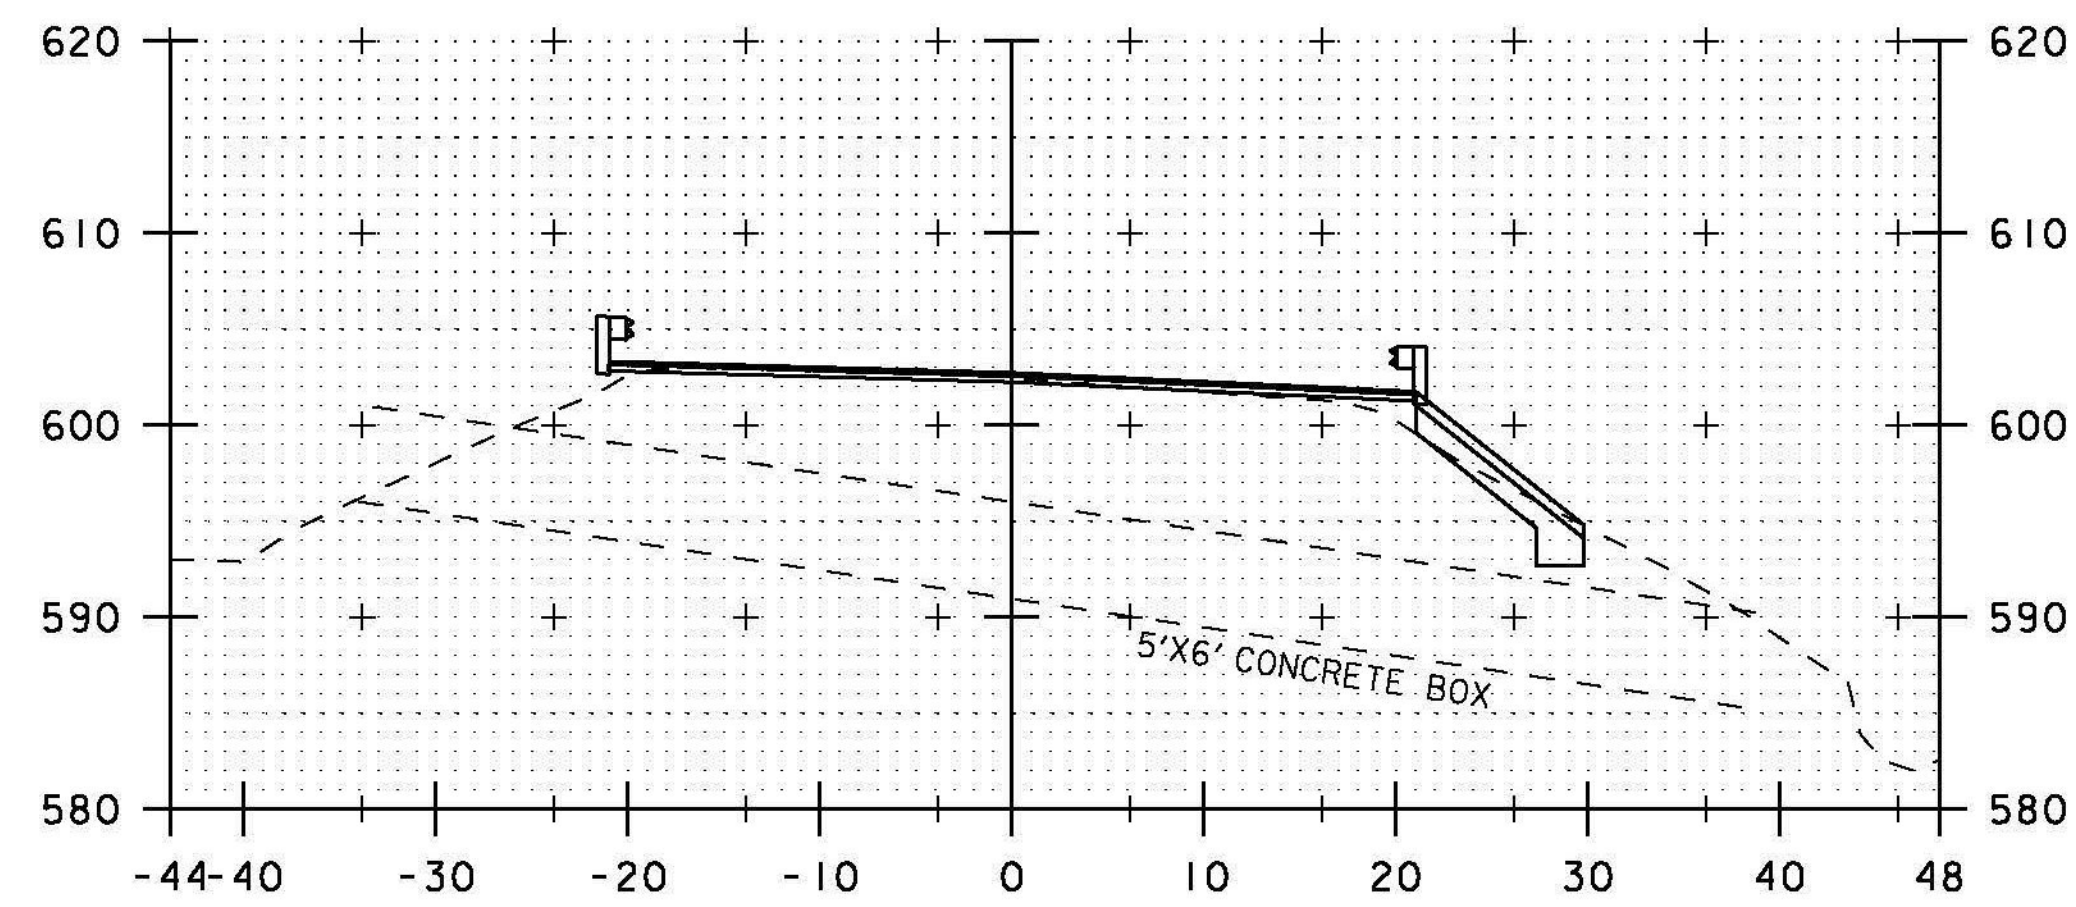

180+45

3

3 REMOVE EXISTING DI AND
INSTALL NEW DI WITH
CAST IRON GRATE (TYPE A)
STA. 154+21 LT 19.8'
EXTEND 24" CPEP (SL) 3.0' LT
MATCH EXISTING SLOPE
AND CONNECT TO NEW DI
RIM EL. = 584.87'

STA. 154+23 TO STA. 180+45

PROJECT NAME: BETHEL-RANDOLPH
PROJECT NUMBER: STP 292(I)

PLOT FILE: z10c244.dgn
PROJECT LEADER: C. LATHROP
DESIGNED BY: S. LAMPHERE
CULVERT CROSS SECTION SHEET 2

PLOT DATE: 4/23/2015
DRAWN BY: S. LAMPHERE
CHECKED BY: C. LATHROP
SHEET 201 OF 211