




A 14+00

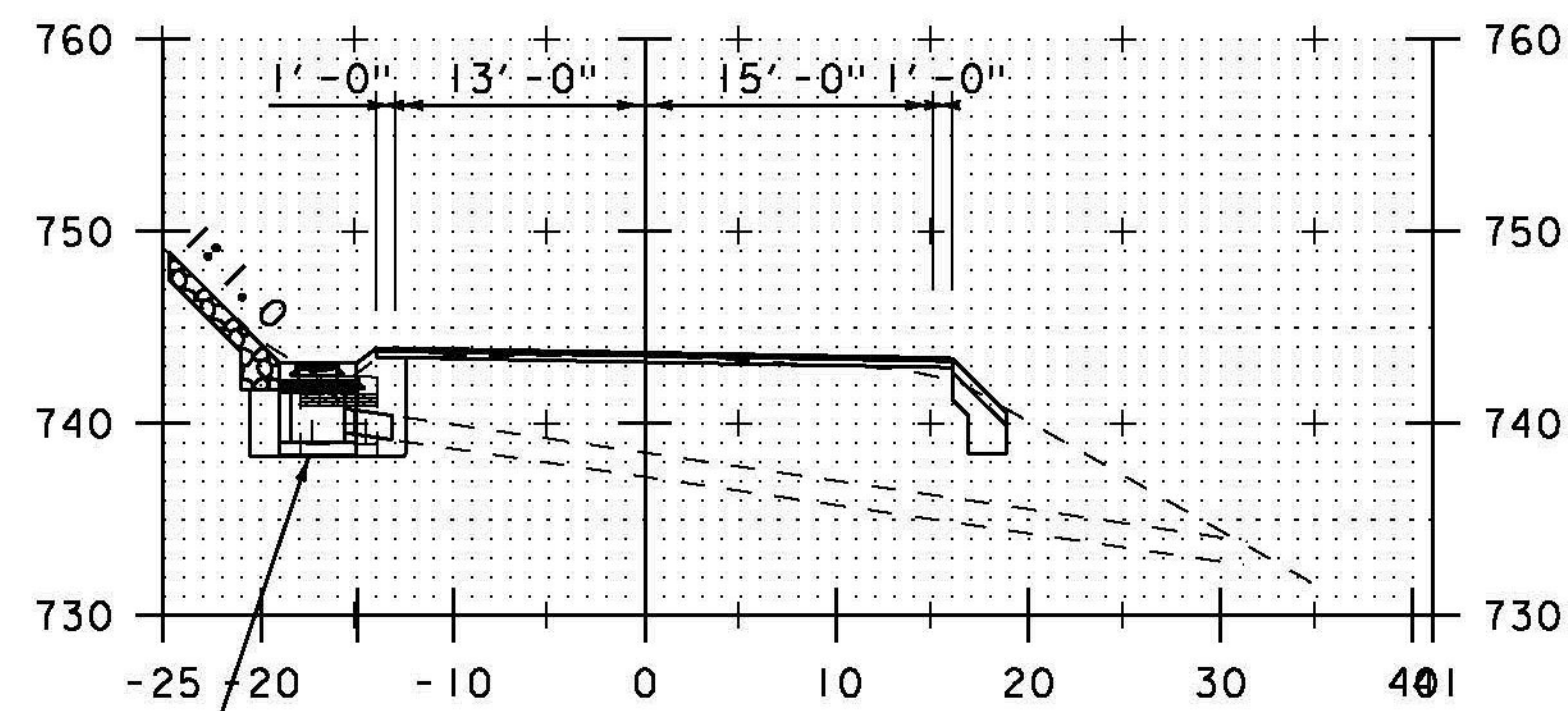


A 11+96

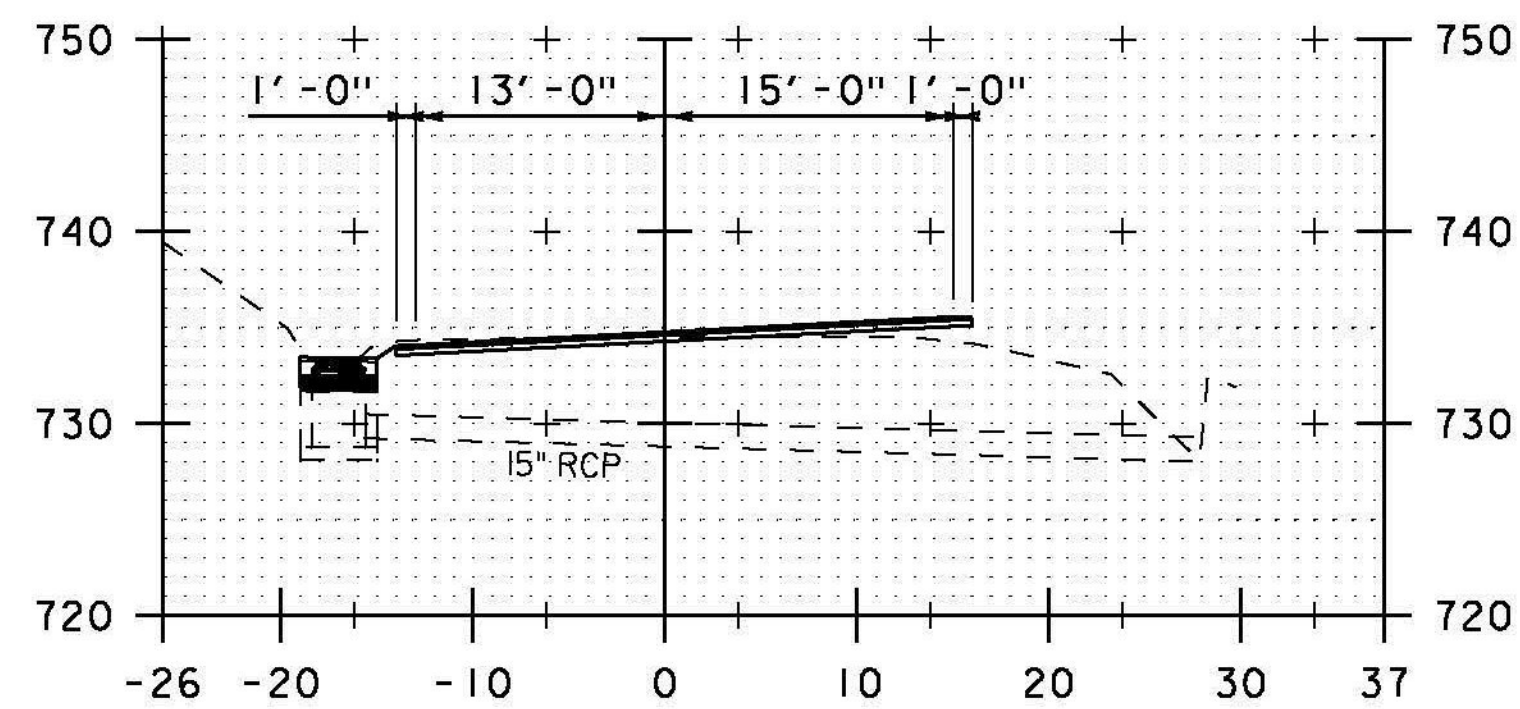


A 8+20

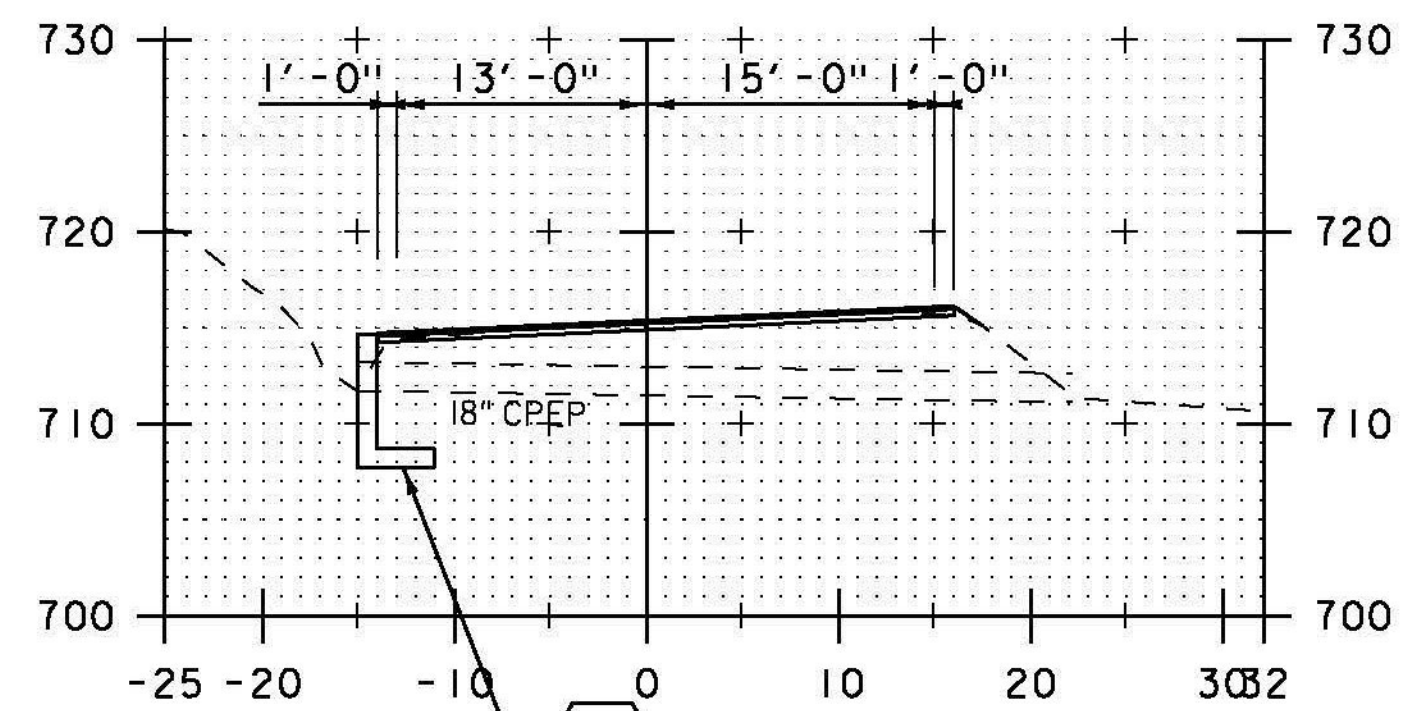


A 36+18

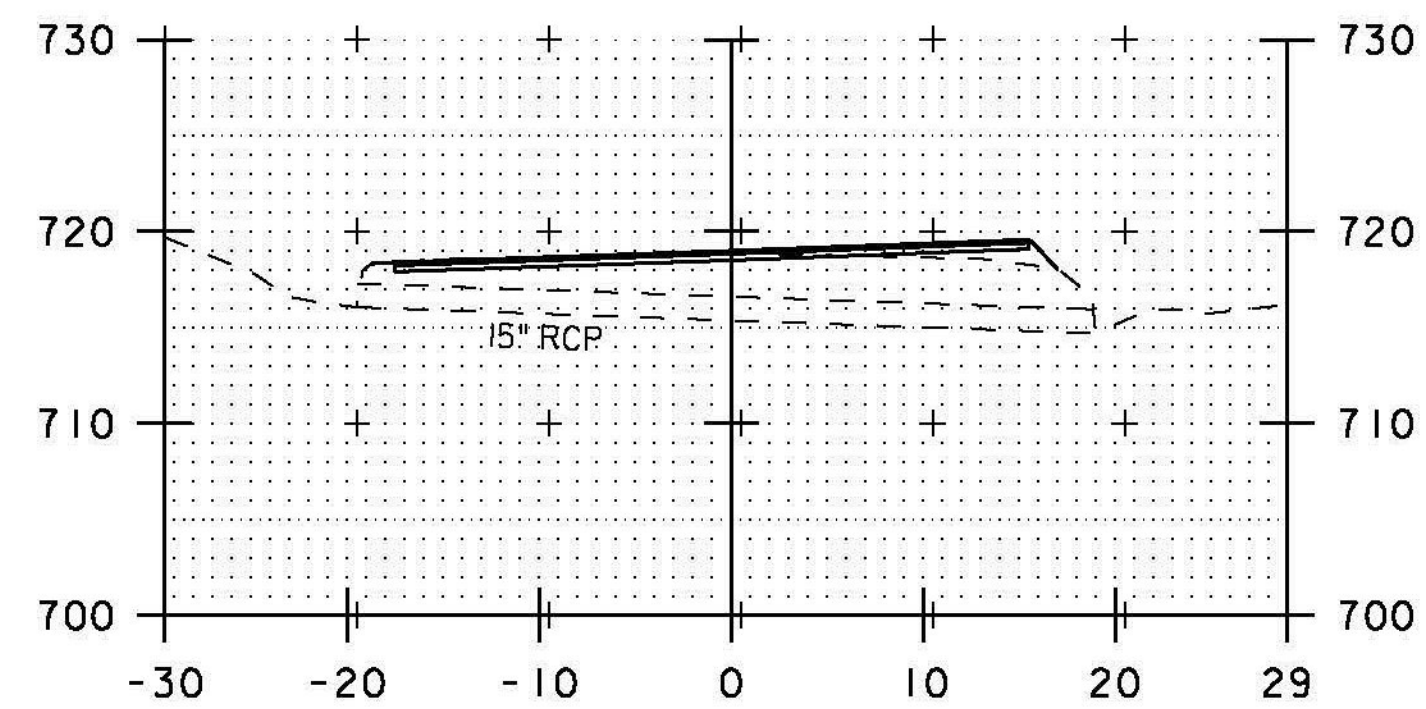


A 32+51

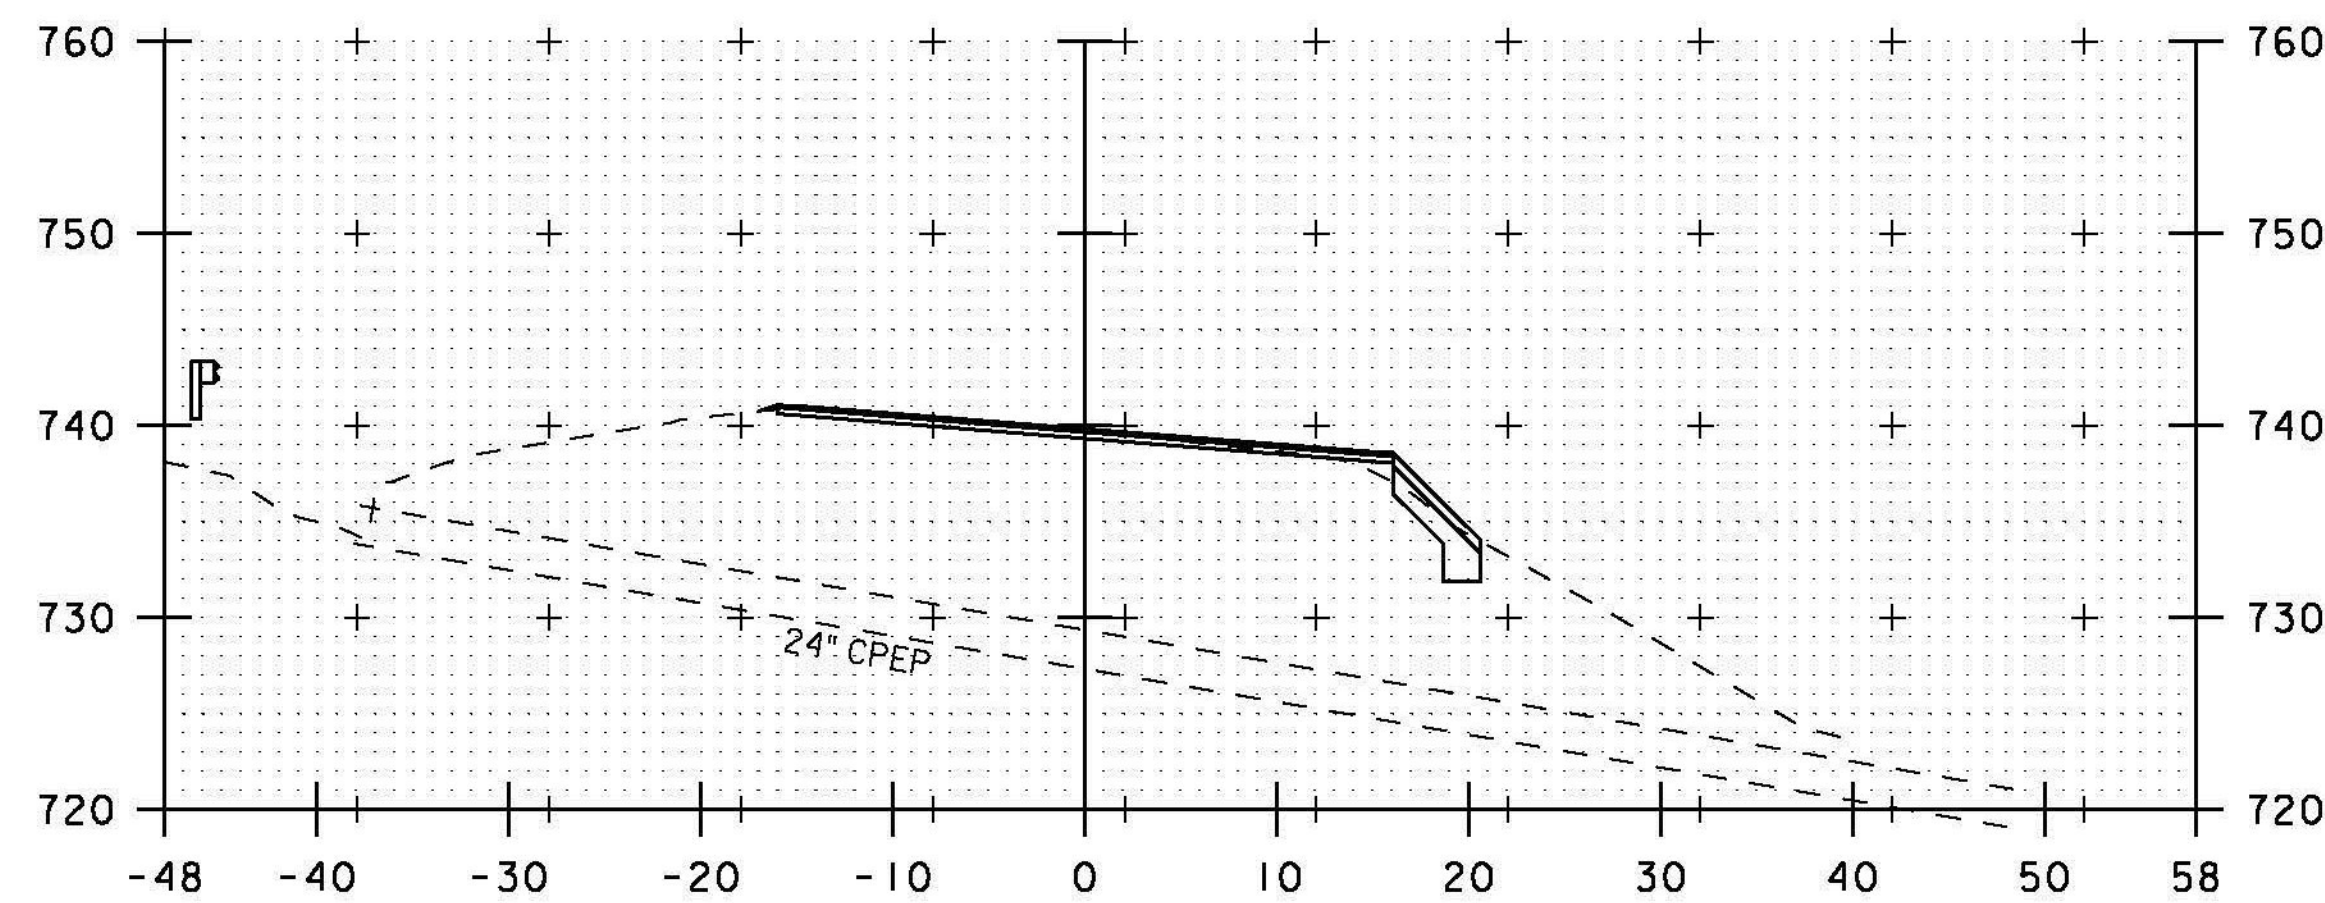


A 16+26

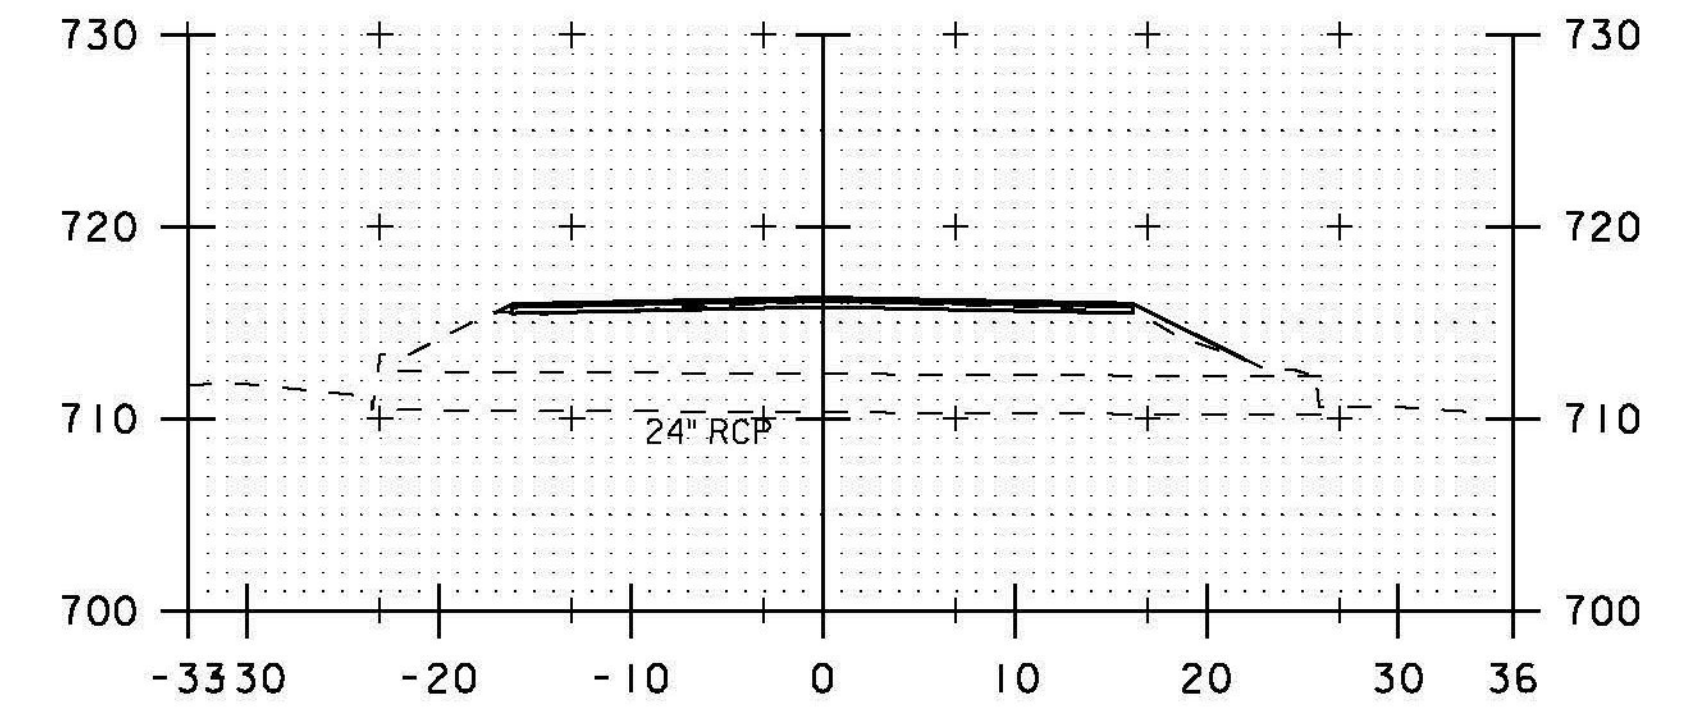

A 54+27

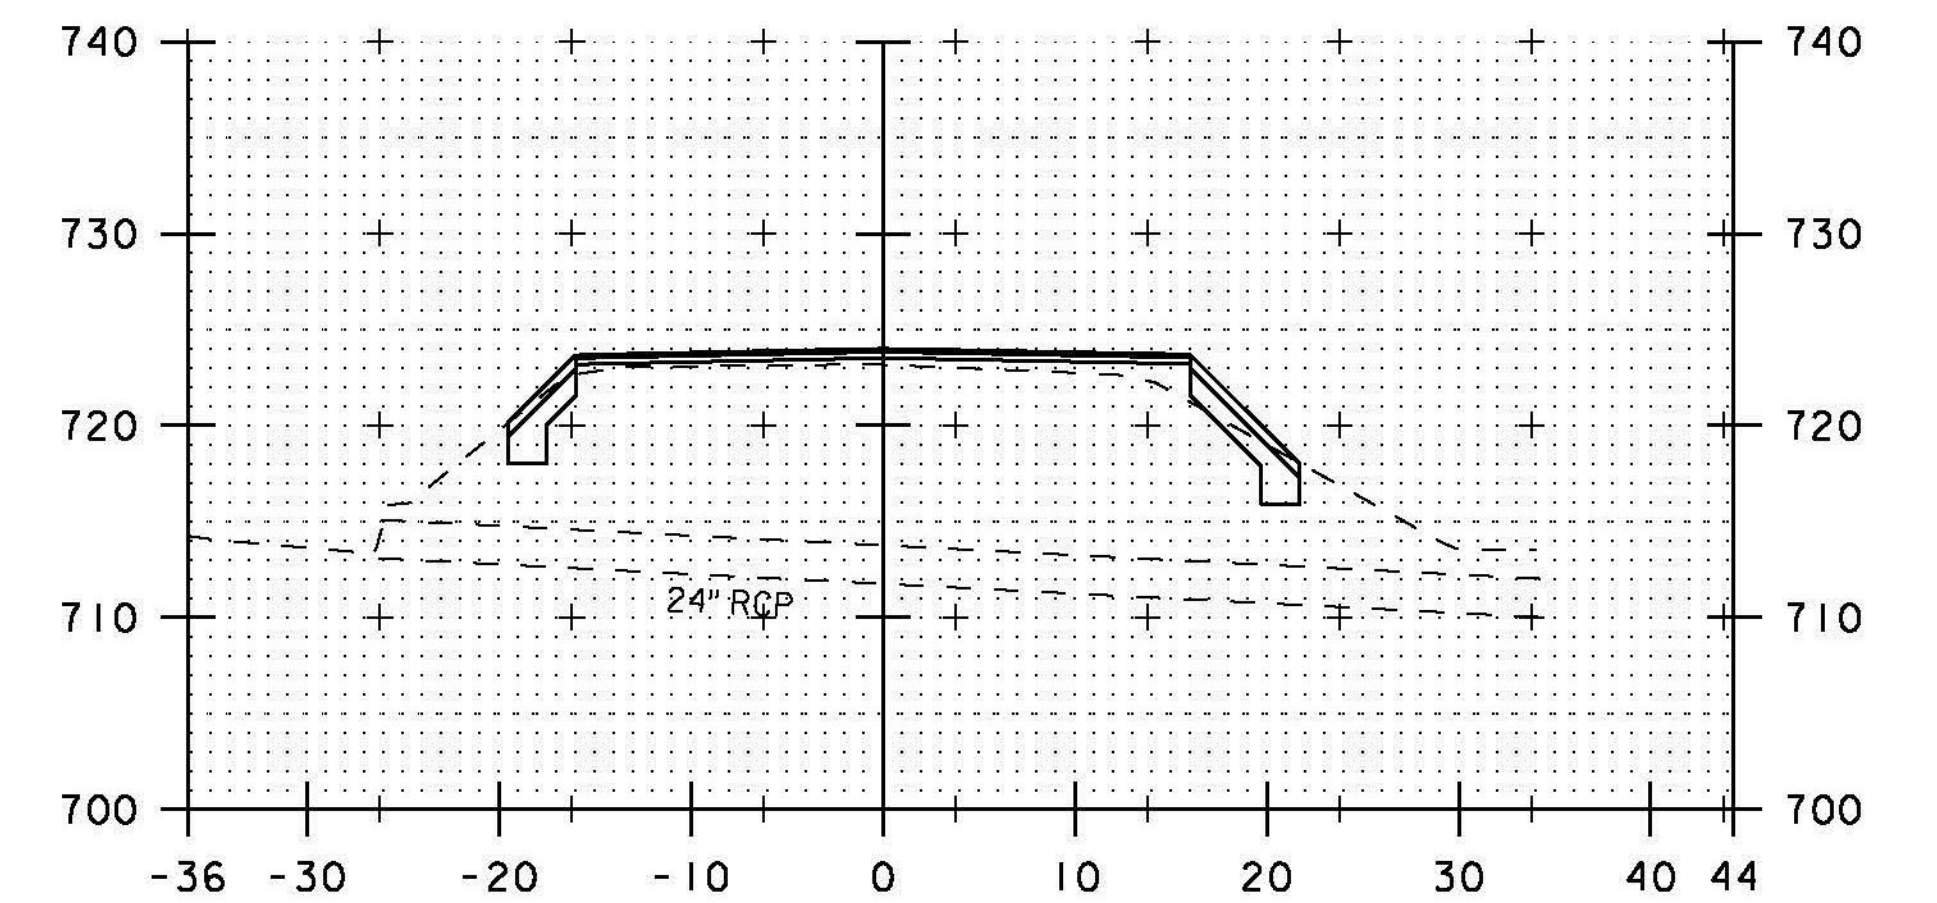

A 50+08

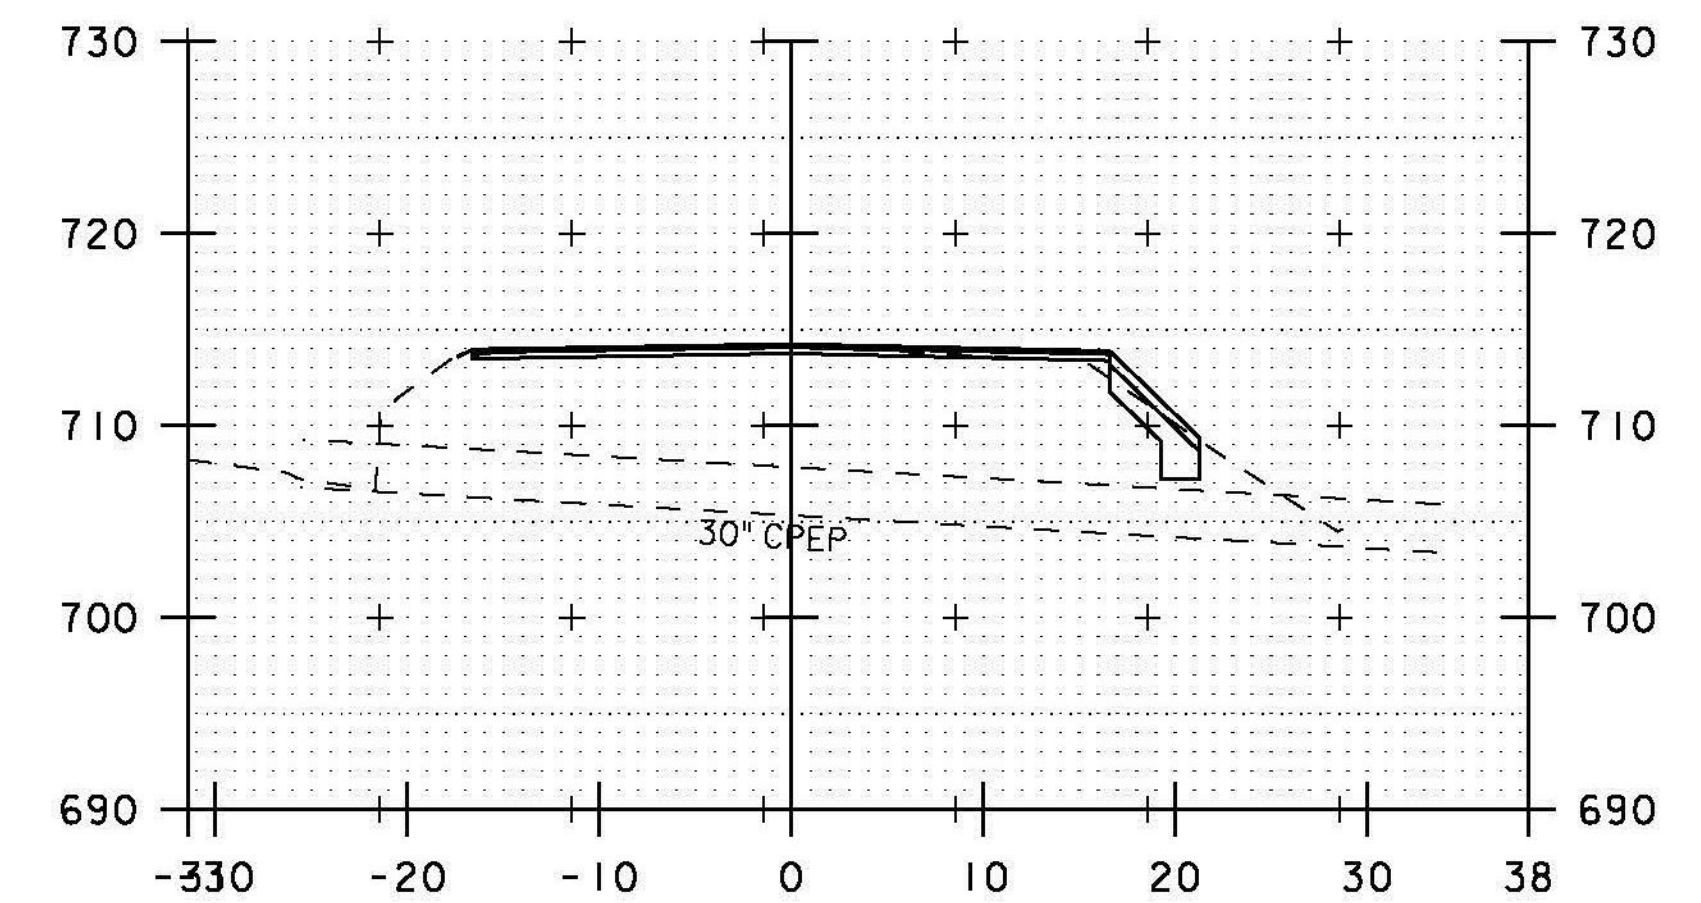

A 40+63

12 REMOVE EXISTING DI AND INSTALL NEW DI WITH CAST IRON GRATE (TYPE A) STA. A 11+96 LT 18.0' EXTEND 15"RCP 2.0' LT MATCH EXISTING SLOPE AND CONNECT TO NEW DI RIM EL. = 743.16'

13 INSTALL NEW PRECAST CONCRETE HEADWALL AT STA. A 36+18 LT. PIPE INV. = 711.71', TOP OF HEADWALL EL. = 714.73' SEE STD. D-33

STA. A 8+20 TO STA. A 54+27

PROJECT NAME: BETHEL-RANDOLPH
PROJECT NUMBER: STP 292(I)

PLOT FILE: z10c244.dgn
PROJECT LEADER: C. LATHROP
DESIGNED BY: S. LAMPHERE
CULVERT CROSS SECTION SHEET 6

PLOT DATE: 4/23/2015
DRAWN BY: S. LAMPHERE
CHECKED BY: C. LATHROP
SHEET 205 OF 211